


LOCATION MAP
1" INCH = 5,000 FEET

DIVER INVESTIGATION SURVEY OF POTENTIAL BURIED UTILITIES INTRACOASTAL WATERWAY, CUT PB-36 THROUGH CUT PB-41 PALM BEACH COUNTY, FLORIDA

—FOR—

TAYLOR ENGINEERING, INC.

DATE: FEBRUARY 15, 2018
COMMISSION NUMBER: 5303.16

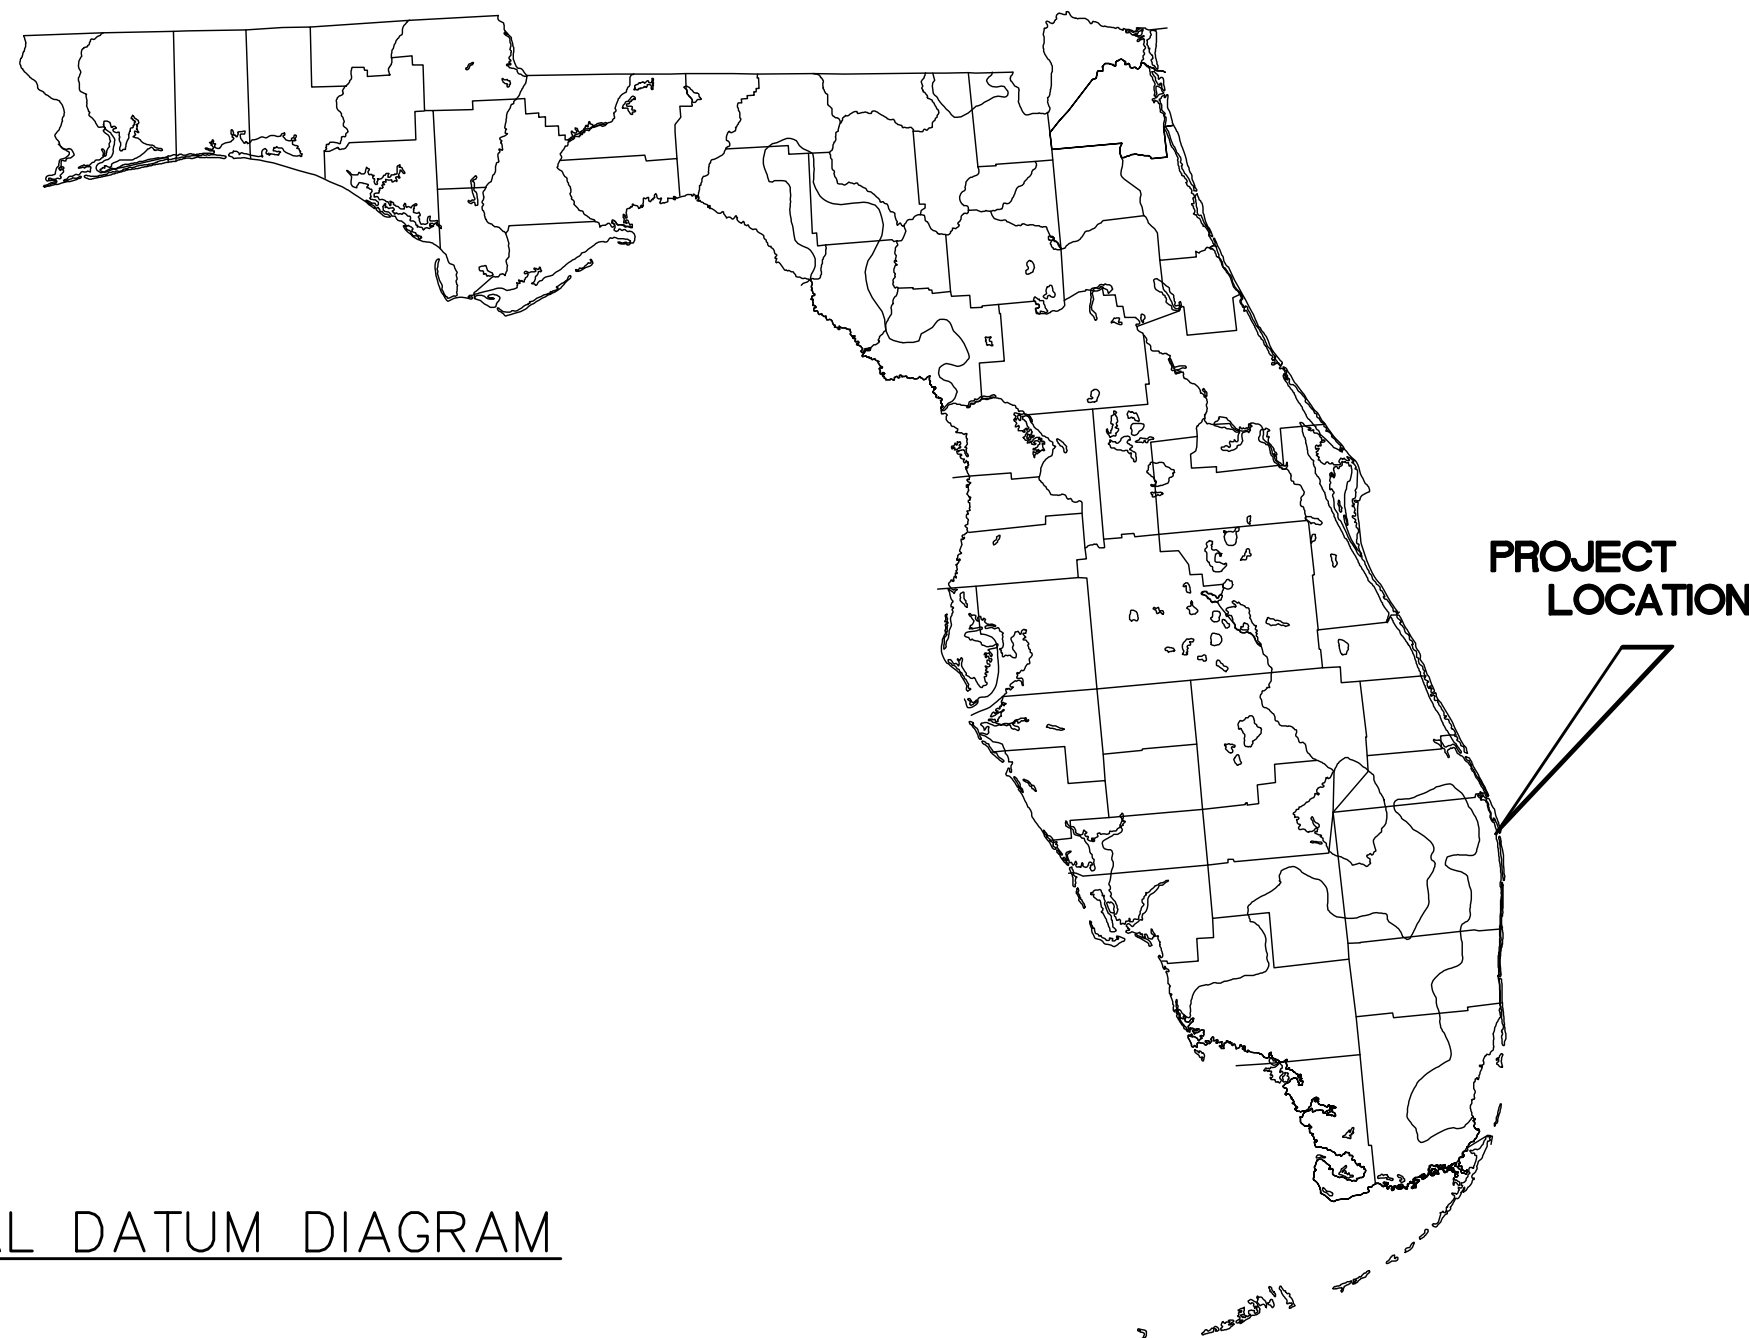

- SURVEY NOTES:**
- COORDINATES SHOWN ARE IN U.S. SURVEY FEET, AND ARE REFERENCED TO THE FLORIDA STATE PLANE COORDINATE SYSTEM, EAST ZONE, NORTH AMERICAN DATUM OF 1983, ADJUSTMENT OF 2011 (NAD 83/2011).
 - ELEVATIONS ARE REFERENCED TO MEAN LOWER LOW WATER (SEE VERTICAL DATUM DIAGRAM).
 - ELEVATIONS SHOWN ARE IN FEET AND ARE REFERENCED TO MEAN LOWER LOW WATER. ELEVATION DATA WAS COLLECTED IN FEET RELATIVE TO THE NORTH AMERICAN VERTICAL DATUM OF 1988 (NAVD 88) AND CONVERTED TO MLLW USING THE LATEST VERSION OF VDATUM (VERTICAL DATUM TRANSFORMATION) PROVIDED BY NOAA, NATIONAL OCEAN SERVICE (NOS).
 - CAUTION:** THE DIFFERENCE BETWEEN NAVD 88 AND MEAN LOWER LOW WATER VARIES AND MAY NOT BE THE SAME AS THE DIFFERENCE USED FOR PREVIOUS ACOE SURVEYS. TO MAKE A DIRECT COMPARISON BETWEEN SURVEYS, THE USER NEEDS TO BE CAREFUL TO VERIFY THE VERTICAL DATUM TRANSFORMATION PARAMETERS FOR EACH PROJECT AREA.
 - COORDINATES AND ELEVATIONS ARE BASED UPON THE MONUMENTS SHOWN IN THE CONTROL TABLE.
 - ELEVATION DATA POINTS SHOWN HEREON WERE INTERPOLATED ALONG A GRIDDED SURFACE DERIVED FROM SOUNDING DATA AND ARE FOR DISPLAY PURPOSES ONLY.
 - BATHYMETRIC, MAGNETOMETER, SEISMIC RESULTS AND SIDE-SCAN SONAR INFORMATION DEPICTED ON THIS SURVEY REPRESENT THE EXISTING CONDITIONS ON THE DATE OF THE FIELD SURVEY. DATA WAS COLLECTED ON DEC 14-17 AND 21-23, 2015, JANUARY 6, 7, & 27, AND FEBRUARY 4, 2016.
 - AERIAL IMAGERY WAS TAKEN IN 2013 AND WAS PROVIDED BY THE FLORIDA DEPARTMENT OF TRANSPORTATION.
 - AERIAL IMAGERY IS DISPLAYED HEREON FOR INFORMATION PURPOSES ONLY, NO PHOTOGRAPHIC ACCURACY IS IMPLIED BY THIS MAP.
 - NOT VALID WITHOUT THE SIGNATURE AND ORIGINAL RAISED SEAL OF A FLORIDA LICENSED SURVEYOR AND MAPPER.
 - HORIZONTAL POSITIONING UTILIZED A TRIMBLE SPS 852 REAL TIME REAL TIME KINEMATIC GPS RECEIVER WITH REAL TIME CORRECTIONS APPLIED FROM POINT 235.
 - SOUNDINGS WERE OBTAINED USING AN ODOM MB1 MULTI BEAM ECHO SOUNDER OPERATING AT 219KHZ.
 - WATER SURFACE ELEVATIONS WERE OBTAINED USING A TRIMBLE SPS 852 REAL TIME KINEMATIC (RTK) DUAL FREQUENCY GPS RECEIVER WITH REAL TIME CORRECTIONS APPLIED FROM A TRIMBLE 5700 DUAL FREQUENCY BASE STATION OCCUPYING POINTS SHOWN IN THE CONTROL TABLE AND WERE VERIFIED TO A TIDE STAFF ELEVATED FROM CONTROL POINT 234.
 - THE SIDE-SCAN SONAR DATA WAS COLLECTED USING THE EDGETECH DUAL FREQUENCY (600 KHZ AND 1600 KHZ) CHIRP SIDE-SCAN SONAR. THE MODEL USED WAS THE 4125. THE SIDE-SCAN SONAR IS CAPABLE OF PRODUCING SONIC IMAGES OF THE BOTTOM WITH THE RESOLUTION TO DISPLAY SMALL OBJECTS IF THEY ARE EXPOSED AND NOT COMPLETELY BURIED. THE LIMITATIONS OF THE SIDE-SCAN SONAR ARE THAT IT CANNOT PENETRATE THE BOTTOM AND DETECT A BURIED OBJECT.
 - MAGNETOMETER DATA WAS COLLECTED USING THE GEOMETRICS G-882 DIGITAL CESIUM MAGNETOMETER WITH ALTIMETER AND DEPTH SENSOR. THE MAGNETOMETER READS THE EARTH'S MAGNETIC FIELD AND MEASURES THE EFFECTS OF FERROUS OBJECTS UPON IT.
 - THE SUB-BOTTOM (SEISMIC) DATA WAS COLLECTED USING AN EDGETECH X-STAR CHIRP SUB-BOTTOM PROFILER.
 - ADDITIONS OR DELETIONS TO THIS SURVEY MAP ARE PROHIBITED WITHOUT WRITTEN CONSENT.
 - DIVER INVESTIGATION WAS PERFORMED BY INDUSTRIAL DIVERS CORPORATION. ON JANUARY 22-26 AND 29-31, FEBRUARY 1-2, 5-9, AND 12-15, 2018.

PREPARED BY:

Morgan & Eklund Inc.
PROFESSIONAL SURVEY CONSULTANTS




4909 US HIGHWAY #1
VERO BEACH, FL 32967
PHONE: (772) 388-5364
FAX: (772) 388-3165

1612 NW 2D AVENUE, SUITE 3
BOCA RATON, FL 33432
PHONE: (954) 421-6882
FAX: (954) 421-0425
LB #4298

SUITE 211
1001 NORTH AMERICAN WAY
MIAMI, FL 33132
PHONE: (305) 364-5158

VERTICAL DATUM DIAGRAM

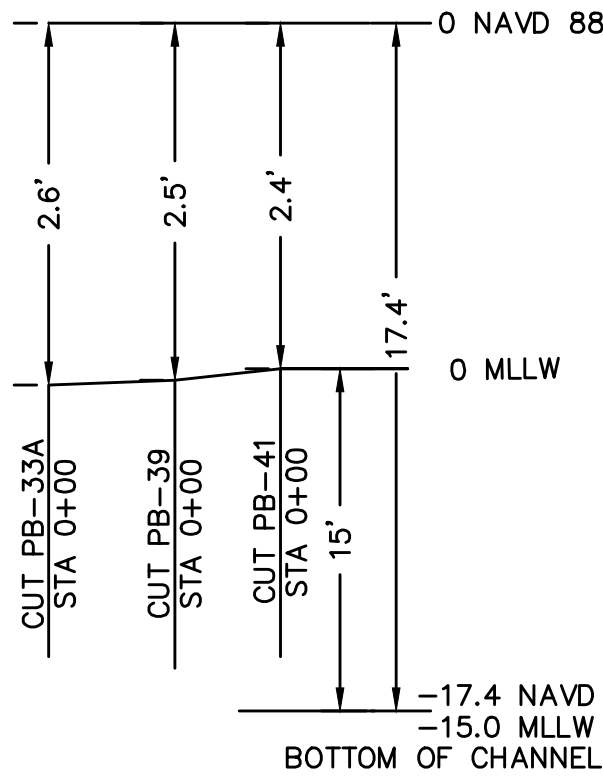

RELATIONSHIP BETWEEN NAVD88 AND MLLW
(BASED UPON NOAA VDATUM CONVERSION)

LEGEND

- | | |
|-------|--|
| APM | ALUMINUM PIPE MONUMENT |
| CGS | COAST & GEODETIC SURVEY |
| CM | CONCRETE MONUMENT |
| DM ID | FDEP DOCUMENT IDENTIFICATION NUMBER |
| DRM | DEEP ROD MONUMENT |
| FDEP | FLORIDA DEPARTMENT OF ENVIRONMENTAL PROTECTION |
| ICWW | INTRACOASTAL WATERWAY |
| LT | LEFT |
| M&E | MORGAN & EKLUND, INC. |
| MLLW | MEAN LOWER LOW WATER |
| NGS | NATIONAL GEODETIC SURVEY |
| NOAA | NATIONAL OCEANIC AND ATMOSPHERIC ASSOCIATION |
| ORB | OFFICIAL RECORD BOOK |
| RT | RIGHT |
| USACE | UNITED STATES ARMY CORPS OF ENGINEERS |
| Ⓢ | CENTERLINE |
| Ⓢ | RED CHANNEL MARKER |
| Ⓢ | GREEN CHANNEL MARKER |

CONTROL TABULATION

DESIGNATION	NAD 83/11 NORTHING	SPCS 0901 EASTING	NAVD 88* ELEVATION	STAMPING	DESCRIPTION
282	892034.55	968102.57	5.11	LB 4298	5/8" IRC
225	891643.02	968059.34	4.76	LB 4298	5/8" IRC
W 309	891639.96	968062.79	8.88	W 309	FLORIDA SRD DISK
IWP 26			2.49	IWP 26 1957 JACKSONVILLE	USACE DISK
234	870009.90	966430.83	3.35	LB 4298	5/8" IRC
235	869928.48	966453.56	3.15	LB 4298	5/8" IRC
236	852476.42	969017.25	4.46	LB 4298	5/8" IRC
237	852483.15	969075.62	4.58	LB 4298	5/8" IRC
ZEIS	852327.16	967513.56		ZEIS	CGS DISK

* ALL ELEVATION DATA SHOWN ON THE FOLLOWING PAGES HAVE BEEN CONVERTED TO MEAN LOWER LOW WATER USING THE LATEST VERSION OF VDATUM (VERTICAL DATUM TRANSFORMATION) PROVIDED BY NOAA, NATIONAL OCEAN SERVICE (NOS).

CAUTION

THERE MAY BE OTHER UTILITY CROSSINGS
THAT WERE NOT DETECTED DURING THIS
SURVEY. CONTRACTOR IS TO VERIFY
UTILITY LOCATIONS PRIOR TO DREDGING.


SHEET INDEX

SHEET NO.	DESCRIPTION
1	COVER SHEET
2	KEY MAP
3-10	ELEVATION DATA
11-18	MAGNETOMETER, SEISMIC & SIDE-SCAN SONAR DATA
19-21	SURVEY REPORT
22	PROFILES


FIELD BOOK: PALM BEACH 64A, PAGES 1-24

REVISED 3/6/18: ADD DIVER DATA AND NOTES

SHEET 1 OF 22

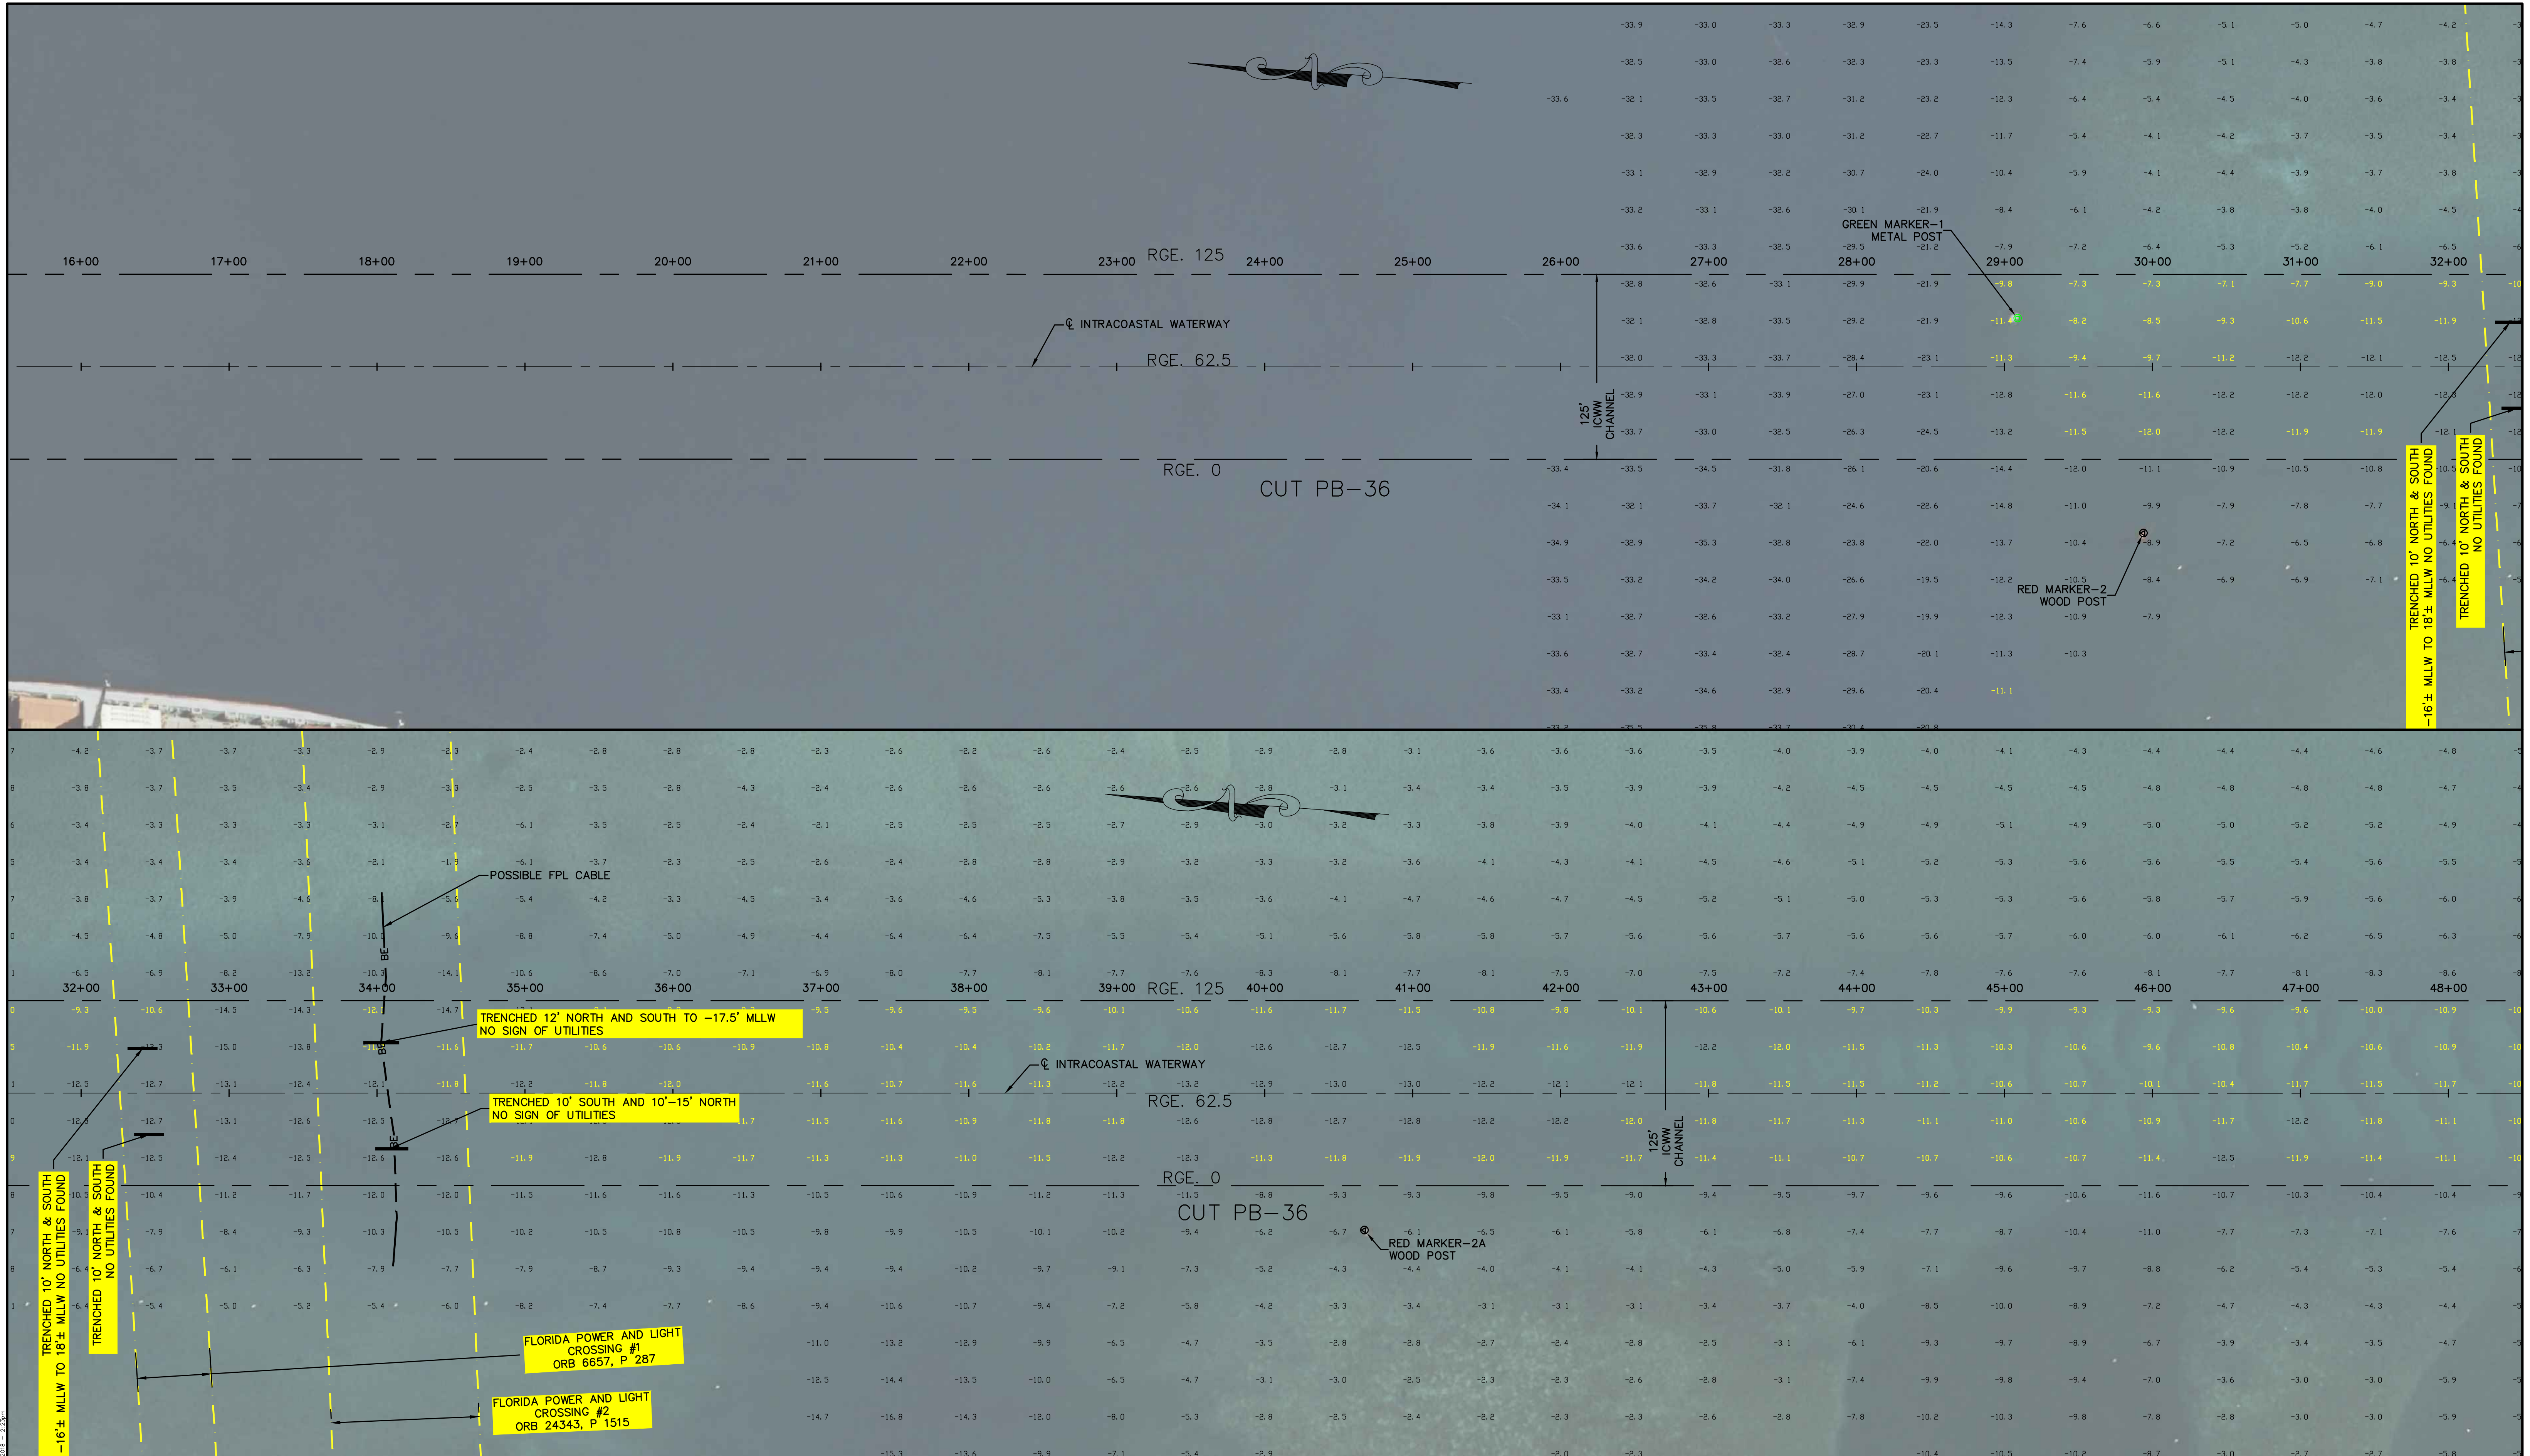

11. Jan. 2018 - 2.27am

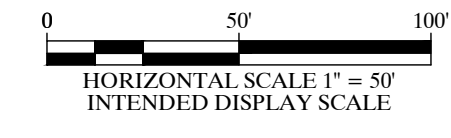

LEGEND		
TRENCHED TO -17.5 MLLW NO UTILITIES ENCOUNTERED	FOUND UTILITY LINE	NOT INVESTIGATED
PWC-PROCEED WITH CAUTION		

Morgan & Eklund Inc.
PROFESSIONAL SURVEY CONSULTANTS

4909 US HIGHWAY #1
VERO BEACH, FL 32967
PHONE: (772) 388-5364
FAX: (772) 388-3165

1612 NW 2ND AVENUE
SUITE 3
BOCA RATON, FL 33432
PHONE: (954) 421-6682
FAX: (954) 421-0425


LB #4298

JOHN R. MORGAN II, PSM
FLORIDA CERTIFICATION #3520


CERTIFICATE OF SURVEYOR - I HEREBY CERTIFY THAT THE INFORMATION SHOWN HEREON IS IN ACCORDANCE WITH A RECENT FIELD SURVEY MADE UNDER MY DIRECTION, AND THAT IT IS TRUE AND CORRECT TO THE BEST OF MY KNOWLEDGE AND BELIEF, AND MEETS THE STANDARDS OF PRACTICE AS SET FORTH BY THE FLORIDA BOARD OF PROFESSIONAL LAND SURVEYORS IN CHAPTER 34-17, FLORIDA ADMINISTRATIVE CODE, PURSUANT TO SECTION 472.027, FLORIDA STATUTES.

JOHN R. MORGAN II, PLS
PROFESSIONAL LAND SURVEYOR #3520
STATE OF FLORIDA


ELEVATION DATA (MLLW -10' PROJECT)					COMMISSION NO.
DIVER INVESTIGATION SURVEY OF POTENTIAL BURIED UTILITIES					5303.16
INTRACOASTAL WATERWAY, CUT PB-36 THROUGH PB-41					SCALE AS SHOWN
PALM BEACH COUNTY, FLORIDA FOR TAYLOR ENGINEERING, INC.					DATE 3/6/18
DRAWN BY LFP	CHECKED BY JRM	FIELD BOOK PAGE NO.	SEE COVER	DATE OF SURVEY 2/15/18	SHEET 3 OF 22

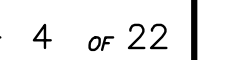

DRAWN BY LFP	CHECKED BY JRM	FIELD BOOK PAGE NO.	SEE COVER	DATE OF SURVEY 2/15/18	SHEET 4 OF 22
-----------------	-------------------	------------------------	--------------	---------------------------	---------------

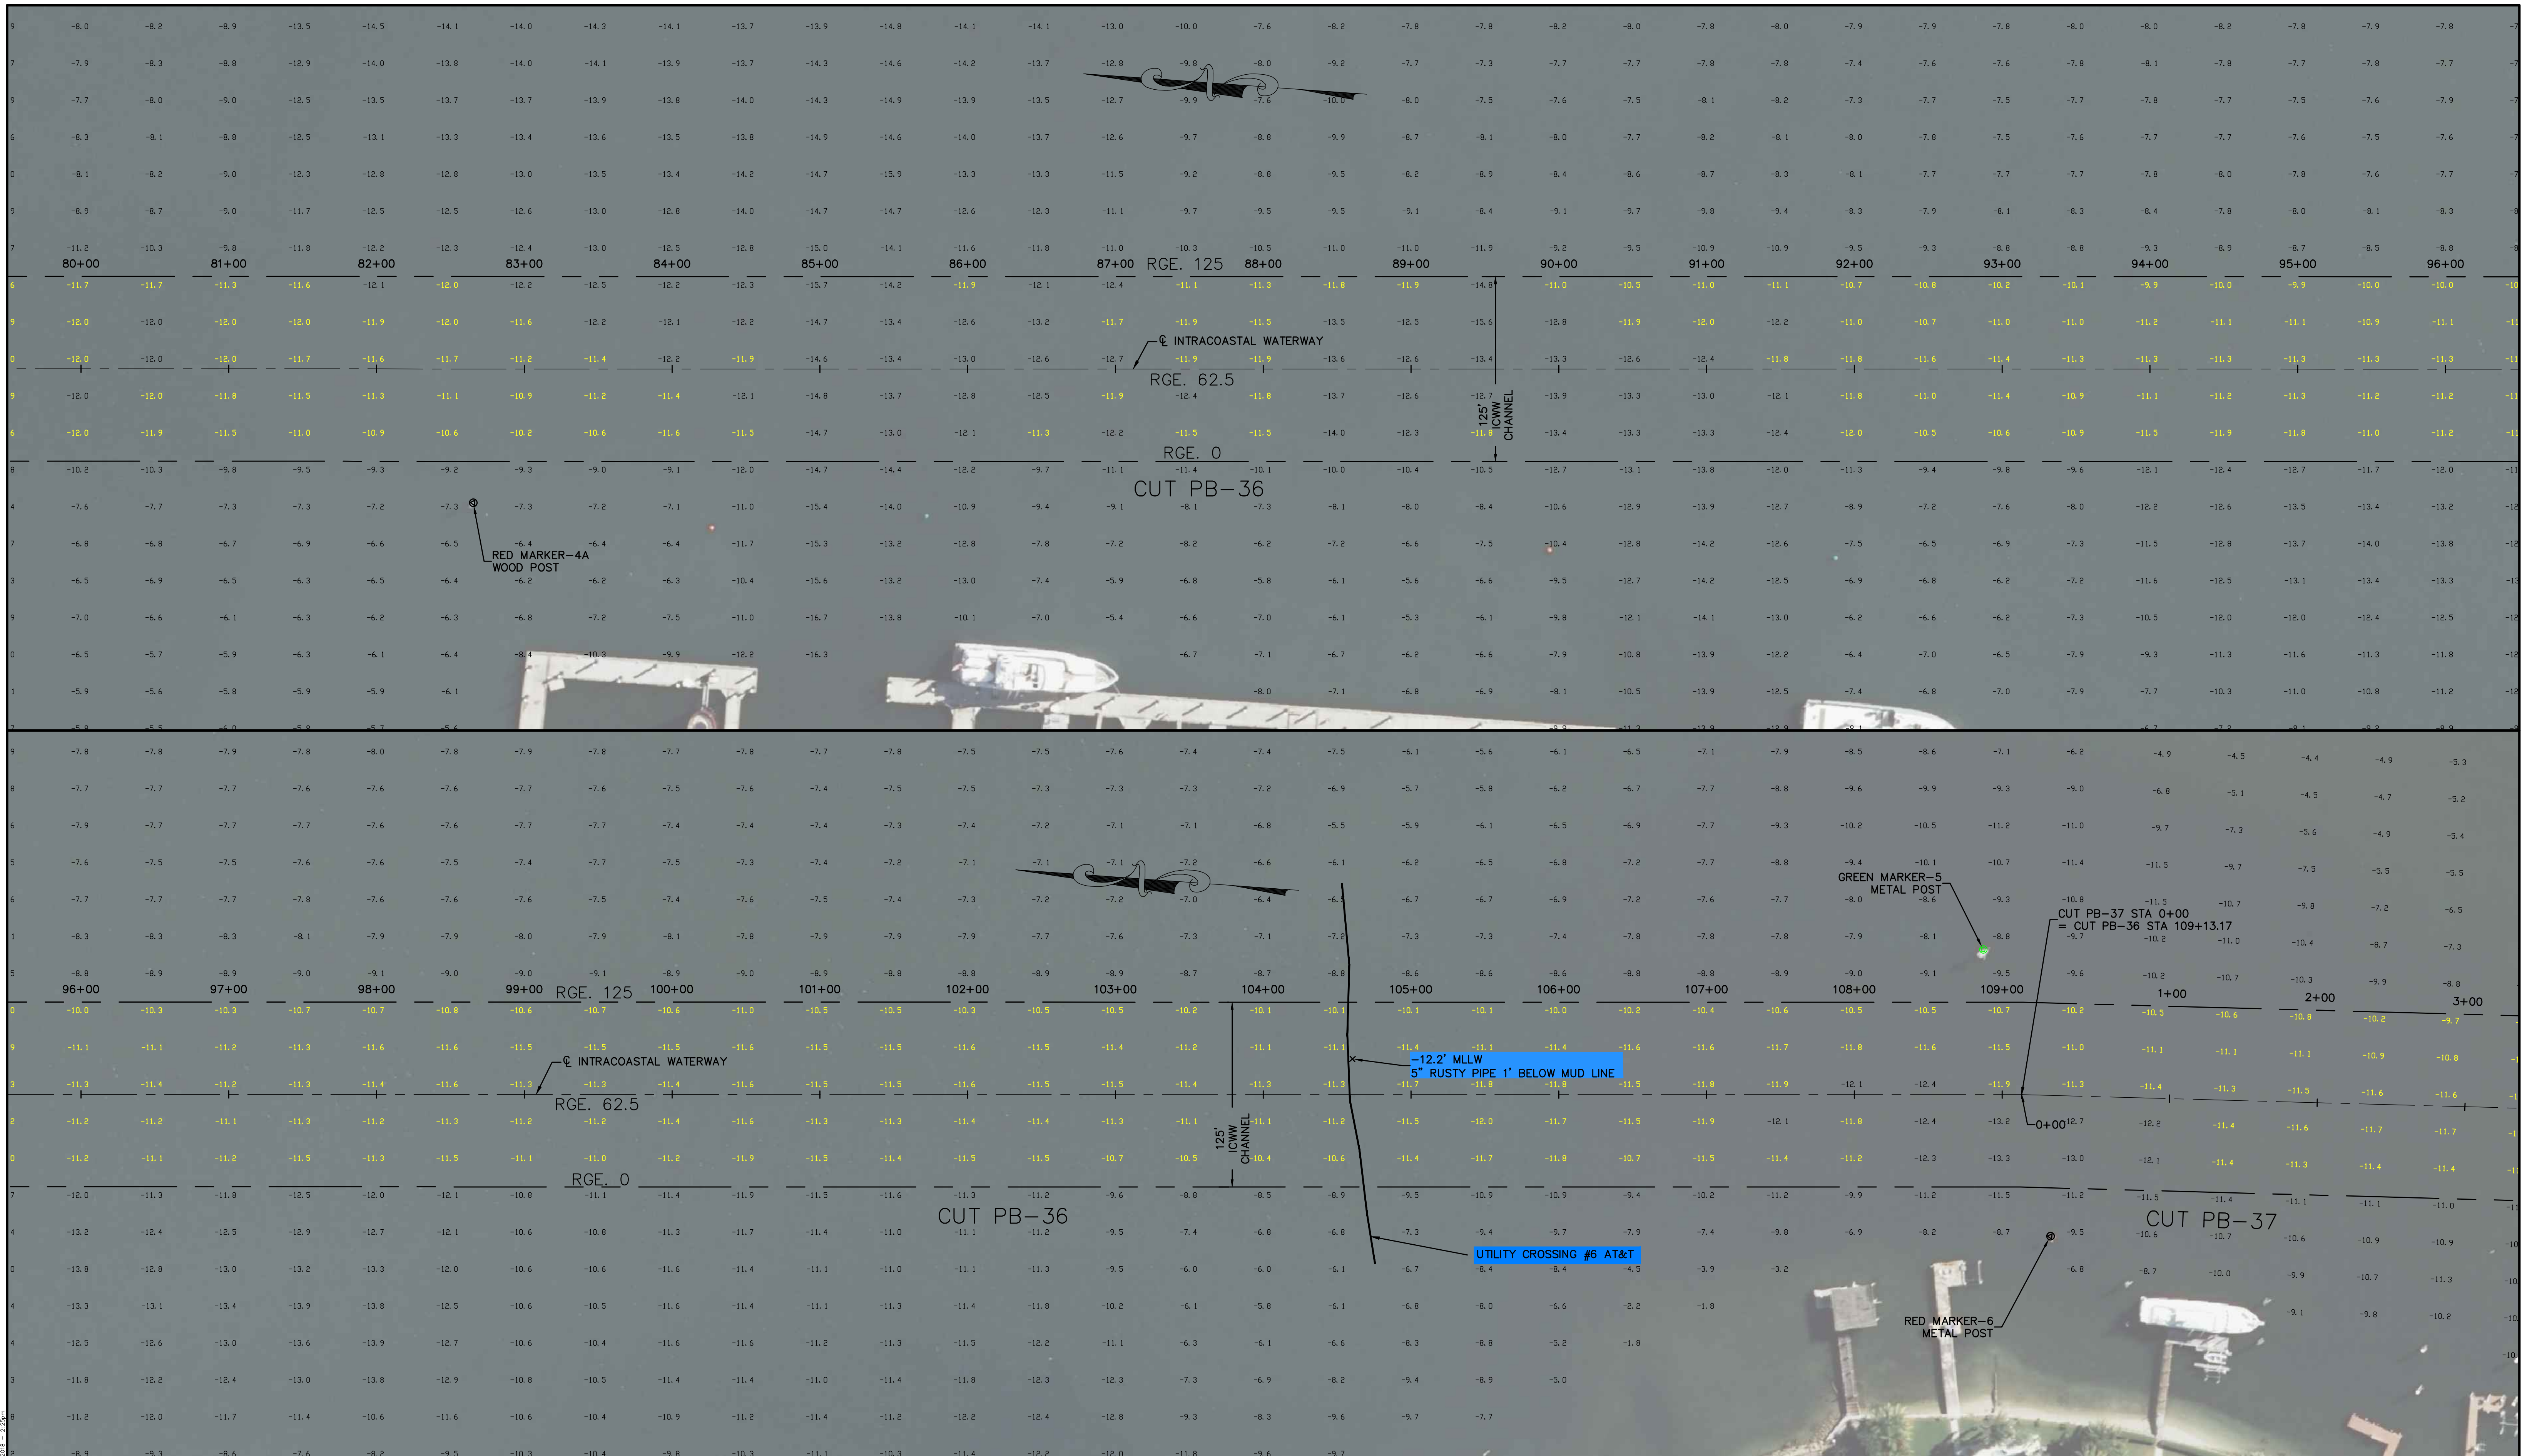

11. Jan. 2018 - 2.24pm

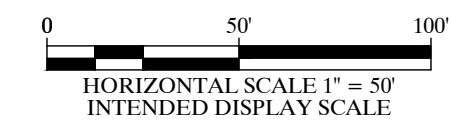

LEGEND

- TRENCHED TO -17.5 MLLW
NO UTILITIES ENCOUNTERED
- FOUND UTILITY LINE
- NOT INVESTIGATED
- PWC-PROCEED WITH CAUTION



JOHN R. MORGAN II, PSM
FLORIDA CERTIFICATION #3520

Morgan & Eklund Inc.

PROFESSIONAL SURVEY CONSULTANTS

4909 US HIGHWAY #1
VERO BEACH, FL 32967
PHONE: (772) 388-5364
FAX: (772) 388-3165


1612 NW 2ND AVENUE
SUITE 3
BOCA RATON, FL 33432
PHONE: (954) 421-6682
FAX: (954) 421-0425

LB #4298


CERTIFICATE OF SURVEYOR - I HEREBY CERTIFY THAT THE INFORMATION SHOWN HEREON IS IN ACCORDANCE WITH A RECENT FIELD SURVEY MADE UNDER MY DIRECTION, AND THAT IT IS TRUE AND CORRECT TO THE BEST OF MY KNOWLEDGE AND BELIEF, AND MEETS THE STANDARDS OF PRACTICE AS SET FORTH BY THE FLORIDA BOARD OF PROFESSIONAL LAND SURVEYORS IN CHAPTER 36-17, FLORIDA ADMINISTRATIVE CODE, PURSUANT TO SECTION 472.027, FLORIDA STATUTES.

JOHN R. MORGAN II, PLS
PROFESSIONAL LAND SURVEYOR #3520
STATE OF FLORIDA

ELEVATION DATA (MLLW -10' PROJECT)				COMMISSION NO. 5303.16	
DIVER INVESTIGATION SURVEY OF POTENTIAL BURIED UTILITIES				SCALE AS SHOWN	
INTRACOASTAL WATERWAY, CUT PB-36 THROUGH PB-41				DATE 3/6/18	
PALM BEACH COUNTY, FLORIDA				SHEET 5 OF 22	
FOR TAYLOR ENGINEERING, INC.					
DRAWN BY	CHECKED BY	FIELD BOOK	SEE	DATE OF SURVEY	
LFP	JRM	PAGE NO.	COVER	2/15/18	

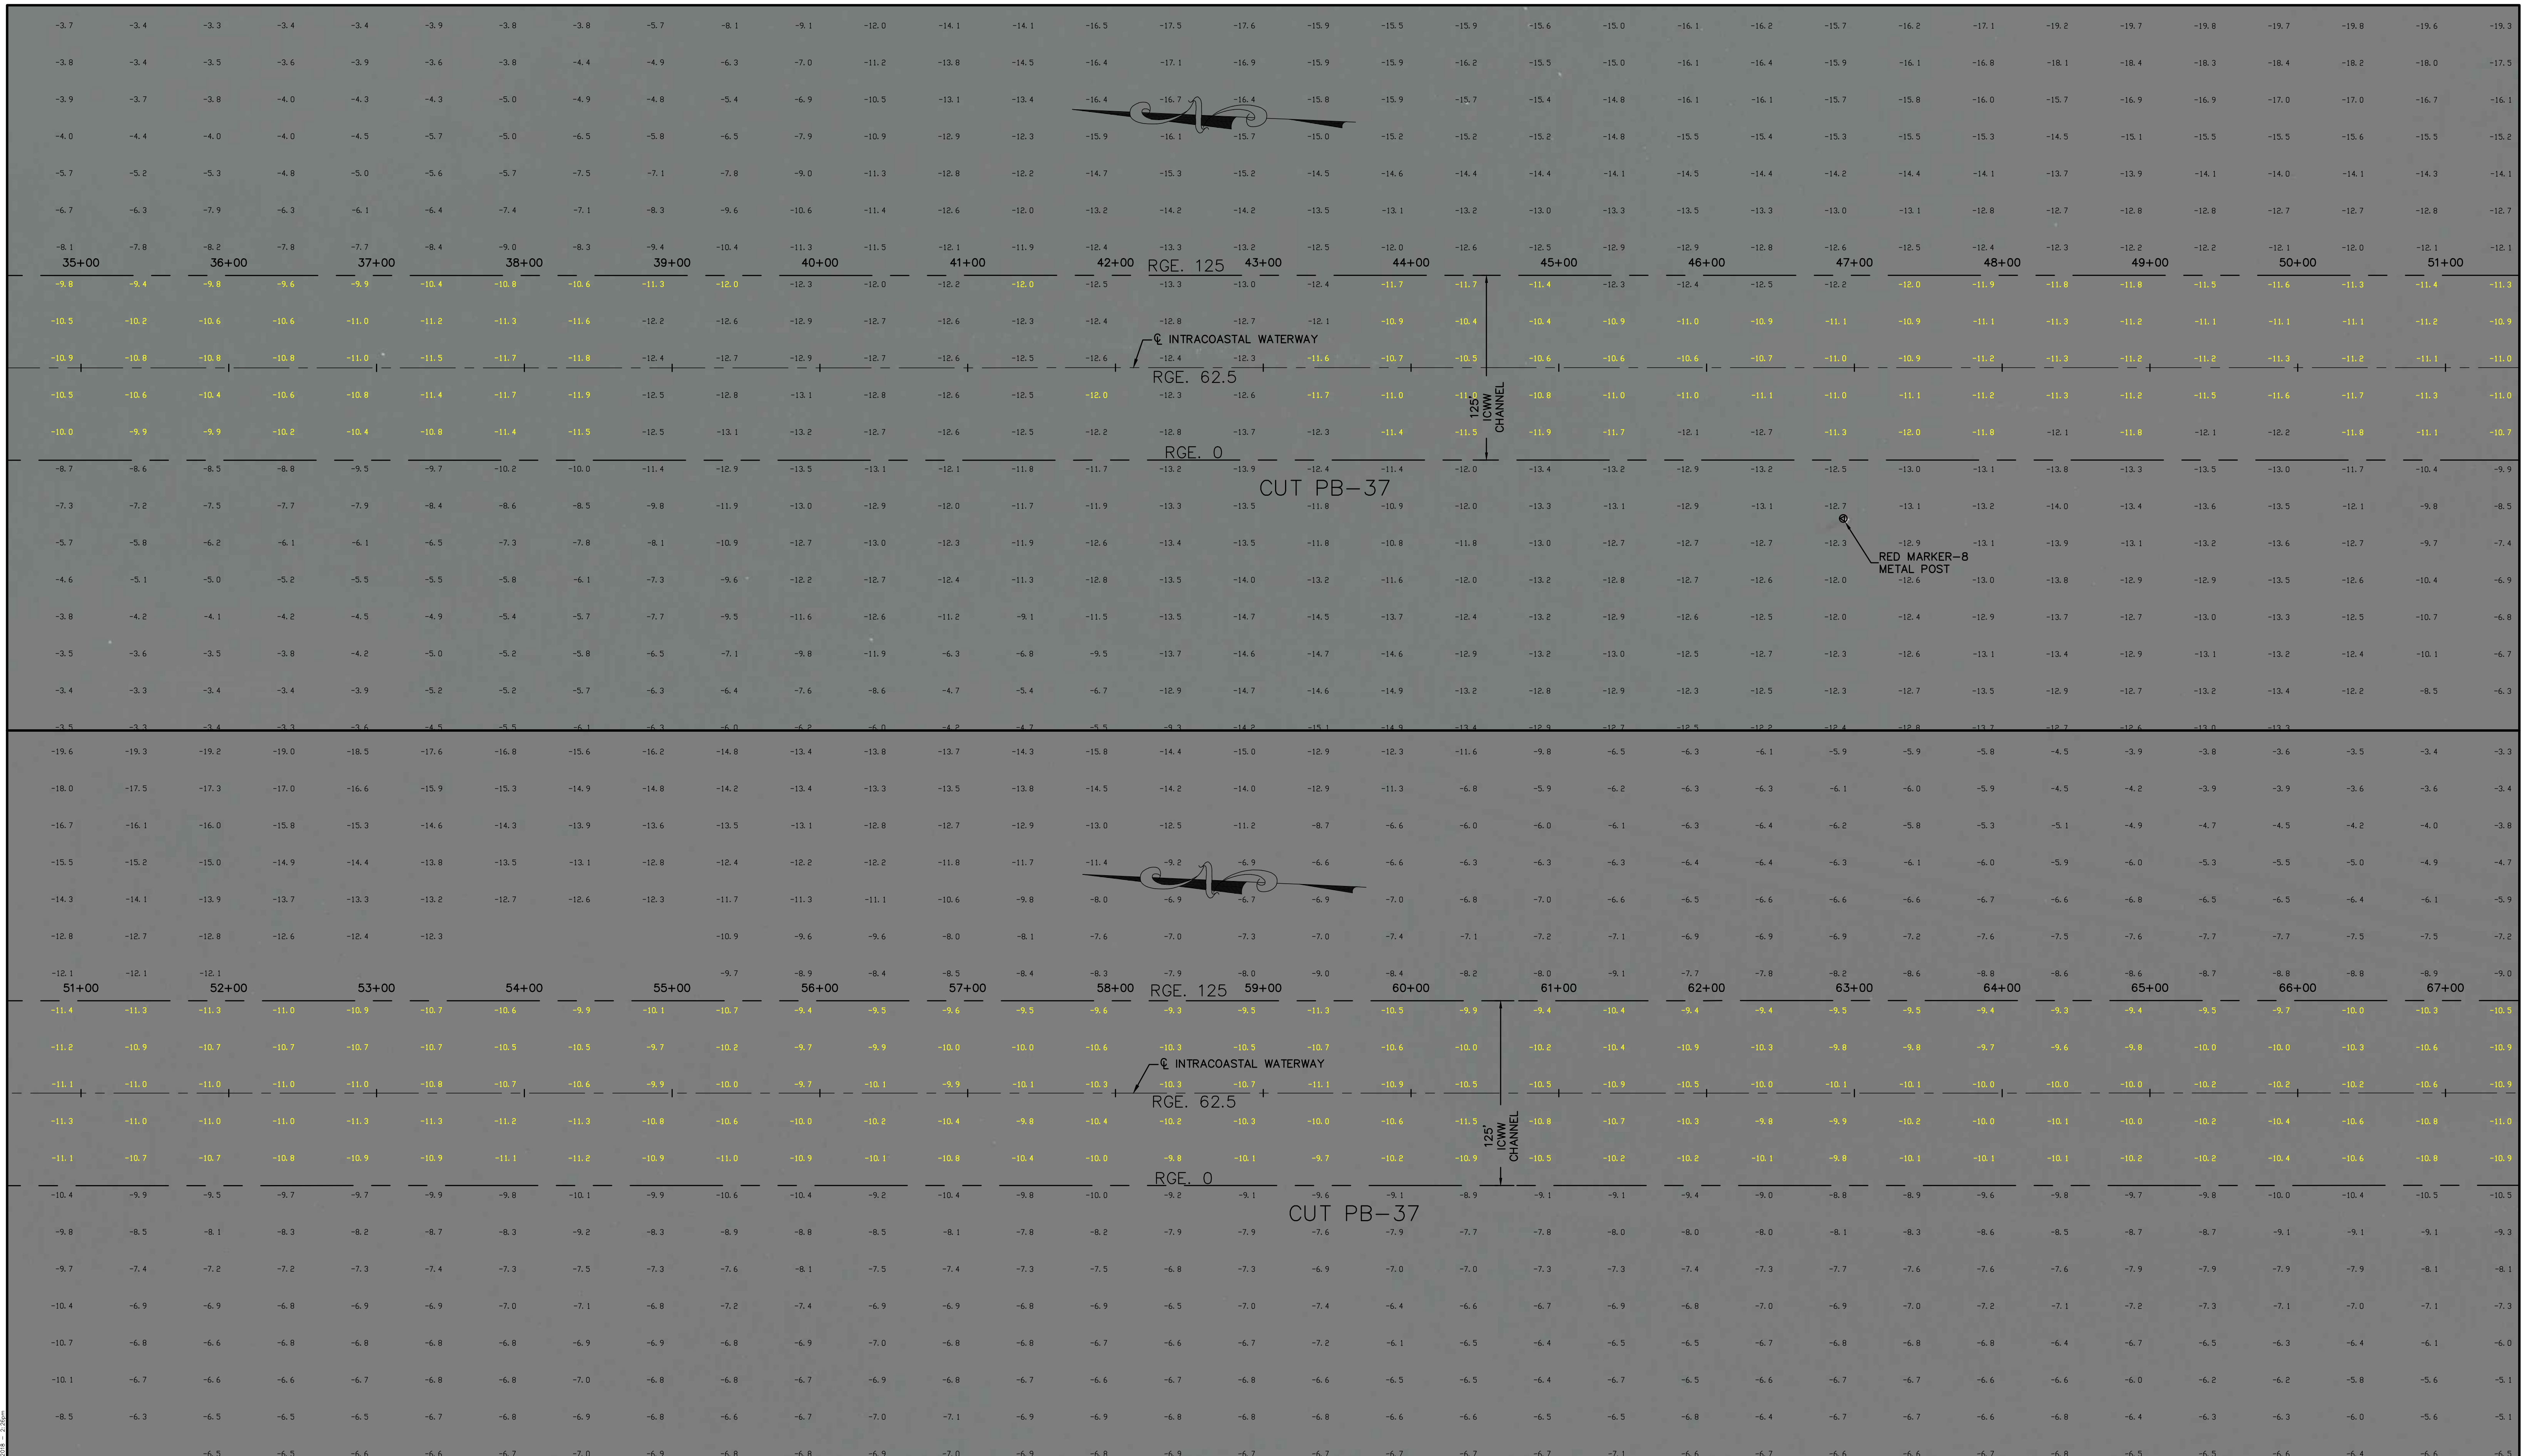

U:\Surveying\3520-16\DWG\3520-16.dwg, Job No. 3520, 11-Jan-2018, 2:29pm

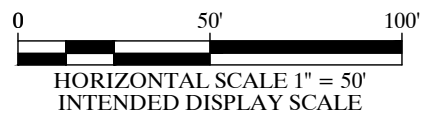

- LEGEND
- TRENCHED TO -17.5 MLLW
NO UTILITIES ENCOUNTERED
 - FOUND UTILITY LINE
 - NOT INVESTIGATED
 - PWC-PROCEED WITH CAUTION

Morgan & Eklund Inc.
PROFESSIONAL SURVEY CONSULTANTS

4909 US HIGHWAY #1
VERO BEACH, FL 32967
PHONE: (772) 388-5364
FAX: (772) 388-3165

1612 NW 2ND AVENUE
SUITE 3
BOCA RATON, FL 33432
PHONE: (954) 421-6682
FAX: (954) 421-0425

LB #4298

CERTIFICATE OF SURVEYOR - I HEREBY CERTIFY THAT THE INFORMATION SHOWN HEREON IS IN ACCORDANCE WITH A RECENT FIELD SURVEY MADE UNDER MY DIRECTION, AND THAT IT IS TRUE AND CORRECT TO THE BEST OF MY KNOWLEDGE AND BELIEF, AND MEETS THE STANDARDS OF PRACTICE AS SET FORTH BY THE FLORIDA BOARD OF PROFESSIONAL LAND SURVEYORS IN CHAPTER 35-17, FLORIDA ADMINISTRATIVE CODE, PURSUANT TO SECTION 472.027, FLORIDA STATUTES.

JOHN R. MORGAN, II, PSM
FLORIDA CERTIFICATION #3520

ELEVATION DATA (MLLW -10' PROJECT)

DIVER INVESTIGATION SURVEY OF POTENTIAL BURIED UTILITIES


INTRACOASTAL WATERWAY, CUT PB-36 THROUGH PB-41

PALM BEACH COUNTY, FLORIDA

FOR TAYLOR ENGINEERING, INC.

DRAWN BY	CHECKED BY	FIELD BOOK	SEE	DATE OF SURVEY
LFP	JRM	PAGE NO.	COVER	2/15/18

COMMISSION NO.	SCALE
5303.16	AS SHOWN
DATE	
3/6/18	
SHEET	7 OF 22

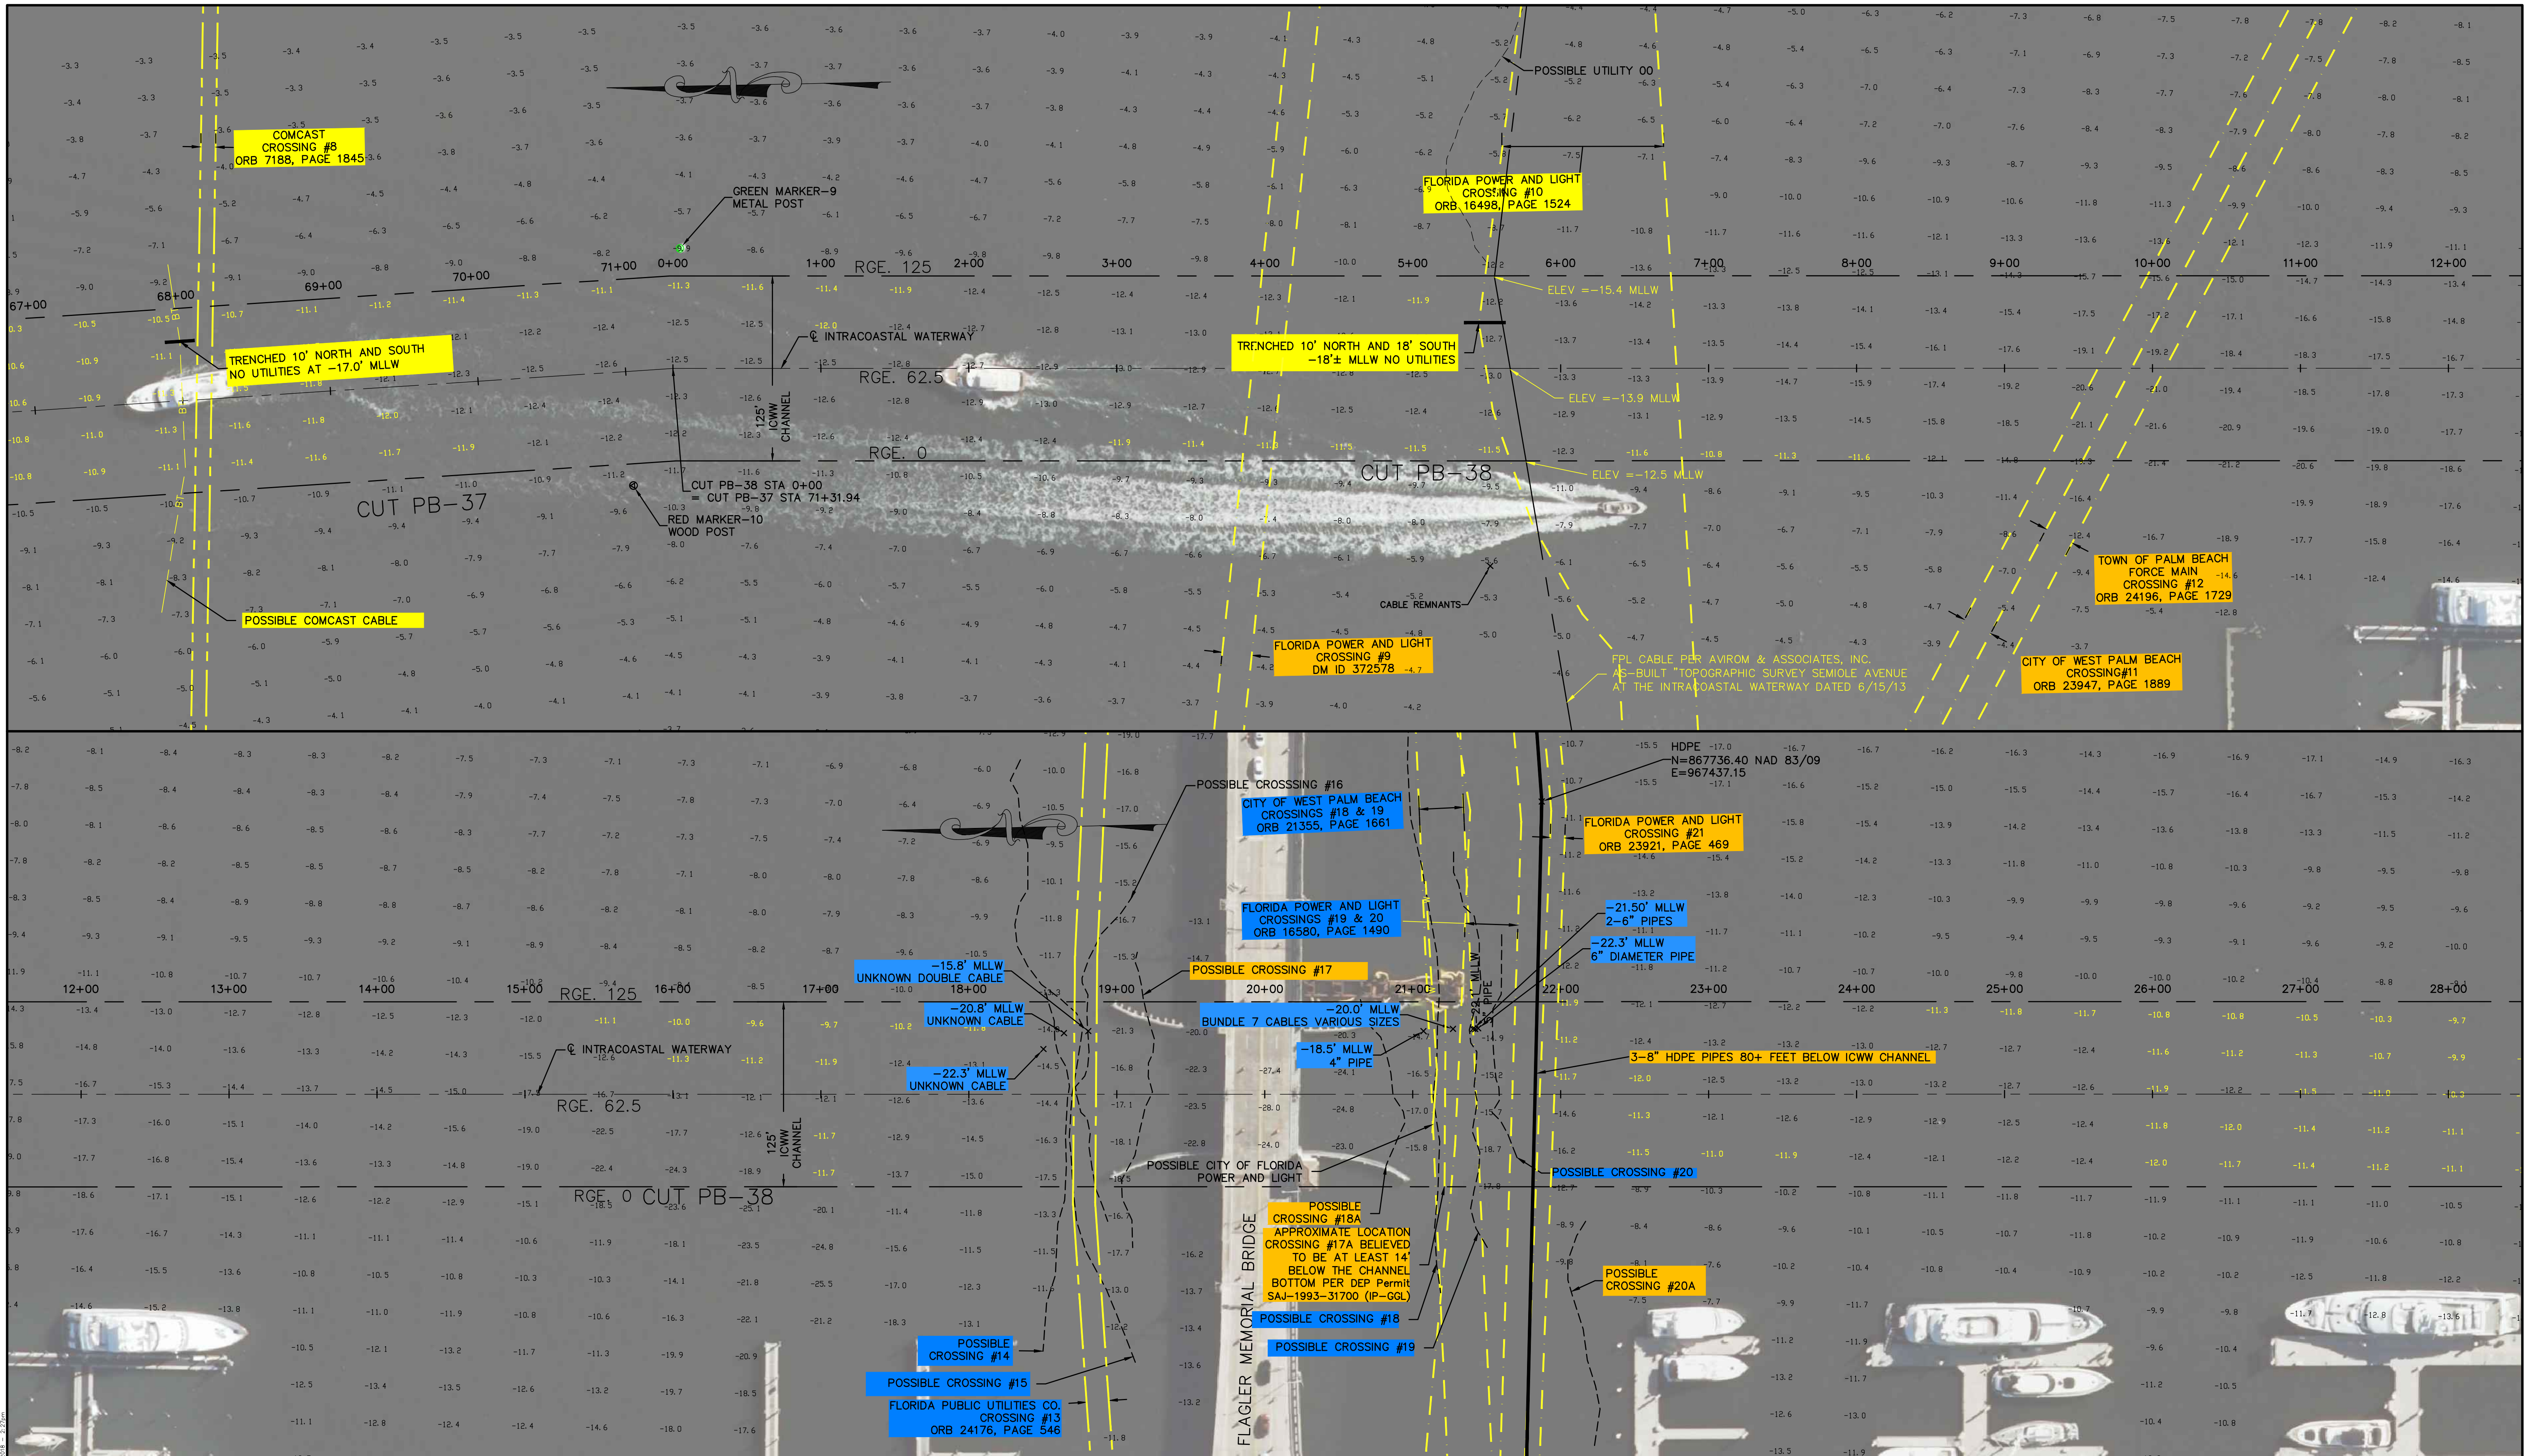

0 50' 100'

HORIZONTAL SCALE 1" = 50'

INTENDED DISPLAY SCALE

LEGEND

- TRENCHED TO -17.5 MLLW NO UTILITIES ENCOUNTERED
- FOUND UTILITY LINE
- NOT INVESTIGATED
- PWC-PROCEED WITH CAUTION

Morgan & Eklund Inc.

PROFESSIONAL SURVEY CONSULTANTS

4909 US HIGHWAY #1
VERO BEACH, FL 32967
PHONE: (772) 388-5364
FAX: (772) 388-3165

1612 NW 2ND AVENUE
SUITE 3
BOCA RATON, FL 33432
PHONE: (954) 421-6682
FAX: (954) 421-0425

LB #4298

CERTIFICATE OF SURVEYOR - I HEREBY CERTIFY THAT THE INFORMATION SHOWN HEREON IS IN ACCORDANCE WITH A RECENT FIELD SURVEY MADE UNDER MY DIRECTION, AND THAT IT IS TRUE AND CORRECT TO THE BEST OF MY KNOWLEDGE AND BELIEF, AND MEETS THE STANDARDS OF PRACTICE AS SET FORTH BY THE FLORIDA BOARD OF PROFESSIONAL LAND SURVEYORS IN CHAPTER 36-17, FLORIDA ADMINISTRATIVE CODE, PURSUANT TO SECTION 472.027, FLORIDA STATUTES.

JOHN R. MORGAN, II, PLS
PROFESSIONAL LAND SURVEYOR #3520
STATE OF FLORIDA

ELEVATION DATA (MLLW -10' PROJECT)

DIVER INVESTIGATION SURVEY OF POTENTIAL BURIED UTILITIES

INTRACOASTAL WATERWAY, CUT PB-36 THROUGH PB-41


PALM BEACH COUNTY, FLORIDA

FOR TAYLOR ENGINEERING, INC.

DRAWN BY	CHECKED BY	FIELD BOOK	SEE	DATE OF SURVEY
LFP	JRM	PAGE NO.	COVER	2/15/18



COMMISSION NO.	SCALE	DATE
5303.16	AS SHOWN	3/6/18

SHEET 8 OF 22

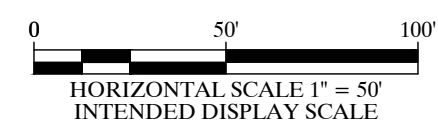

TRENCHED TO -17.5 MLLW
NO UTILITIES ENCOUNTERED
FOUND UTILITY LINE
NOT INVESTIGATED
PWC-PROCEED WITH CAUTION

COMMISSION NO.	5303.16
SCALE	AS SHOWN
DATE	3/6/18

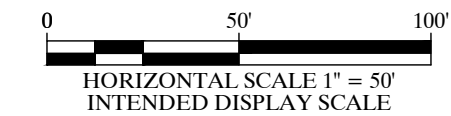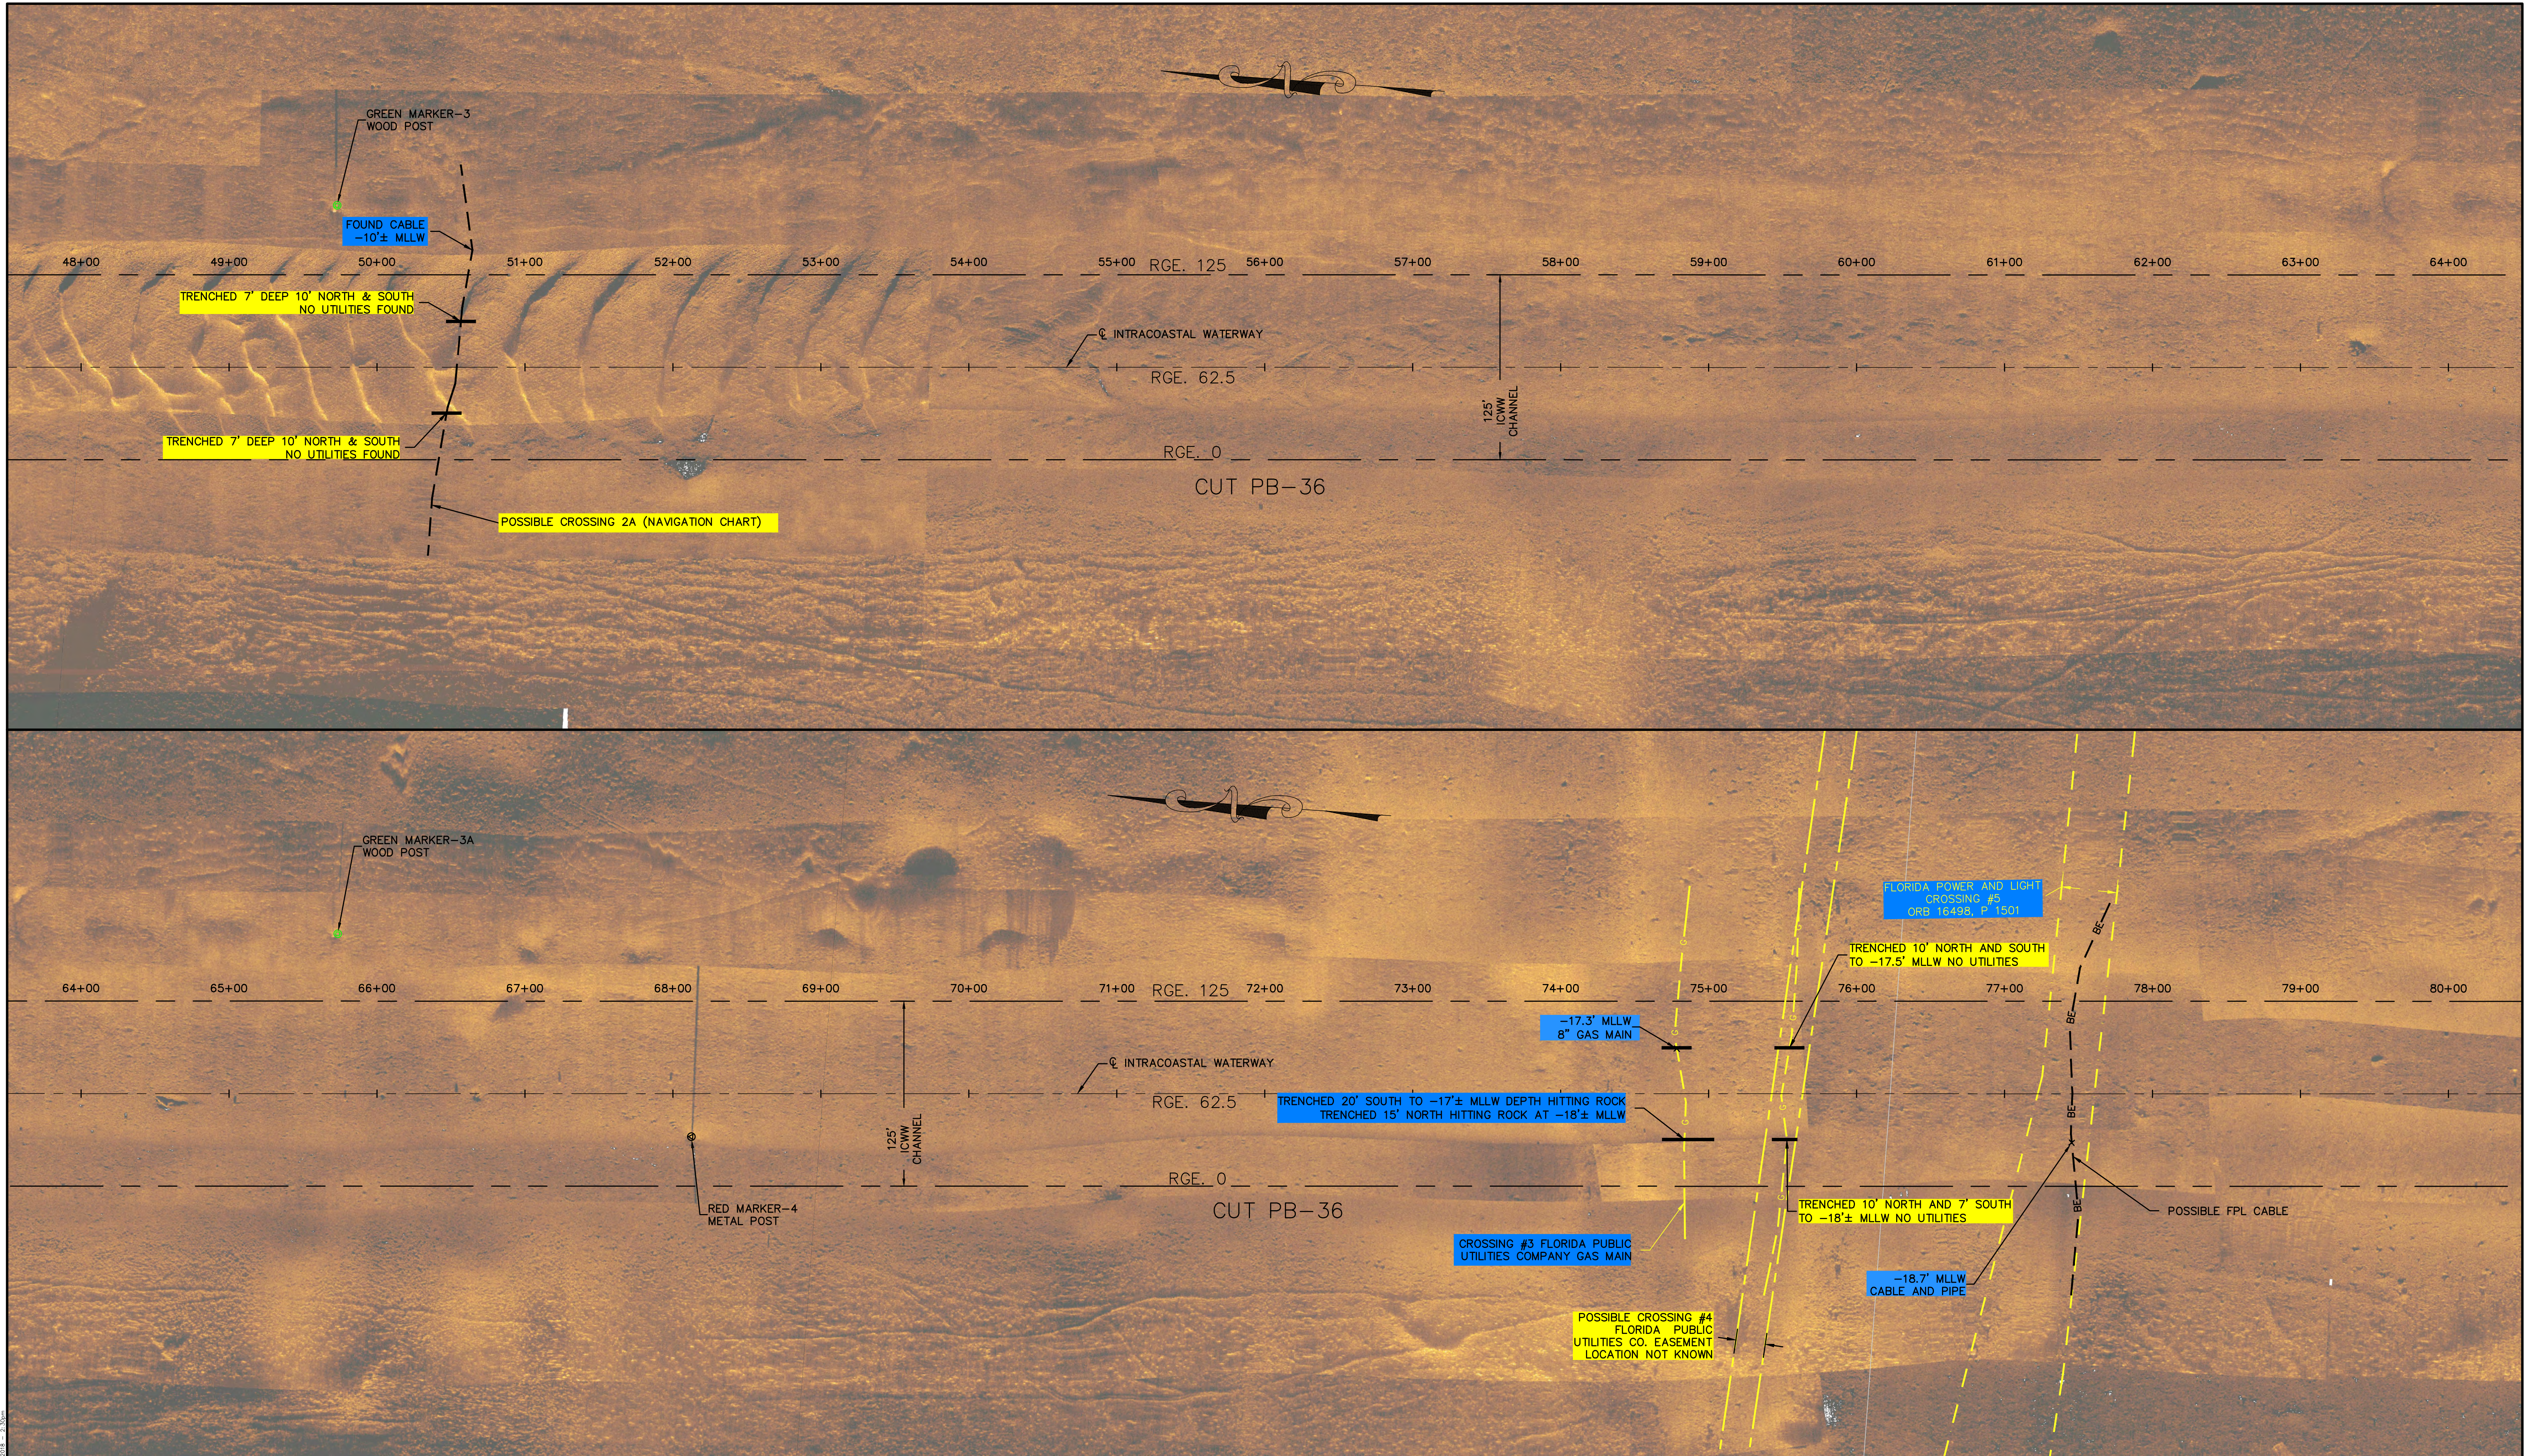

LEGEND	
TRENCHED TO -17.5 MLLW NO UTILITIES ENCOUNTERED	
FOUND UTILITY LINE	
NOT INVESTIGATED	
PWC-PROCEED WITH CAUTION	

Morgan & Eklund Inc.
PROFESSIONAL SURVEY CONSULTANTS

4909 US HIGHWAY #1
VERO BEACH, FL 32967
PHONE: (772) 388-5364
FAX: (772) 388-3165

1612 NW 2ND AVENUE
SUITE 3
BOCA RATON, FL 33432
PHONE: (954) 421-6682
FAX: (954) 421-0425



JOHN R. MORGAN II, PSM
FLORIDA CERTIFICATION #3520

LB #4298


CERTIFICATE OF SURVEYOR - I HEREBY CERTIFY THAT THE INFORMATION SHOWN HEREON IS IN ACCORDANCE WITH A RECENT FIELD SURVEY MADE UNDER MY DIRECTION, AND THAT IT IS TRUE AND CORRECT TO THE BEST OF MY KNOWLEDGE AND BELIEF, AND MEETS THE STANDARDS OF PRACTICE AS SET FORTH BY THE FLORIDA BOARD OF PROFESSIONAL LAND SURVEYORS IN CHAPTER 36-17, FLORIDA ADMINISTRATIVE CODE, PURSUANT TO SECTION 472.027, FLORIDA STATUTES.

JOHN R. MORGAN II, PLS
PROFESSIONAL LAND SURVEYOR #3520
STATE OF FLORIDA

SONAR MOSAICS					COMMISSION NO.
DIVER INVESTIGATION SURVEY OF POTENTIAL BURIED UTILITIES					5303.16
INTRACOASTAL WATERWAY, CUT PB-36 THROUGH PB-41					SCALE
PALM BEACH COUNTY, FLORIDA					AS SHOWN
FOR TAYLOR ENGINEERING, INC.					DATE
					3/6/18
DRAWN BY	CHECKED BY	FIELD BOOK	SEE	DATE OF SURVEY	SHEET 12 OF 22
LFP	JRM	PAGE NO.	COVER	2/15/18	

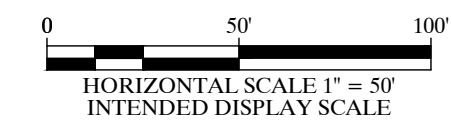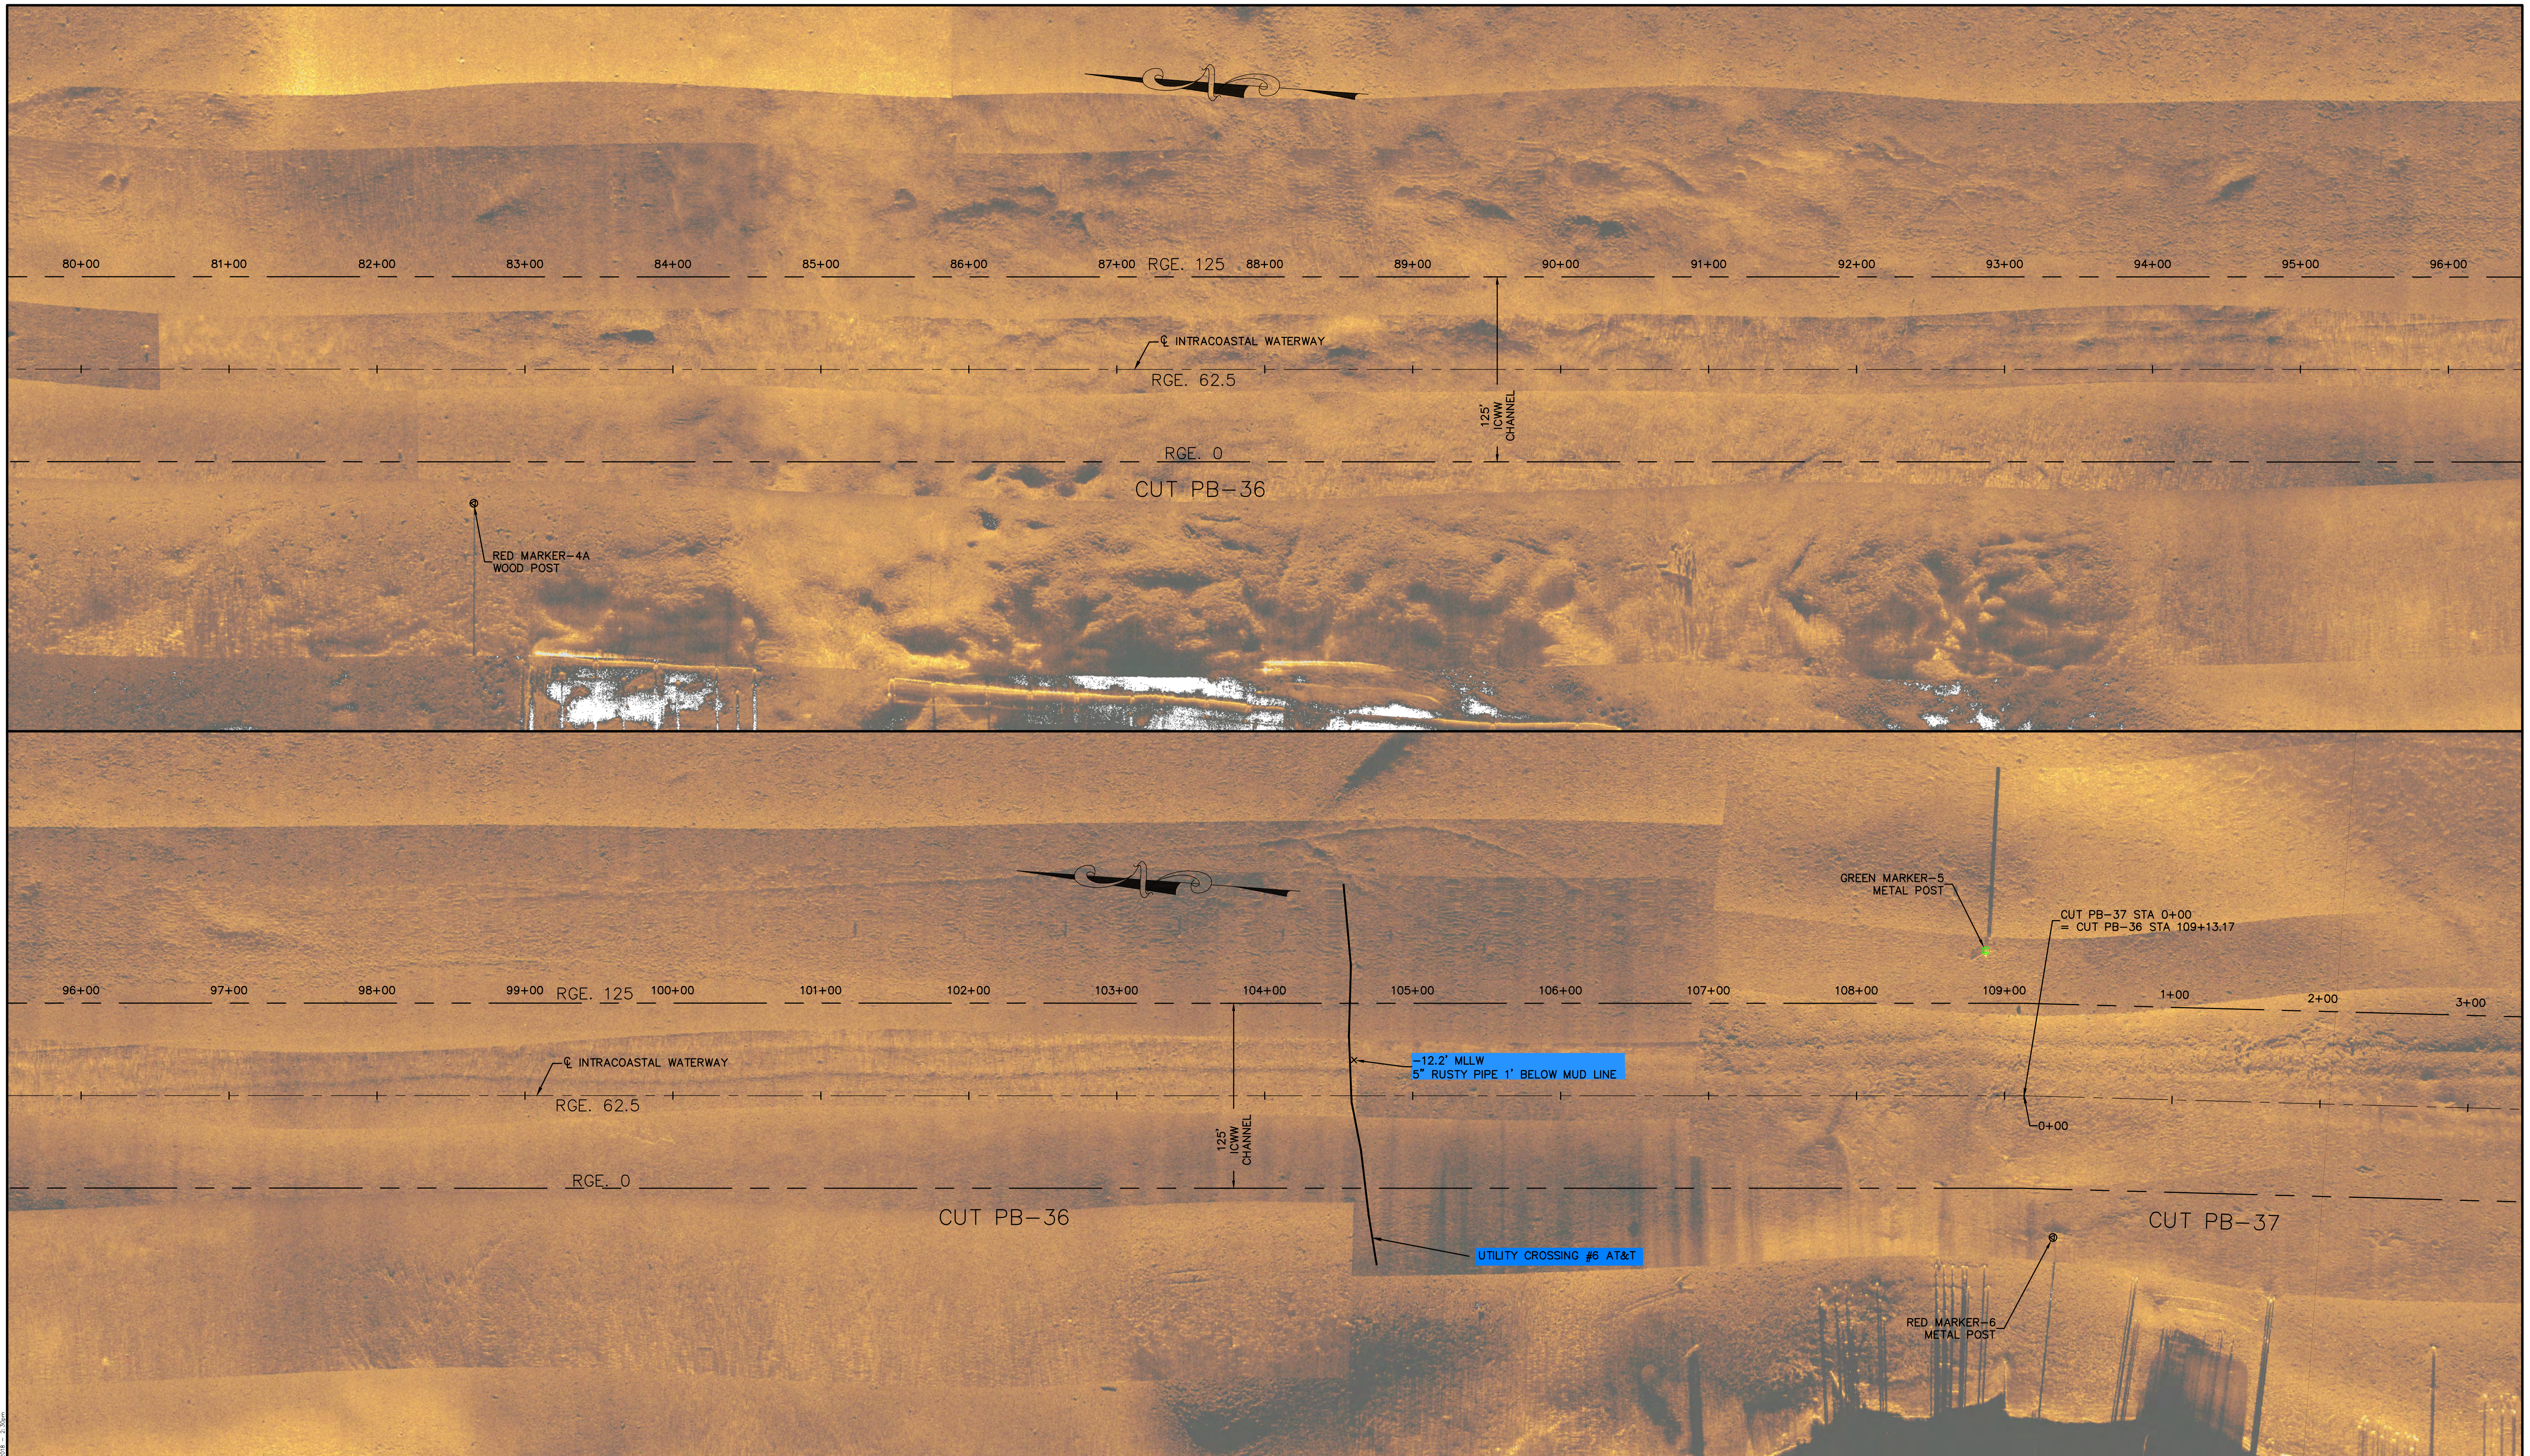

LEGEND	
TRENCHED TO -17.5 MLLW NO UTILITIES ENCOUNTERED	
FOUND UTILITY LINE	
NOT INVESTIGATED	
PWC-PROCEED WITH CAUTION	



Morgan & Eklund Inc.
PROFESSIONAL SURVEY CONSULTANTS

4909 US HIGHWAY #1
VERO BEACH, FL 32967
PHONE: (772) 388-5364
FAX: (772) 388-3165

1612 NW 2ND AVENUE
SUITE 3
BOCA RATON, FL 33432
PHONE: (954) 421-6682
FAX: (954) 421-0425


LB #4298

JOHN R. MORGAN II, PSM
FLORIDA CERTIFICATION #3520

CERTIFICATE OF SURVEYOR - I HEREBY CERTIFY THAT THE INFORMATION SHOWN HEREON IS IN ACCORDANCE WITH A RECENT FIELD SURVEY MADE UNDER MY DIRECTION, AND THAT IT IS TRUE AND CORRECT TO THE BEST OF MY KNOWLEDGE AND BELIEF, AND MEETS THE STANDARDS OF PRACTICE AS SET FORTH BY THE FLORIDA BOARD OF PROFESSIONAL LAND SURVEYORS IN CHAPTER 64-17, FLORIDA ADMINISTRATIVE CODE, PURSUANT TO SECTION 472.027, FLORIDA STATUTES.

JOHN R. MORGAN II, PLS
PROFESSIONAL LAND SURVEYOR #3520
STATE OF FLORIDA

SONAR MOSAICS					COMMISSION NO.
DIVER INVESTIGATION SURVEY OF POTENTIAL BURIED UTILITIES					5303.16
INTRACOASTAL WATERWAY, CUT PB-36 THROUGH PB-41					SCALE
PALM BEACH COUNTY, FLORIDA					AS SHOWN
FOR TAYLOR ENGINEERING, INC.					DATE
					3/6/18
DRAWN BY	CHECKED BY	FIELD BOOK	SEE	DATE OF SURVEY	SHEET 13 OF 22
LFP	JRM	PAGE NO.	COVER	2/15/18	

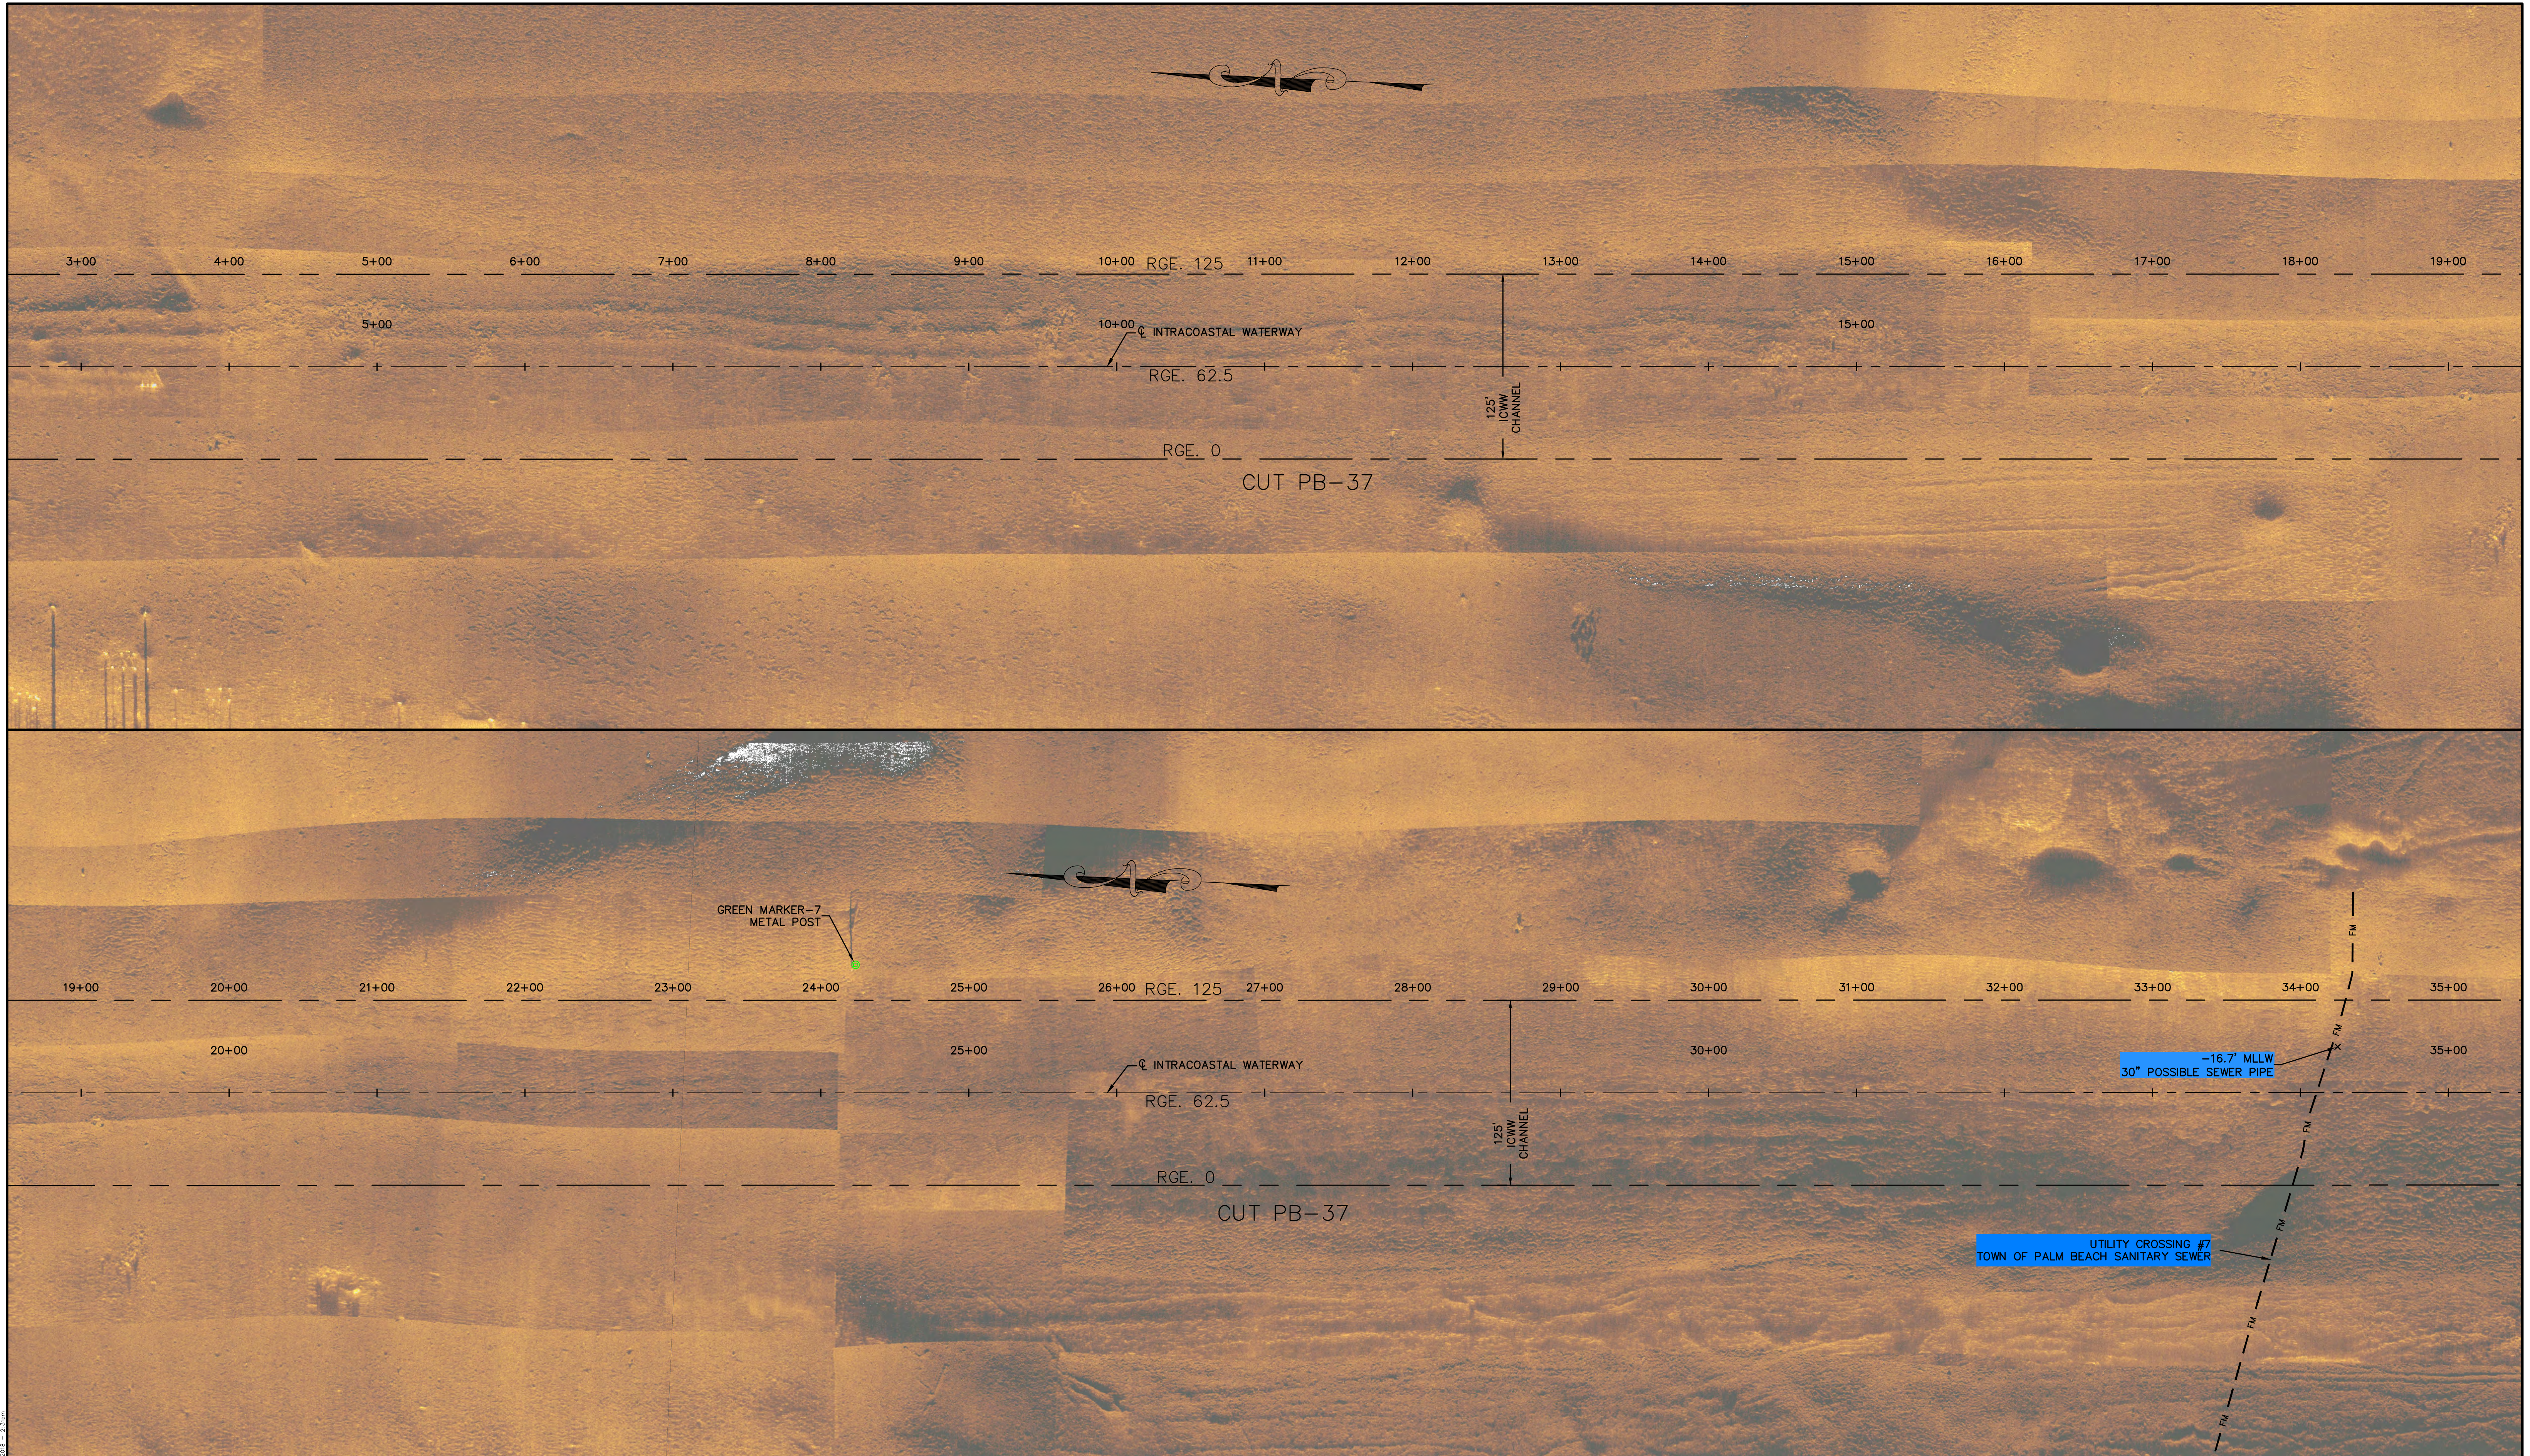

0 50' 100'

HORIZONTAL SCALE 1" = 50'

INTENDED DISPLAY SCALE

LEGEND

TRENCHED TO -17.5 MLLW
NO UTILITIES ENCOUNTERED

FOUND UTILITY LINE

NOT INVESTIGATED

PWC-PROCEED WITH CAUTION

Morgan & Eklund Inc.

PROFESSIONAL SURVEY CONSULTANTS

4909 US HIGHWAY #1
VERO BEACH, FL 32967
PHONE: (772) 388-5364
FAX: (772) 388-3165

1612 NW 2ND AVENUE
SUITE 3
BOCA RATON, FL 33432
PHONE: (954) 421-6682
FAX: (954) 421-0425

LB #4298

CERTIFICATE OF SURVEYOR - I HEREBY CERTIFY THAT THE INFORMATION SHOWN HEREON IS IN ACCORDANCE WITH A RECENT FIELD SURVEY MADE UNDER MY DIRECTION, AND THAT IT IS TRUE AND CORRECT TO THE BEST OF MY KNOWLEDGE AND BELIEF, AND MEETS THE STANDARDS OF PRACTICE AS SET FORTH BY THE FLORIDA BOARD OF PROFESSIONAL LAND SURVEYORS IN CHAPTER 63-17, FLORIDA ADMINISTRATIVE CODE, PURSUANT TO SECTION 472.027, FLORIDA STATUTES.

JOHN R. MORGAN, II, PLS
PROFESSIONAL LAND SURVEYOR #3520
STATE OF FLORIDA

SONAR MOSAICS

DIVER INVESTIGATION SURVEY OF POTENTIAL BURIED UTILITIES


INTRACOASTAL WATERWAY, CUT PB-36 THROUGH PB-41

PALM BEACH COUNTY, FLORIDA


FOR TAYLOR ENGINEERING, INC.

DRAWN BY	CHECKED BY	FIELD BOOK	SEE	DATE OF SURVEY	COMMISSION NO.
LFP	JRM	PAGE NO.	COVER	2/15/18	5303.16

SHEET 14 OF 22

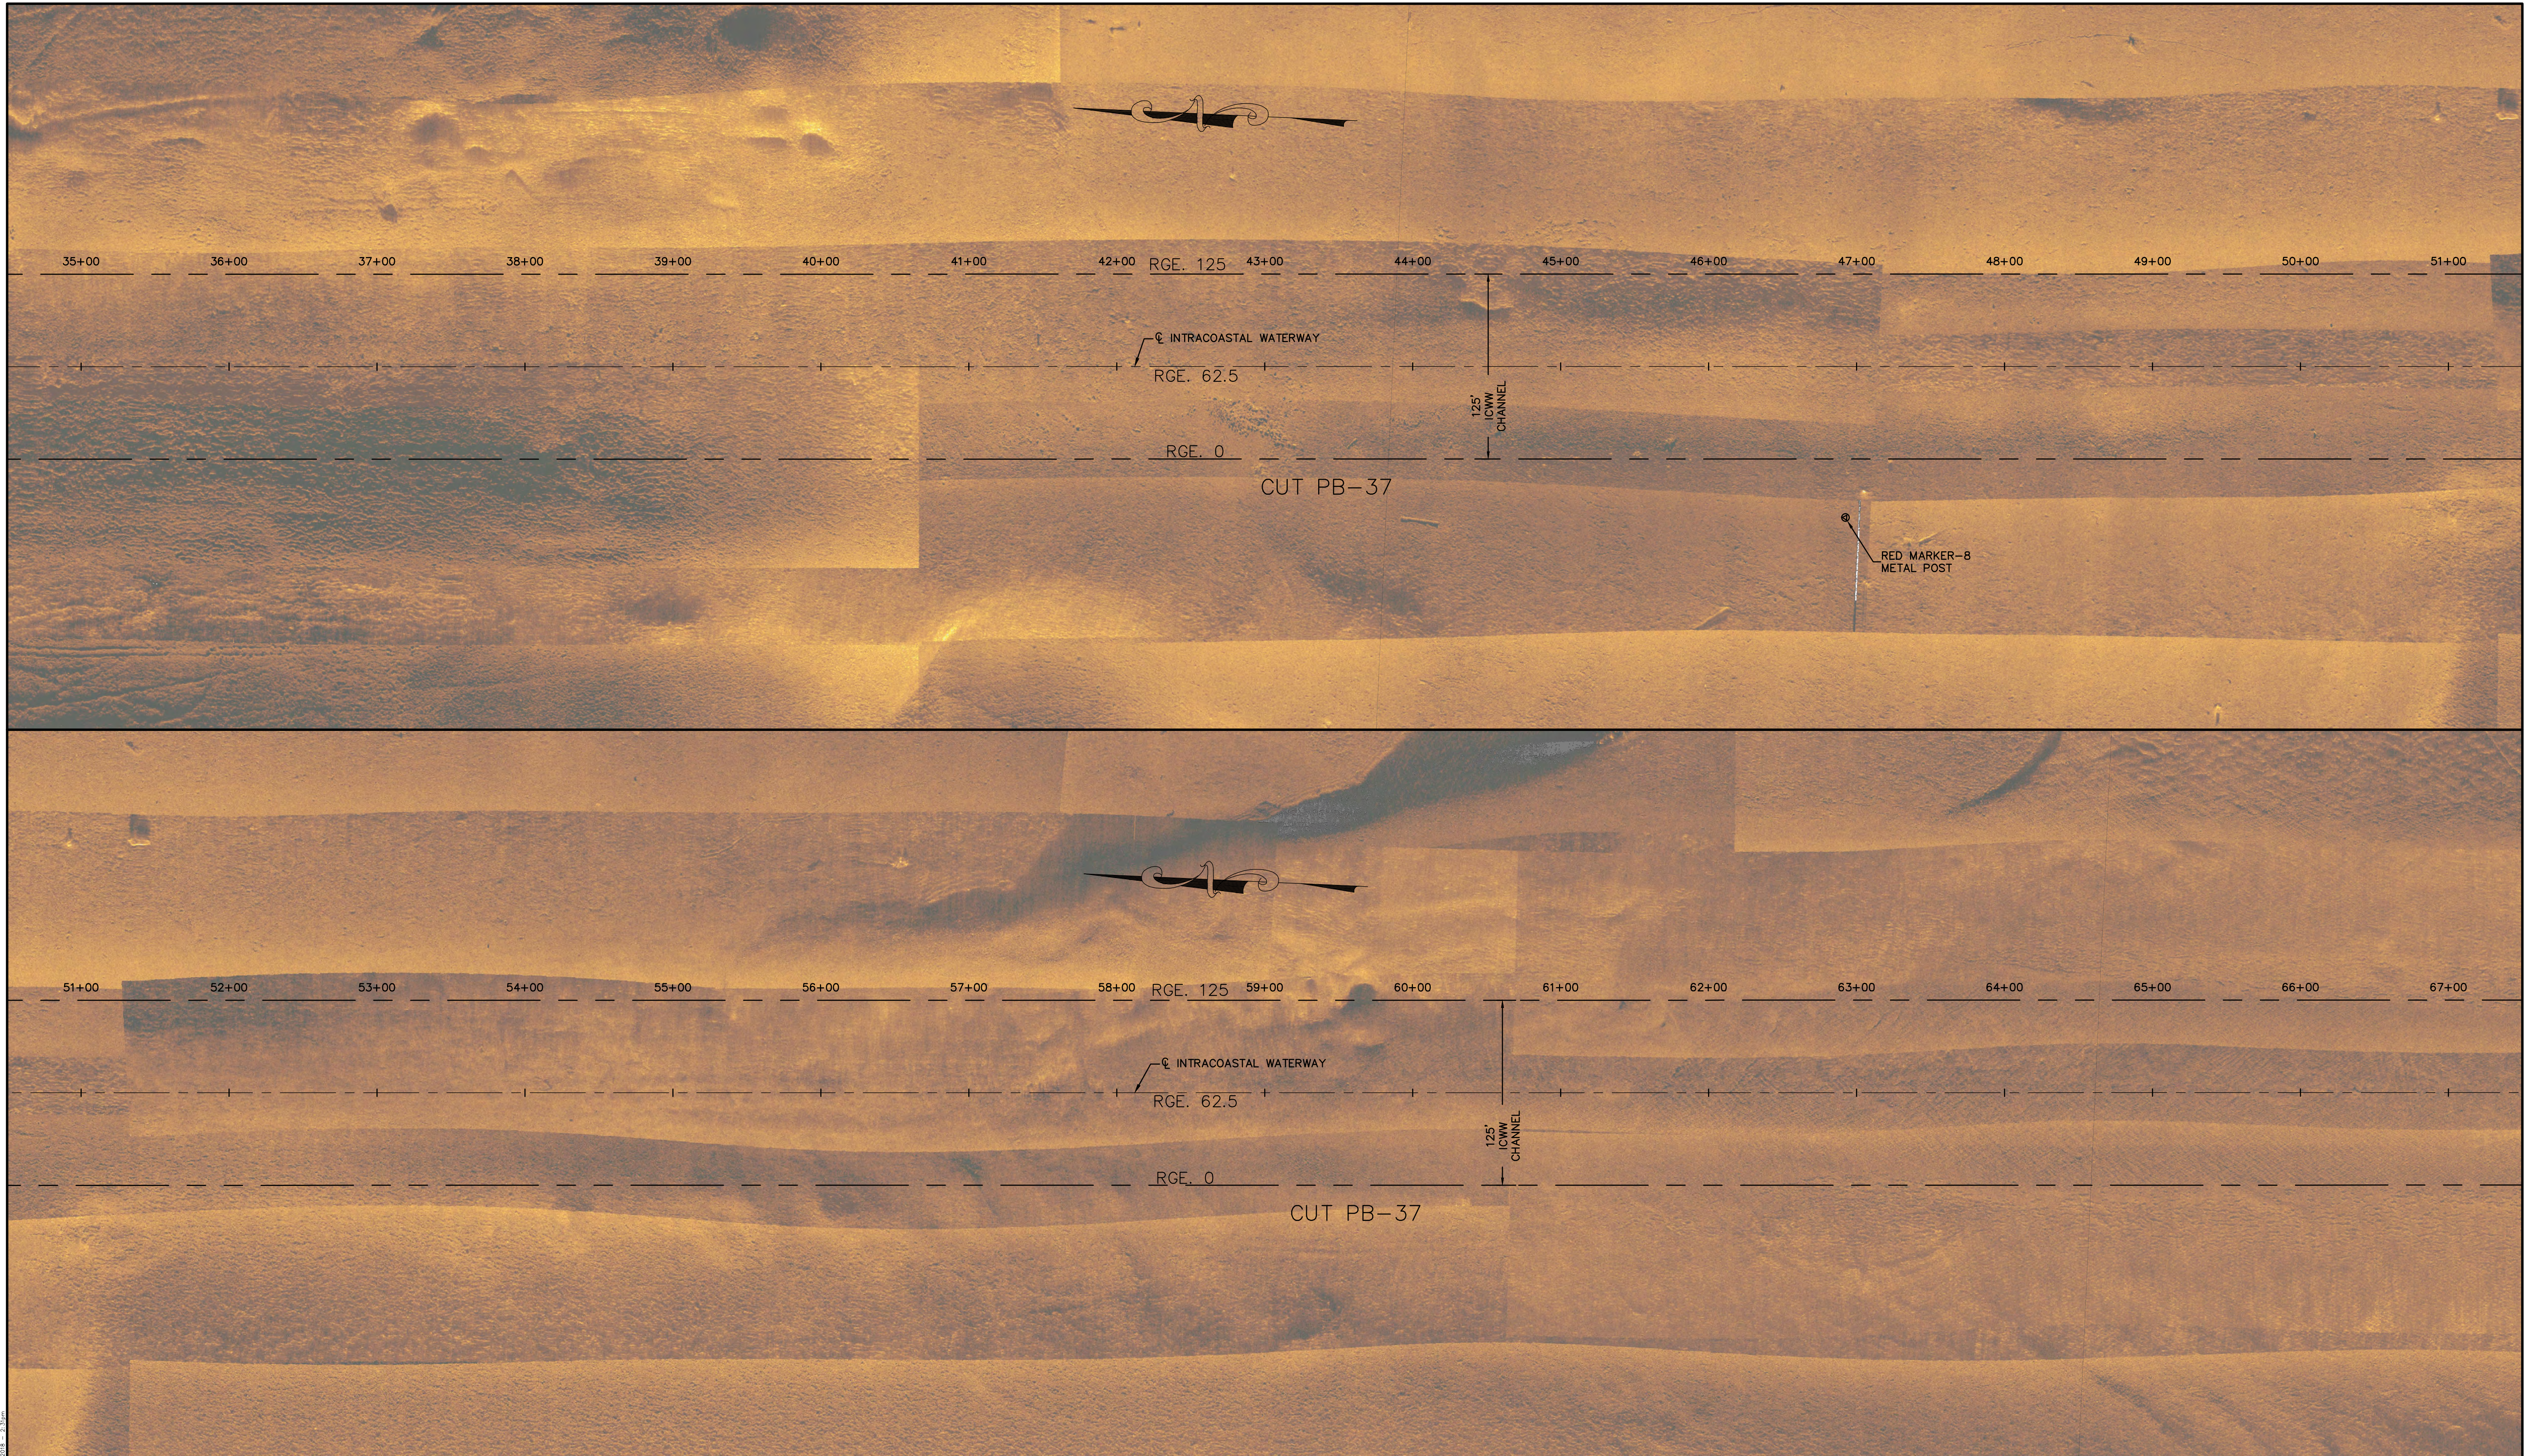

U:\Subarea\A301-16\DWG\A301-16.dwg, Job: Map, 11 Jan 2018, 2:27pm

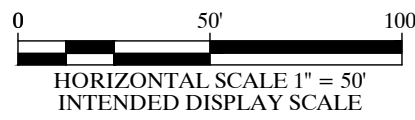

LEGEND

- TRENCHED TO -17.5 MLLW
NO UTILITIES ENCOUNTERED
- FOUND UTILITY LINE
- NOT INVESTIGATED
- PWC-PROCEED WITH CAUTION



JOHN R. MORGAN II, PSM
FLORIDA CERTIFICATION #3520

Morgan & Eklund Inc.

PROFESSIONAL SURVEY CONSULTANTS

4909 US HIGHWAY #1
VERO BEACH, FL 32967
PHONE: (772) 388-5364
FAX: (772) 388-3165

LB #4298

1612 NW 2ND AVENUE
SUITE 3
BOCA RATON, FL 33432
PHONE: (954) 421-6682
FAX: (954) 421-0425

CERTIFICATE OF SURVEYOR - I HEREBY CERTIFY THAT THE INFORMATION SHOWN HEREON IS IN ACCORDANCE WITH A RECENT FIELD SURVEY MADE UNDER MY DIRECTION, AND THAT IT IS TRUE AND CORRECT TO THE BEST OF MY KNOWLEDGE AND BELIEF, AND MEETS THE STANDARDS OF PRACTICE AS SET FORTH BY THE FLORIDA BOARD OF PROFESSIONAL LAND SURVEYORS IN CHAPTER 63-17, FLORIDA ADMINISTRATIVE CODE, PURSUANT TO SECTION 472.027, FLORIDA STATUTES.

JOHN R. MORGAN II, PLS
PROFESSIONAL LAND SURVEYOR #3520
STATE OF FLORIDA

SONAR MOSAICS

DIVER INVESTIGATION SURVEY OF POTENTIAL BURIED UTILITIES
INTRACOASTAL WATERWAY, CUT PB-36 THROUGH PB-41
PALM BEACH COUNTY, FLORIDA
FOR TAYLOR ENGINEERING, INC.

COMMISSION NO.
5303.16

SCALE
AS SHOWN

DATE
3/6/18


DRAWN BY
LFP

CHECKED BY
JRM

FIELD BOOK
PAGE NO. COVER

DATE OF SURVEY
2/15/18

SHEET 15 OF 22

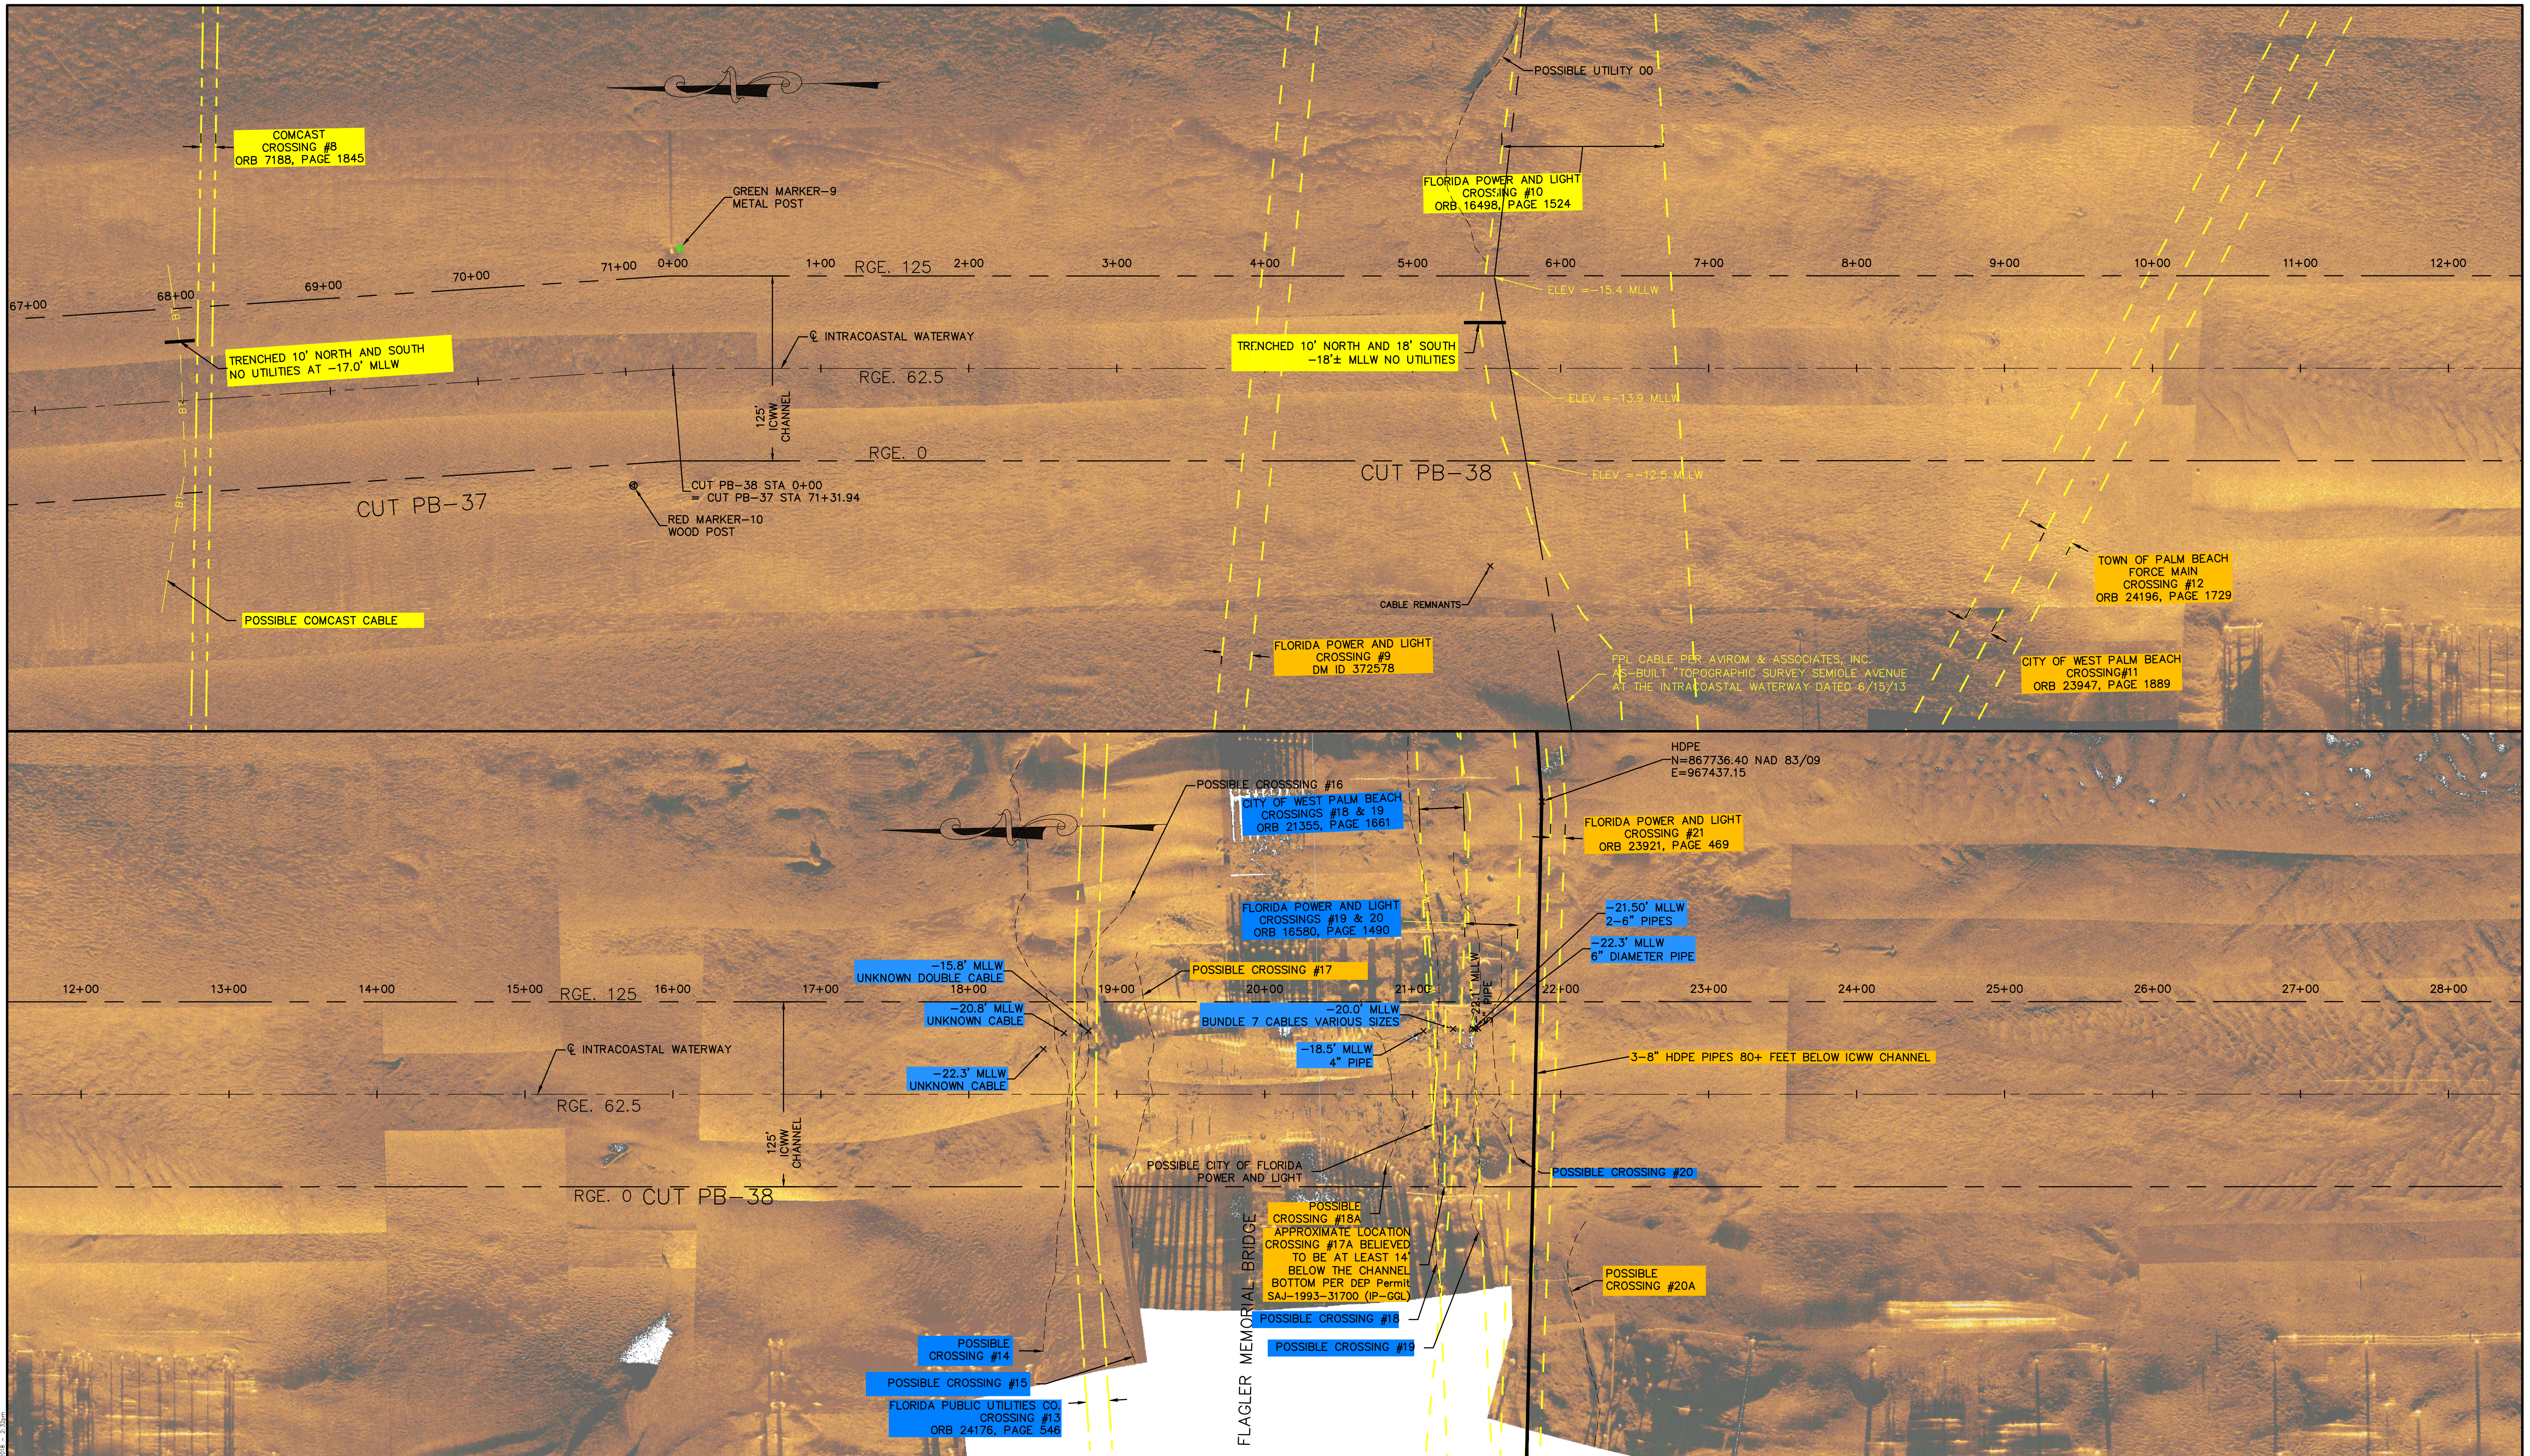

0 50' 100'
HORIZONTAL SCALE 1" = 50'
INTENDED DISPLAY SCALE

LEGEND

- TRENCHED TO -17.5 MLLW
NO UTILITIES ENCOUNTERED
- FOUND UTILITY LINE
- NOT INVESTIGATED
- PWC-PROCEED WITH CAUTION



JOHN R. MORGAN II, PSM
FLORIDA CERTIFICATION #3520

Morgan & Eklund Inc.

PROFESSIONAL SURVEY CONSULTANTS

4909 US HIGHWAY #1
VERO BEACH, FL 32967
PHONE: (772) 388-5364
FAX: (772) 388-3165




1612 NW 2ND AVENUE
SUITE 3
BOCA RATON, FL 33432
PHONE: (954) 421-6682
FAX: (954) 421-0425

LB #4298

CERTIFICATE OF SURVEYOR - I HEREBY CERTIFY THAT THE INFORMATION SHOWN HEREON IS IN ACCORDANCE WITH A RECENT FIELD SURVEY MADE UNDER MY DIRECTION, AND THAT IT IS TRUE AND CORRECT TO THE BEST OF MY KNOWLEDGE AND BELIEF, AND MEETS THE STANDARDS OF PRACTICE AS SET FORTH BY THE FLORIDA BOARD OF PROFESSIONAL LAND SURVEYORS IN CHAPTER 64-17, FLORIDA ADMINISTRATIVE CODE, PURSUANT TO SECTION 402.027, FLORIDA STATUTES.

JOHN R. MORGAN II, PLS
PROFESSIONAL LAND SURVEYOR #3520
STATE OF FLORIDA

SONAR MOSAICS					COMMISSION NO.
DIVER INVESTIGATION SURVEY OF POTENTIAL BURIED UTILITIES					5303.16
INTRACOASTAL WATERWAY, CUT PB-36 THROUGH PB-41					SCALE
PALM BEACH COUNTY, FLORIDA					AS SHOWN
FOR TAYLOR ENGINEERING, INC.					DATE
					3/6/18
DRAWN BY	CHECKED BY	FIELD BOOK	SEE	DATE OF SURVEY	SHEET 16 OF 22
LFP	JRM	PAGE NO.	COVER	2/15/18	

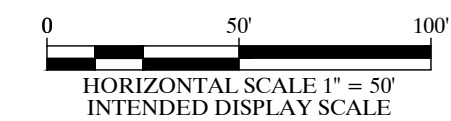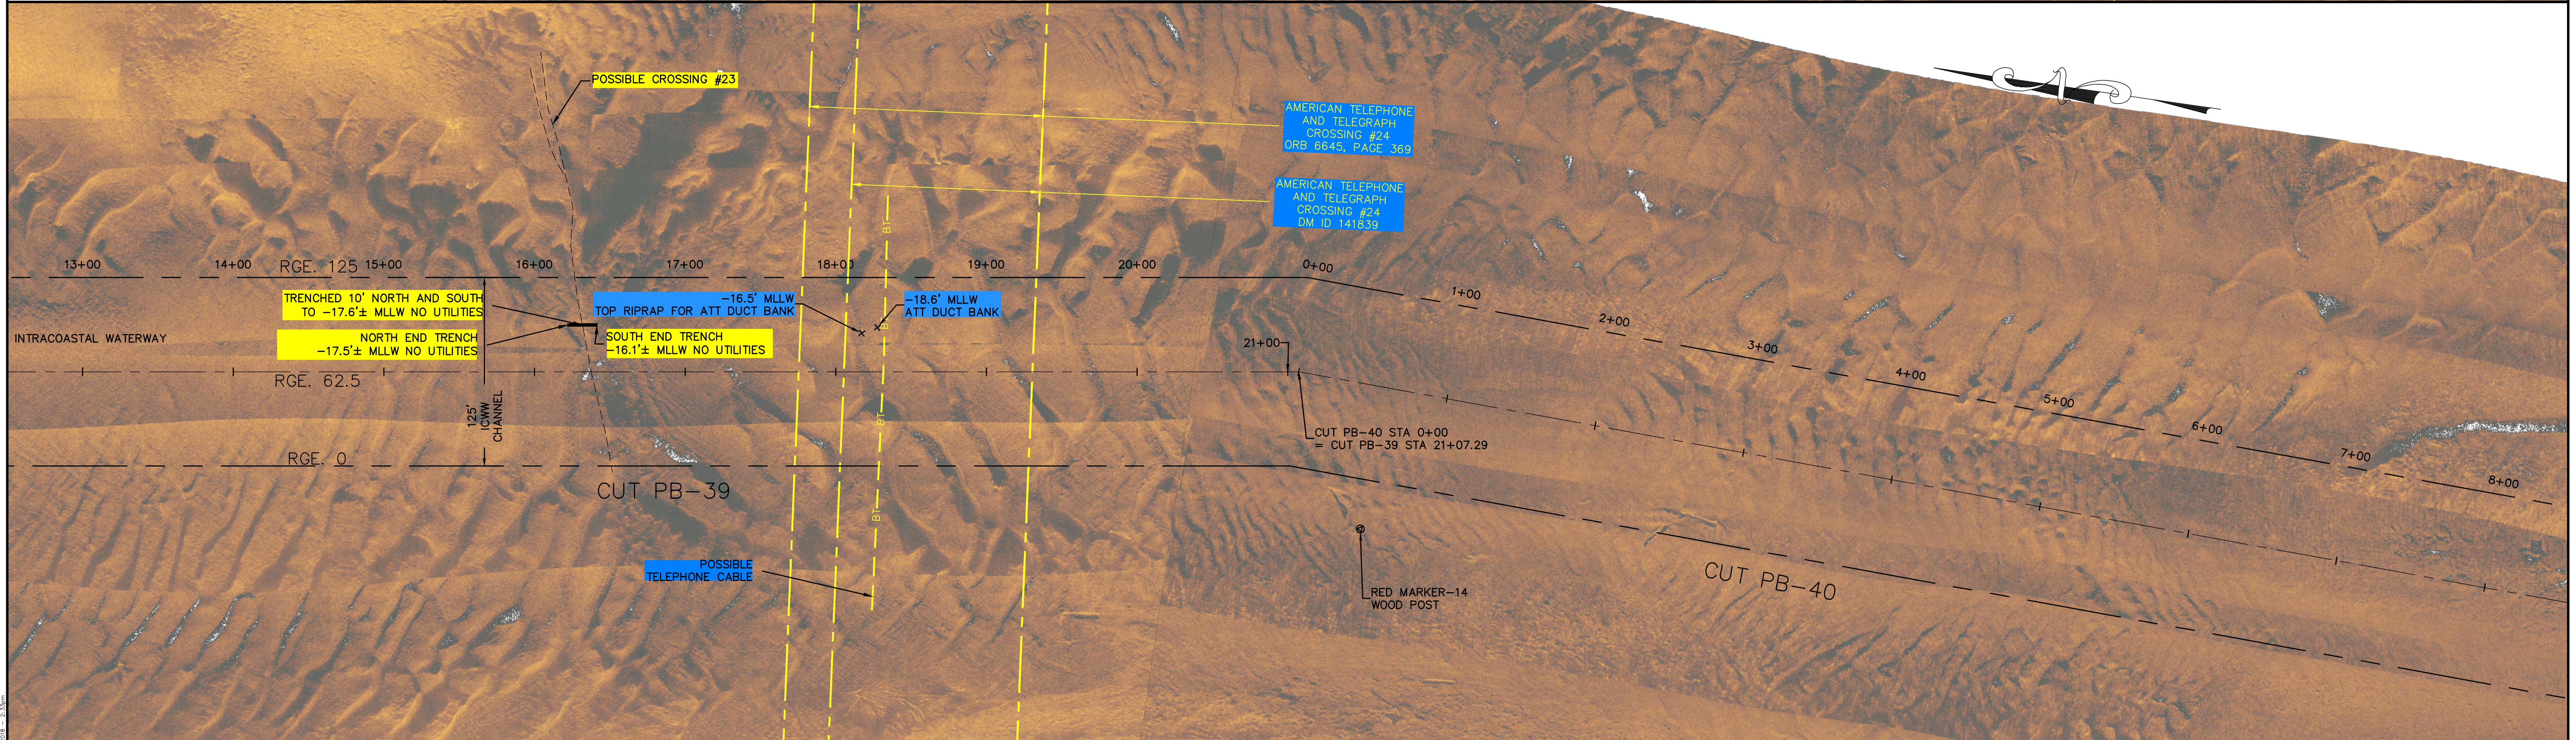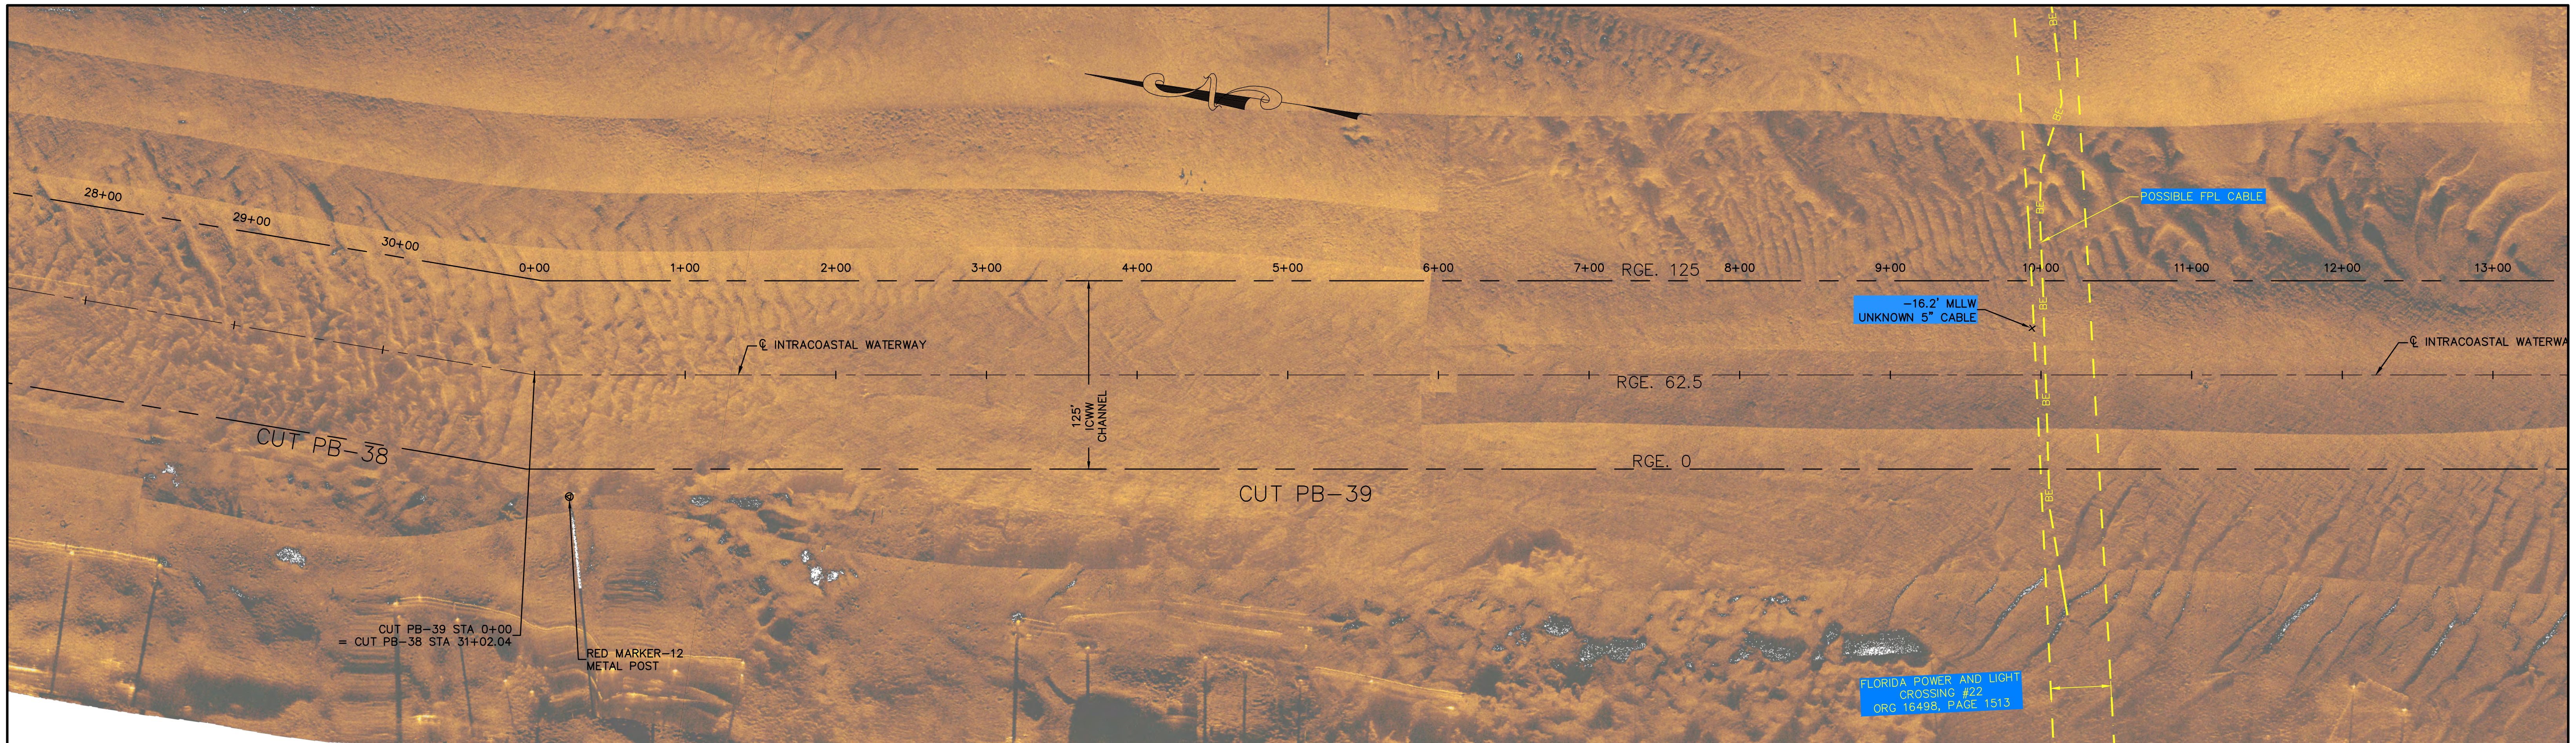

LEGEND

- TRENCHED TO -17.5 MLLW
NO UTILITIES ENCOUNTERED
- FOUND UTILITY LINE
- NOT INVESTIGATED
- PWC-PROCEED WITH CAUTION



JOHN R. MORGAN II, PSM
FLORIDA CERTIFICATION #3520

Morgan & Eklund Inc.

PROFESSIONAL SURVEY CONSULTANTS

4909 US HIGHWAY #1
VERO BEACH, FL 32967
PHONE: (772) 388-5364
FAX: (772) 388-3165

1612 NW 2ND AVENUE
SUITE 3
BOCA RATON, FL 33432
PHONE: (954) 421-6682
FAX: (954) 421-0425

LB #4298

CERTIFICATE OF SURVEYOR - I HEREBY CERTIFY THAT THE INFORMATION SHOWN HEREON IS IN ACCORDANCE WITH A RECENT FIELD SURVEY MADE UNDER MY DIRECTION, AND THAT IT IS TRUE AND CORRECT TO THE BEST OF MY KNOWLEDGE AND BELIEF, AND MEETS THE STANDARDS OF PRACTICE AS SET FORTH BY THE FLORIDA BOARD OF PROFESSIONAL LAND SURVEYORS IN CHAPTER 64-17, FLORIDA ADMINISTRATIVE CODE, PURSUANT TO SECTION 472.027, FLORIDA STATUTES.

JOHN R. MORGAN II, PLS
PROFESSIONAL LAND SURVEYOR #3520
STATE OF FLORIDA

SONAR MOSAICS
DIVER INVESTIGATION SURVEY OF POTENTIAL BURIED
UTILITIES
INTRACOASTAL WATERWAY, CUT PB-36 THROUGH PB-41
PALM BEACH COUNTY, FLORIDA
FOR TAYLOR ENGINEERING, INC.

DRAWN BY
LFP

CHECKED BY
JRM

FIELD BOOK
PAGE NO. SEE
COVER


DATE OF SURVEY
2/15/18

COMMISSION NO.
5303.16


SCALE
AS SHOWN

DATE
3/6/18


SHEET 17 OF 22

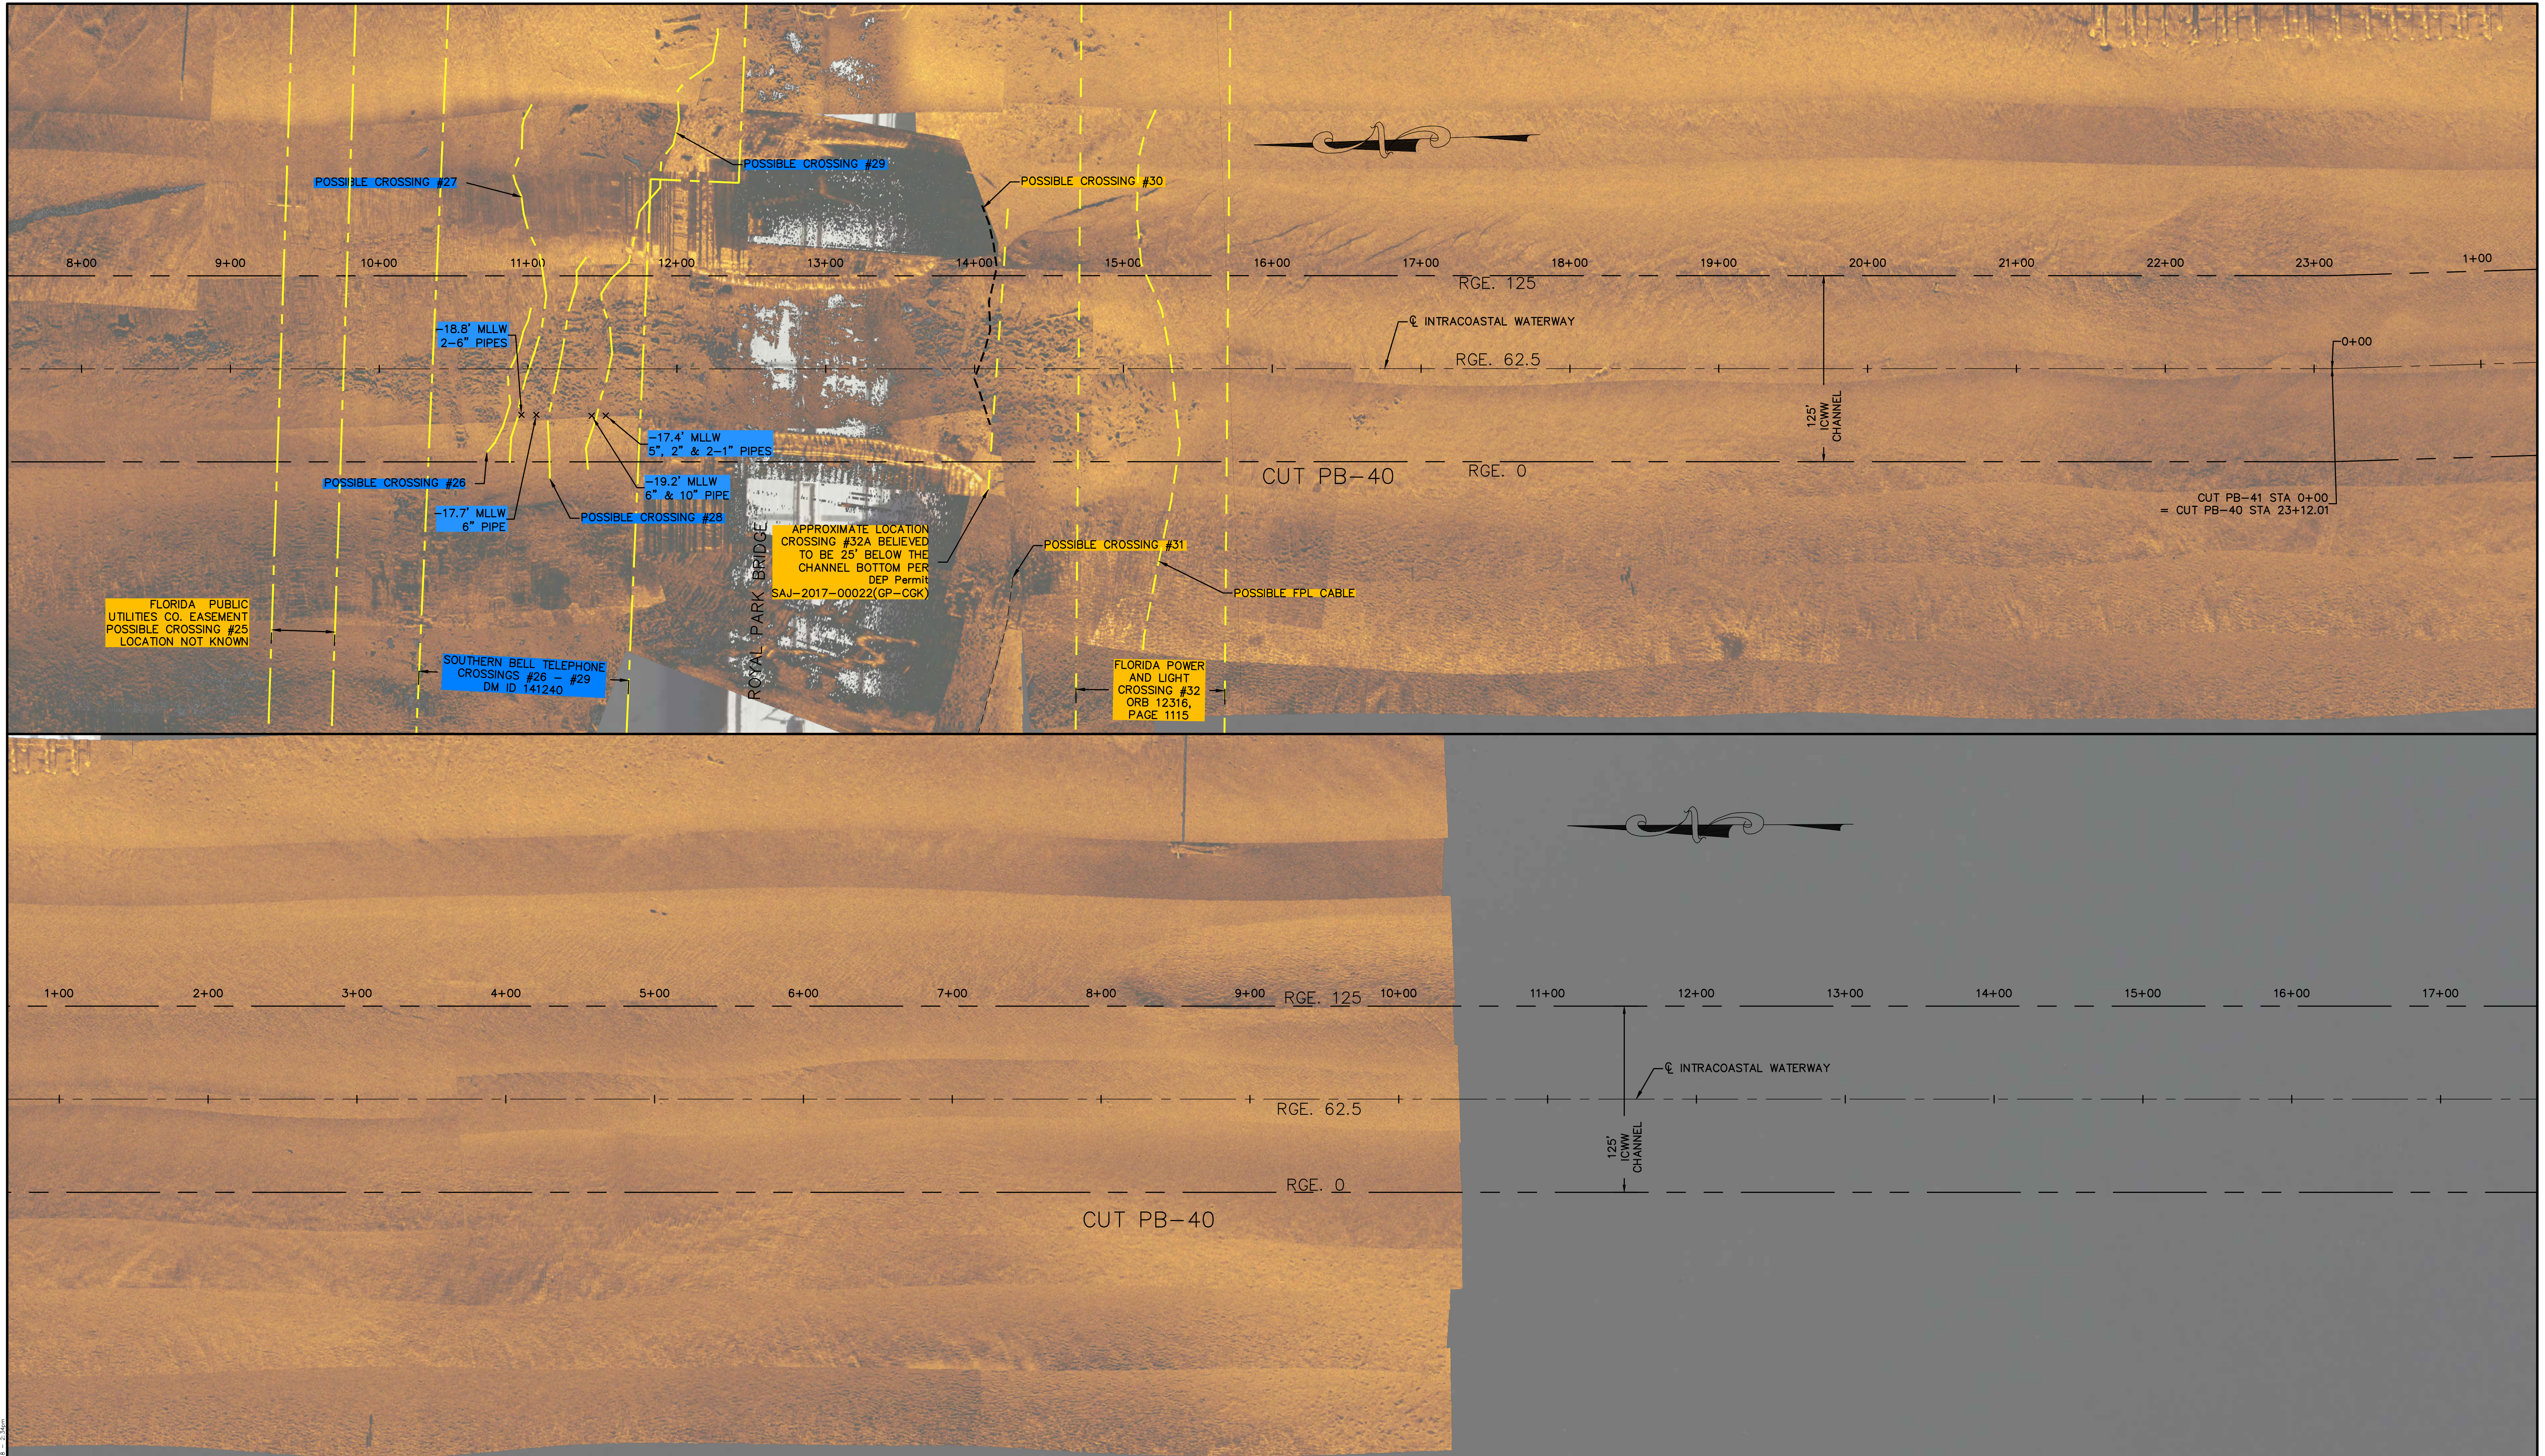

\\s\shared\GIS\2018-19\0000\3520-18.dwg, 11 Jan 2018, 2:24pm

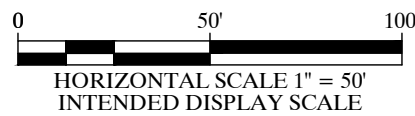

LEGEND	
TRENCHED TO -17.5 MLLW NO UTILITIES ENCOUNTERED	
FOUND UTILITY LINE	
NOT INVESTIGATED	
PWC-PROCEED WITH CAUTION	



Morgan & Eklund Inc.

PROFESSIONAL SURVEY CONSULTANTS

4909 US HIGHWAY #1
VERO BEACH, FL 32967
PHONE: (772) 388-5364
FAX: (772) 388-3165

1612 NW 2ND AVENUE
SUITE 3
BOCA RATON, FL 33432
PHONE: (954) 421-6682
FAX: (954) 421-0425

JOHN R. MORGAN II, PSM
FLORIDA CERTIFICATION #3520

LB #4298

CERTIFICATE OF SURVEYOR - I HEREBY CERTIFY THAT THE INFORMATION SHOWN HEREON IS IN ACCORDANCE WITH A RECENT FIELD SURVEY MADE UNDER MY DIRECTION, AND THAT IT IS TRUE AND CORRECT TO THE BEST OF MY KNOWLEDGE AND BELIEF, AND MEETS THE STANDARDS OF PRACTICE AS SET FORTH BY THE FLORIDA BOARD OF PROFESSIONAL LAND SURVEYORS IN CHAPTER 6J-17, FLORIDA ADMINISTRATIVE CODE, PURSUANT TO SECTION 472.027, FLORIDA STATUTES.

JOHN R. MORGAN II, PLS
PROFESSIONAL LAND SURVEYOR #3520
STATE OF FLORIDA

SONAR MOSAICS					COMMISSION NO. 5303.16
DIVER INVESTIGATION SURVEY OF POTENTIAL BURIED UTILITIES					SCALE AS SHOWN
INTRACOASTAL WATERWAY, CUT PB-36 THROUGH PB-41 PALM BEACH COUNTY, FLORIDA FOR TAYLOR ENGINEERING, INC.					DATE 3/6/18
DRAWN BY LFP	CHECKED BY JRM	FIELD BOOK PAGE NO.	SEE COVER	DATE OF SURVEY 2/15/18	SHEET 18 OF 22

Palm Beach ICWW Utility Search

Introduction

SONOGRAPHICS, INC. and MORGAN & EKLUND, INC. (M&E) have completed an underwater survey of the Intracoastal Waterway in Palm Beach County, Florida to detect the possible presence of utilities crossing. This report describes the equipment used, the methods implemented and the results obtained.

A. Equipment Used to Detect Submerged Utilities

A-1 MAGNETOMETER:

To locate utilities such as pipelines and cables under a waterway, several devices were employed. One device was the Geometrics Model G-882 marine magnetometer. It is a highly sensitive cesium pumped digital unit capable of sampling at 10 times per second. It is capable of locating ferrous objects because they interrupt the earth's magnetic field. It is a very common tool for locating pipelines and cables that have ferrous iron in their construction. The limitations of a magnetometer are:

1. If the cable or pipeline is not made with ferrous iron they will not be detected by the magnetometer.
2. If a utility is detected the depth of burial can only be determined through calculations that are imprecise and therefore are not very accurate or reliable.
3. If there are other ferrous items in the vicinity they must be separated from the potential utility contacts usually by comparing positions and analyzing signatures.
4. Selecting the exact position of an anomaly can be difficult due to the context in which the anomaly is situated relative to the earth's field and other ferrous objects. Some positions are straightforward and accurate while others are subject to interpretation.

A-2 SIDE-SCAN SONAR:

The second device employed was an EdgeTech dual frequency (600 kHz and 1600 kHz) chirp side-scan sonar. The model used was the 4125. The side-scan sonar is capable of producing sonic images of the bottom with the resolution to display the utility if it is exposed and not completely buried. It is capable of covering the entire bottom of the waterway from one side to the other. The limitation of the side-scan sonar is that it cannot penetrate the bottom and detect a buried utility.

A-3 SUB-BOTTOM PROFILER:

The third device employed was an EdgeTech X-Star Chirp Sub-bottom Profiler (SBP). The tow-fish used was the model SB-216S which can sweep sonic pulses from 2 kHz to 16 kHz. The sub-bottom profiler is capable of penetrating the sediment and getting reflections from the utility if it is significantly different in density from the surrounding sediment. The beam pattern of the sub-bottom profiler is wide enough fore and aft to detect the utility before and after it is directly under the tow-fish resulting in a classic hyperbolic pattern. If such a pattern is detected, then the actual depth of burial can be measured accurately relative to the surrounding bottom. The limitations of the sub-bottom profiler are:

1. The sediment may not be conducive to penetration if it contains gaseous organic material.
2. If the utility was purposely buried in the sediment, it may have been backfilled with material that is impenetrable. In this instance the backfill may be detected but the depth of burial would be un-measurable.
3. The construction of the utility may be of a material that is not of sufficient difference in density from the sediment or it may be physically too small. Typically, utilities with a diameter smaller than 6 inches will not be detected.

A. SURVEY METHODS

On January 6th, 7th and 27th, 2016 the survey vessel provided by Morgan Eklund, Inc. was mobilized with the Side-Scan Sonar, Magnetometer, Sub-bottom Profiler and Trimble DGPS Navigation Systems. The Navigation computer with Hypack Navigation Software was installed to interface the DGPS and output towfish coordinates to the Side-scan computer topside. The Navigation computer was loaded with preplanned survey lines spaced at 50 and 100 foot intervals through the length of the survey area and parallel to potential utilities for the side-scan survey. It provided visual guidance to the helmsman for navigation of each line. The RTK was able to provide WGS 84 differential positions to the Navigation computer. The published accuracy of the DGPS system is less than 1 meter.

The Side-Scan and Sub-bottom tow-fish were deployed from the side of the vessel with minimal amount of cable out. The distance from the DGPS antenna to the center of the transducers was also measured. The layback and offset was calculated by the Navigation software, enabling towfish coordinates to be sent to both the Sub-bottom and Sonar computers in real time.

The magnetometer was installed and tests were done to insure that it was interfaced and working properly. The navigation computer recorded the data from the magnetometer and combined it with the NAD83, Florida State Plane East Zone, U.S. Survey Foot tow-fish coordinates. The magnetometer sensor was towed near the water surface from 50 to 70 feet aft of the vessel. The layback and offset was calculated by the Navigation software, enabling tow-fish coordinates to be merged with the incoming magnetometer readings in real time. The sampling rate was set to

10 samples per second. The magnetometer signal strength was monitored as the vessel was operated at 8 points of the compass to ensure that the sensor would not be affected by an improper angle to the earth's magnetic field. Test passes close to a metal navigation aid produced a significant anomaly with no degradation in signal strength. The background noise level was normal throughout the test and it was deemed that the magnetometer was ready for survey operations.

A. DATA PROCESSING

C-1 SIDE-SCAN SONAR DATA:

The Side-scan data was recorded in the native EdgeTech JSF format on the hard drive in the Sonar Computer by the EdgeTech Discover program. The JSF files were read by the Chesapeake SonarWizMap program and after adjustments and navigation smoothing, image files were created for the construction of a sonar mosaic. The sonar mosaic was exported as a Geo-Tif file. Each individual sonar line was examined for possible utility targets.

C-2 MAGNETOMETER DATA:

The magnetometer data was recorded in the Hypack (RAW) files. The RAW files were imported to an editor where anomalies were analyzed in profile and recorded as targets. The targets were plotted and analyzed for continuous patterns consistent with the presence of utilities.

C-3 SUB-BOTTOM PROFILER DATA:

The Sub-bottom data was recorded in the native EdgeTech (JSF) format on the hard drive in the Sub-bottom Computer. The JSF files were read by the Chesapeake SonarWizMap program and after adjustments and navigation smoothing profiles were produced for each survey line. The data was analyzed for patterns consistent with pipeline or cable signatures. Particular attention was paid to utility easement areas and where magnetic anomalies were detected.

B. RESULTS

D-1 SIDE-SCAN SONAR RESULTS:

20 possible utility detections were observed on the side-scan imagery.

Possible Utility _00 is a possible cable or pipeline meandering from the as-built plot of an FPL cable at the north edge of FPL Crossing #10 easement. The contact image starts at the northern easement boundary and moves north 30 feet from the

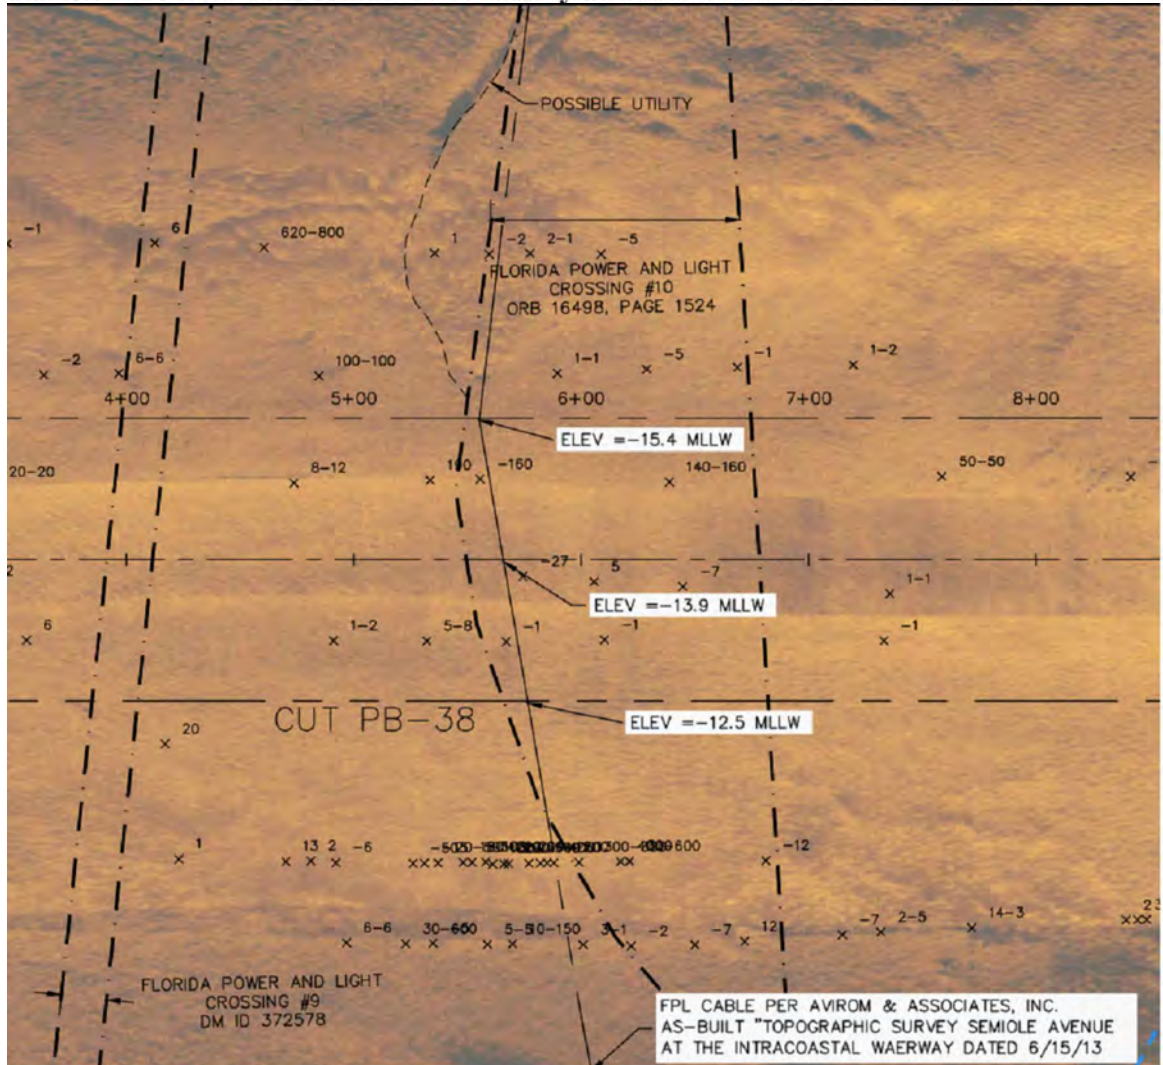


Figure 1. Short dashed black line at top of image is Possible Utility _00 boundary then bends back and meets the plotted cable just inside the boundary on the east end for a total length of about 120 feet (See Figure 1).

Possible Utility _01 crosses the waterway about 20 – 30 feet north of the north fender piles of the Flagler Memorial Bridge. It is adjacent to Possible Utilities _02 and _03. It is not within or close to any utility easements known to us at this time (See Figure 2). We are designating it as Crossing #14.

Possible Utility _02 is adjacent and south of Possible Utility _01 and runs across the entire waterway survey area (See Figure 2). We are designating it as Crossing #15.

Possible Utility _03 is adjacent and south of Possible Utility _02 (See Figure 2). We are designating it as Crossing #16.

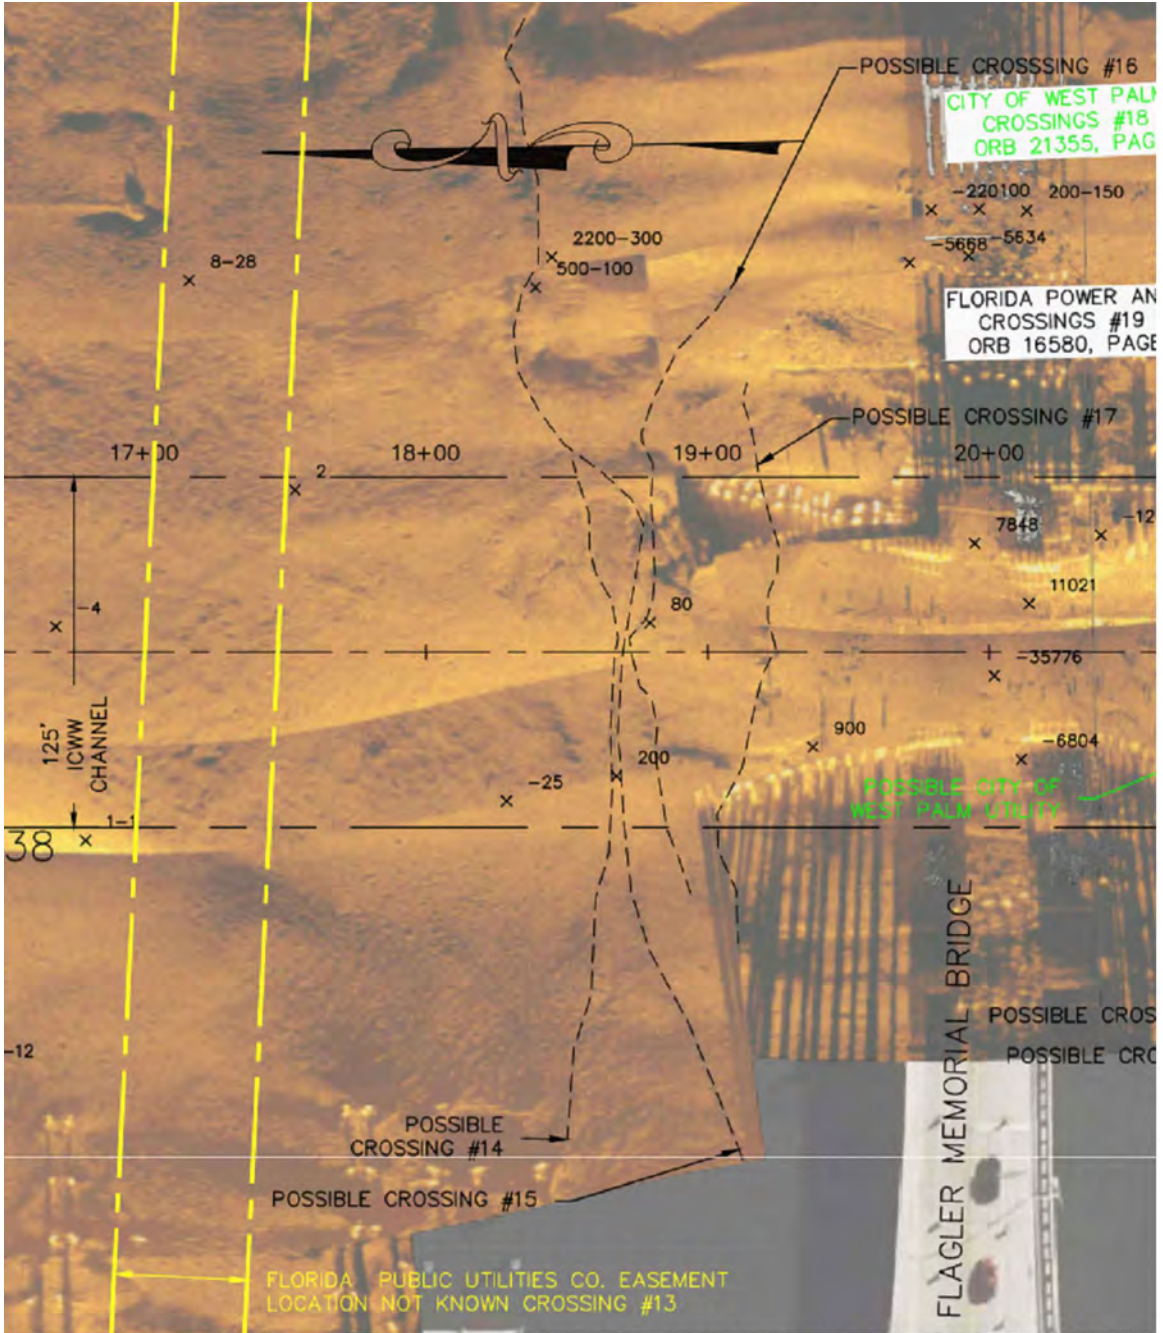


Figure 2. Short dashed black lines are Possible Crossings #14, #15, #16 and #17.

Possible Utility _04 runs through the north fender piles of the Flagler Memorial Bridge (See Figure 2). We are designating it as Crossing #17.

Possible Utility _05 runs between the south fender piles of the Flagler Memorial Bridge about 15 to 30 feet north of the City of West Palm Beach Crossing #18 easement boundary (See Figure 3).

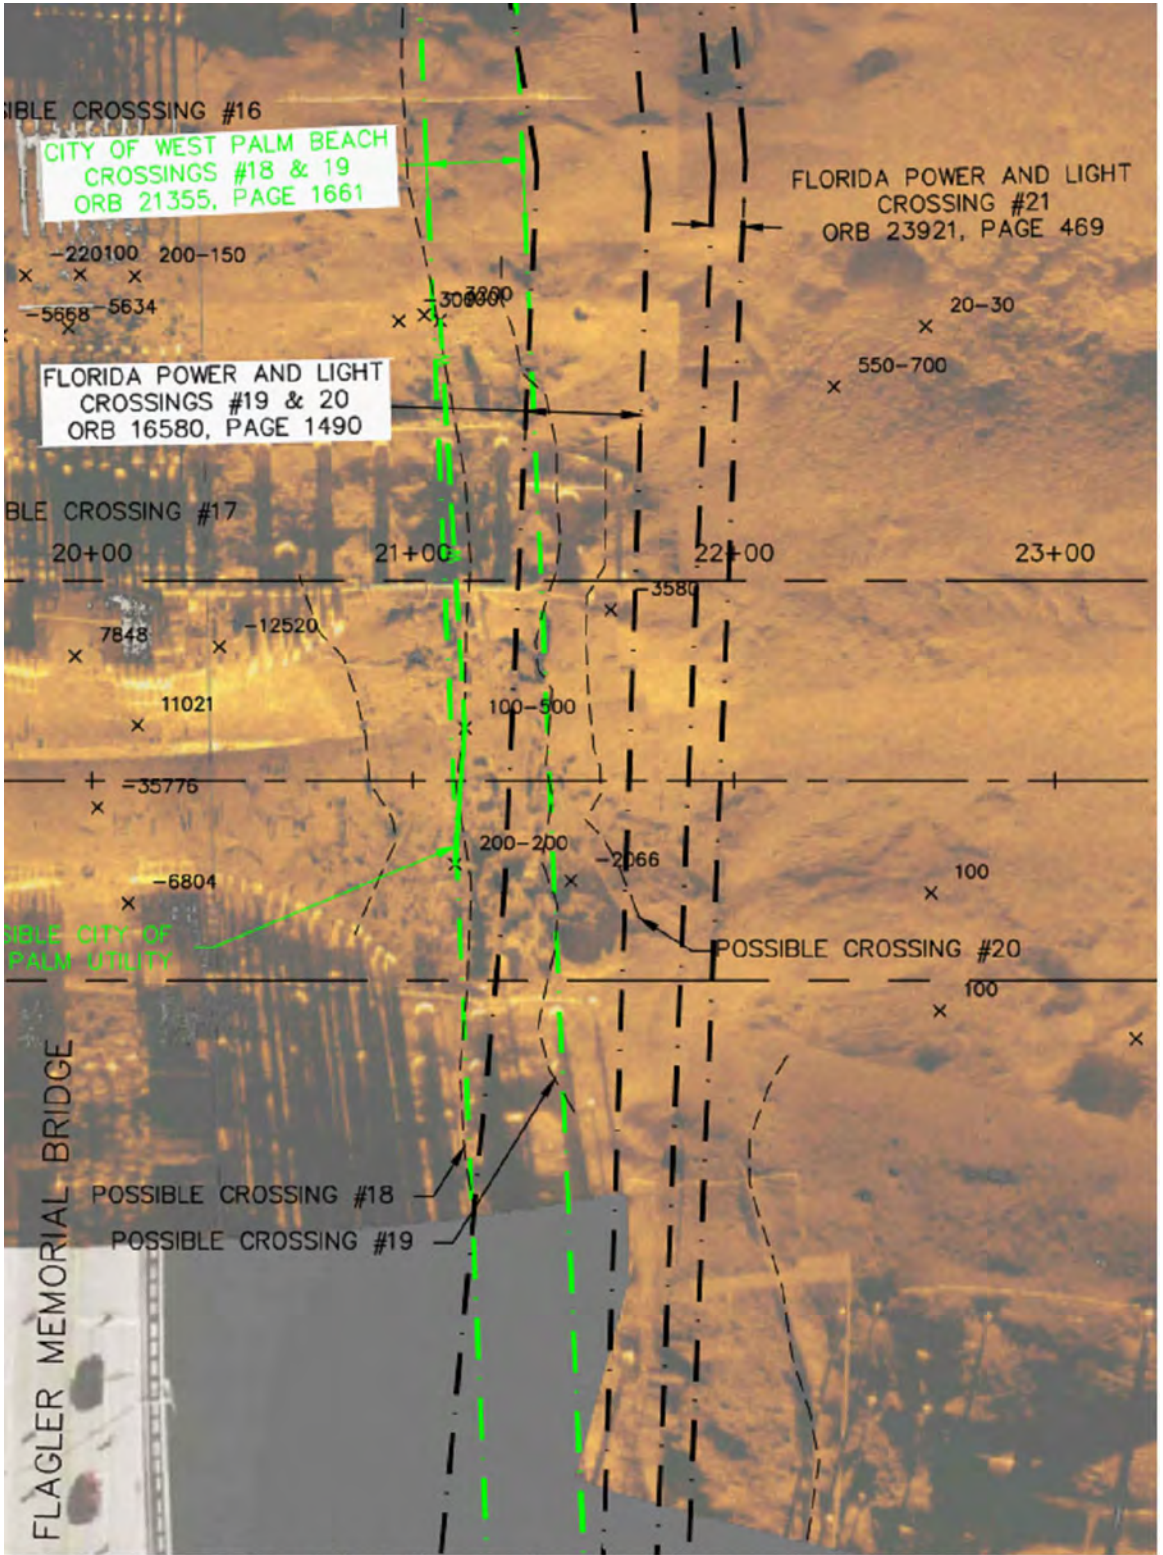


Figure 3. Short dashed black lines are Possible Crossings #18, #19 and #20. Possible Crossing 18A (leftmost) and 20A (rightmost) are unlabeled.

runs across the entire waterway survey area, through the south fender piles and along the northern boundary of the City of West Palm Beach easement (See Figure 3). We are designating it as Crossing #18.

Possible Utility _07 runs across the entire waterway survey area, through the south fender piles and along the southern boundary of the City of West Palm Beach easement (See Figure 3). We are designating it as Crossing #19.

Possible Utility _08 runs from just inside the east fender piles on the south side of the bridge within the FPL easement to the west side of the channel (See Figure 3). We are designating it as Crossing #20.

Possible Utility _09 runs from the west extent of the sonar coverage to the west edge of the channel (See Figure 3). It varies from 13 to 37 feet south of the Florida Power & Light Crossing #21 easement.

Possible Utility _10 runs for less than 100 feet on the eastern edge of the sonar coverage within the FP&L Crossing #22 easement (See Figure 4). Magnetometer string 8 was detected west of this feature and within the northern half of the easement. These two features were joined to form "Possible FPL Cable" in Figure 4a.

Possible Utility _11 merges with Possible Utility _12 east of the channel after a run of less than 100 feet and is not near a known easement (See Figure 5).

Possible Utility _12 runs from the west edge of the channel to approximately 150 feet west of the channel and is not near a known easement (See Figure 5). We have designated Possible Utility 12 as crossing #23.

Possible Utility _13 runs from the west edge of the channel and most of the way across toward the east edge (See Figure 6). Possible Utility _13 has been designated as Crossing #26.

Possible Utility _14 runs from the west edge of the channel to 125 feet beyond the east edge (see Figure 6). Possible Utility _14 has been designated as Crossing #27.

Possible Utility _15 runs from just outside the west edge of the channel to just outside the east edge (See Figure 6). Possible Utility _15 has been designated as Crossing #28.

Possible Utility _16 runs from the west edge of the channel to just inside the last fender pile on the northeast side of the Royal Park Bridge and continues almost to the extent of the sonar coverage to the east (See Figure 6). Possible Utility _16 has been designated as Crossing #29. Possible Utilities 13, _14, _15 and _16 are all within the Southern Bell Telephone easement (See Figure 6).

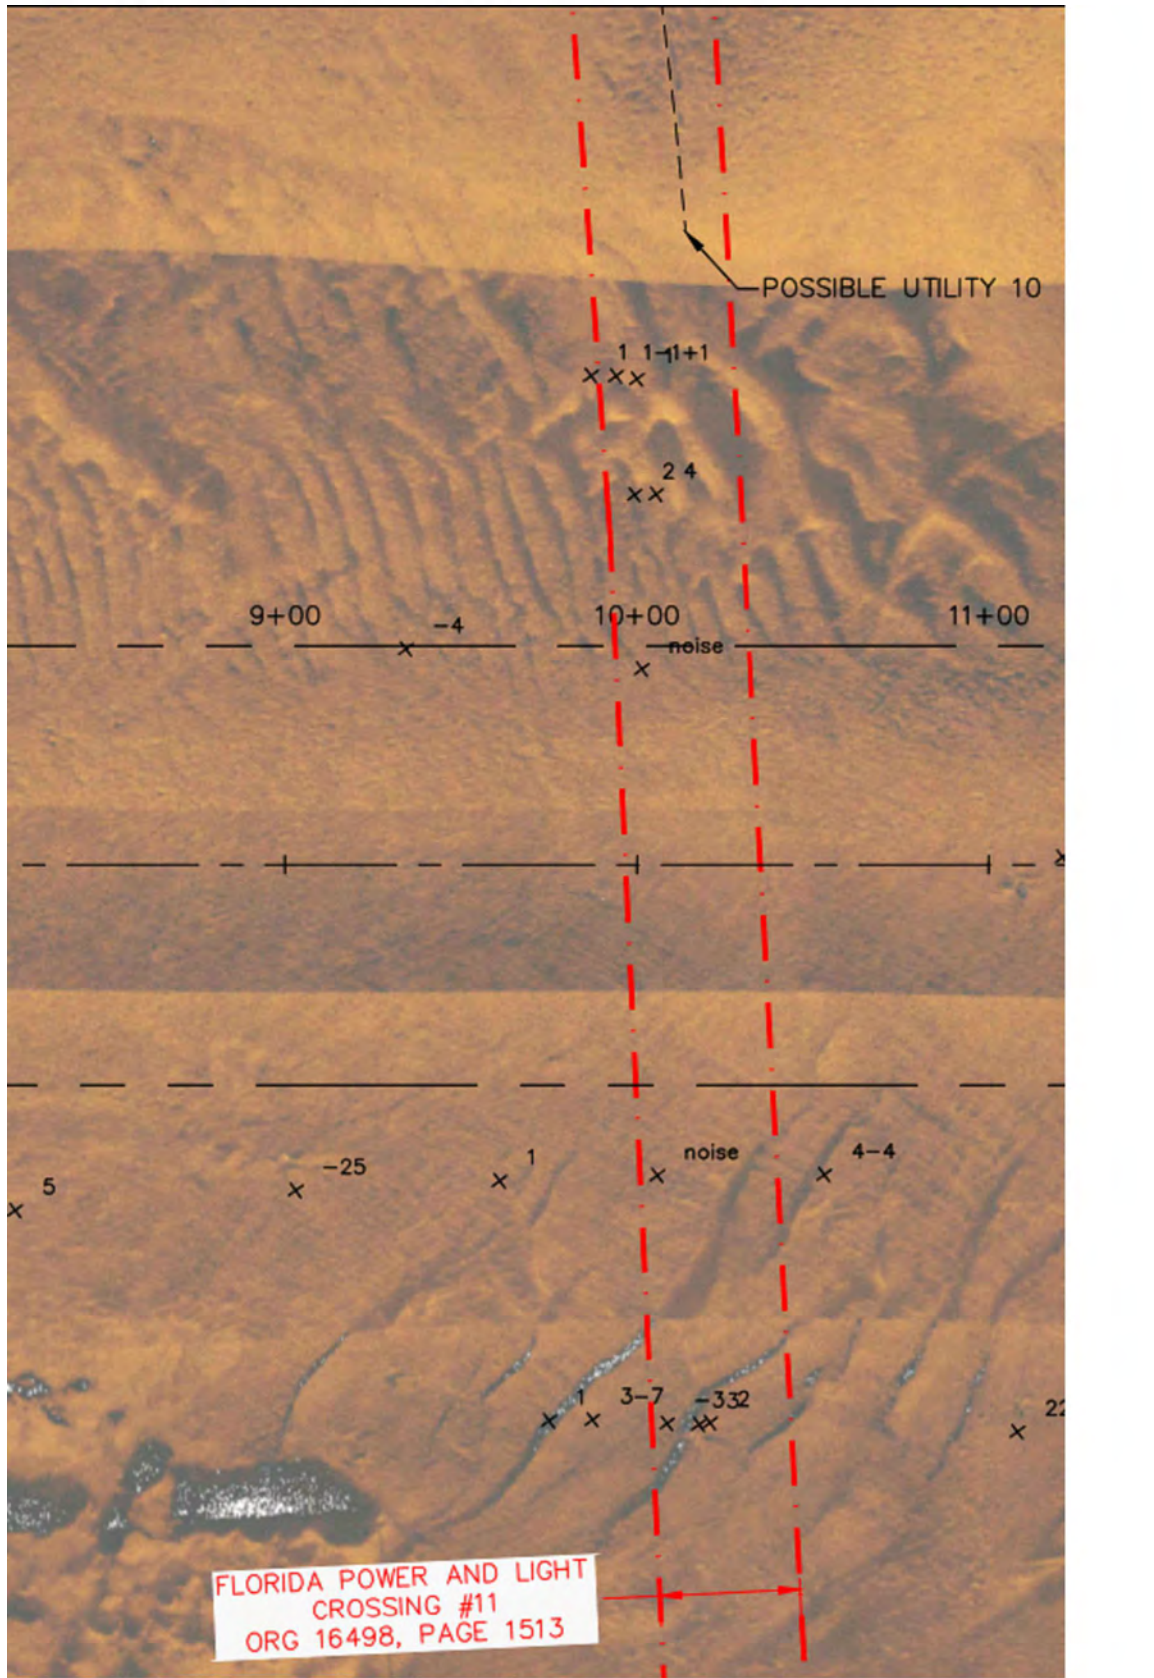


Figure 4. Short dashed black line is Possible Utility _10.

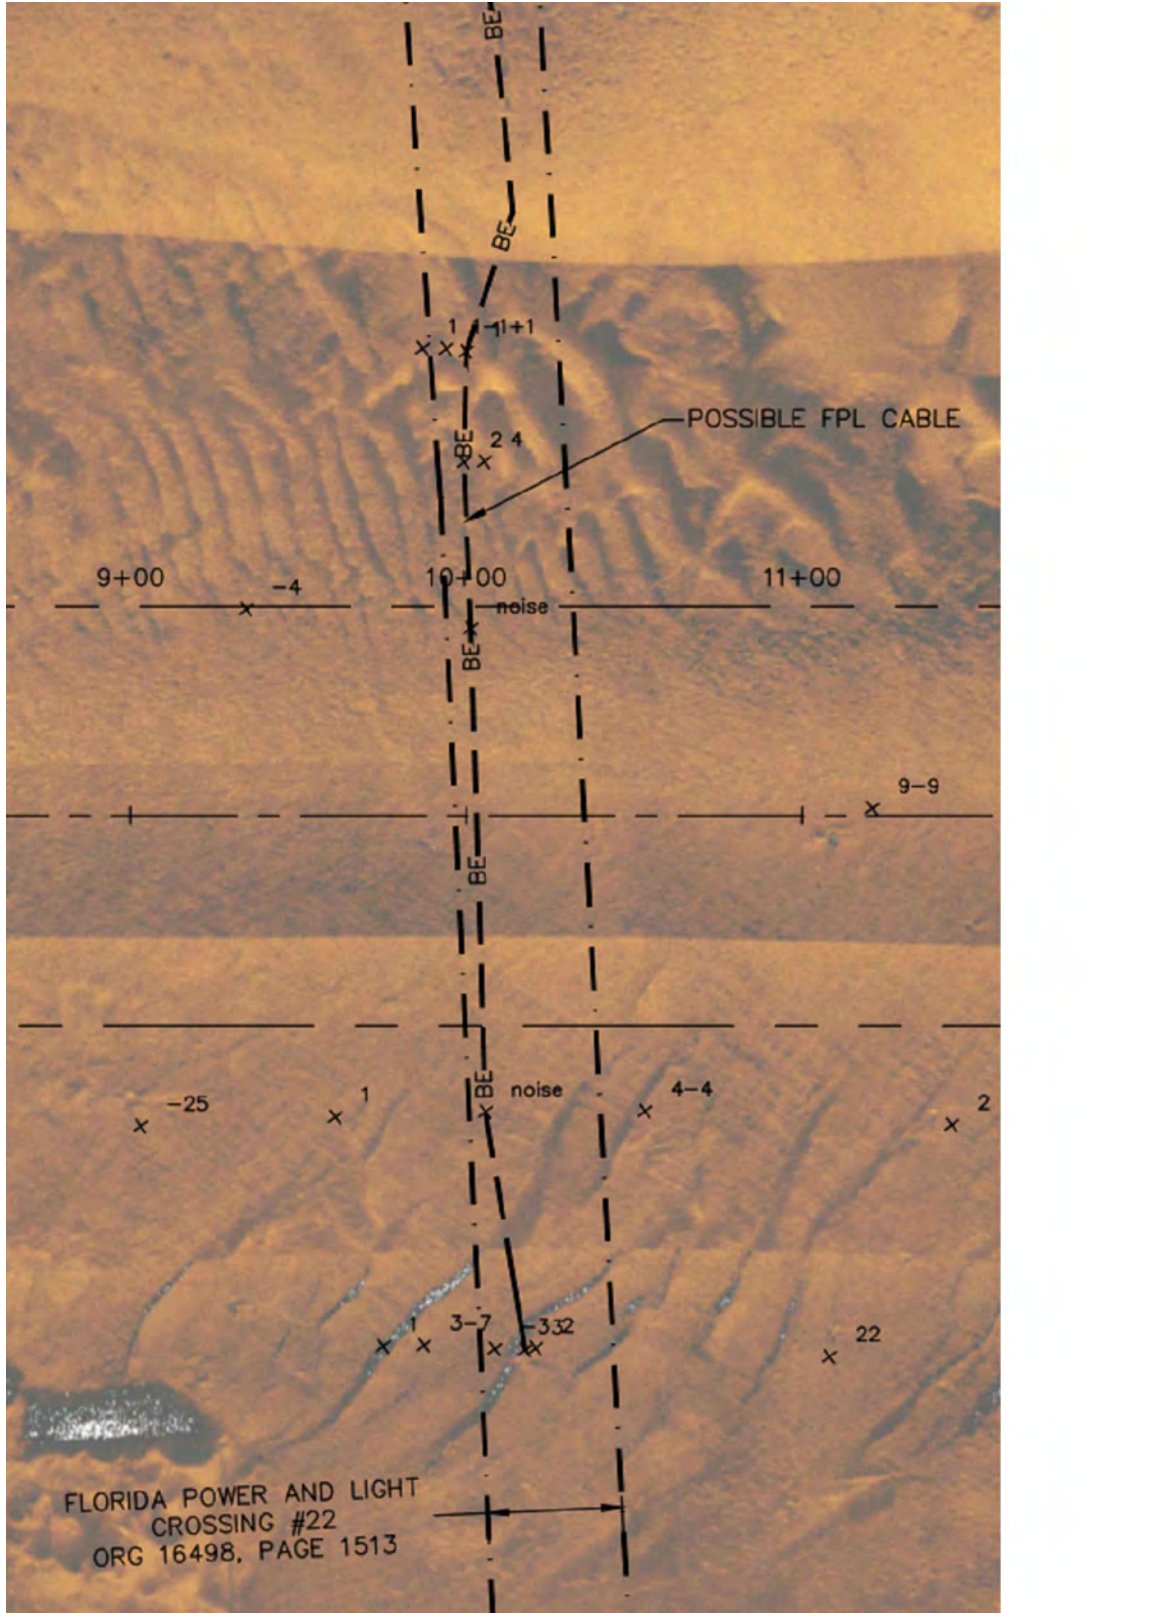


Figure 4a. "Possible FPL Cable" is combined mag string 8 and sonar feature "Possible Utility _10"

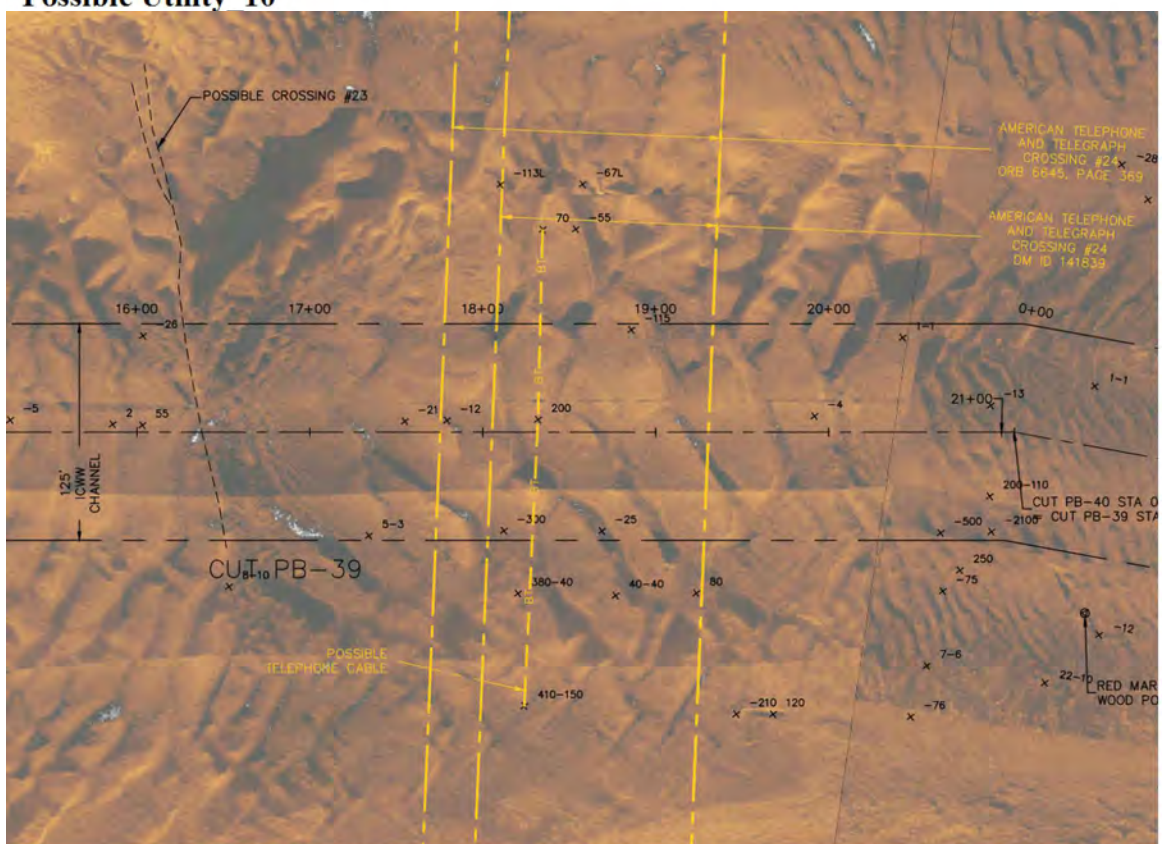


Figure 5. Short dashed black lines at left are Possible Crossing 23. Yellow dashed line is mag string 9 labeled as Possible Telephone Cable.

Possible Utility _17 starts within the channel on the west side and runs about 70 feet past the east edge of the channel south of the fender pilings on the south side of the Royal Park Bridge (See Figure 7). Possible Utility _17 has been designated as Crossing #30.

Possible Utility _18 starts about 75 feet west of the west channel edge and runs west to the extent of the sonar coverage. It may be another segment of Possible Utility _17 and both are outside of any known easements (See Figure 7). Possible Utility _18 has been designated as Crossing #31 .

Possible Utility _19 runs most of the way across the waterway for 400 feet and is within the Florida Power & Light easement (Crossing #32) just south of the Royal Park Bridge (See Figure 7).

The Sonar mosaic is available as several geo-tif files.

SURVEY REPORT
DIVER INVESTIGATION SURVEY OF POTENTIAL BURIED UTILITIES
INTRACOASTAL WATERWAY, CUT PB-36 THROUGH PB-41
PALM BEACH COUNTY, FLORIDA
FOR TAYLOR ENGINEERING, INC.

Morgan & Eklund Inc.
PROFESSIONAL SURVEY CONSULTANTS
4909 US HIGHWAY #1
VERO BEACH, FL 32967
PHONE: (772) 388-5364
FAX: (772) 388-3165
1612 NW 2ND AVENUE
SUITE 3
BOCA RATON, FL 33432
PHONE: (954) 421-6682
FAX: (954) 421-0425
LB #4298

CERTIFICATE OF SURVEYOR - I HEREBY CERTIFY THAT THE INFORMATION SHOWN HEREON IS IN ACCORDANCE WITH A RECENT FIELD SURVEY MADE UNDER MY DIRECTION, AND THAT IT IS TRUE AND CORRECT TO THE BEST OF MY KNOWLEDGE AND BELIEF, AND MEETS THE STANDARDS OF PRACTICE AS SET FORTH BY THE FLORIDA BOARD OF PROFESSIONAL LAND SURVEYORS IN CHAPTER 36-17, FLORIDA ADMINISTRATIVE CODE, PURSUANT TO SECTION 472.027, FLORIDA STATUTES.
JOHN R. MORGAN, II, PLS
PROFESSIONAL LAND SURVEYOR #3520
STATE OF FLORIDA


DRAWN BY LFP		CHECKED BY JRM		FIELD BOOK PAGE NO.		SEE COVER		DATE OF SURVEY 2/15/18		COMMISSION NO. 5303.16	
										SCALE AS SHOWN	
										DATE 3/6/18	
										SHEET 19 OF 22	

A spreadsheet (M-E summary.xlsx) has been constructed to help illustrate the results of this survey.


The power and telephone cables do not typically have significant ferrous iron in their construction that would allow them to be detected by the magnetometer. Occasionally the magnetometer will detect a large amount of current flowing through a power cable but that is a variable factor and did occur on two occasions during this survey.

It should be understood that the results of this survey are an interpretation of remote sensing data and as such cannot be relied upon as positive confirmation of the existence or nonexistence of submerged or buried utilities.


Some examples of sub-bottom targets from other project areas are shown below:

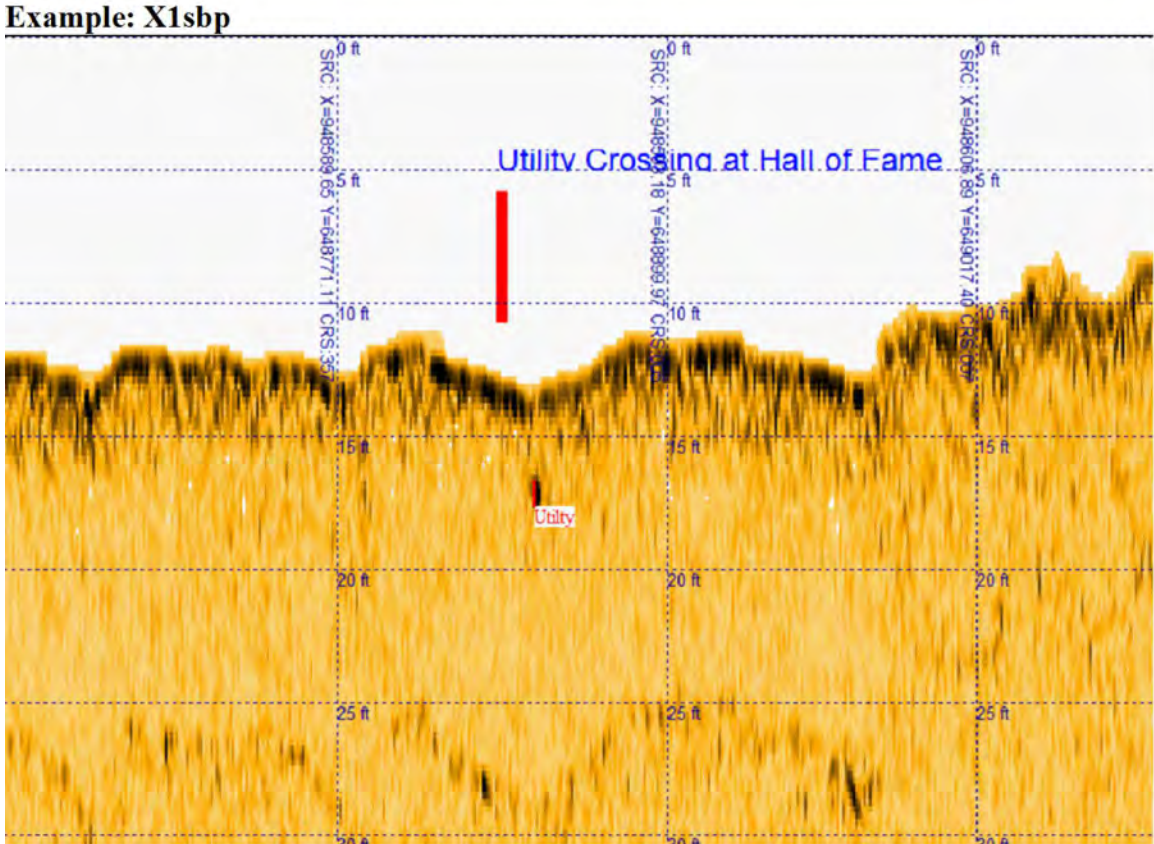


Utility located by SB-216s System in Florida Intracoastal Waterway

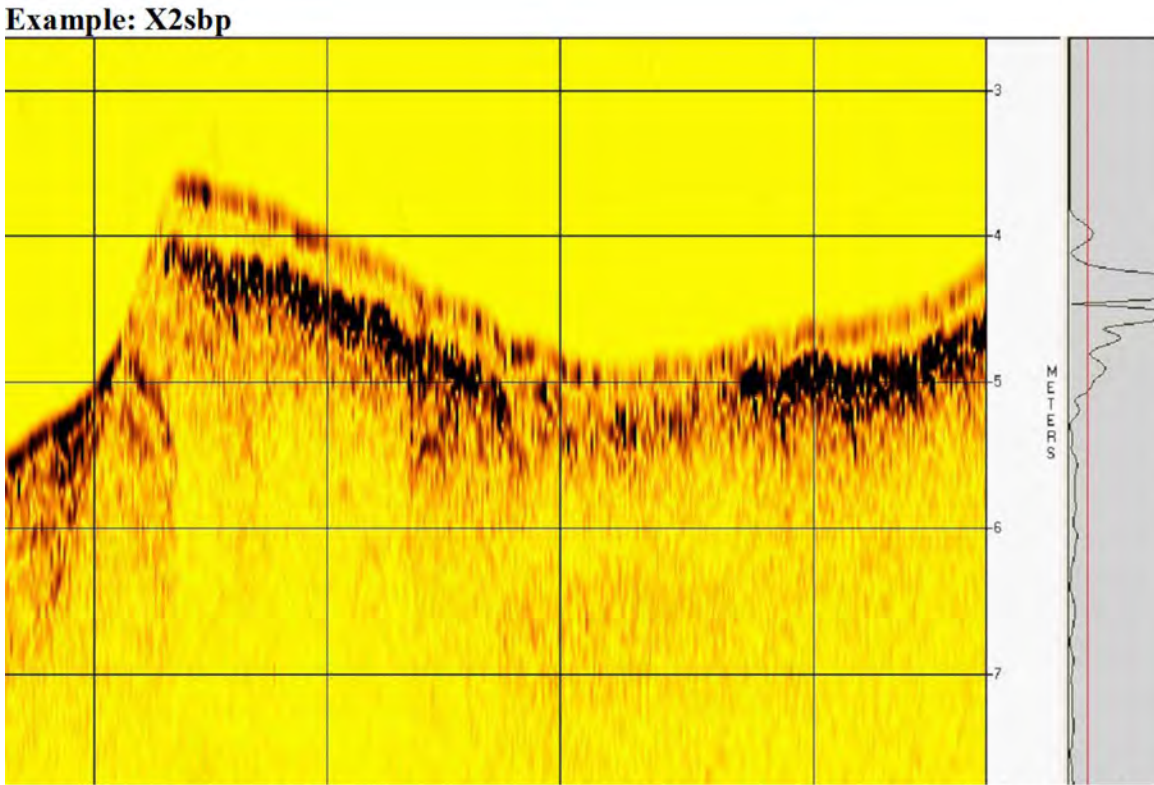


Example of apparent point source object at 5.3meters presenting partial hyperbolic pattern. Bottom is 4.4meters at that point thus object may be buried 0.9meters.










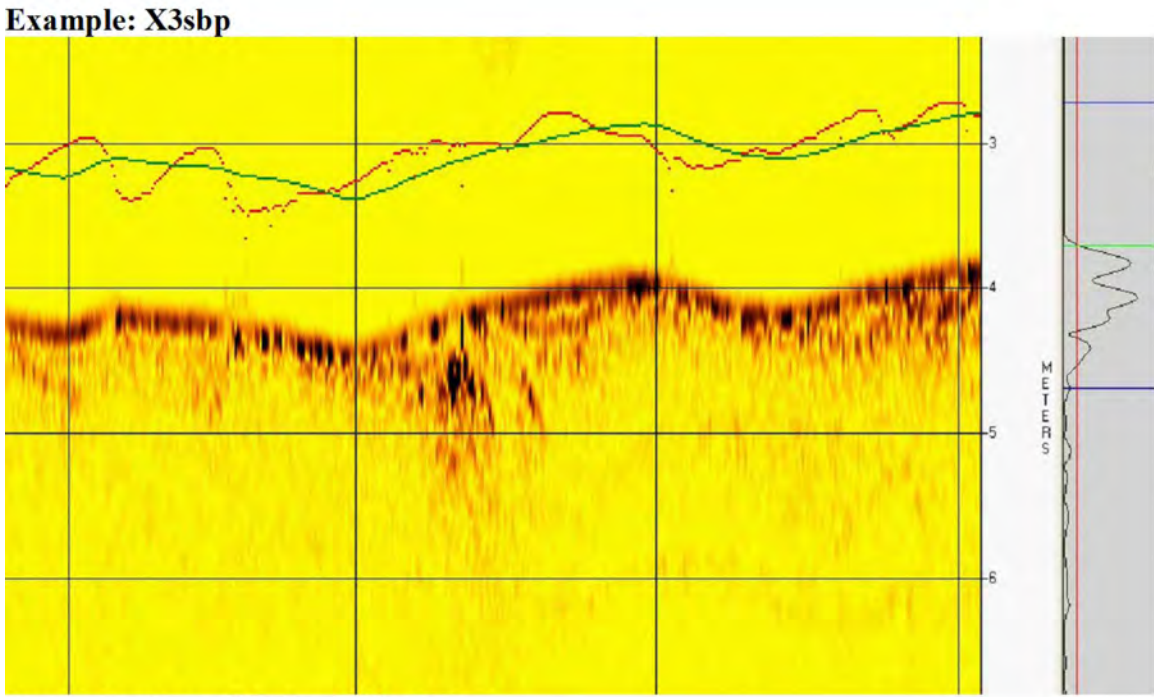


Example of possible backfill pattern.

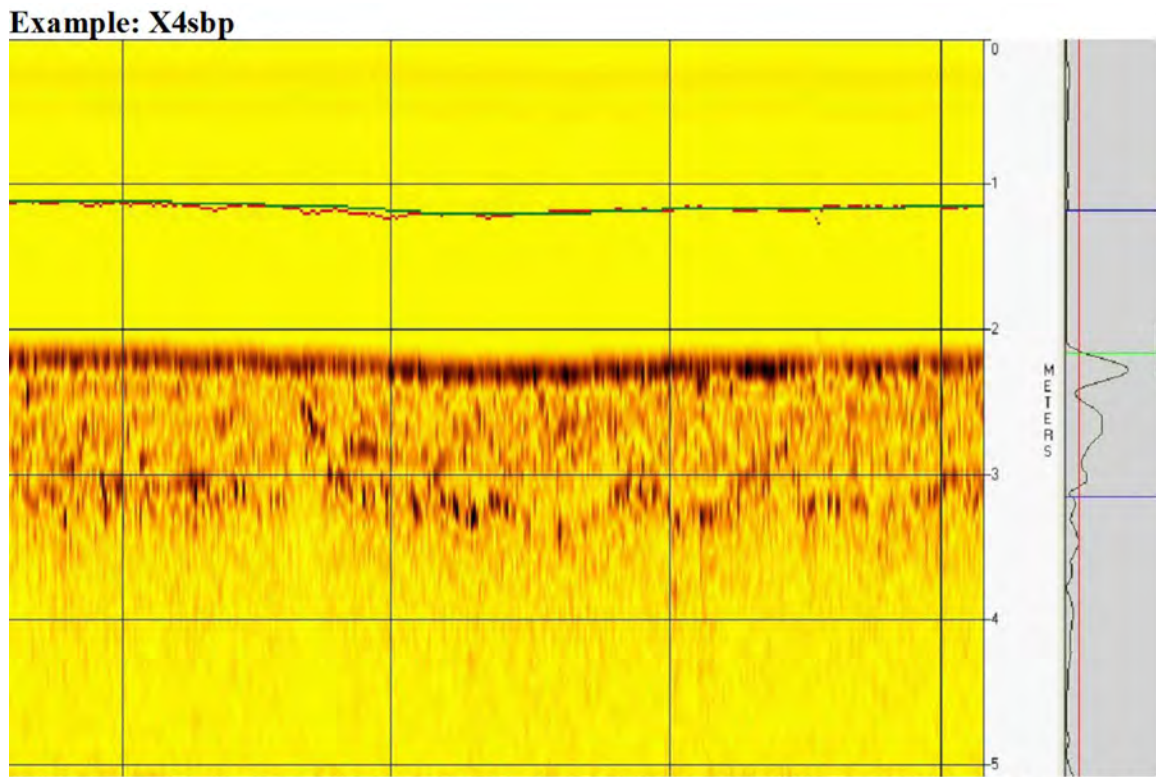


Example of Sub-surface anomaly. Object at 2.5meters with bottom at 2.1meters thus top of object may be buried 0.4meters. Note masking of sub-bottom reflector by object.

<div><div><div>Morgan & Eklund Inc.</div><div>PROFESSIONAL SURVEY CONSULTANTS</div><div><div>4909 US HIGHWAY #1 VERO BEACH, FL 32967 PHONE: (772) 388-5364 FAX: (772) 388-3165</div><div>1612 NW 2ND AVENUE SUITE 3 BOCA RATON, FL 33432 PHONE: (954) 421-6682 FAX: (954) 421-0425</div><div>LB #4298</div></div></div></div>		<div><div>CERTIFICATE OF SURVEYOR - I HEREBY CERTIFY THAT THE INFORMATION SHOWN HEREON IS IN ACCORDANCE WITH A RECENT FIELD SURVEY MADE UNDER MY DIRECTION, AND THAT IT IS TRUE AND CORRECT TO THE BEST OF MY KNOWLEDGE AND BELIEF, AND MEETS THE STANDARDS OF PRACTICE AS SET FORTH BY THE FLORIDA BOARD OF PROFESSIONAL LAND SURVEYORS IN CHAPTER 36-17, FLORIDA ADMINISTRATIVE CODE, PURSUANT TO SECTION 472.027, FLORIDA STATUTES.</div><div><div>JOHN R. MORGAN II, PLS</div><div>PROFESSIONAL LAND SURVEYOR #3520</div><div>STATE OF FLORIDA</div></div></div>		DIVER INVESTIGATION SURVEY OF POTENTIAL BURIED UTILITIES				COMMISSION NO. 5303.16	
INTRACOASTAL WATERWAY, CUT PB-36 THROUGH PB-41						SCALE AS SHOWN			
PALM BEACH COUNTY, FLORIDA						DATE 3/6/18			
FOR TAYLOR ENGINEERING, INC.									
DRAWN BY LFP		CHECKED BY JRM		FIELD BOOK PAGE NO.	SEE COVER	DATE OF SURVEY 2/15/18	SHEET 21 OF 22		

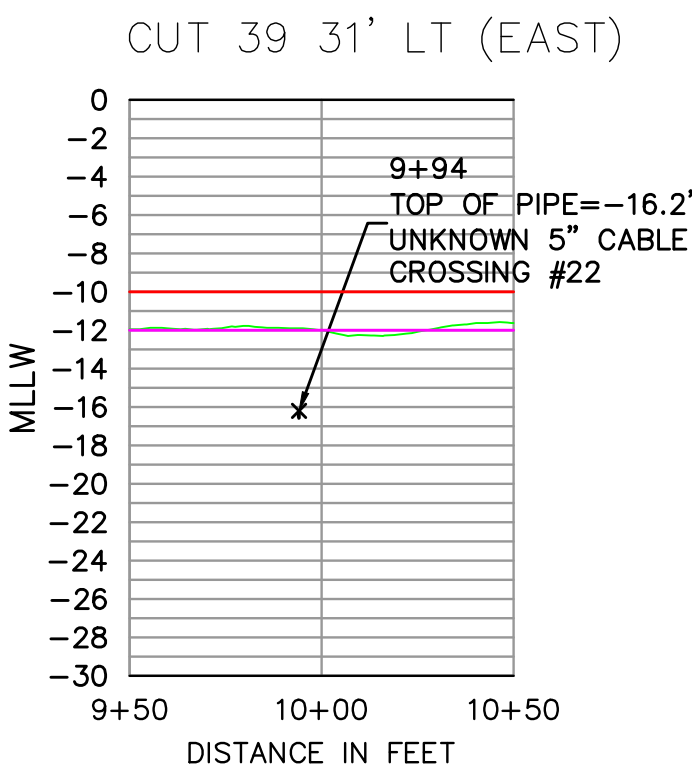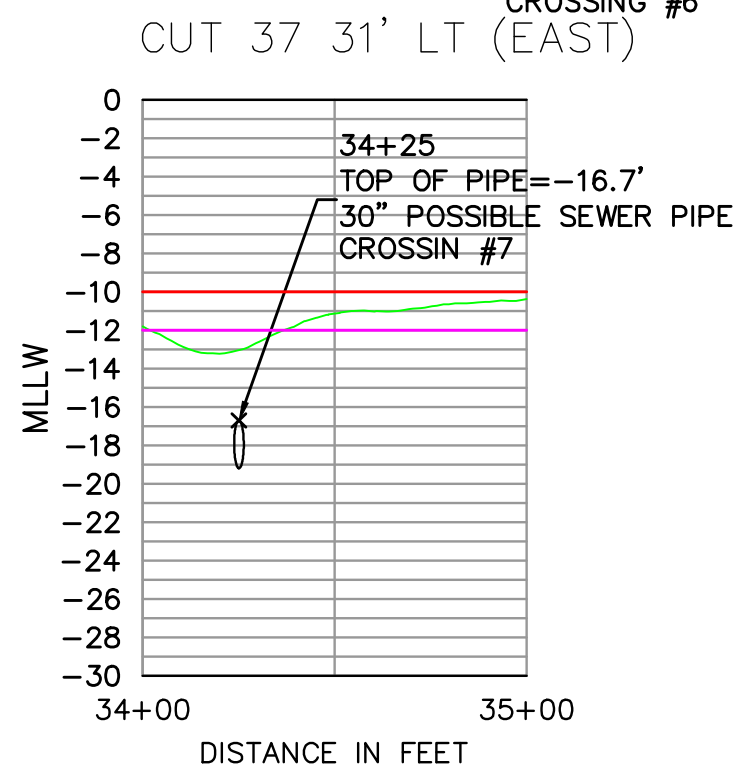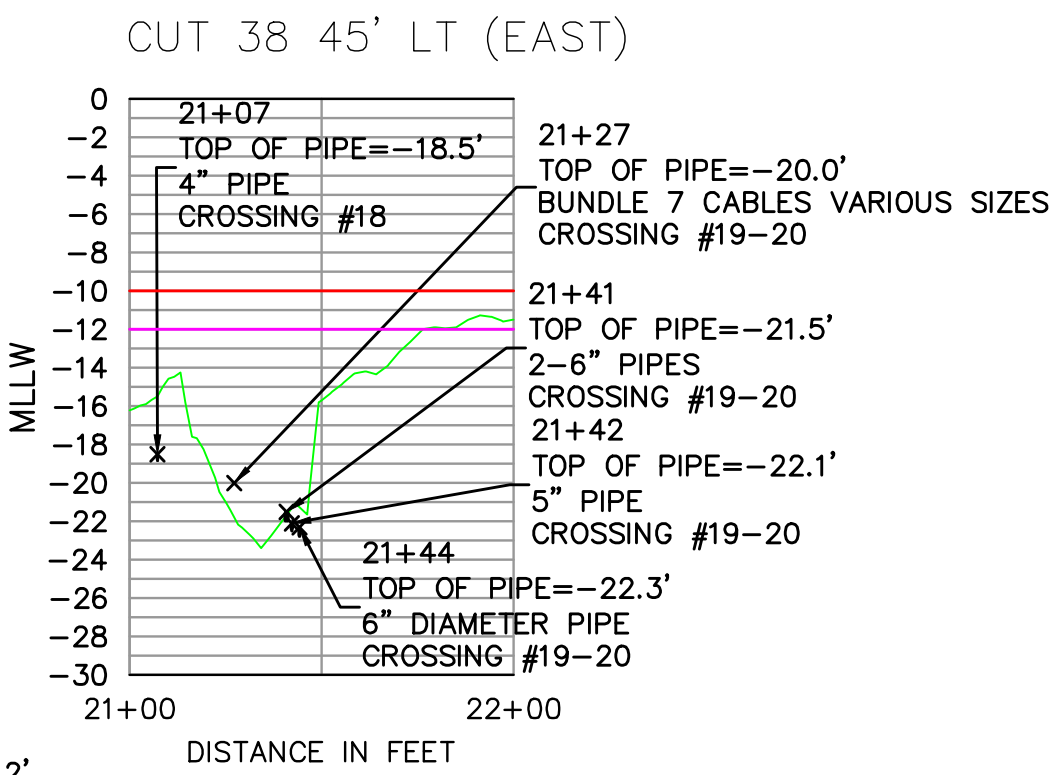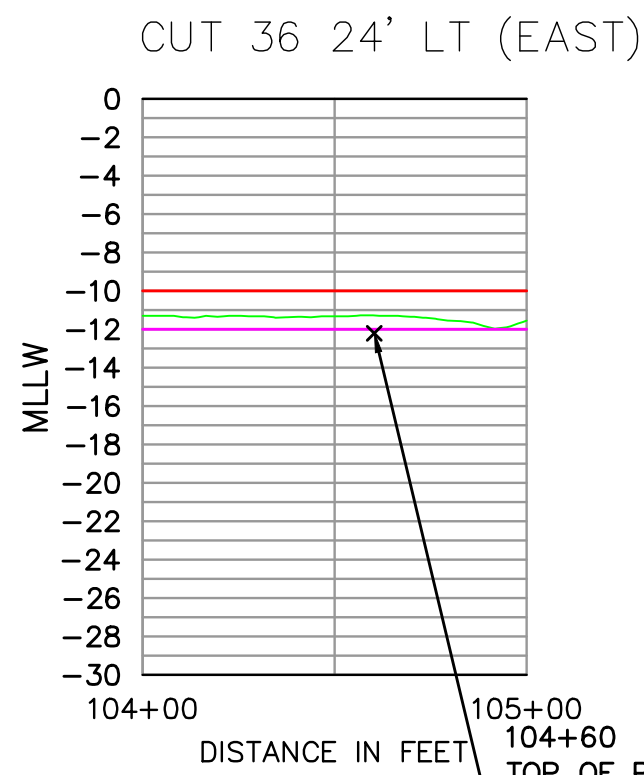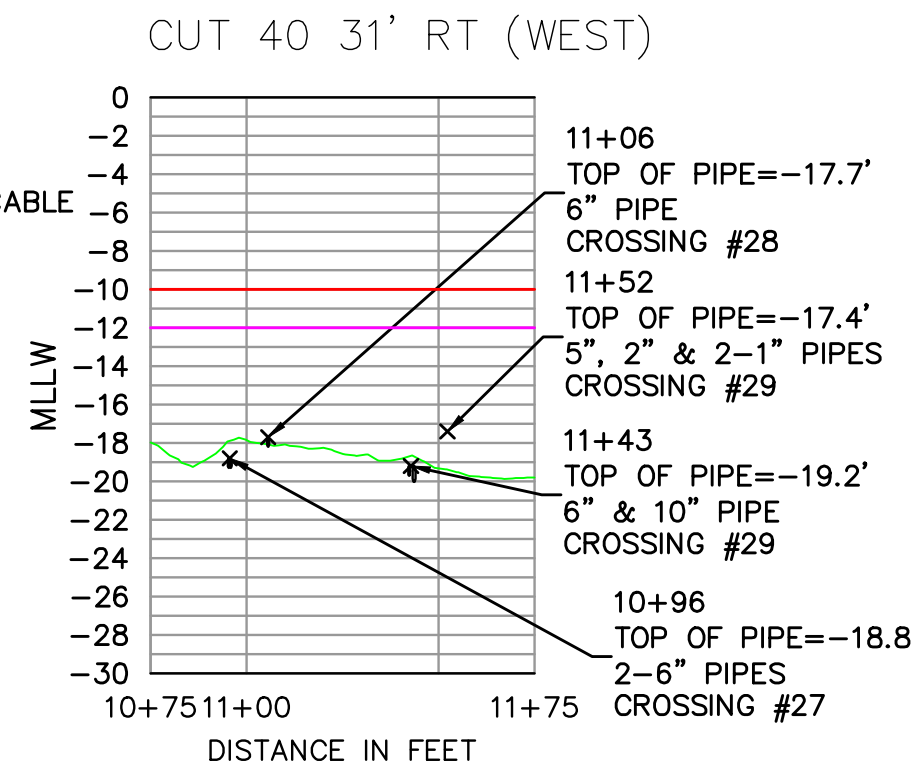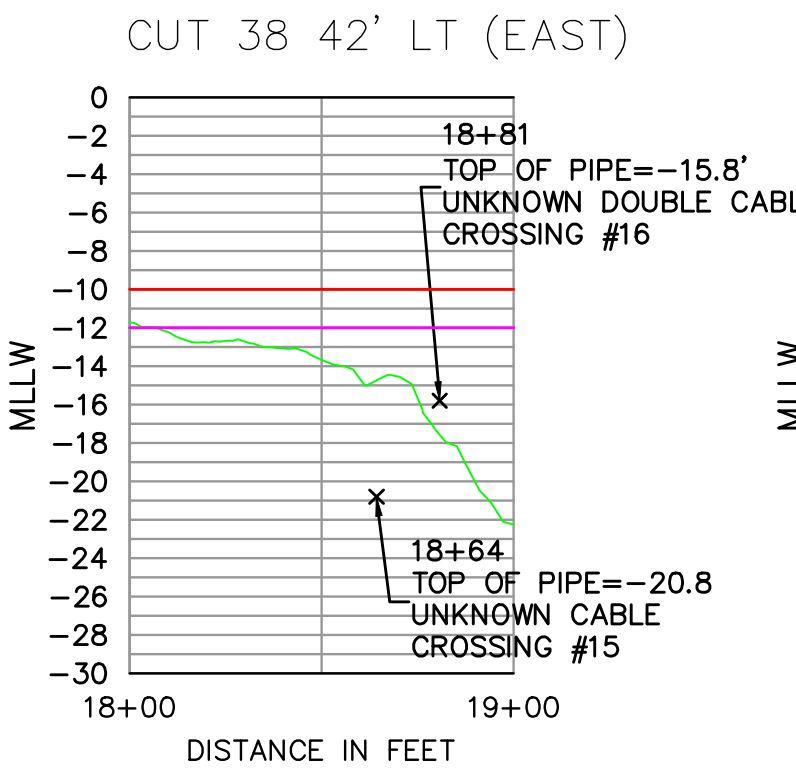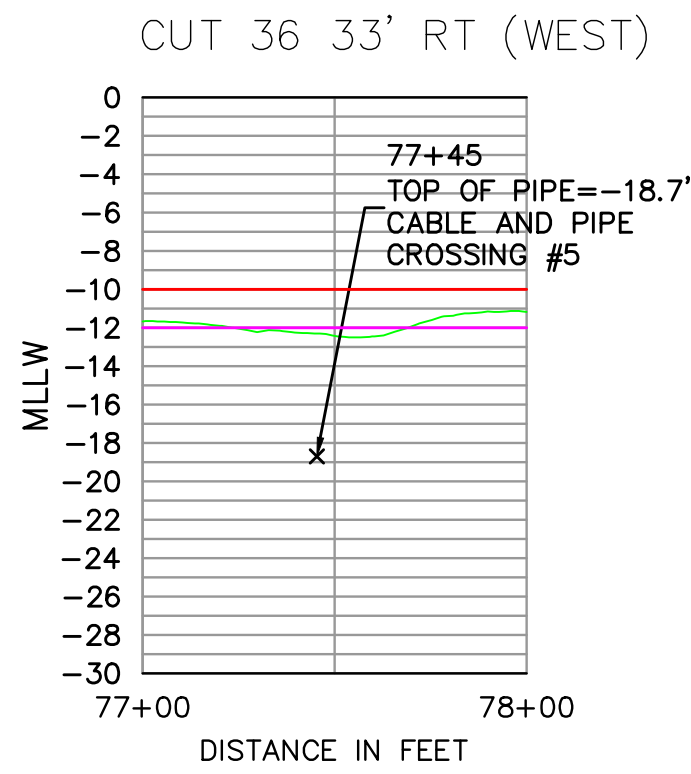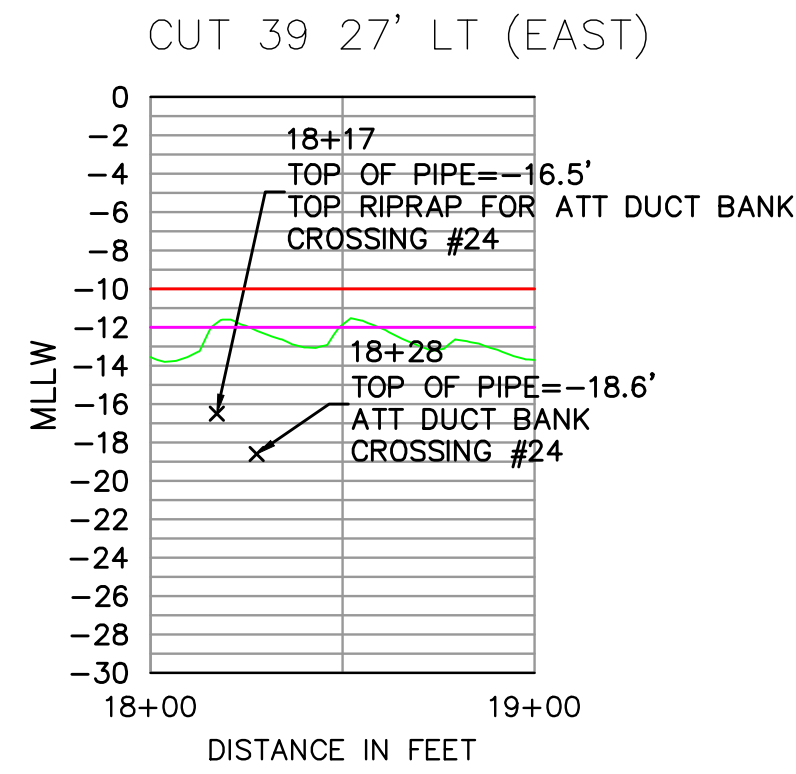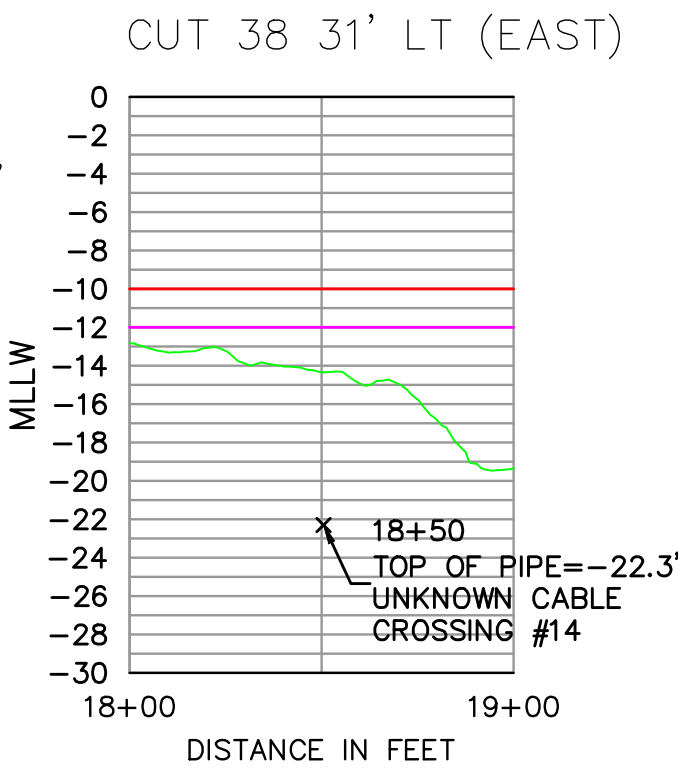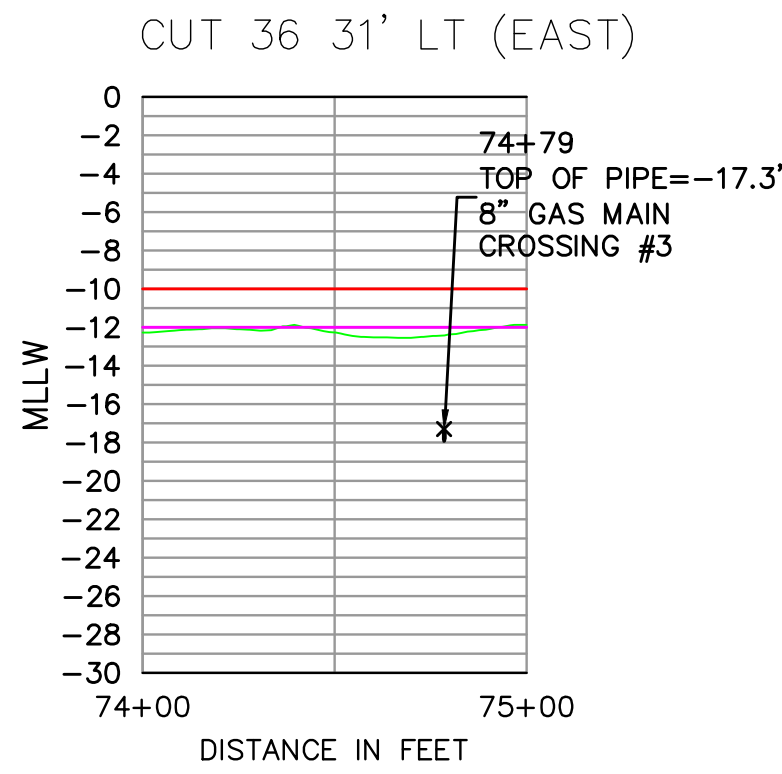

NOTE: ALL PROFILE VIEWS FACE EAST

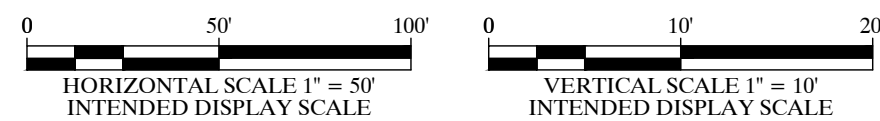

LEGEND

- DECEMBER 2015
- DESIGN SURFACE (-10' MLLW)
- DESIGN +2 (-12' MLLW)

Morgan & Eklund Inc.

PROFESSIONAL SURVEY CONSULTANTS

4909 US HIGHWAY #1
VERO BEACH, FL 32967
PHONE: (772) 388-5364
FAX: (772) 388-3165

1612 NW 2ND AVENUE
SUITE 3
BOCA RATON, FL 33432
PHONE: (954) 421-6682
FAX: (954) 421-0425

LB #4298

CERTIFICATE OF SURVEYOR - I HEREBY CERTIFY THAT THE INFORMATION SHOWN HEREON IS IN ACCORDANCE WITH A RECENT FIELD SURVEY MADE UNDER MY DIRECTION, AND THAT IT IS TRUE AND CORRECT TO THE BEST OF MY KNOWLEDGE AND BELIEF, AND MEETS THE STANDARDS OF PRACTICE AS SET FORTH BY THE FLORIDA BOARD OF PROFESSIONAL LAND SURVEYORS IN CHAPTER 63-17, FLORIDA ADMINISTRATIVE CODE, PURSUANT TO SECTION 472.027, FLORIDA STATUTES.

JOHN R. MORGAN II, PLS
PROFESSIONAL LAND SURVEYOR #3520
STATE OF FLORIDA

PROFILES (MLLW -10' PROJECT)					COMMISSION NO. 5303.16
DIVER INVESTIGATION SURVEY OF POTENTIAL BURIED UTILITIES					SCALE AS SHOWN
INTRACOASTAL WATERWAY, CUT PB-36 THROUGH PB-41 PALM BEACH COUNTY, FLORIDA FOR TAYLOR ENGINEERING, INC.					DATE 3/6/18
DRAWN BY LFP	CHECKED BY JRM	FIELD BOOK PAGE NO.	SEE COVER	DATE OF SURVEY 2/15/18	SHEET 22 OF 22