

CERTIFICATE OF LOCATION OF GOVERNMENT CORNER

SOUTHWEST Corner of Section 19, Township 41, Range 24, 4TH P.M.

STATE OF MINNESOTA, County of KANABEC

At the corner location shown on the sketch:

FOUND MONUMENT
AND ESTABLISHED G.P.S. COORDINATES ON THE LOCATION.

Kanabec County U.S. Survey Feet Coordinates
NAD 1983, HARN 1996 Adjustment
Obtained by RTK GPS Observation


Northing= 202764.38

Easting= 364620.39

Note: NAD 1983, HARN 1996 Adjustment
coordinates are NOT compatible with
NAD 1983 coordinates

Note: 1 Meter=3937/1200 U.S. Survey Feet

SKETCH OF REFERENCE TIES

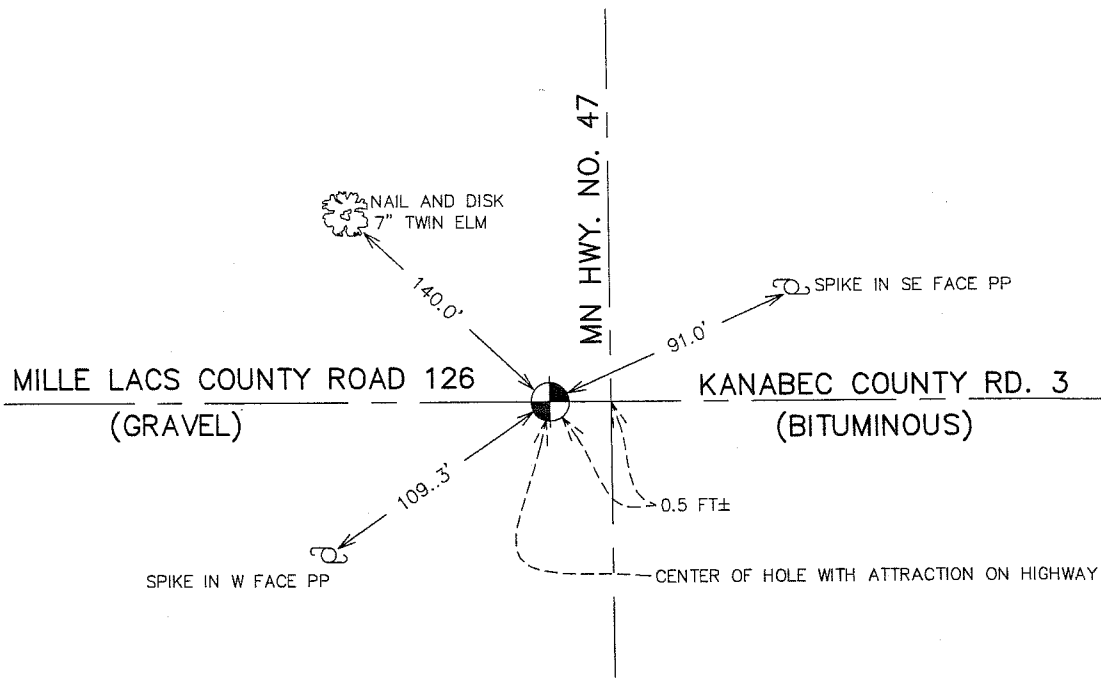

Statement of evidence relative to this corner location is on back of page.

I hereby certify that this document and the data contained herein was prepared by me or under my direct supervision.

Ernest G. Rud 1-23-2006
Signature Date

Registration No. Minn No 9808

- Land Surveyor, Professional Engineer
 County Surveyor, County Engineer

OFFICE OF THE COUNTY RECORDER

County of _____

I hereby certify that this document was filed in the County Recorder's office at _____ M. on the _____ day of _____ A.D., 20____

County Recorder _____

BY _____ Deputy

DOCUMENT NO. _____

STATEMENT OF EVIDENCE:

THE ORIGINAL CORNER WAS SET BY DEPUTY SURVEYOR ISAAC BANKER IN DECEMBER 1855. NO EVIDENCE FOR THE CORNER OR BEARING TREES REMAIN.

IN MARCH 1925 GEORGE JENKS FOUND A STONE MARKED WITH AND X AT THIS LOCATION AND IS RECORDED ON PAGE 88 OF SECTION CORNER TIES.

THE MINNESOTA HIGHWAY DEPARTMENT NOTED A STONE FOR THIS SECTION CORNER WHEN HIGHWAY 47 WAS CONSTRUCTED PRIOR TO 1956. IN APRIL 2004 WE RAN A SURVEY AROUND SECTION 7, 8, 9, 18, AND 19 TO LOCATE EXISTING MONUMENTATION AND TIES IN LINES OF OCCUPATION. WE FOUND A MONUMENT ON THE CENTERLINE OF HIGHWAY AND CENTERLINE OF COUNTY ROAD NO. 3 TO THE EAST. THIS MONUMENT FITS INFORMATION ON FILE FOR COUNTY ROAD 3 ESTABLISHED BY M.B. RUDE IN 1975.

WE ESTABLISHED KANABEC COUNTY COORDINATES ON THIS CORNER USING G.P.S. EQUIPMENT AND TOOK NEW TIES.