

# BERGEN TOWNSHIP

Each township has six files containing six sections in each, and one file containing all 36 sections.

Bergen01to06.pdf

Bergen07to12.pdf

Bergen13to18.pdf

Bergen19to24.pdf

Bergen25to30.pdf

Bergen31to36.pdf

BergenAll36.pdf

The points are listed starting with the point above the SE corner and continuing in a counter-clockwise rotation around the section. This normally begins with the East point, Northeast, then North, but may also include Witness Corners, and/or Meander Corners.

## **Definitions**


**Witness Corner:** A witness corner “stands in” when the true corner cannot be monumented or occupied because of difficult terrain or obstruction of the corner sight. The witness corner must be on the section line and is usually 5 or 10 chains away from the true corner.

**Meander Corner:** The intersection of a township, range, or section line and the banks of a navigable stream or meandering body of water.

# Certificate of Location of Government Corner

East Quarter corner, Section 1, Township 116 North, Range 27 West

SKETCH OF REFERENCE TIES (NO SCALE)

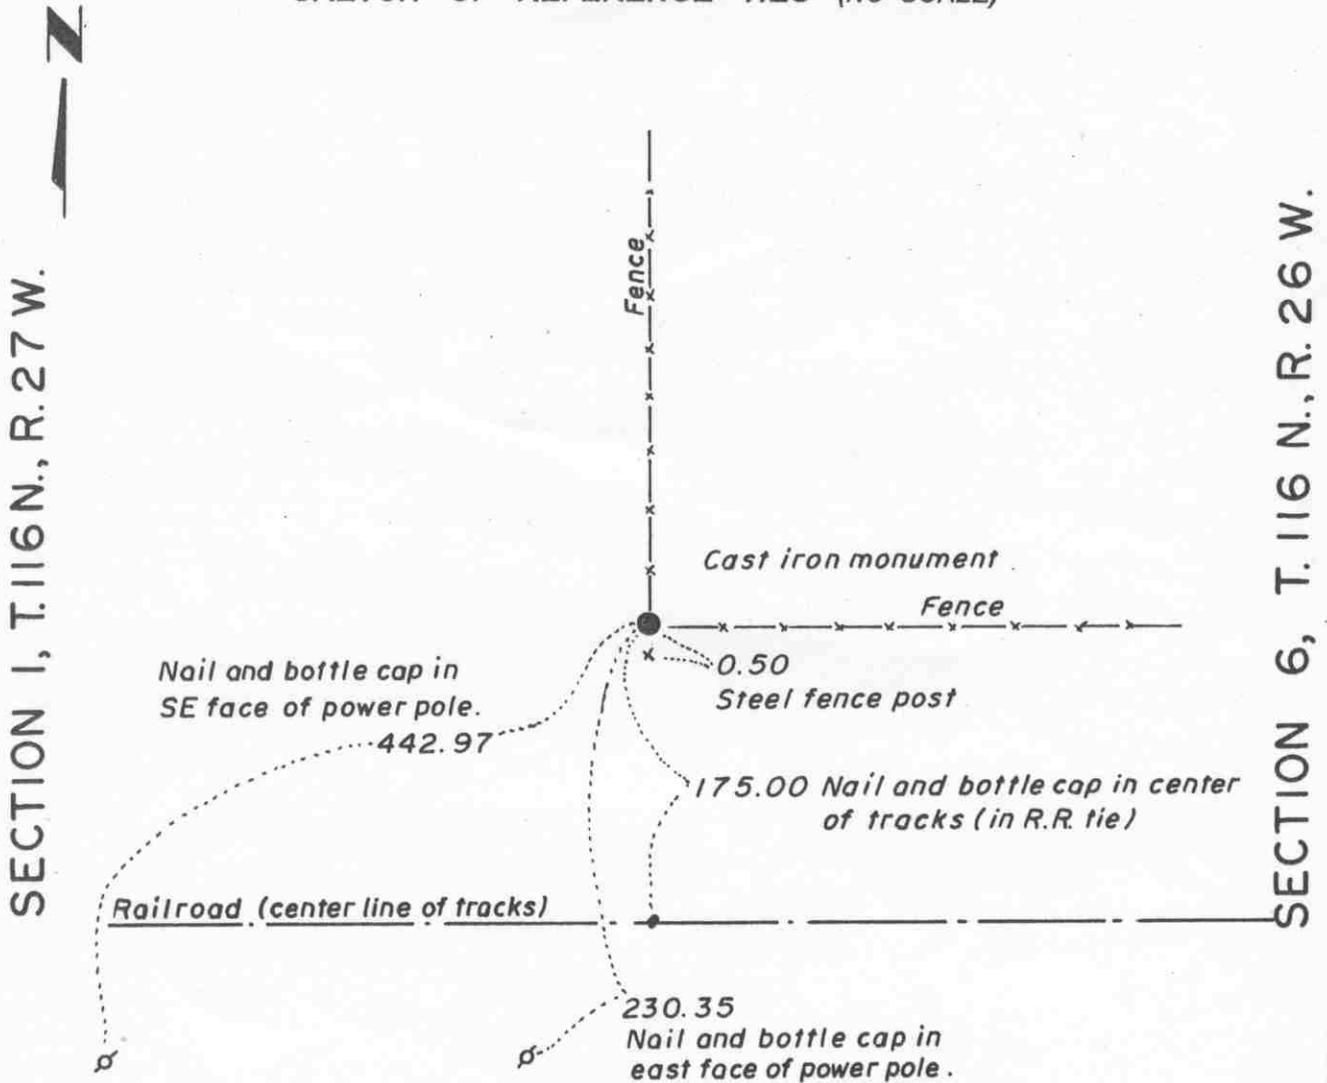

Statement of evidence relative to this corner location on sheet 2

I hereby certify that this document was prepared by me or under my direct supervision.

Willard Pellinen

Willard Pellinen  
McLeod County Surveyor  
License No. 9626.

Date Feb. 4, 1995

OFFICE OF THE COUNTY RECORDER  
MCLEOD COUNTY, MINNESOTA

I hereby certify that this document was filed in this office at 9 o'clock A. M. on the 6th day of February 19 95.

Carmen Otthi Mulder County Recorder

By \_\_\_\_\_, Deputy.

Document No. 264029

## ***Certificate of Location of Government Corner***

***East Quarter Corner, Section 1 Township 116 North, Range 27 West***

***1855. John Ryan of the General Land Office established this corner. He set a post and marked a 14 inch elm and a 6 inch ash for bearing trees.***

***The railroad right of way maps show this corner being 175 feet north of the center line of the railroad tracks. The adjoining property owners have no knowledge regarding the location of this corner. Dickman Knutson, county surveyor, dug around the fence intersection which was 175 feet north of the railroad center line, fences north and east, but found no evidence of the corner.***


***October 13, 1971. Knutson set a McLeod County cast iron monument at the fence intersection, 175 feet north of the railroad center line, and took available ties.***

***January 5, 1995. We checked the reference ties to the monument.***

# Certificate of Location of Government Corner

NORTHEAST corner, Section 1, Township 116 North, Range 27 West

SKETCH OF REFERENCE TIES (NO SCALE)

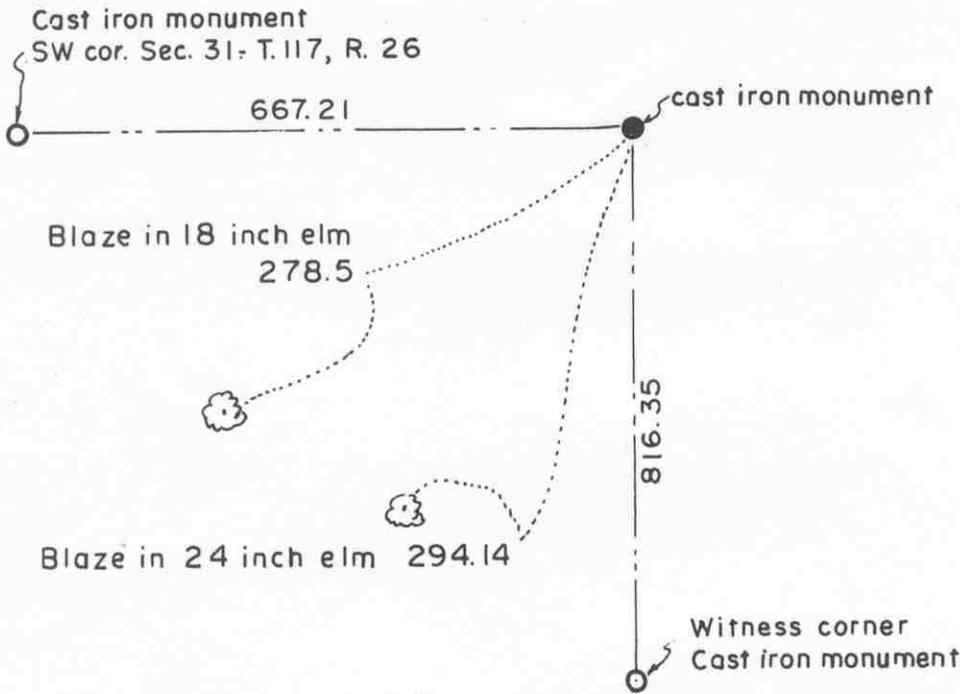

Statement of evidence relative to this corner location on sheet 2

I hereby certify that this document was prepared by me or under my direct supervision.

Willard Pellinen

Willard Pellinen  
McLeod County Surveyor  
License No. 9626.

Date Feb. 2, 1995

OFFICE OF THE COUNTY RECORDER  
MCLEOD COUNTY, MINNESOTA

I hereby certify that this document was filed in this office at 9 o'clock A. M. on the 6th day of February, 19 95.

Carmen Kottli Mulder County Recorder

By \_\_\_\_\_, Deputy.

Document No. 264028

NORTHEAST corner, Section 1, Township 116 North, Range 27 West

## Certificate of Location of Government Corner

1855.

This corner was not set by government. The corner fell in a marsh and John Ryan of the General Land Office set a witness corner on the south edge of the marsh along the east line of Section 1. Government distance from the witness corner to the northeast corner was 762.30 feet. Government distance from the northeast corner to the southeast corner of Section 31, Township 117, Range 27, was 591.36 feet;

August 25, 1971. McCombs Knutson Associates (Dickman Knutson, county surveyor) found a limestone monument at the witness corner. Knutson set a cast iron monument in place of the limestone and took available reference ties.


October 25, 1971. Knutson searched the area in the marsh on the northerly extension of the east line of Section 1 and the easterly extension of the southerly line of Section 31, but found nothing.

The Carver County Surveyor set a cast iron monument in the marsh to mark the northeast corner of Section 1. This is 816.35 feet north of the witness corner and 667.21 feet east of the southeast corner of Section 31.

# Certificate of Location of Government Corner

North Quarter      corner, Section   1  , Township  116  North, Range  27  West

## SKETCH OF REFERENCE TIES (NO SCALE)

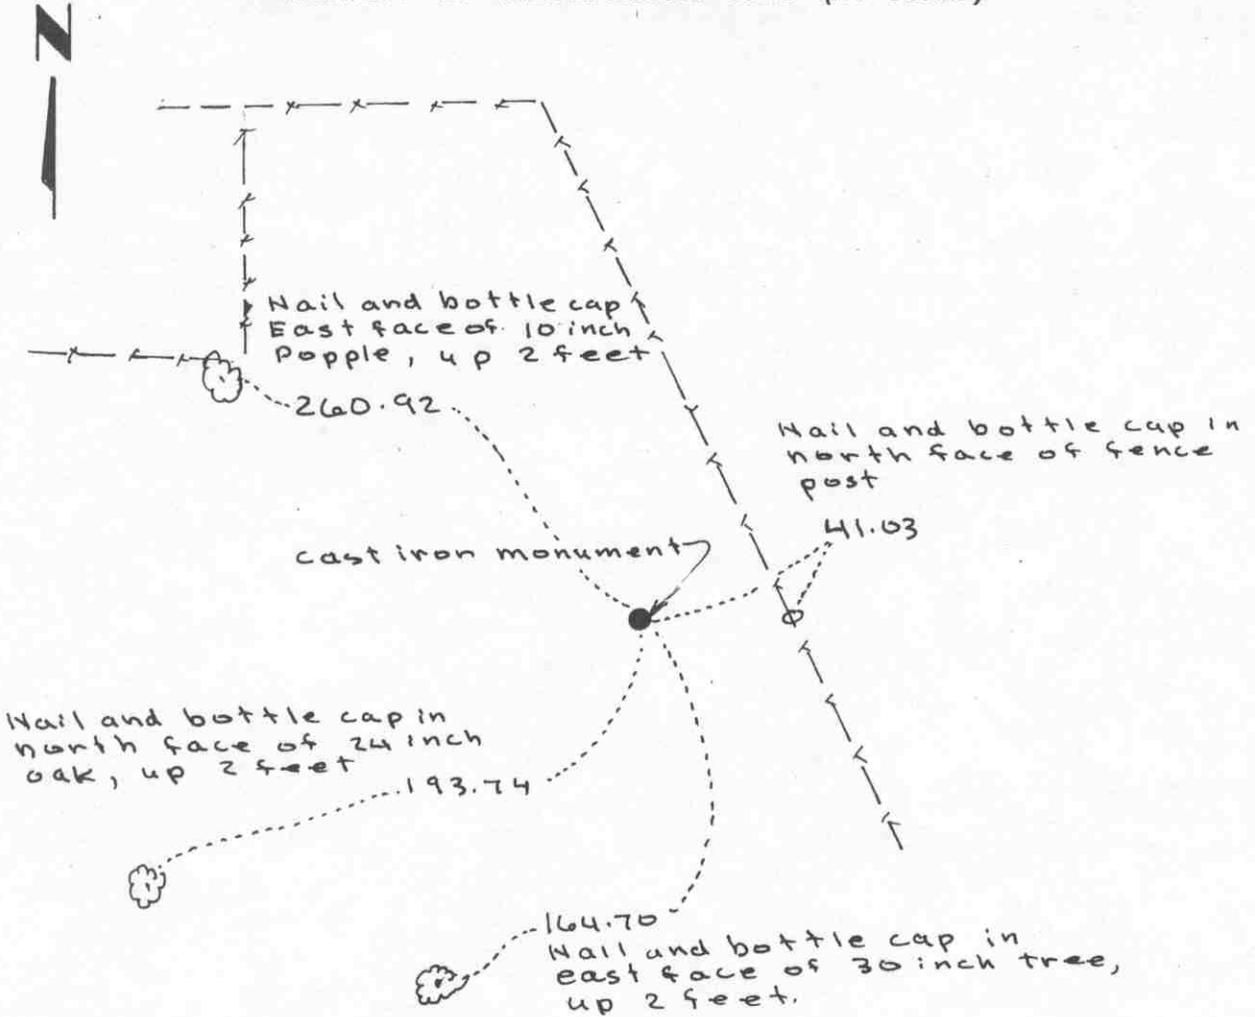

## SECTION 1

### Statement of evidence relative to this corner location on sheet 2

I hereby certify that this document was prepared by me or under my direct supervision.

Willard Pellinen  
 Willard Pellinen  
 McLeod County Surveyor  
 License No. 9626.

Date March 6, 1995

### OFFICE OF THE COUNTY RECORDER MCLEOD COUNTY, MINNESOTA

I hereby certify that this document was filed in this office at   9   o'clock   A   M. on the  16th  day of  March  19  95 .

Carmen O'Brien Mulder, County Recorder

By \_\_\_\_\_, Deputy.

Document No.   264722

**Certificate of Location of Government Corner**  
**North Quarter Corner, Section 1, Township 116 North, Range 27 West**

*March 14, 1980. We found an iron pipe at approximately half way between the section corners. This was along the north side of an old east-west fence. No property lines at the quarter corner. Same owner on all sides of the corner.*


*July 17, 1980. We replaced the found iron pipe with a McLeod County cast iron monument and took available reference ties.*

*January 5, 1995. We found the monument in good condition down 3 inches below the surface and took new reference ties.*

# Certificate of Location of Government Corner

EAST QUARTER corner, Section 2, Township 116 North, Range 27 West

SKETCH OF REFERENCE TIES (NO SCALE)

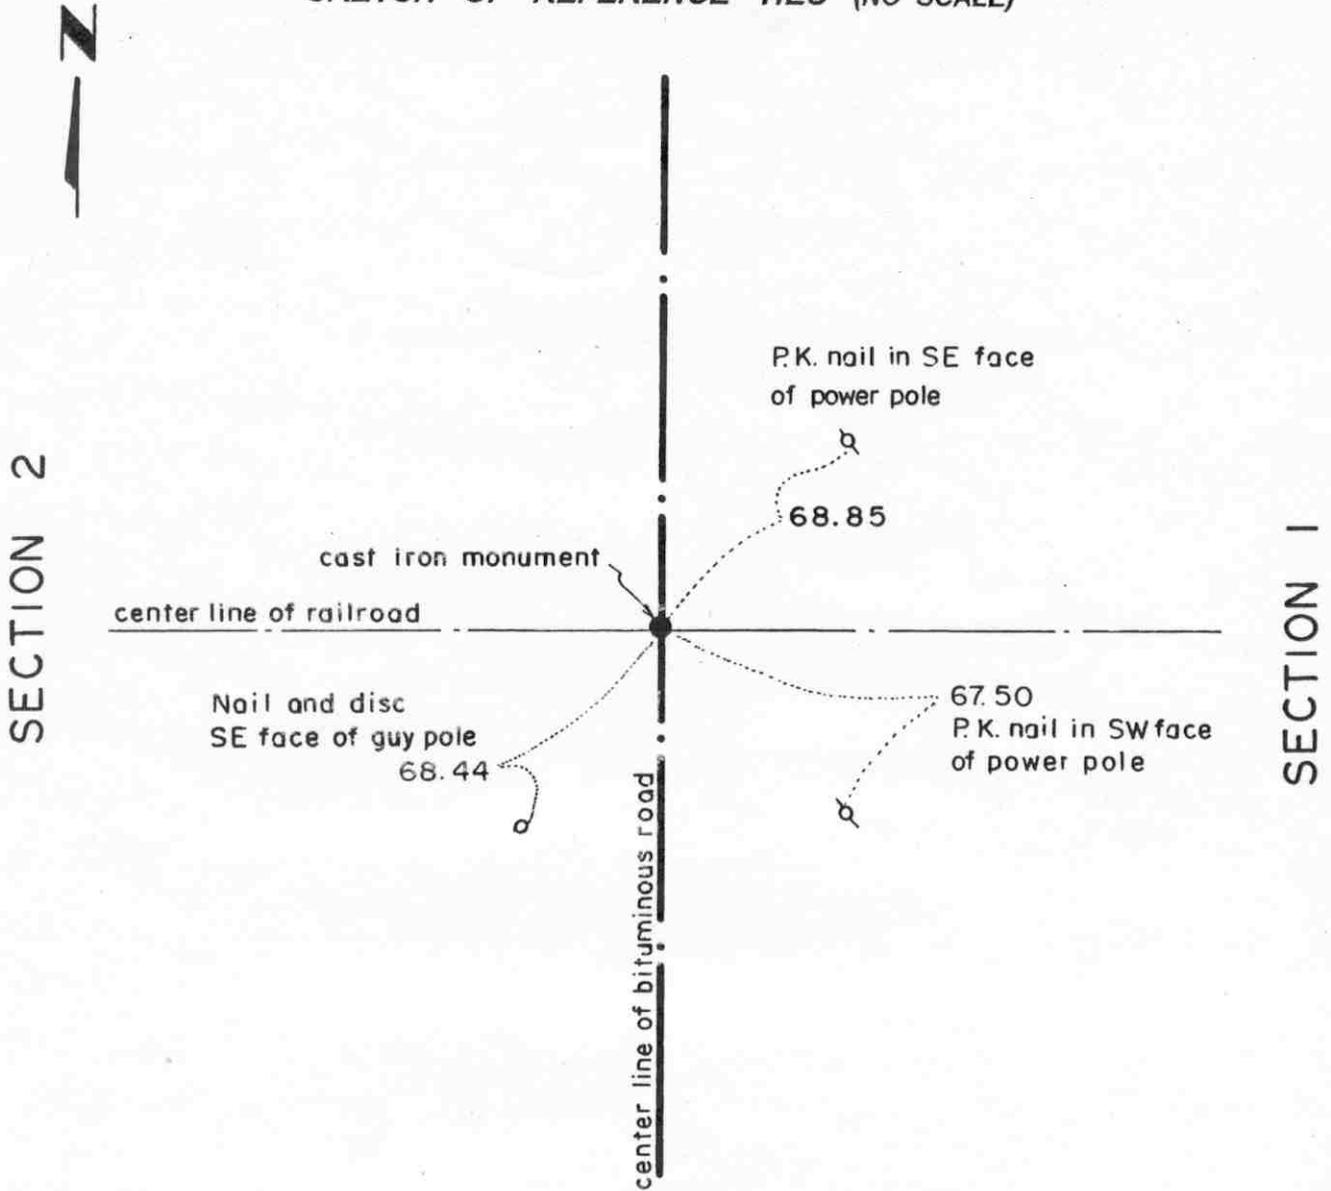

Statement of evidence relative to this corner location on sheet 2

I hereby certify that this document was prepared by me or under my direct supervision.

Willard Pellinen

Willard Pellinen  
McLeod County Surveyor  
License No. 9626.

Date August 26, 1994

OFFICE OF THE COUNTY RECORDER  
MCLEOD COUNTY, MINNESOTA

I hereby certify that this document was filed in this office at 9 o'clock A M. on the 9th day of Sept 19 94.

Carmen Hotter Mueller County Recorder

By \_\_\_\_\_, Deputy.

Document No. 261746

## ***Certificate of Location of Government Corner***

***East Quarter Corner, Section 2, Township 116 North, Range 27 West***

***November, 1856. E. N. Darling of the General Land Office originally established this corner. He set a post and marked 2 6 inch aspens for bearing trees.***

***Railroad right of way map shows the corner to be on the center line of the railroad.***

***May 21, 1974. Dickman Knutson, county surveyor, replaced a found 1/2 inch diameter iron pipe with a Mcleod County cast iron monument and took available reference ties.***


***August 23, 1994. We found the monument in good condition and checked the reference ties. This monument is about 22 feet south and 1 1/2 feet west of a lost position for this corner.***

***The monument set by Knutson is accepted as marking the correct location of the quarter corner. It fits long standing occupation lines (the center lines of the railroad and Highway 261) and it perpetuates the location of an older monument.***

NORTHEAST corner, Section 2, Township 116 North, Range 27 West

# Certificate of Location of Government Corner

## SKETCH OF REFERENCE TIES (NO SCALE)

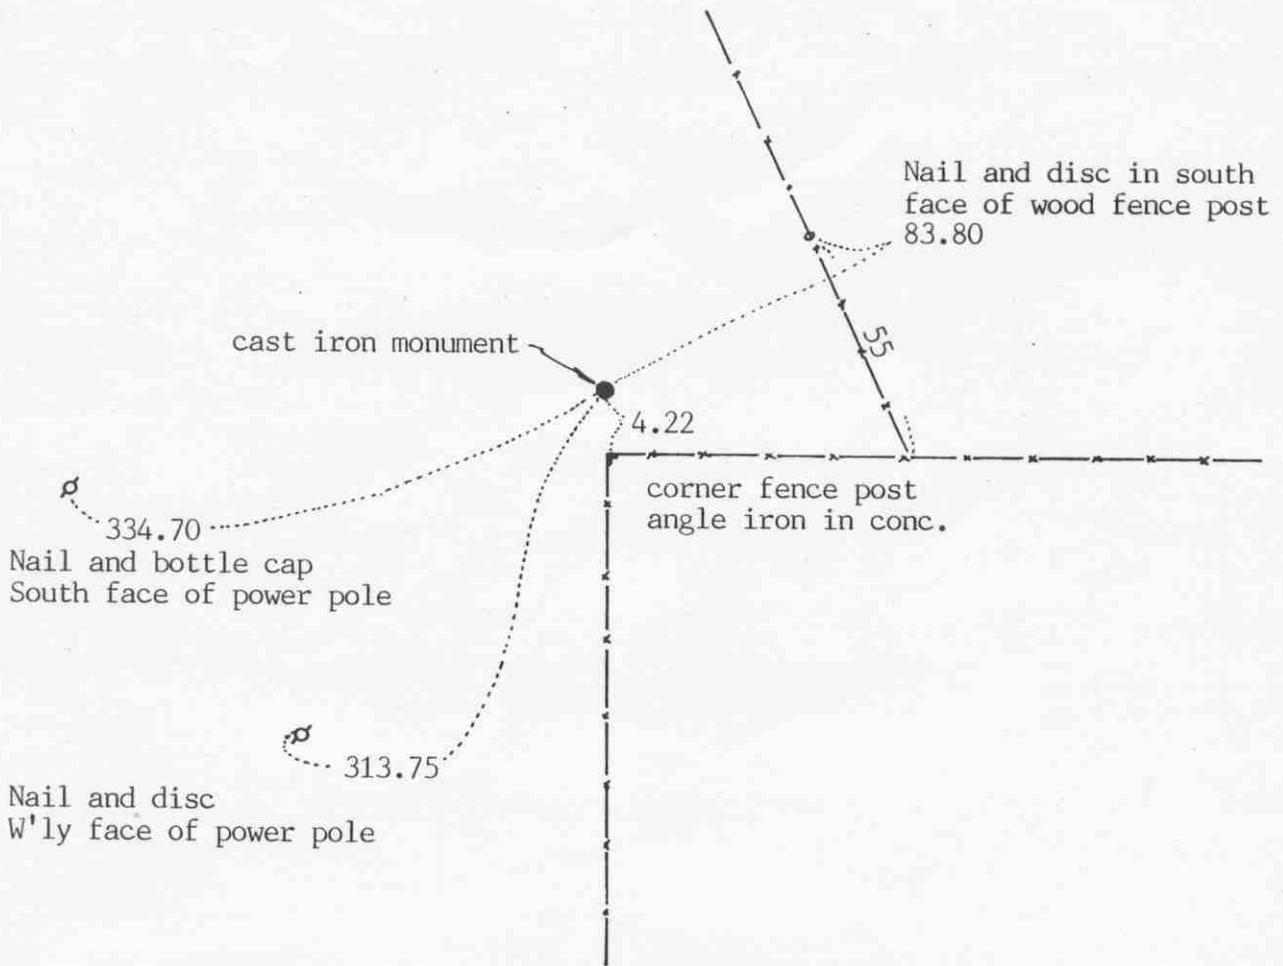

### Statement of evidence relative to this corner location on sheet 2

I hereby certify that this document was prepared by me or under my direct supervision.

Willard Pellinen

Willard Pellinen  
McLeod County Surveyor  
License No. 9626

Date Jan. 9, 1991

### OFFICE OF THE COUNTY RECORDER MCLEOD COUNTY, MINNESOTA.

I hereby certify that this document was filed in this office at 3 o'clock P.M. on the 15th day of Jan, 1991.

Carmen Ostlie, County Recorder

By \_\_\_\_\_, Deputy

Document No. 237103

NORTHEAST \_\_\_\_\_ corner, Section 2, Township 116 North, Range 27 West

## Certificate of Location of Government Corner

1855. This corner was originally set by John Ryan of the General Land Office. He set a post and marked 2 aspens for bearing trees.


November 23, 1968. McCombs Knutson Associates (Dickman Knutson, county surveyor) found an iron pin at the fence intersection. Fences running south and east. They replaced the iron pin with a McLeod County cast iron monument and took reference ties.

November 14, 1989. We reset the monument, 3.98 feet north to the standard parallel, and took new reference ties. We measured 559.01 feet to the southeast corner of Section 35, Township 117, Range 27, compared with a distance of 8.60 chains (567 feet) by the Government in 1855.

# Certificate of Location of Government Corner

North Quarter        corner, Section   2  , Township  116  North, Range  27  West

SKETCH OF REFERENCE TIES (NO SCALE)

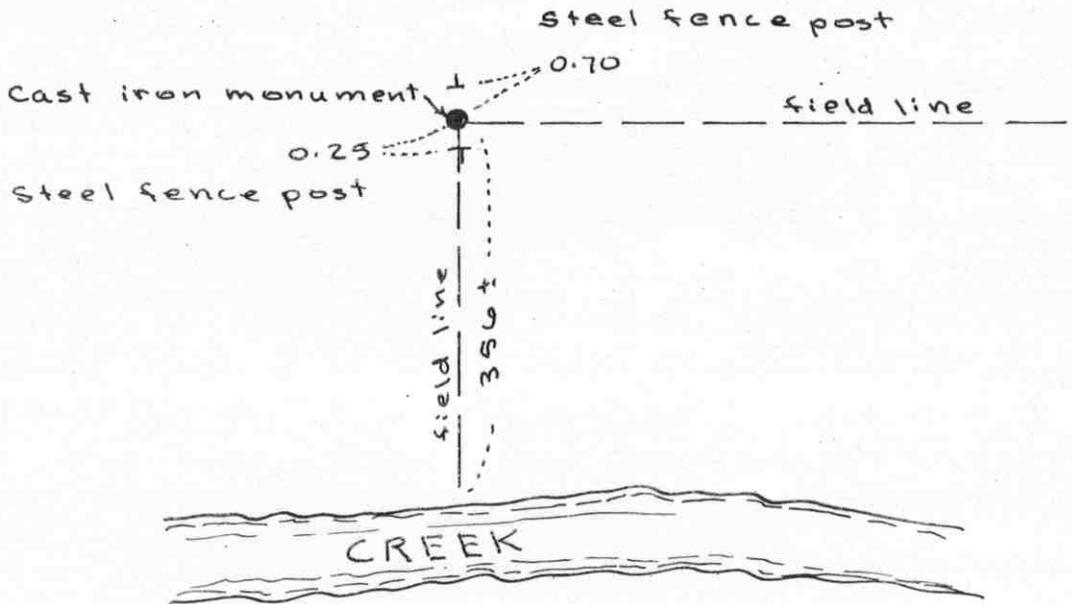

SECTION 2

Statement of evidence relative to this corner location on sheet 2

I hereby certify that this document was prepared by me or under my direct supervision.

Willard Pellinen

Willard Pellinen  
McLeod County Surveyor  
License No. 9626.

Date Jan. 9, 1995

OFFICE OF THE COUNTY RECORDER  
MCLEOD COUNTY, MINNESOTA

I hereby certify that this document was filed in this office at 9 o'clock A. M. on the 13th day of January, 19 95.

Carmin DeLia Mulder, County Recorder

By \_\_\_\_\_, Deputy.

Document No. 263713

NORTH QUARTER corner, Section 2, Township 116 North, Range 27 West

## Certificate of Location of Government Corner

1970. McCombs Knutson Associates (Dickman Knutson, county surveyor) found a wood stake on the northerly extension of Maple Street in Lester Prairie, on line between the south quarter corner and the southeast corner of Section 35, Township 117, Range 27. (on the standard parallel) This is approximately 11 feet west of a split between the northeast and northwest corners of Section 2.


August 27, 1970. Knutson set a McLeod County cast iron monument in place of the wood stake and took available reference ties.

***January 3, 1995. We found the monument in good condition and checked the reference ties.***

# Certificate of Location of Government Corner

EAST QUARTER corner, Section 3, Township 116 North, Range 27 West

SKETCH OF REFERENCE TIES (NO SCALE)

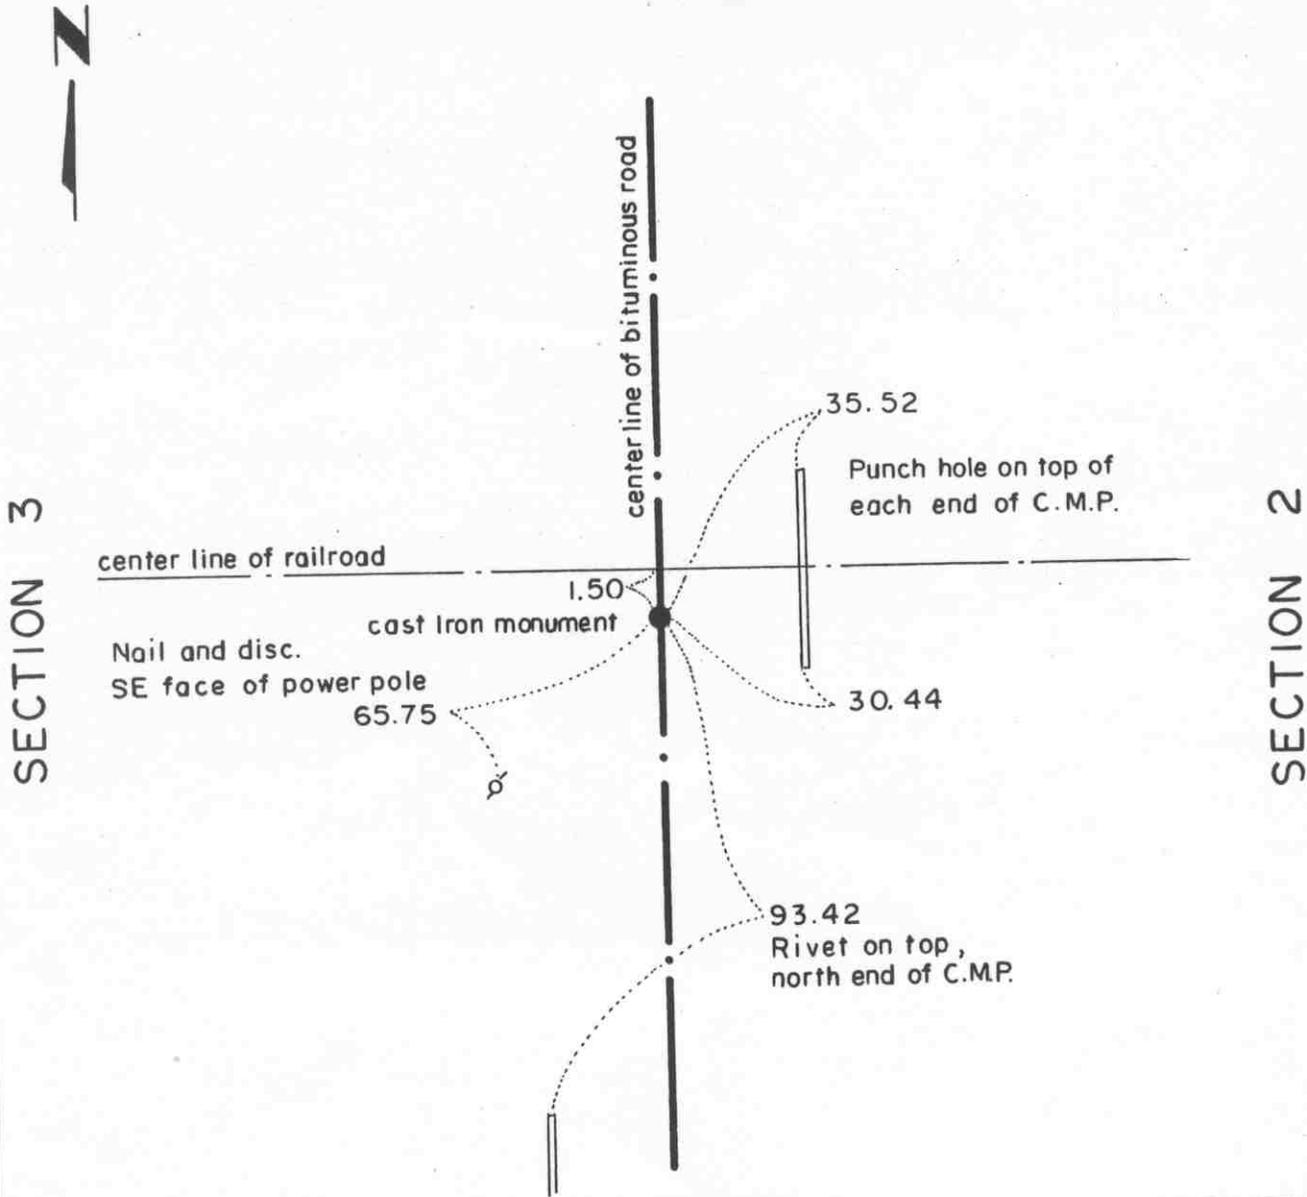

Statement of evidence relative to this corner location on sheet 2

I hereby certify that this document was prepared by me or under my direct supervision.

Willard Pellinen  
 Willard Pellinen  
 McLeod County Surveyor  
 License No. 9626.

Date August 26, 1994

OFFICE OF THE COUNTY RECORDER  
 MCLEOD COUNTY, MINNESOTA

I hereby certify that this document was filed in this office at 9 o'clock A. M. on the 9th day of Sept 1994.

Carmen Ostlie Mulder, County Recorder

By \_\_\_\_\_, Deputy.

Document No. 261748

## ***Certificate of Location of Government Corner***

***East Quarter Corner, Section 3, Township 116 North, Range 27 West †***

***November, 1856. E. N. Darling of the General Land Office originally established this corner. He set a post and marked a 6 inch and an 8 inch aspen for bearing trees.***

***March 21, 1974. Dickman Knutson, county surveyor, set a spike 1.50 feet north of the center line of the railroad, as shown on the railroad right of way map.***

***August 15, 1974. Knutson set a McLeod County cast iron monument and took available reference ties.***

***August 23, 1994. We found the monument in good condition and checked the reference ties.***

# Certificate of Location of Government Corner


NORTHEAST corner, Section 3, Township 116 North, Range 27 West

SKETCH OF REFERENCE TIES (NO SCALE)



SECTION 35 T. 117 R. 27

Monument is 0.47 south of standard parallel

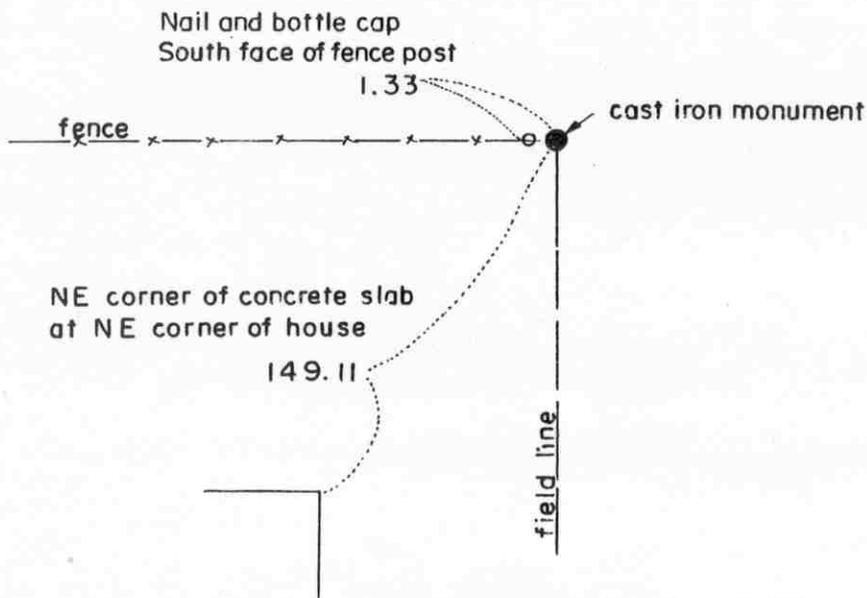

T. 116 R. 27

SECTION 3

SECTION 2

Statement of evidence relative to this corner location on sheet 2

I hereby certify that this document was prepared by me or under my direct supervision.

Willard Pellinen  
Willard Pellinen  
McLeod County Surveyor  
License No. 9626.

Date August 26, 1994

OFFICE OF THE COUNTY RECORDER  
MCLEOD COUNTY, MINNESOTA

I hereby certify that this document was filed in this office at 9 o'clock A.M. on the 9th day of Sept 19 94.

Carmen Estlie Mulder, County Recorder

By \_\_\_\_\_, Deputy.

Document No. 261747

## **Certificate of Location of Government Corner**

**Northeast Corner, Section 3, Township 116 North, Range 27 West**

**1855. John Ryan of the General Land Office first established this corner.**

**1931. State Highway No. 261 right of way map shows an iron pin at the corner.**

**November, 1968. Dickman Knutson, county surveyor, found an iron pin at the fence intersection, fences east, west and south. Knutson replaced the iron pin with a Mcleod County cast iron monument and took reference ties.**

**November 9, 1988. We found the monument in good condition 0.47 feet south of the standard parallel. We left the monument in place.**

**August 23, 1994. We found monument in good condition down 0.3 feet below the surface and checked the reference ties.**


# Certificate of Location of Government Corner

North Quarter corner, Section 3, Township 116 North, Range 27 West

## SKETCH OF REFERENCE TIES (NO SCALE)



Ties are 1/2 inch diam. iron pipes  
on shoulders of the road

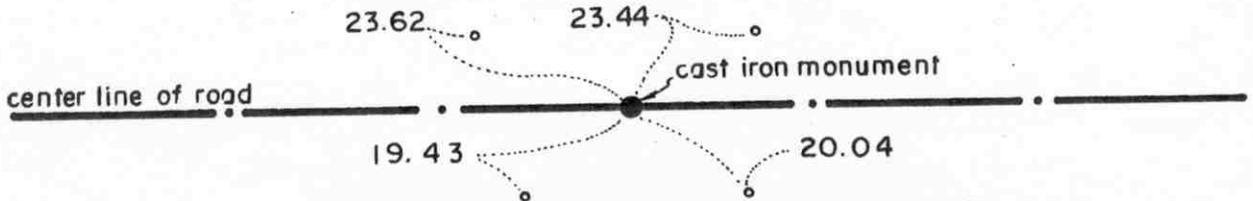

Monument is 1.99 feet south  
of standard parallel

field line

### Statement of evidence relative to this corner location on sheet 2

I hereby certify that this document  
was prepared by me or under my  
direct supervision.

Willard Pellinen

Willard Pellinen  
McLeod County Surveyor  
License No. 9626.

Date Sept. 6, 1994

### OFFICE OF THE COUNTY RECORDER MCLEOD COUNTY, MINNESOTA

I hereby certify that this document was filed in this office at 9  
o'clock A M. on the 9th day of Sept  
19 94.

Carmen Helis Mulder, County Recorder

By \_\_\_\_\_, Deputy.

Document No. 261749

NORTH QUARTER corner, Section 3, Township 116 North, Range 27 West

## *Certificate of Location of Government Corner*

November 22, 1968. McCombs Knutson Associates (Dickman Knutson, county surveyor) found an iron pipe in the center line of the east-west road in line with a fence to the south.

Knutson replaced the iron pipe with a McLeod County cast iron pipe and took reference ties.


November 7, 1988. We found the monument in good condition and found it to be 1.99 feet south of the standard parallel. We measured 518.32 feet to the south quarter corner of Section 34, Township 117, Range 27.

August 23, 1994. We found the bottom of the monument in good condition down 8 inches below the surface of the road. The top of the monument had been broken off. No old ties remaining so we took new ties to iron pipes on the shoulder of the road.

# Certificate of Location of Government Corner

EAST QUARTER corner, Section 4, Township 116 North, Range 27 West

SKETCH OF REFERENCE TIES (NO SCALE)

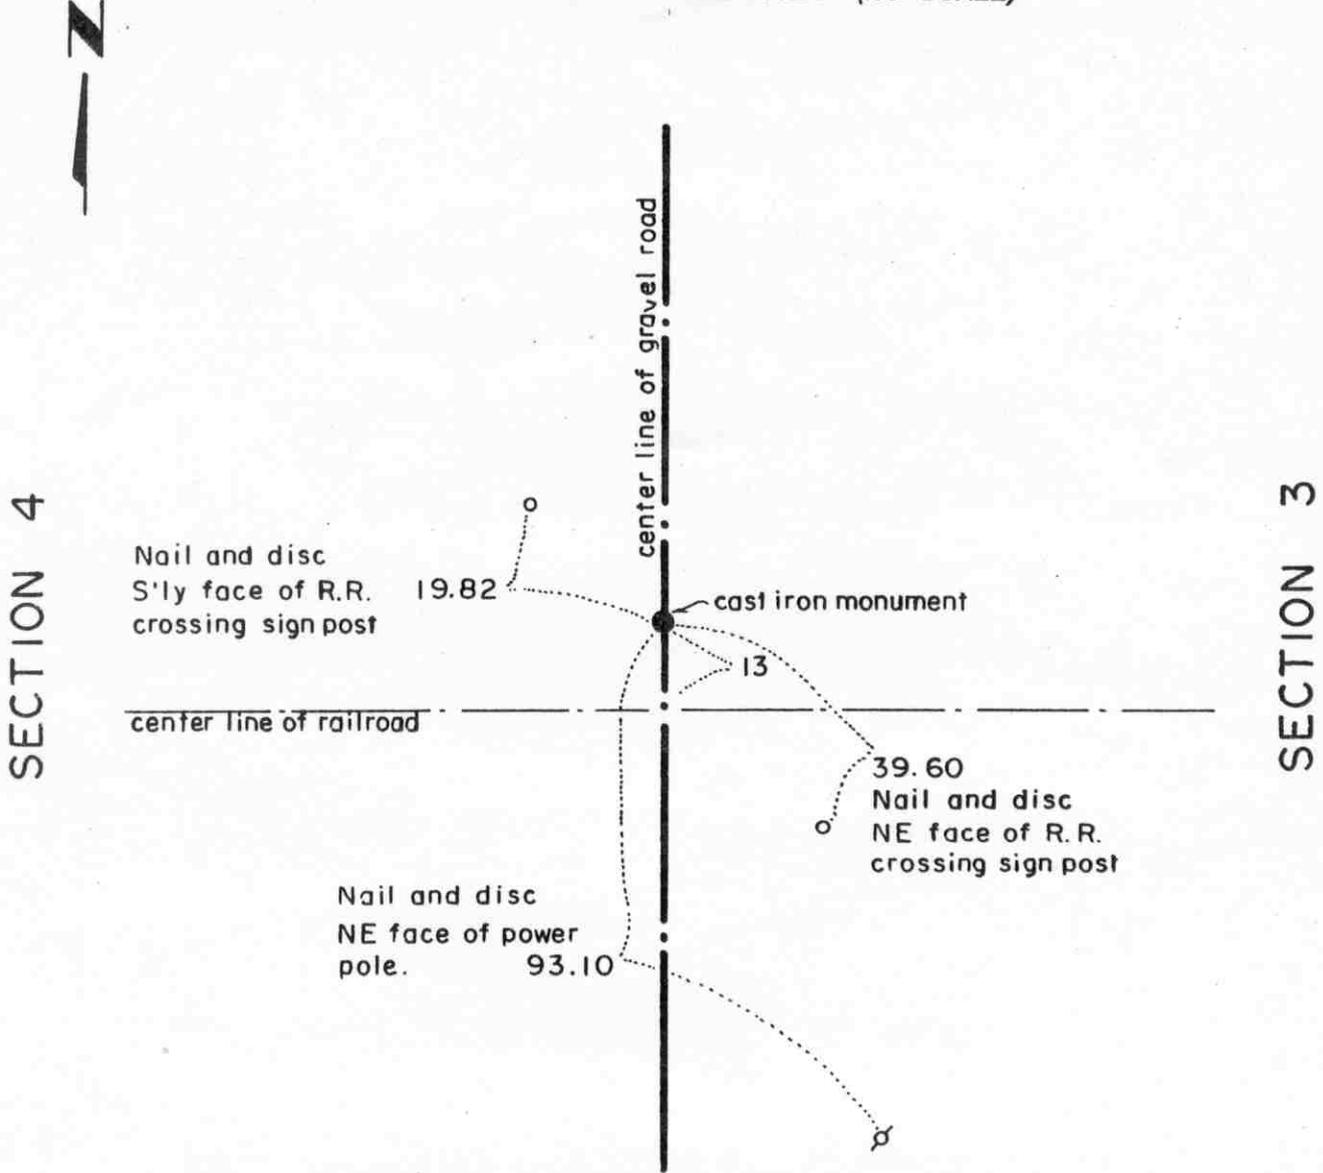

**Statement of evidence relative to this corner location on sheet 2**

I hereby certify that this document was prepared by me or under my direct supervision.

Willard Pellinen  
 Willard Pellinen  
 McLeod County Surveyor  
 License No. 9626.

Date August 25, 1994

**OFFICE OF THE COUNTY RECORDER  
 MCLEOD COUNTY, MINNESOTA**

I hereby certify that this document was filed in this office at 9 o'clock A. M. on the 9th day of Sept 19 94

Carmen Estlie Mulder County Recorder

By \_\_\_\_\_, Deputy.

Document No. 261751

## **Certificate of Location of Government Corner**

**East Quarter Corner, Section 4, Township 116 North, Range 27 West**

**November, 1856. E. N. Darling of the General Land Office set a post and marked an 8 inch and a 12 inch linden for bearing trees.**

**January 31, 1973. Dickman Knutson, county surveyor, excavated for the corner and found an iron pipe 13 feet north of the center line of the railroad as shown on the railroad right of way plans.**

**Knutson replaced the iron pipe with a McLeod County cast iron monument and took reference ties.**

**This is about 10 feet south and 5 feet west of a lost position for this corner.**

**August 23, 1994. We found the monument in good condition and checked the reference ties.**

# Certificate of Location of Government Corner


NORTHEAST corner, Section 4, Township 116 North, Range 27 West

SKETCH OF REFERENCE TIES (NO SCALE)

T. 117, R. 27



Monument is 0.28 south of Standard Parallel

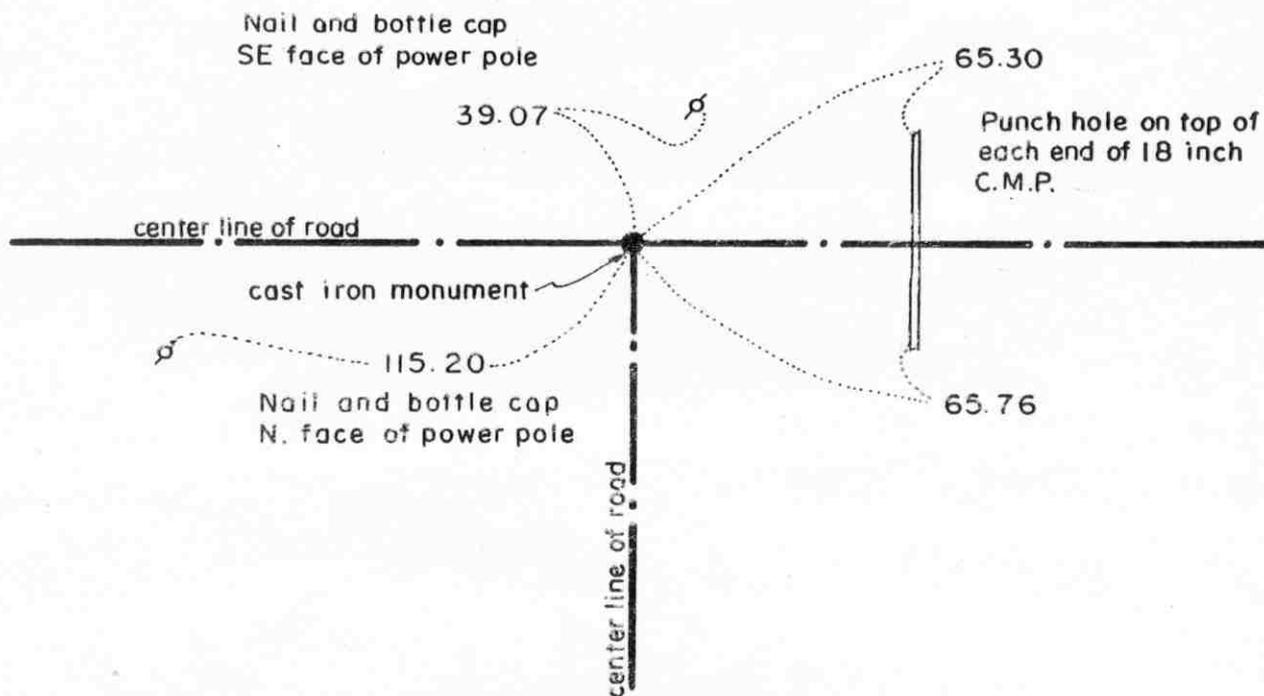

T. 116, R. 27

SECTION 4

SECTION 5

Statement of evidence relative to this corner location on sheet 2

I hereby certify that this document was prepared by me or under my direct supervision.

Willard Pellinen

Willard Pellinen  
McLeod County Surveyor  
License No. 9626.

Date Sept. 6, 1994

OFFICE OF THE COUNTY RECORDER  
MCLEOD COUNTY, MINNESOTA

I hereby certify that this document was filed in this office at 9 o'clock A. M. on the 9th day of Sept 19 94.

Carmin Otis Melder, County Recorder

By \_\_\_\_\_, Deputy.

Document No. 261750

NORTHEAST corner, Section 4, Township 116 North, Range 27 West

## Certificate of Location of Government Corner

1856. This corner was originally set by E. N. Darling of the General Land Office. He set a post and marked a 6 inch and a 15 inch elm for bearing trees. He measured 7.84 chains (517.44 feet) to the southwest corner of Section 34, Township 117, Range 27.

November 22, 1968. McCombs Knutson Associates (Dickman Knutson, county surveyor) set a temporary corner on the center line intersection of the roads. Roads east-west and south.

1970. Knutson dug for the corner (John Tupa from Hutchinson with a backhoe) They found a stone and a wood stake down below the original road bed. They took reference ties. Mr. Ortwin Seamann, road boss when the road was rebuilt, said he found a stone at most of the government corners in this road.

May 6, 1988. We found the monument in good condition and found it to be 0.27 feet south of the standard parallel and 528.84 feet east of the southwest corner of Section 34.


August 23, 1994. We found the monument in good condition down 8 inches below the surface of the road and took new available reference ties.

NORTH QUARTER corner, Section 4, Township 116 North, Range 27 West

# Certificate of Location of Government Corner

## SKETCH OF REFERENCE TIES

(NO SCALE)

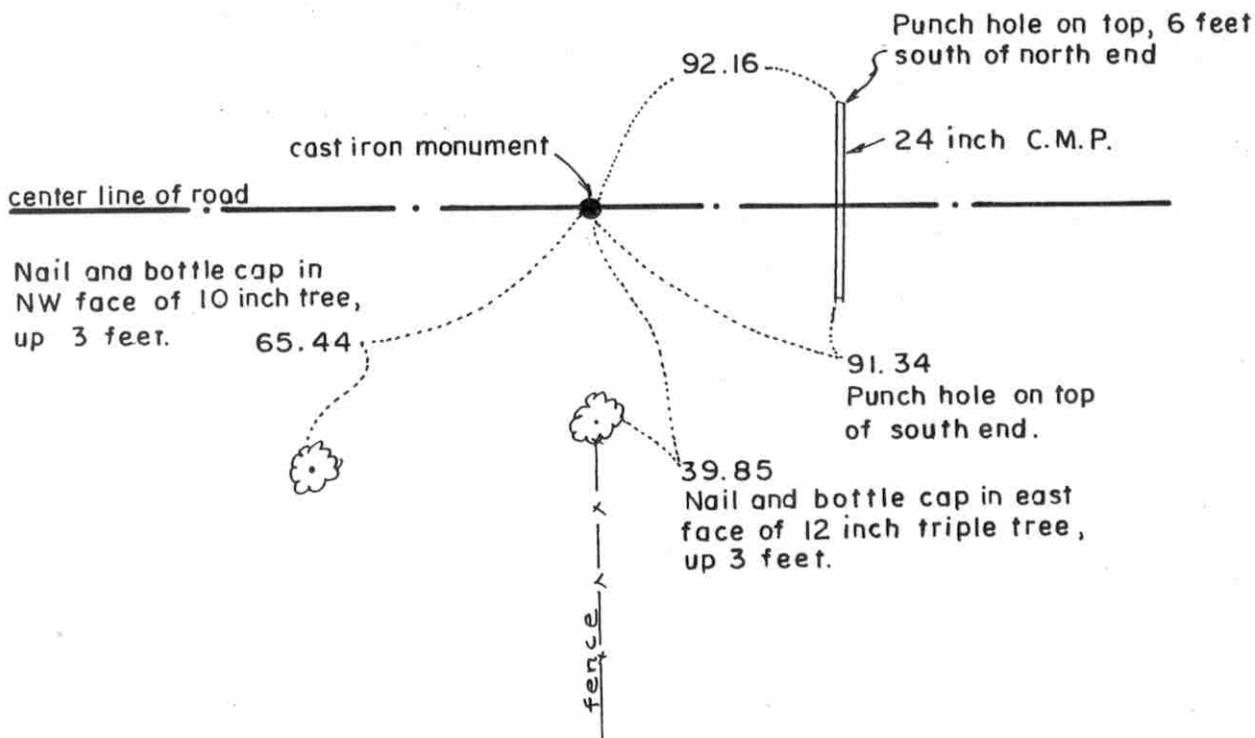

Statement of evidence relative to this corner location on sheet 2

I hereby certify that this document was prepared by me or under my direct supervision.

Willard Pellinen

Willard Pellinen  
McLeod County Surveyor  
License No. 9626

Date Jan. 4, 1995

OFFICE OF THE COUNTY RECORDER  
MCLEOD COUNTY, MINNESOTA.

I hereby certify that this document was filed in this office at 9 o'clock A. M. on the 10th day of January, 19 95.

Armin Otho Mulder County Recorder

By \_\_\_\_\_, Deputy

Document No. 263629

NORTH QUARTER            corner, Section 4, Township 116 North, Range 27 West

## Certificate of Location of Government Corner

November 22, 1968. McCombs Knutson Associates (Dickman Knutson, county surveyor) set a temporary quarter corner on the center line of the east-west road on line with a fence to the south.

1970. Knutson dug for the corner, John Tupa from Hutchinson with a backhoe. They found a stone down below the old road bed in the original ground. They took available ties. Mr. Ortwin Seamann, road boss when the road was rebuilt, said there were stones at most of the corners along this road. Knutson set a McLeod County cast iron monument.


May 6, 1988. We found the monument in good condition. We found it to be within 0.34 feet of being half way between the northeast and northwest quarter corners of Section 4. It was 0.11 feet north of the standard parallel.

***January 3, 1995. We took new reference ties to the monument.***

# Certificate of Location of Government Corner

East Quarter corner, Section 5, Township 116 North, Range 27 West

## SKETCH OF REFERENCE TIES (NO SCALE)

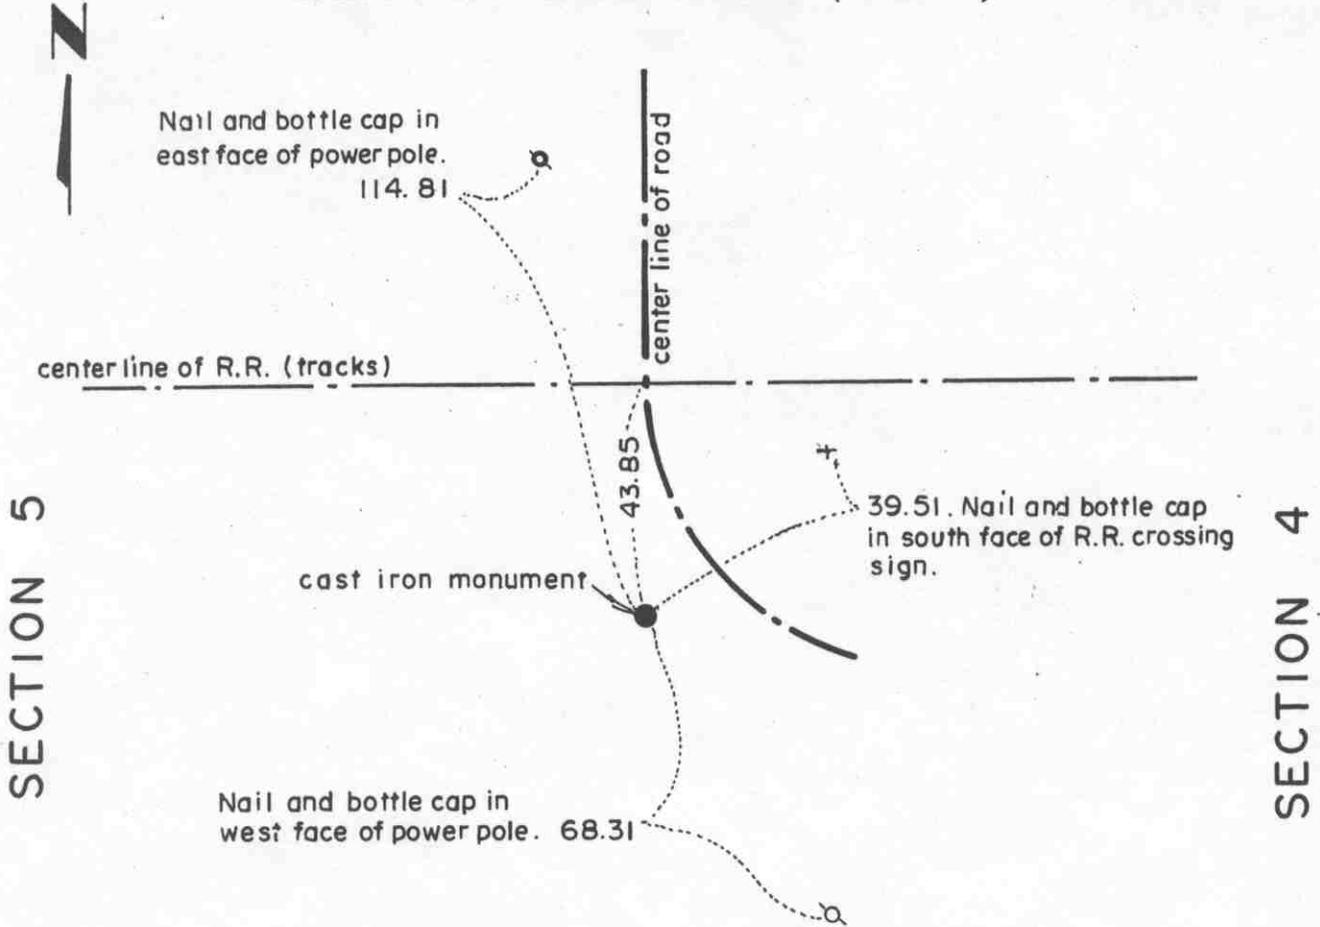

**Statement of evidence relative to this corner location on sheet 2**

I hereby certify that this document was prepared by me or under my direct supervision.

Willard Pellinen  
Willard Pellinen  
McLeod County Surveyor  
License No. 9626.

Date Jan. 4, 1995

**OFFICE OF THE COUNTY RECORDER  
MCLEOD COUNTY, MINNESOTA**

I hereby certify that this document was filed in this office at 9 o'clock A. M. on the 6th day of February, 19 95.

Carmen Ottilie Mulder, County Recorder

By \_\_\_\_\_, Deputy.

Document No. 264030

## ***Certificate of Location of Government Corner***

***East Quarter Corner, Section 5 Township 116 North, Range 27 West***

***November, 1856. E. N. Darling of the General Land Office established this corner. He set a post and marked a 7 inch elm and a 6 inch butternut for bearing trees.***

***January 31, 1973. Dickman Knutson, county surveyor, set an iron pipe along the center line of the north-south road, 44 feet south of the center line of the railroad as per railroad right of way map.***

***August 15, 1974. Knutson replaced the iron pipe with a McLeod County cast iron monument and took available reference ties.***


***This corner is 46.90 feet south and 23.82 feet west of a lost position for the corner.***

***January 3, 1995. We took new reference ties to the monument.***

NORTHEAST corner, Section 5, Township 116 North, Range 27 West

# Certificate of Location of Government Corner

## SKETCH OF REFERENCE TIES (NO SCALE)

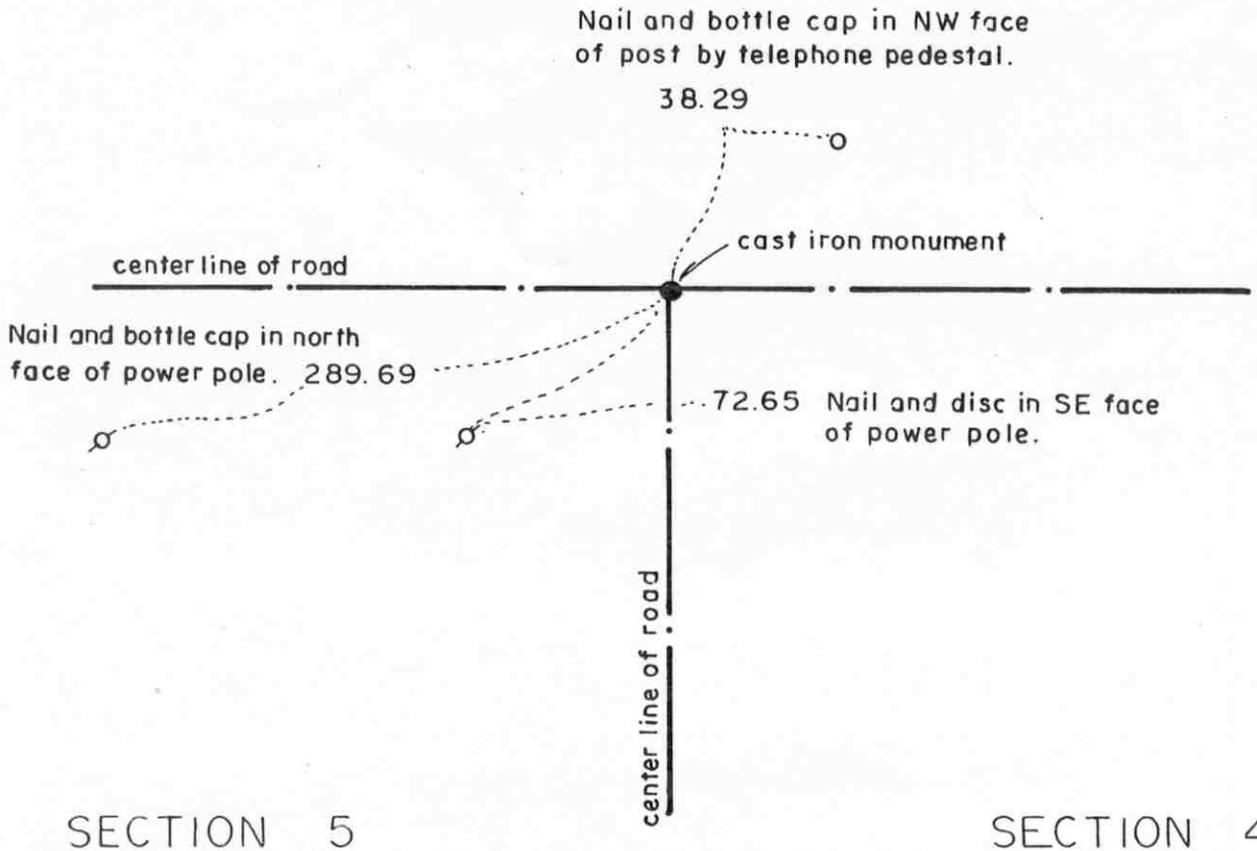

SECTION 5

SECTION 4

Statement of evidence relative to this corner location on sheet 2

I hereby certify that this document was prepared by me or under my direct supervision.

Willard Pellinen

Willard Pellinen  
McLeod County Surveyor  
License No. 9626

Date Jan. 4, 1995

OFFICE OF THE COUNTY RECORDER  
MCLEOD COUNTY, MINNESOTA.

I hereby certify that this document was filed in this office at 9 o'clock A.M. on the 10th day of January, 1995.

Carmin Ottilie Mulder County Recorder

By \_\_\_\_\_, Deputy

Document No. 263630

NORTHEAST                      corner, Section 5, Township 116 North, Range 27 West

## Certificate of Location of Government Corner

1856. E. N. Darling of the General Land Office originally established this corner. He set a post and marked a 14 inch and a 20 inch linden for bearing trees. He measured 7.80 chains (514.80 feet) to the southwest corner of Section 33, Township 117, Range 27.

November 22, 1968. McCombs Knutson Associates (Dickman Knutson, county surveyor) set a temporary corner along the center line of the east-west road and the center line of the road running south.

1970. Knutson dug at the temporary corner and found a wood post down in the original ground. Knutson took available reference ties and set a McLeod County cast iron monument at the corner.


May 6, 1988. We found the monument in good condition and found it to be on the standard parallel and we measured 507.64 feet to the southwest corner of Section 33.

***January 3, 1995. We took new reference ties to the monument.***

NORTH QUARTER corner, Section 5, Township 116 North, Range 27 West

# Certificate of Location of Government Corner

## SKETCH OF REFERENCE TIES (NO SCALE)

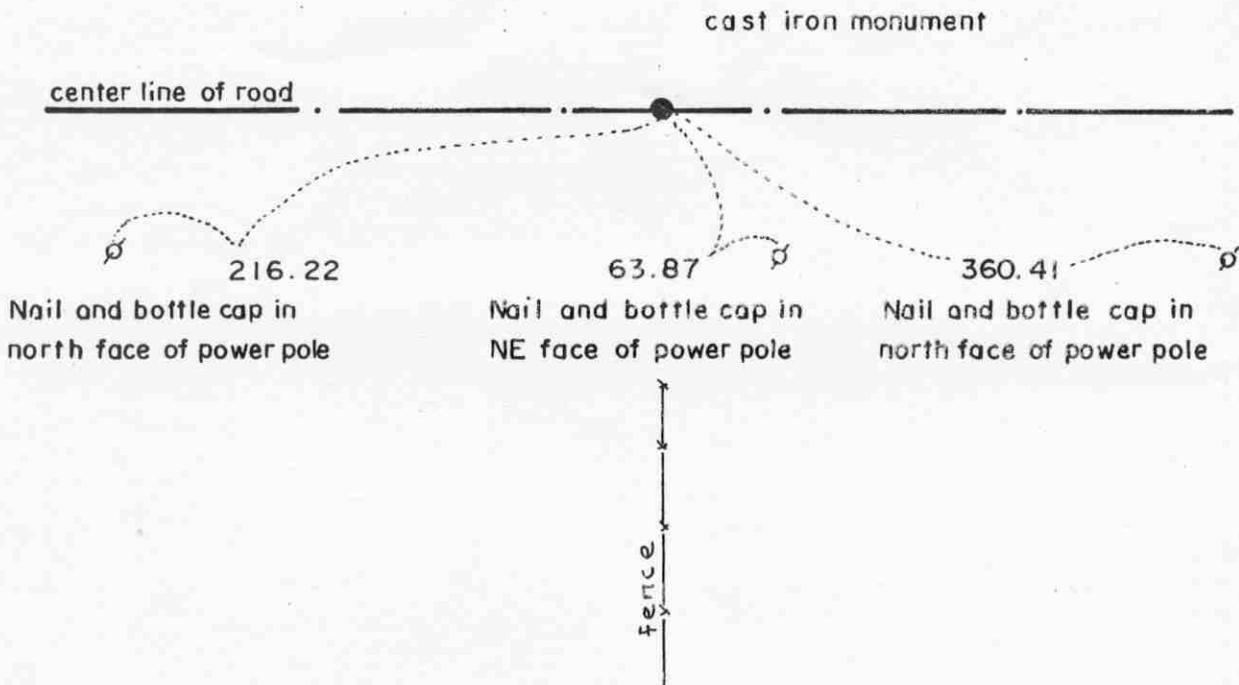

Statement of evidence relative to this corner location on sheet 2

I hereby certify that this document was prepared by me or under my direct supervision.

Willard Pellinen  
Willard Pellinen  
McLeod County Surveyor  
License No. 9626

Date Jan. 4, 1995

OFFICE OF THE COUNTY RECORDER  
MCLEOD COUNTY, MINNESOTA.

I hereby certify that this document was filed in this office at 9 o'clock A.M. on the 10th day of January, 1995.

Carmen Estelle Muller, County Recorder

By \_\_\_\_\_, Deputy

Document No. 263631

NORTH QUARTER corner, Section 5, Township 116 North, Range 27 West

## *Certificate of Location of Government Corner*

November 22, 1968. McCombs Knutson Associates (Dickman Knutson, county surveyor) set a temporary corner at the intersection of the east-west road and a fence to the south.

1970. Knutson dug for the corner, John Tupa from Hutchinson with a backhoe. Down below the original road bed they found a stone and a wood stake. They took reference ties and set a McLeod County cast iron monument. Mrl Ortwin Seamann, road boss when the road was rebuilt, said he found a stone at most of the government corners along this road.


***January 3, 1995. We took new reference ties to the monument.***

# Certificate of Location of Government Corner



## SKETCH OF REFERENCE TIES

(NO SCALE)

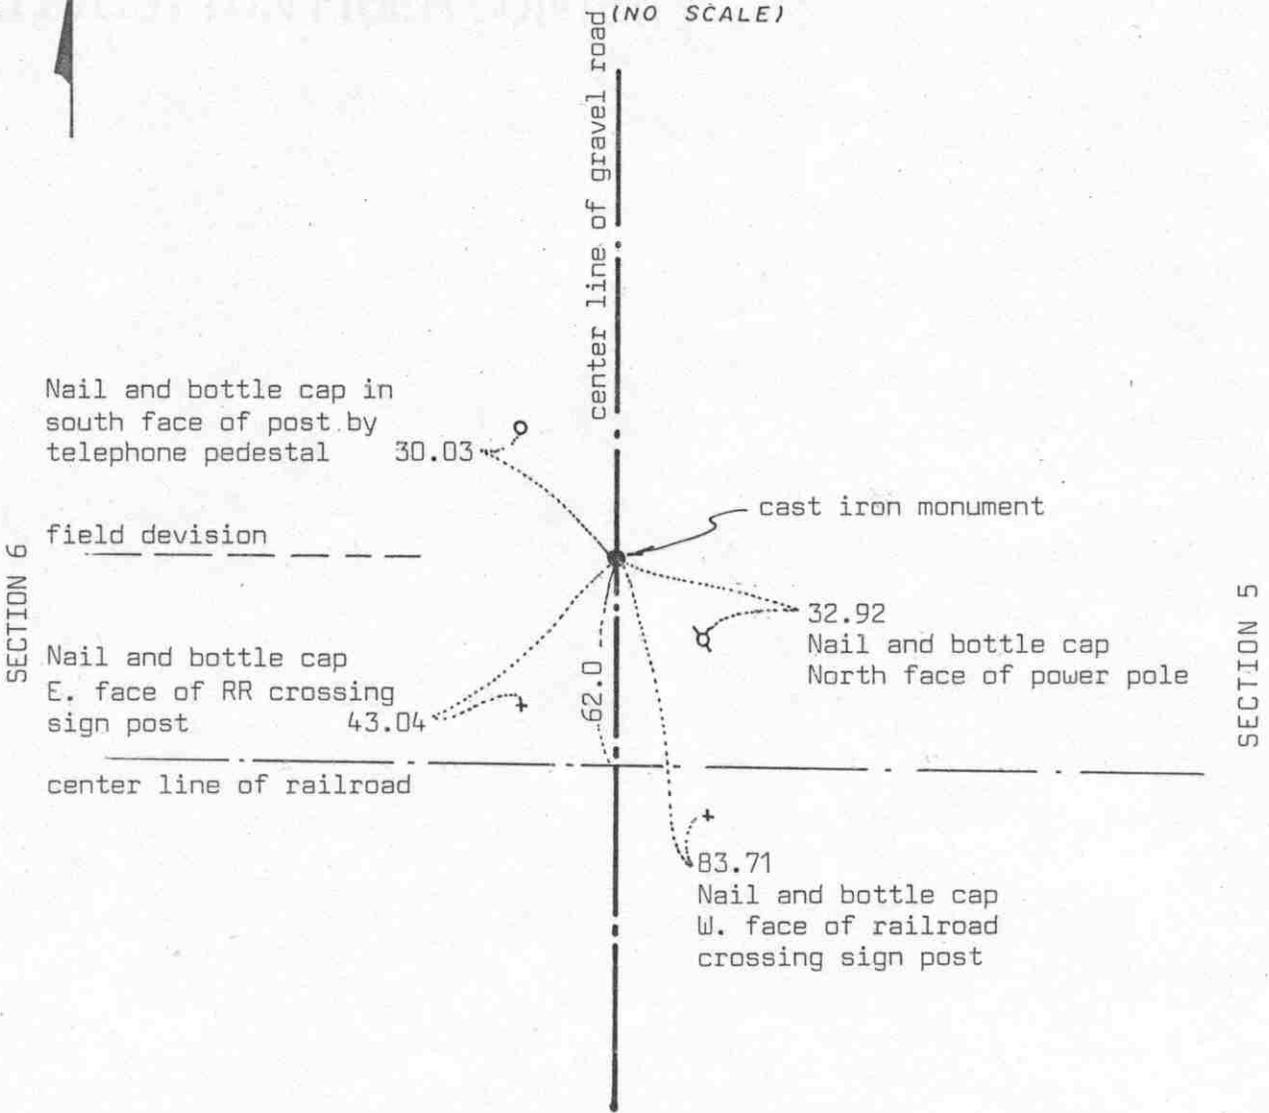

Statement of evidence relative to this corner location on sheet 2

I hereby certify that this document was prepared by me or under my direct supervision.

Willard Pellinen  
 Willard Pellinen  
 McLeod County Surveyor  
 License No. 9626  
 Date 3/24/90

OFFICE OF THE COUNTY RECORDER  
 MCLEOD COUNTY, MINNESOTA.

I hereby certify that this document was filed in this office at 4 o'clock P.M. on the 4th day of April, 1990.

Carmen Ostlie, County Recorder  
 By \_\_\_\_\_, Deputy  
 Document No. 232653

## *Certificate of Location of Government Corner*

This corner was established in 1856 by E.N. Darling of the Government Land Office. He set post and had reference ties to 2 bearing trees.

1975. McCombs Knutson Associates (Dickman Knutson, county surveyor) dug for this corner but found nothing.

April 10, 1978. Knutson set a McLeod County cast iron monument 62.0 feet north of the center line of the railroad tracks as per railroad right of way map. This falls on the easterly extension of a field line to the west.

March 8, 1989. We found the monument in good condition but the reference ties destroyed. We took new ties.


We accept the monument set by Knutson as marking the correct location of the quarter corner.

# Certificate of Location of Government Corner



SKETCH OF REFERENCE TIES  
(NO SCALE)

SECTION 32, T 117, R 27

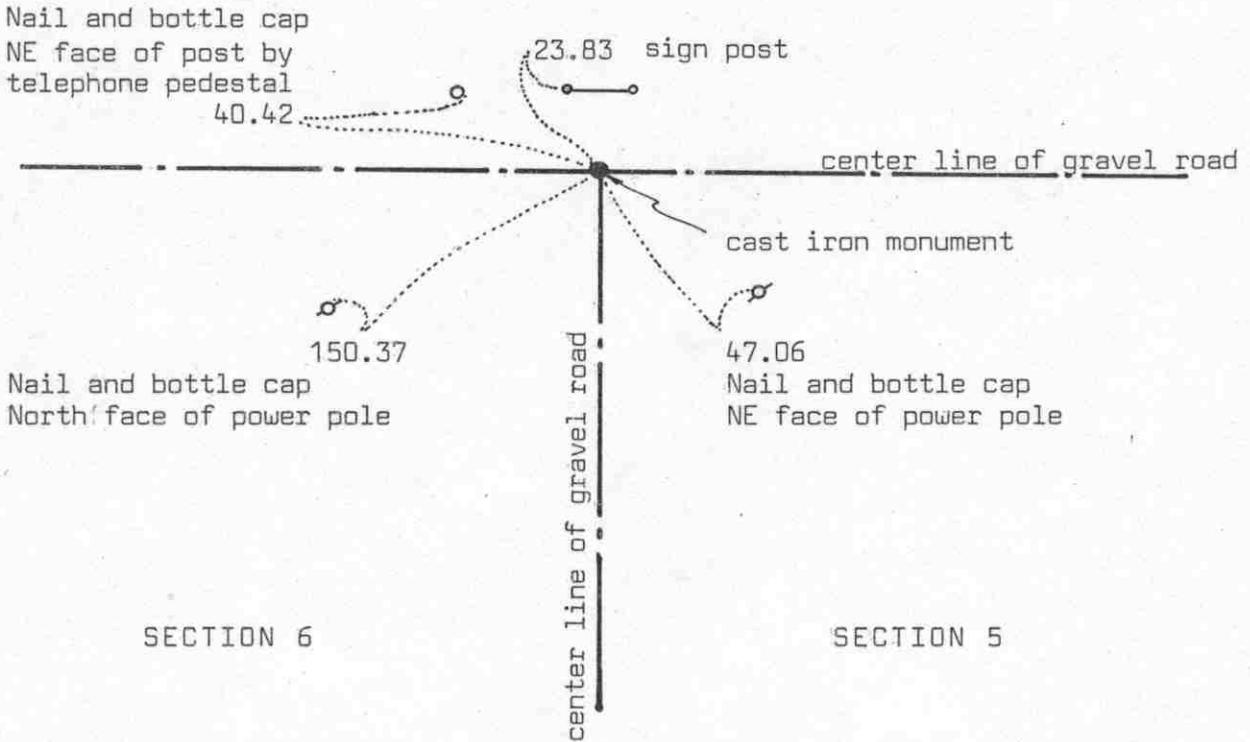

Statement of evidence relative to this corner location on sheet 2

I hereby certify that this document was prepared by me or under my direct supervision.

Willard Pellinen

Willard Pellinen  
McLeod County Surveyor  
License No. 9626

Date 3/24/90

OFFICE OF THE COUNTY RECORDER  
MCLEOD COUNTY, MINNESOTA.

I hereby certify that this document was filed in this office at 4 o'clock P.M. on the 4th day of April, 1990.

Carmen Ostlie, County Recorder

By \_\_\_\_\_, Deputy

Document No. 232654

NORTHEAST corner, Section 6, Township 116 North, Range 27 West

## Certificate of Location of Government Corner

This corner was established by John Ryan of the General Land Office in 1855. He set a post and had reference ties to 2 bearing trees.

1968. McCombs Knutson Associates, Dickman Knutson, county surveyor, found a stone and wood stake at the corner. They replaced the stone with a McLeod County cast iron monument.


March 8, 1989. We found no ties remaining but found the monument in good condition 4 inches below the road surface. We took new reference ties.

We feel the stone and wood stake found by Knutson and later the monument set by Knutson have perpetuated the correct location of the section corner.

# Certificate of Location of Government Corner



SKETCH OF REFERENCE TIES  
(NO SCALE)

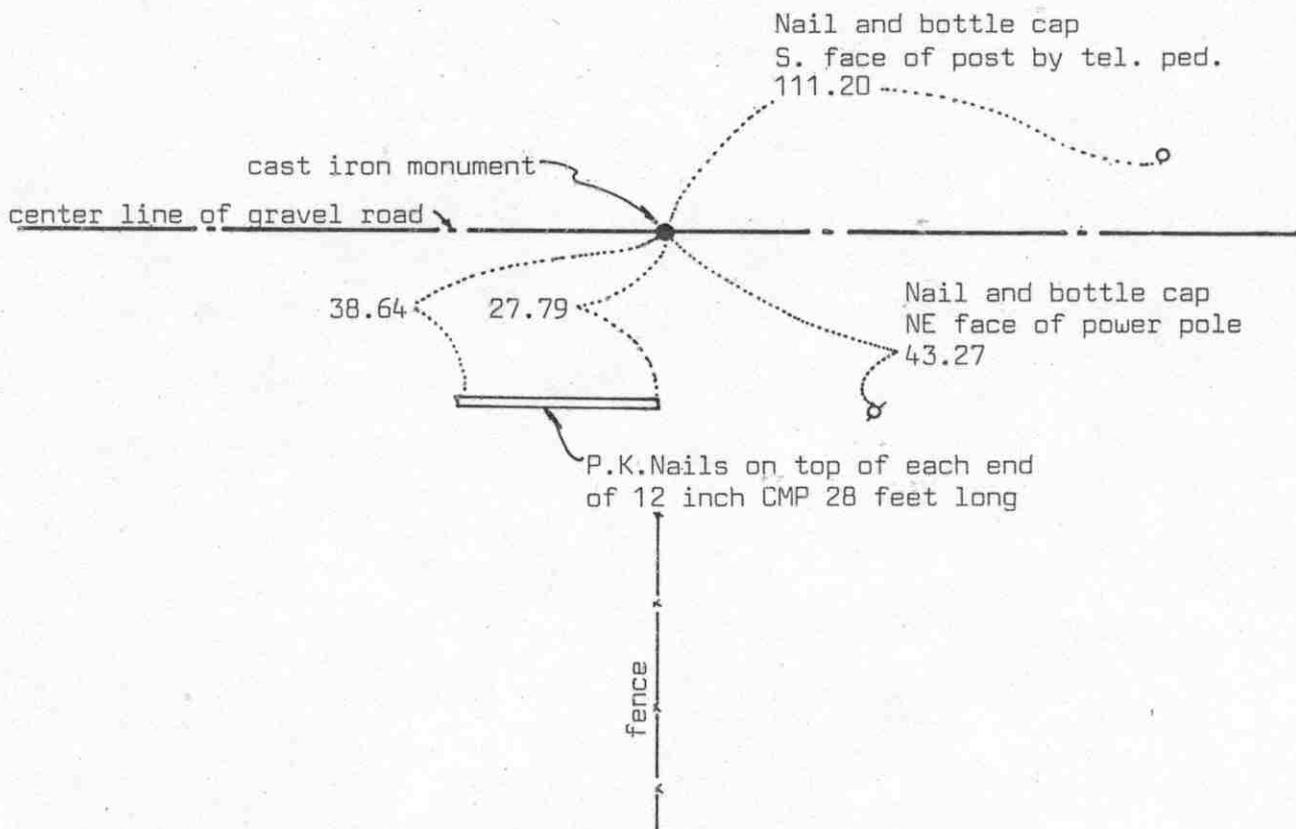

Statement of evidence relative to this corner location on sheet 2

I hereby certify that this document was prepared by me or under my direct supervision.

Willard Pellinen

Willard Pellinen  
McLeod County Surveyor  
License No. 9626

Date 3/25/90

OFFICE OF THE COUNTY RECORDER  
MCLEOD COUNTY, MINNESOTA.

I hereby certify that this document was filed in this office at 4 o'clock P.M. on the 4th day of April, 1990.

Carmen Potlie, County Recorder

By \_\_\_\_\_, Deputy

Document No. 232652

NORTH QUARTER corner, Section 6, Township 116 North, Range 27 West

## Certificate of Location of Government Corner

1970. McCombs Knutson Associates, Dickman Knutson, county surveyor, found a stone down below the gravel road in original ground. Mr. Ortwin Seaman, road boss when the road was rebuilt, said there are stones at most of the corners along this line.

March 8, 1989. We found the old reference ties had been destroyed. We dug and found the cast iron monument set by Knutson down 5 inches below the road surface, in good condition. We took new available reference ties.


We feel the stone found by Knutson has perpetuated the correct location of the quarter corner.

# Certificate of Location of Government Corner



## SKETCH OF REFERENCE TIES

(NO SCALE)

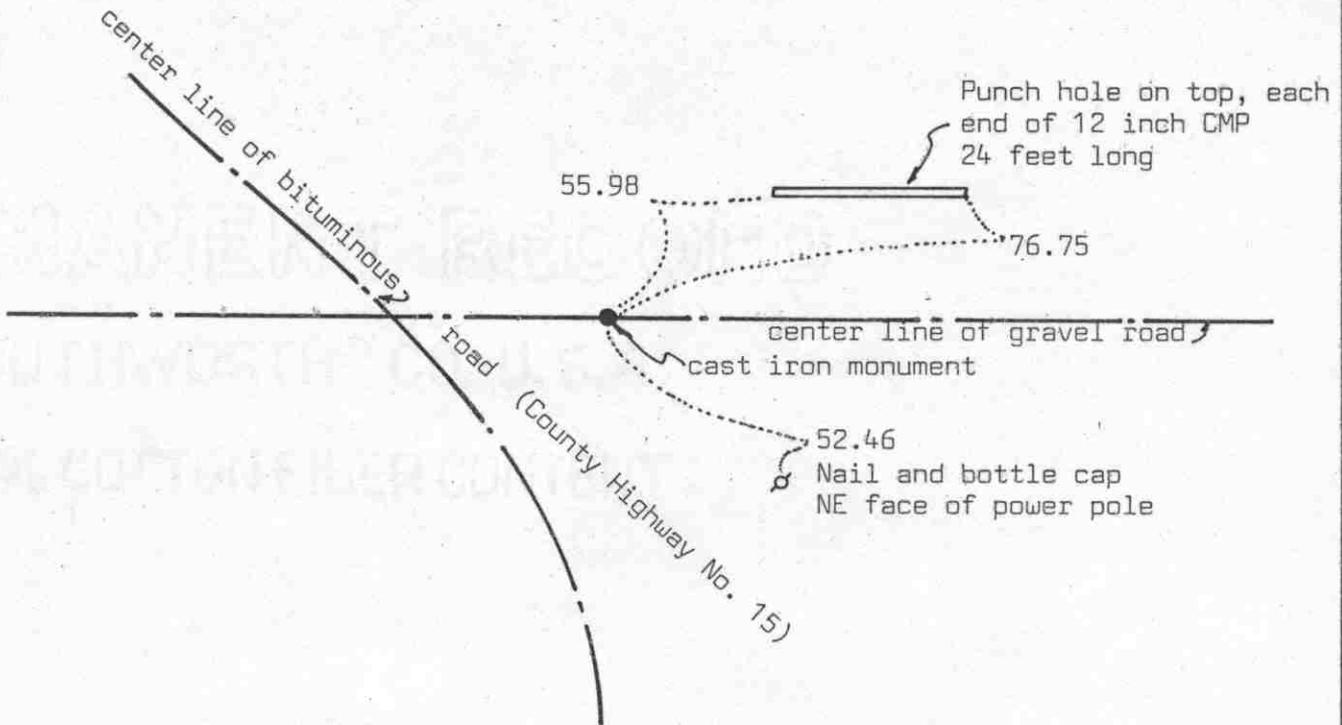

Statement of evidence relative to this corner location on sheet 2

I hereby certify that this document was prepared by me or under my direct supervision.

Willard Pellinen

Willard Pellinen  
McLeod County Surveyor  
License No. 9626

Date 4/1/90

OFFICE OF THE COUNTY RECORDER  
MCLEOD COUNTY, MINNESOTA.

I hereby certify that this document was filed in this office at 4 o'clock P.M. on the 4th day of April, 1990.

Carmen Ostlie, County Recorder

By \_\_\_\_\_, Deputy

Document No. 232650

NORTHEAST corner, Section 1, Township 116 North, Range 28 West

## Certificate of Location of Government Corner

This corner was originally established by the Government Land Office in 1855. John Ryan set a post and took reference ties to 2 bearing trees.


1969. McCombs Knutson Associates, Dickman Knutson, county surveyor, dug for the corner and found a stone. This was within 10-12 feet of the government distance to the southwest corner of Section 31, T.117, R. 30. Knutson set a cast iron monument and took reference ties. Ortwin Seaman, road boss when this road was rebuilt, said they found stones at most of the corners along this line.

March 8, 1989. We found no reference ties remaining. We dug and found the corner down 6 inches below the road surface and took new reference ties.

We accept the monument set by Knutson as the correct location of the section corner because it perpetuates the location of the stone which we feel marked the corner.

# Certificate of Location of Government Corner

SKETCH OF REFERENCE TIES  
(NO SCALE)

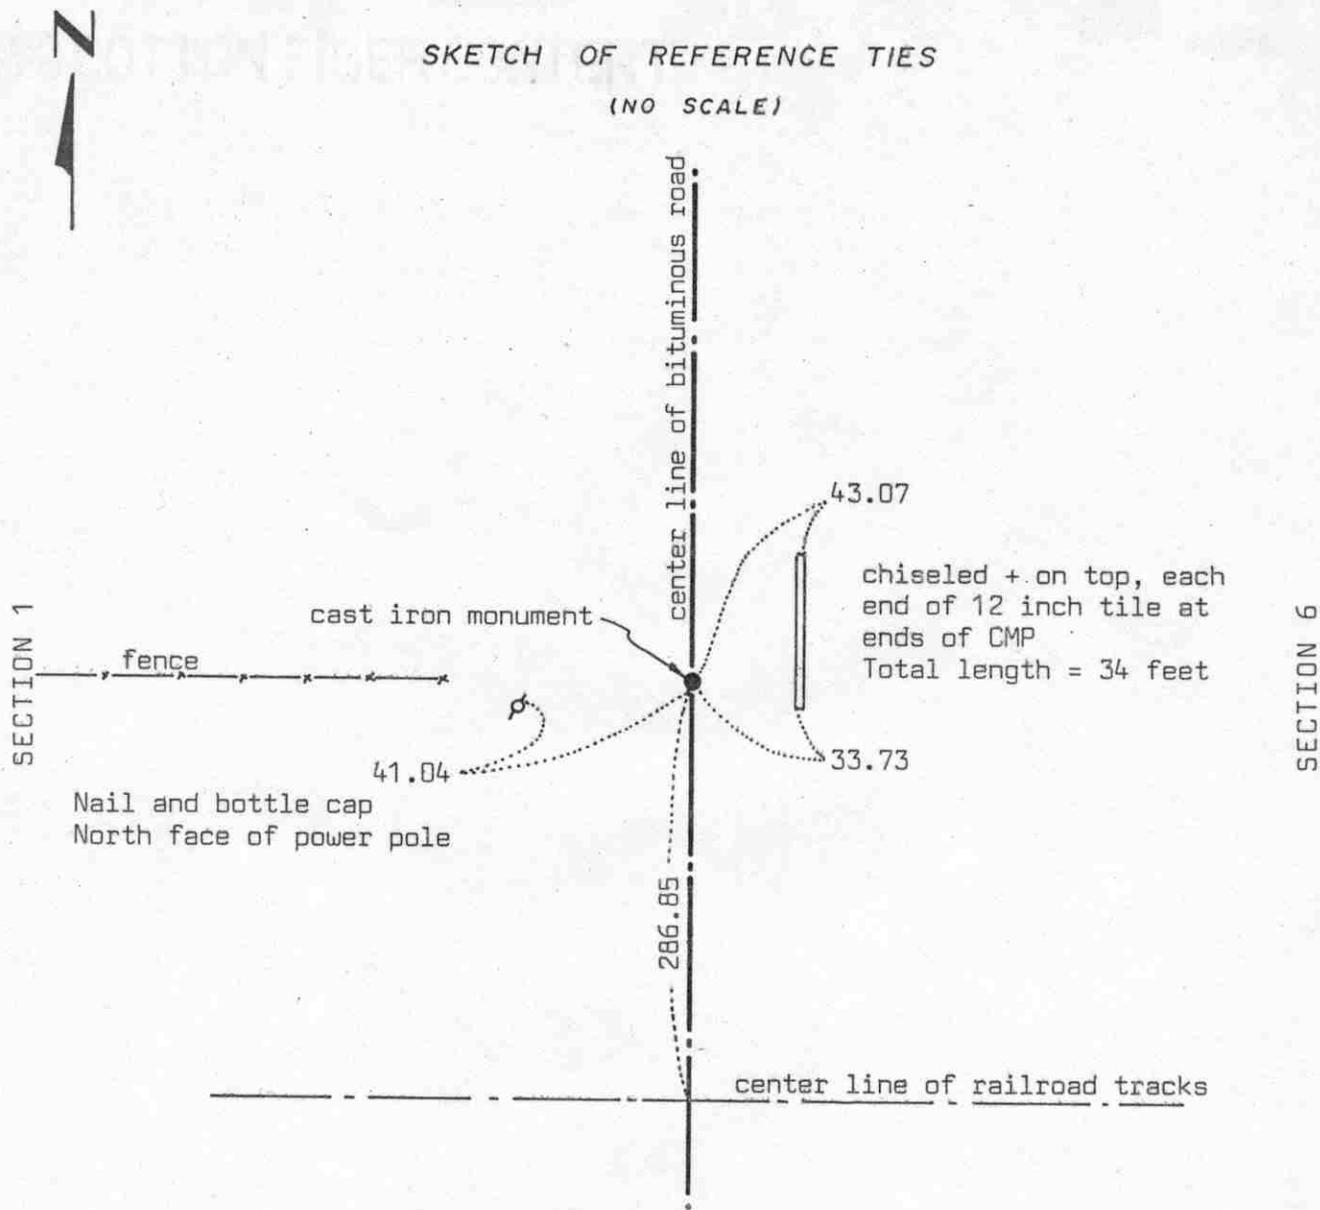

Statement of evidence relative to this corner location on sheet 2

I hereby certify that this document was prepared by me or under my direct supervision.

Willard Pellinen

Willard Pellinen  
McLeod County Surveyor  
License No. 9626

Date 2/10/90

OFFICE OF THE COUNTY RECORDER  
MCLEOD COUNTY, MINNESOTA.

I hereby certify that this document was filed in this office at 3 o'clock P.M. on the 27th day of Feb, 1990.

Carmen Ostlie, County Recorder

By \_\_\_\_\_, Deputy

Document No. 232083

## Certificate of Location of Government Corner

This corner was originally set in 1855 by the General Land Office. John Ryan set the quarter section post at the south edge of a wet marsh and had reference ties to 2 bearing trees.

December, 1968. McCombs Knutson Associates (Dickman Knutson, county surveyor) measured the east line of Section 1 and set a temporary quarter corner on the center line of the road in line with fences east and west.

May, 1969. Knutson found an iron pin which was set over a stone. This was very close to their temporary corner. They set a McLeod County cast iron monument in place of the iron pin and stone and took reference ties.

July 23, 1987. We found the cast iron monument down 7 inches below the road surface, but all the reference ties were destroyed. We took new reference ties.

March 7, 1989. We found the monument in good condition and the reference ties good.

This corner is about 25 feet north of the proration of the government distances between the section corners.

# Certificate of Location of Government Corner


## SKETCH OF REFERENCE TIES

(NO SCALE)



SECTION 7

SECTION 8

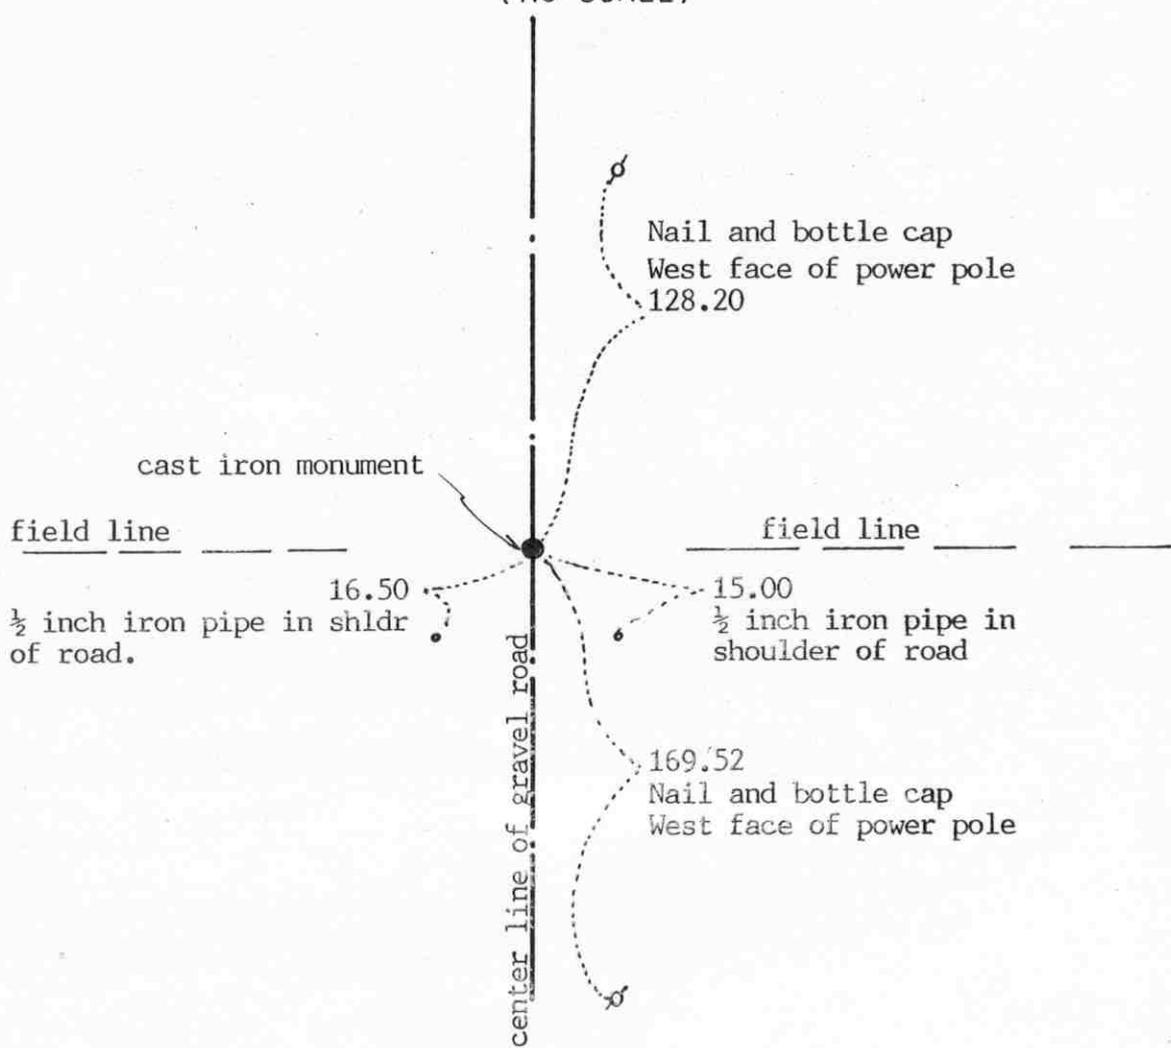

Statement of evidence relative to this corner location on sheet 2

I hereby certify that this document was prepared by me or under my direct supervision.

Willard Pellinen

Willard Pellinen  
McLeod County Surveyor  
License No. 9626

Date Apr: 11, 1994.

OFFICE OF THE COUNTY RECORDER  
MCLEOD COUNTY, MINNESOTA.

I hereby certify that this document was filed in this office at 9 o'clock A.M. on the 20th day of April, 1994.

Carmen Estlin Guder, County Recorder

By \_\_\_\_\_, Deputy

Document No. 259044

EAST QUARTER        corner, Section 7, Township 116 North, Range 27 West

## Certificate of Location of Government Corner

November, 1856. E. N. Darling of the General Land Office set a post in a dry marsh and marked to aspens for bearing trees.

July 15, 1982. Harold Herrmann, 72 years old and had lived in the Southeast Quarter of Section 7 all his life, said his father told him he thought there was a "marker" at the quarter corner. His father and grand father lived on this farm before him. He said the field line to the west is in place of an old fence and has been accepted as being along the east-west quarter line.


July 26, 1982. We dug for the corner, John Tupa from Hutchinson, with a backhoe. Down  $2\frac{1}{2}$  feet below the road surface we found a 10 inch diameter stone. We took reference ties to the stone and dug deeper. Down  $3\frac{1}{2}$  feet below the road surface, directly below the first stone, we found an 8 inch square stone.

August 20, 1982, we set a McLeod County cast iron monument and took additional reference ties.

January 21, 1994. We found the monument in good condition and checked the reference ties.

# Certificate of Location of Government Corner

## SKETCH OF REFERENCE TIES

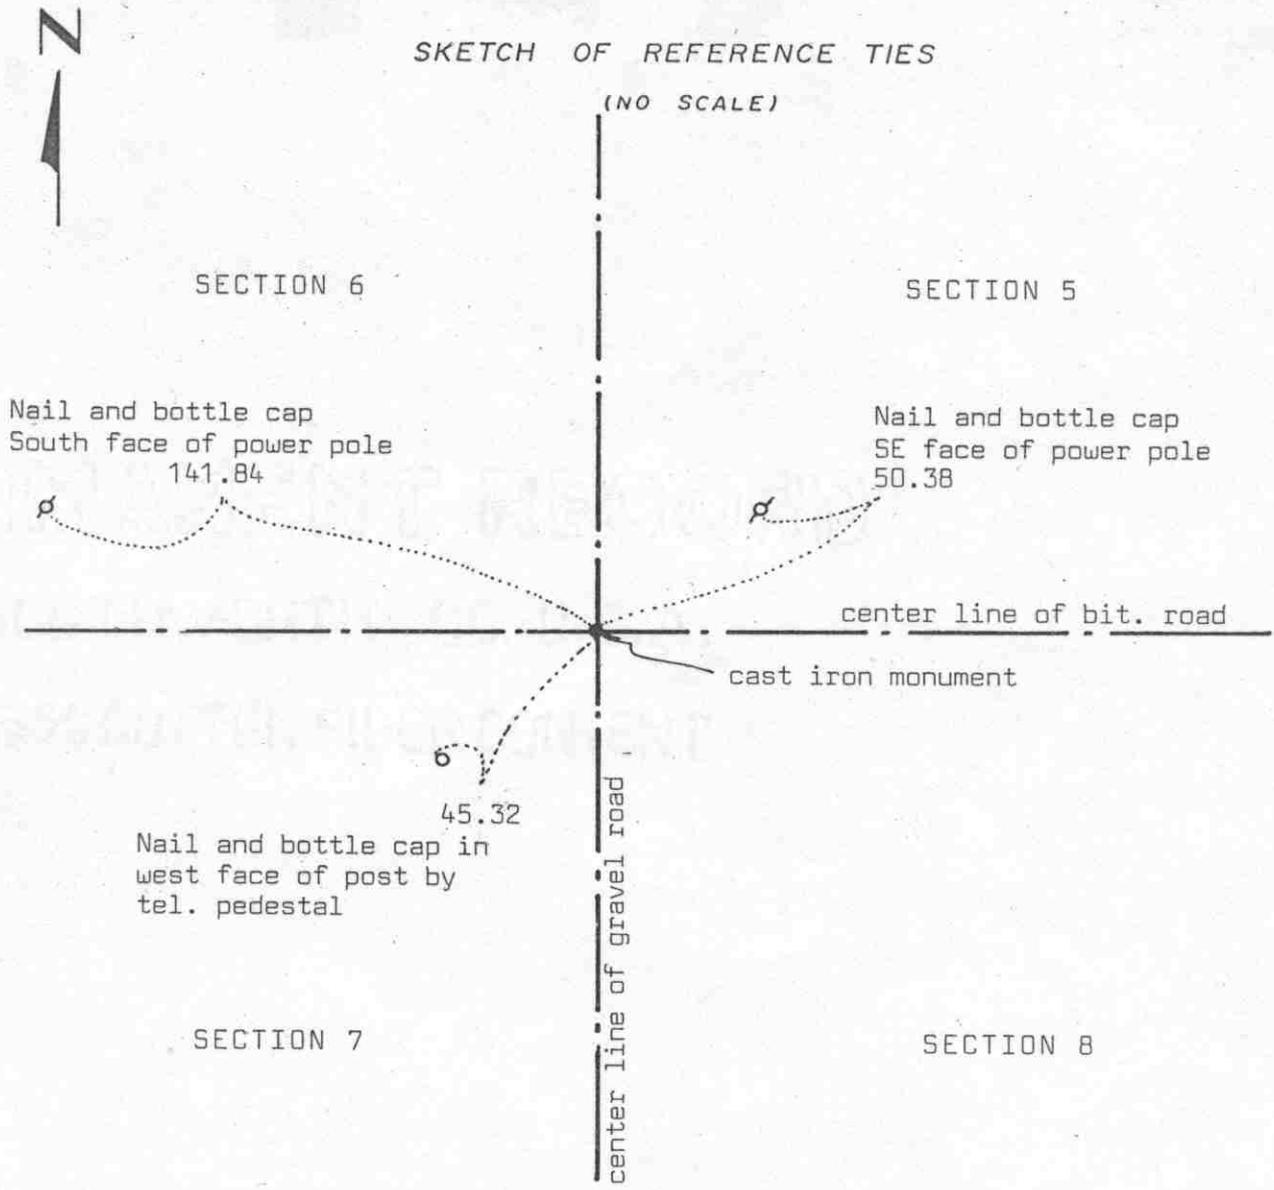

Statement of evidence relative to this corner location on sheet 2

I hereby certify that this document was prepared by me or under my direct supervision.

Willard Pellinen  
 Willard Pellinen  
 McLeod County Surveyor  
 License No. 9626  
 Date 3/28/90

OFFICE OF THE COUNTY RECORDER  
MCLEOD COUNTY, MINNESOTA.

I hereby certify that this document was filed in this office at 4 o'clock P.M. on the 4th day of April, 1990.

Carmen Potlie, County Recorder  
 By \_\_\_\_\_, Deputy  
 Document No. 232651

NORTHEAST corner, Section 7, Township 116 North, Range 27 West

## Certificate of Location of Government Corner

This corner was originally established by E.N. Darling of the Government Land Office in 1856. He set a post and had reference ties to 4 bearing trees.

January 30, 1979. We measured the east line of Section 7 and set a nail and disc as a temporary corner.

July 30, 1982. Mr. Alfred Marks, about 70 years old, has lived in the Southeast Quarter of Section 6 all his life, says older farmers have told him there is a "marker" at the corner on the center line intersection of the roads. Mr. Vernon Parpart, 66, in the Northwest Quarter of Section 8 since 1950, said he bought the farm from Albert Maltz, who since has died. Mr. Maltz told him there was a plow beam at the corner at the center line intersection of the roads. There has been some work done on the road since then by Mr. Howe from Glencoe.

July 22, 1983. We dug for the corner and found the nail and disc we set in 1979 down 4 inches below the surface. Down 2 feet we found another layer of blacktop and down at  $2\frac{1}{2}$  feet we found a 6 inch spike. We took reference ties to the spike and dug down deeper, but found nothing else. We set a 14 inch  $\frac{1}{2}$  inch diameter pipe at the location of the found spike.

July 18, 1985. We replaced the iron pipe with a McLeod County cast iron monument. Reference ties ok.


March 8, 1989. We found the monument in good condition but only 1 reference tie remaining. We took additional ties.

We accept the found spike as having perpetuated the correct location of the corner. This was probably set by Mr. Howe or the County Highway Department when the road was rebuilt.

# Certificate of Location of Government Corner

## SKETCH OF REFERENCE TIES

(NO SCALE)

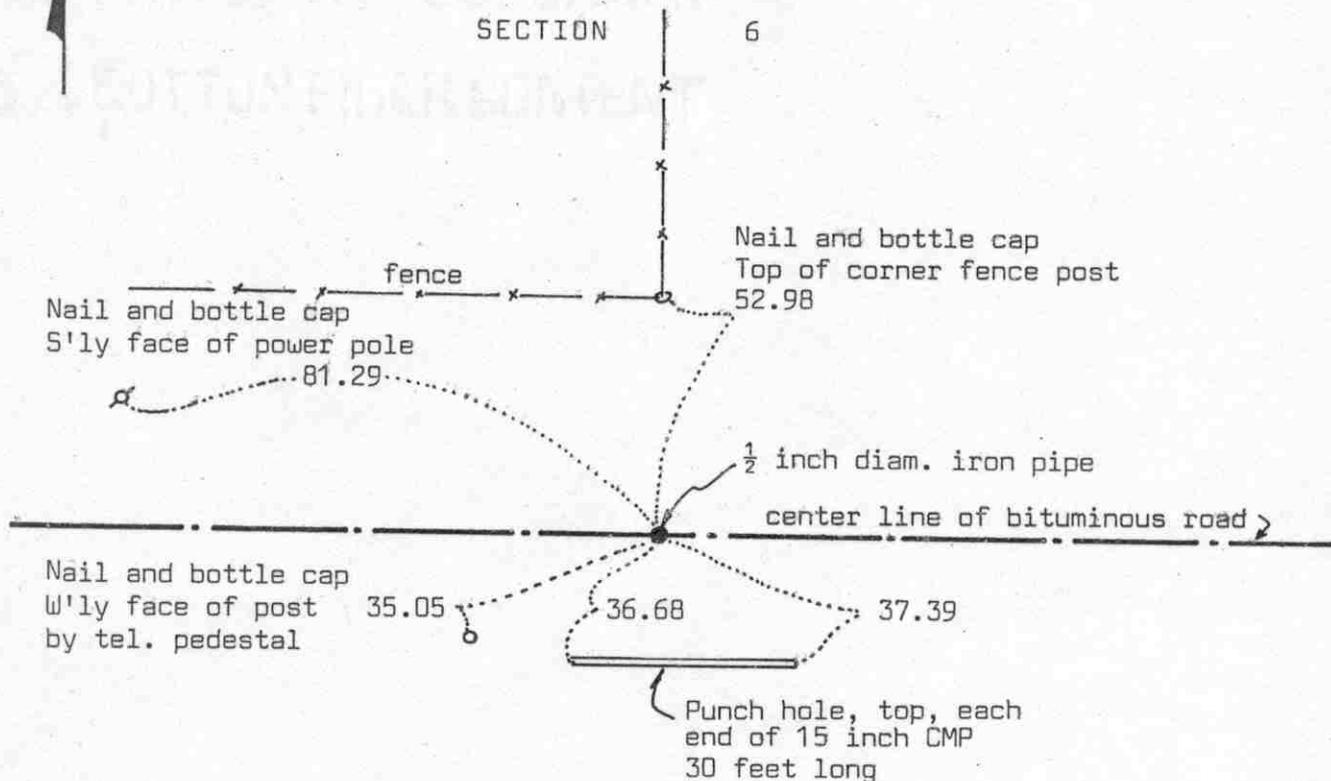

SECTION 7

Statement of evidence relative to this corner location on sheet 2

I hereby certify that this document was prepared by me or under my direct supervision.

Willard Pellinen

Willard Pellinen  
McLeod County Surveyor  
License No. 9626

Date 2/10/90

OFFICE OF THE COUNTY RECORDER  
MCLEOD COUNTY, MINNESOTA.

I hereby certify that this document was filed in this office at 3 o'clock P.M. on the 27th day of Feb, 1990.

Carmen Ostlie, County Recorder

By \_\_\_\_\_, Deputy

Document No. 232082

## Certificate of Location of Government Corner

This corner was originally set in 1856 by E.N. Darling of the General Land Office. He set a post and had reference ties to 2 bearing trees.

January 30, 1979. We measured the north line of Section 7 and set a temporary quarter corner over a "reading" with a metal locator.

May, 1980. We found a spike down 1 foot below the road surface.

August 28, 1980. We replaced the spike with a  $\frac{1}{2}$  inch diameter iron pipe and took reference ties.


July 23, 1987. All the reference ties had been destroyed. We found the iron pipe and took new reference ties.

March 8, 1989. We found the iron pipe and reference ties good. We measured the north line of Section 7. We had a distance of 2636.86 feet to the northeast corner and a distance of 2283.93 feet to the northwest corner of Section 7. This is within 2 feet of being on a proration of the government distances to the section corners. The corner falls 1.2 feet north of a straight line between the section corners.

There being no evidence to the contrary, we accept the found spike as having perpetuated the correct location of the quarter corner. It hits the occupation lines, the center of the road and in line with a fence north.

# Certificate of Location of Government Corner

SKETCH OF REFERENCE TIES  
(NO SCALE)

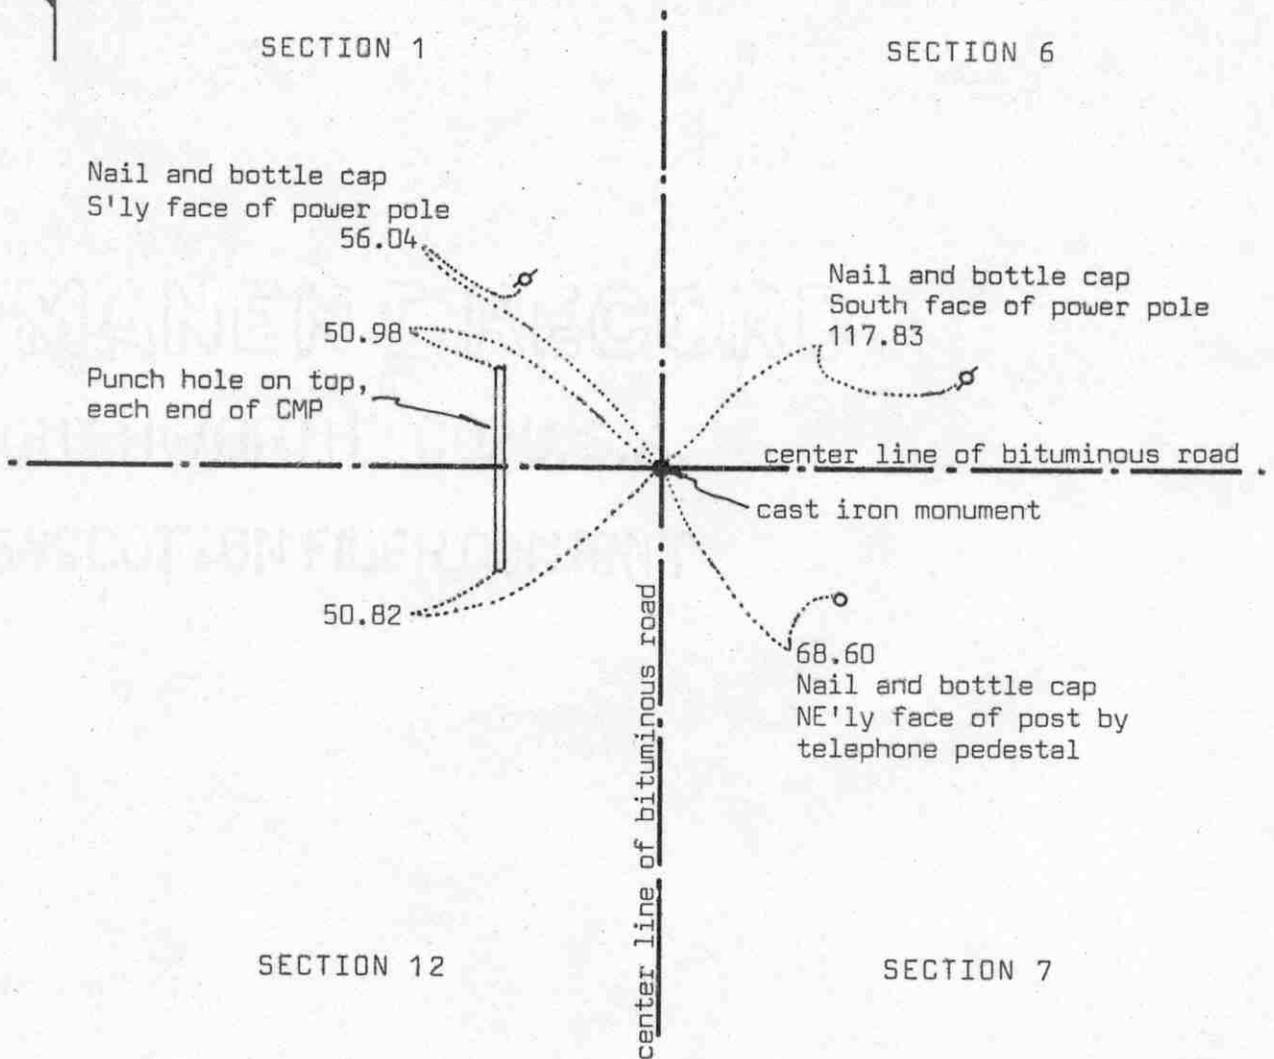

Statement of evidence relative to this corner location on sheet 2

I hereby certify that this document was prepared by me or under my direct supervision.

Willard Pellinen  
Willard Pellinen  
McLeod County Surveyor  
License No. 9626

Date 2/10/90

OFFICE OF THE COUNTY RECORDER  
MCLEOD COUNTY, MINNESOTA.

I hereby certify that this document was filed in this office at 3 o'clock P.M. on the 27th day of Feb, 1990.

Carmen Dotlie, County Recorder

By \_\_\_\_\_, Deputy

Document No. 232084

## Certificate of Location of Government Corner

This corner was originally set in 1855 by the General Land Office. John Ryan set a post, corner to Sections 1, 6, 7 and 12, and had reference ties to 4 bearing trees.

December, 1968. McCombs Knutson Associates (Dickman Knutson, county surveyor) set a temporary corner on the center line center line intersection of the roads.

May, 1969. Knutson found an iron pin down below the road surface and replaced it with a McLeod County cast iron monument and took reference ties.

July 23, 1987. We found no reference ties remaining, but found the cast iron monument in good condition. We took new reference ties.

March 8, 1989. We found the monument in good condition and the reference ties good.


EAST QUARTER corner, Section 12, Township 116 North, Range 28 West

# Certificate of Location of Government Corner

## SKETCH OF REFERENCE TIES (NO SCALE)

SECTION 12 T.116 N. R.28 W.

SECTION 7 T.116 N., R.27 W.

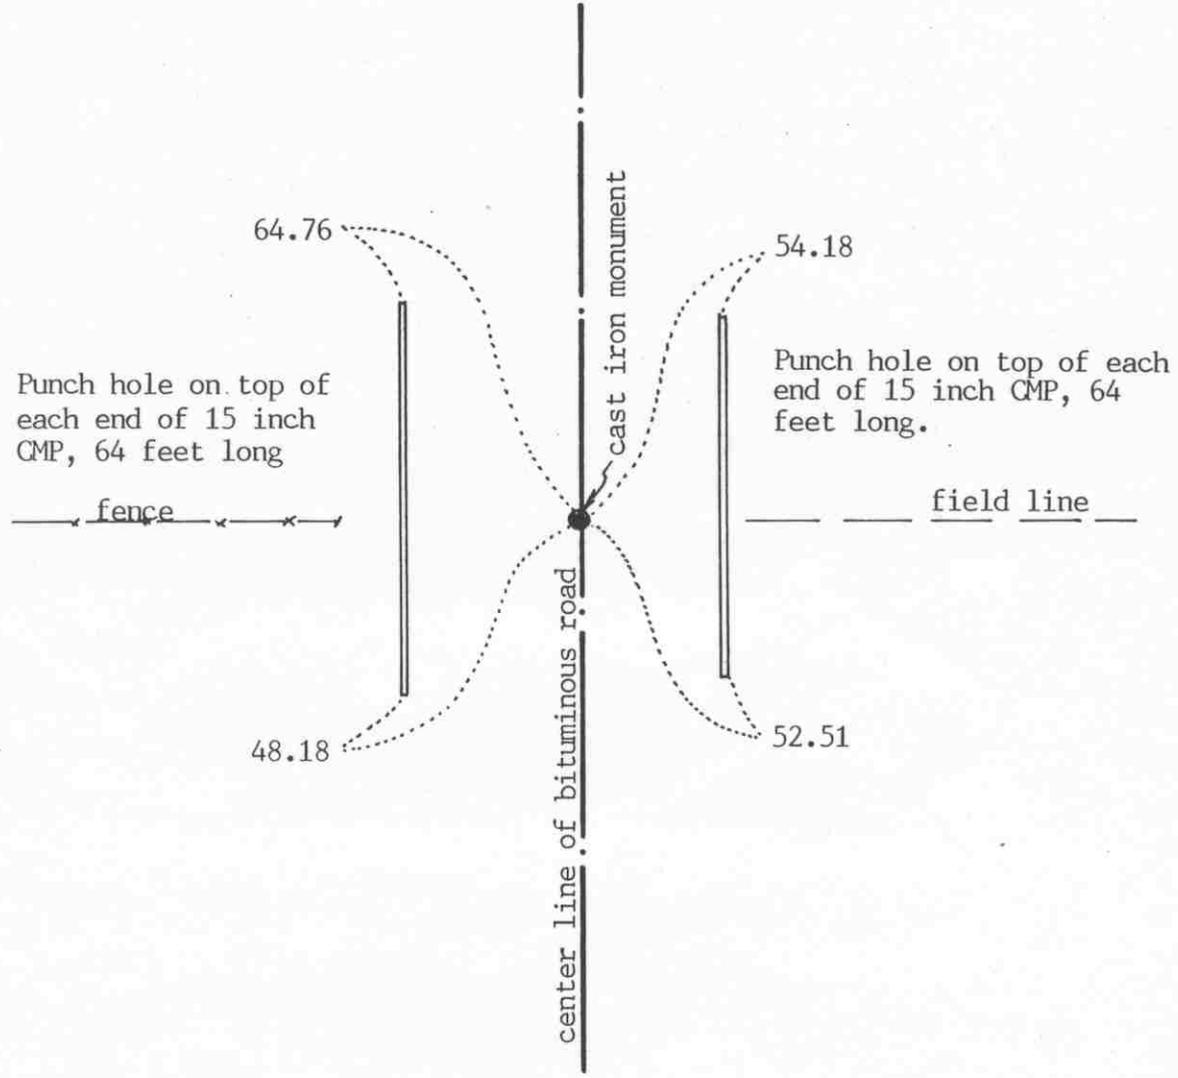

Statement of evidence relative to this corner location on sheet 2

I hereby certify that this document was prepared by me or under my direct supervision.

Willard Pellinen  
Willard Pellinen  
McLeod County Surveyor  
License No. 9626

Date Sept. 29, 1993.

OFFICE OF THE COUNTY RECORDER  
MCLEOD COUNTY, MINNESOTA.

I hereby certify that this document was filed in this office at 9 o'clock A. M. on the 14th day of October, 19 93.

Carmen Belie Mulder, County Recorder

By \_\_\_\_\_, Deputy

Document No. 255334

EAST QUARTER corner, Section 12, Township 116 North, Range 28 West

## Certificate of Location of Government Corner

1855. John Ryan of the General Land Office established this corner. He set a post and marked 2 oaks, an elm and an ash for bearing trees.

December, 1968. Dickman Knutson, county surveyor, set a spike at the center line of the north-south road, in line with fences to the east and west. Adjoining land owners testified this was the location of the quarter corner.

1969. Knutson dug for the corner, John Tupa from Hutchinson with a backhoe. They found no evidence of the government corner. Knutson set a cast iron monument and took ties.


November 30, 1990. We measured the east line of Section 12 and found the monument in good condition. We found the corner to be 5.03 feet south and 1.08 feet west of a lost position for the corner.

September 20, 1993. We found no ties remaining to the corner. We dug and found the top of the monument (removeable top) gone. The monument otherwise was in good condition. We took new available reference ties.

# Certificate of Location of Government Corner

East Quarter corner, Section 8, Township 116 North, Range 27 West

SKETCH OF REFERENCE TIES (NO SCALE)

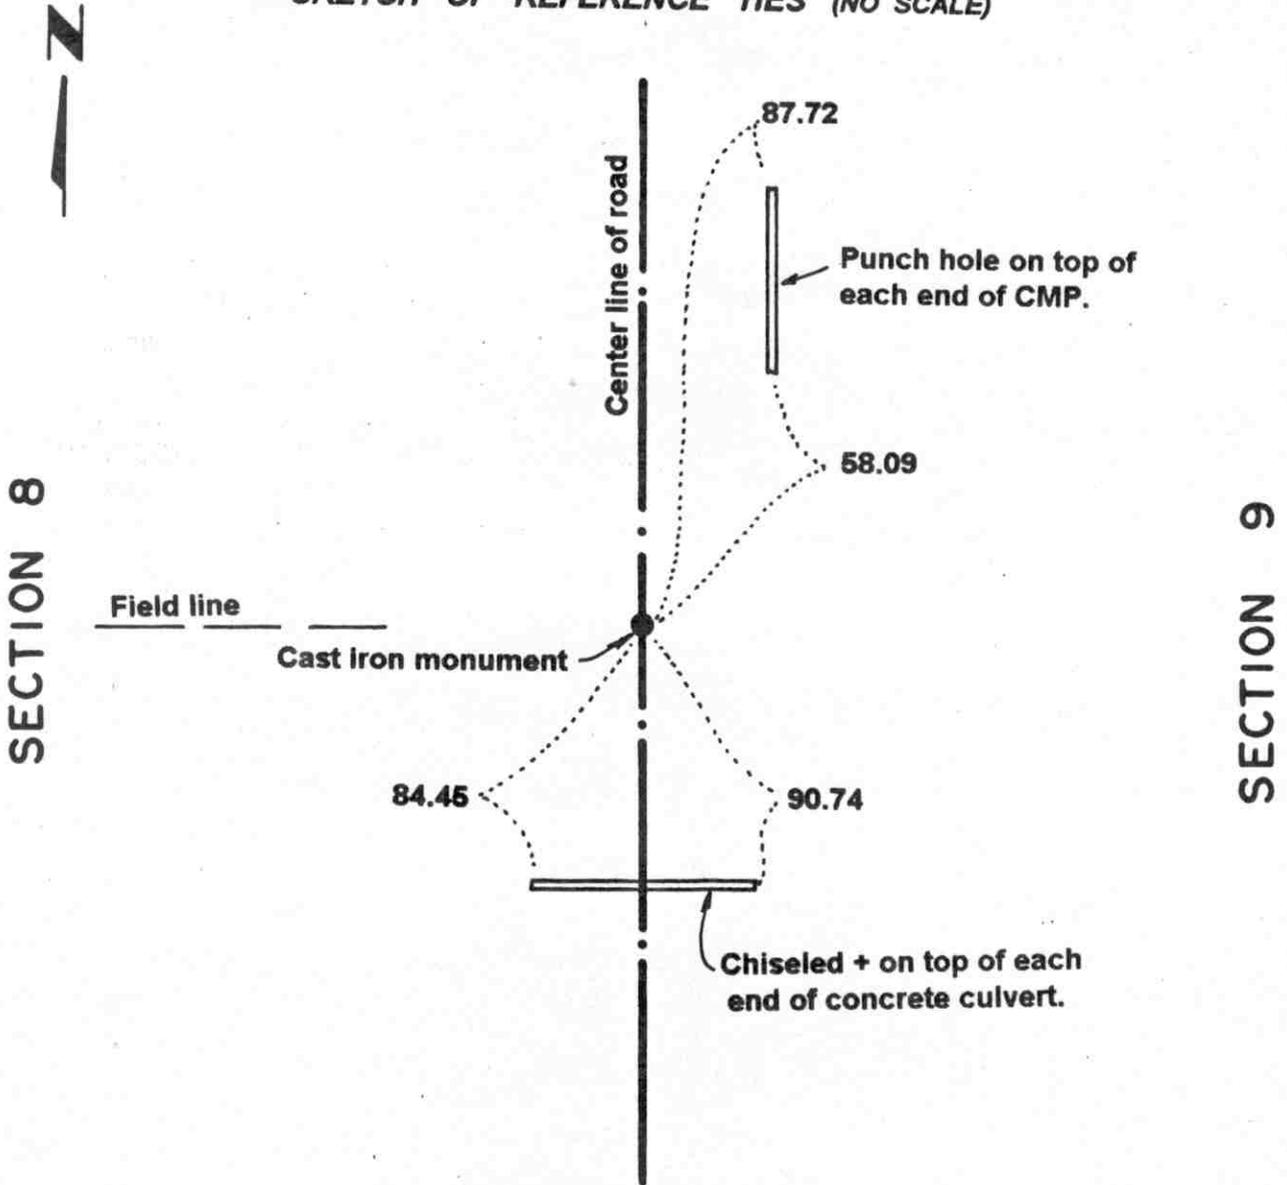

### Statement of evidence relative to this corner location on sheet 2

I hereby certify that this document was prepared by me or under my direct supervision.

Willard Pellinen

Willard Pellinen  
McLeod County Surveyor  
License No. 9626.

Date Oct. 9, 1995

### OFFICE OF THE COUNTY RECORDER MCLEOD COUNTY, MINNESOTA

I hereby certify that this document was filed in this office at 9 o'clock A. M. on the 13th day of October 19 95.

Carmen Potlie Moulder, County Recorder

By \_\_\_\_\_, Deputy.

Document No. 268590

## ***Certificate of Location of Government Corner***

### ***East Quarter Corner, Section 8 Township 116 North, Range 27 West***

***November, 1856. E. N. Darling of the General Land Office established this corner. He set a post and marked a 20 inch oak and a 12 inch elm for bearing trees.***

***January, 1899. E. L. Higgins, county surveyor, found a stump of a bearing tree and reset the quarter corner. He measured 2658 feet to the northeast corner and 2658 feet to the southeast corner of Section 8.***

***October 1970. Dickman Knutson, county surveyor, found an iron pin at the corner.***

***September 4, 1975. Knutson replaced the iron pin with a McLeod County cast iron monument and took available reference ties. Knutson measured 2655.08 feet to the northeast corner and 2647.24 feet to the southeast corner of Section 8. The corner is on the center line of the north-south road in line with a field line to the west. This corner is within a foot of being on a proration of old State Hwy No. 261 distances to the northeast and southeast corners of Section 8.***

***May 15, 1995. We checked the reference ties.***

# Certificate of Location of Government Corner

Northeast corner, Section 8, Township 116 North, Range 27 West

SKETCH OF REFERENCE TIES (NO SCALE)



SECTION 5

SECTION 4

Nail and disc in NW  
face of power pole.

42.05

Center line of road

Cast iron monument

Nail and disc in west  
face of power pole.

176.75

Center line of road

SECTION 8

SECTION 9

Statement of evidence relative to this corner location on sheet 2

I hereby certify that this document was prepared by me or under my direct supervision.

Willard Pellinen

Willard Pellinen  
McLeod County Surveyor  
License No. 9626.

Date Oct. 9, 1995

OFFICE OF THE COUNTY RECORDER  
MCLEOD COUNTY, MINNESOTA

I hereby certify that this document was filed in this office at 9 o'clock A. M. on the 13th day of October 19 95.

Carman Ostberg-Julder, County Recorder

By \_\_\_\_\_, Deputy.

Document No. 268589

## ***Certificate of Location of Government Corner***

### ***Northeast Corner, Section 8 Township 116 North, Range 27 West***

***November, 1856. E. N. Darling of the General Land Office established this corner. He set a post and marked two 10 inch lindens, a 16 inch aspen and a 12 inch elm for bearing trees.***

***January, 1899. E. L. Higgins, county surveyor, found a stone at the corner. He measured 2674.4 feet to the north quarter corner of Section 9 and 2658 feet to the east quarter corner of Section 8.***

***October 2, 1970. Dickman Knutson, county surveyor, dug for the corner and found an iron pin down 1 foot below the surface of the road. He measured 2675.15 feet to the north quarter corner of Section 9 and 2655.08 feet to the east quarter corner of Section 8.***

***August 15, 1974. Knutson set a McLeod County cast iron monument at the corner and took available reference ties.***

***May 15, 1995. We checked the reference ties to the monument.***


# Certificate of Location of Government Corner

North Quarter corner, Section 8, Township 116 North, Range 27 West

SKETCH OF REFERENCE TIES (NO SCALE)



## SECTION 5

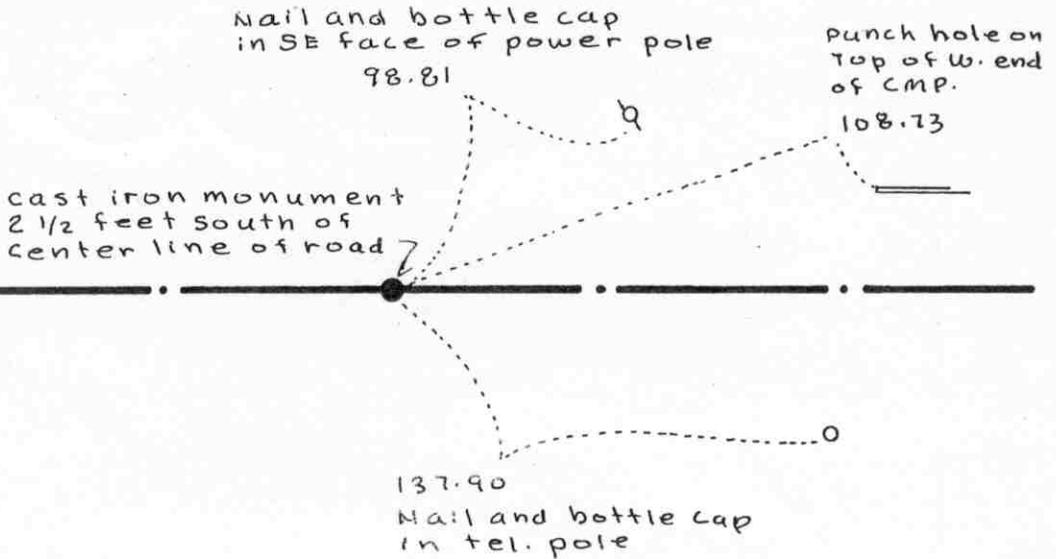

## SECTION 8

Statement of evidence relative to this corner location on sheet 2

I hereby certify that this document was prepared by me or under my direct supervision.

Willard Pellinen

Willard Pellinen  
McLeod County Surveyor  
License No. 9626.

Date Jan. 4, 1995

OFFICE OF THE COUNTY RECORDER  
MCLEOD COUNTY, MINNESOTA

I hereby certify that this document was filed in this office at 9 o'clock A M. on the 10th day of January, 1995.

Armen Botli Mulder, County Recorder

By \_\_\_\_\_, Deputy.

Document No. 263632

## ***Certificate of Location of Government Corner***

***North Quarter Corner, Section 8 Township 116 North, Range 27 West***

***November, 1856. E. N. Darling of the General Land Office established this corner. He set a post and marked an 8 inch and a 6 inch elm for bearing trees.***

***April, 1975. Dickman Knutson, county surveyor, dug for the corner and found an iron pin on the center line P.I. of the east-west road.***

***September 4, 1975. Knutson set a McLeod County cast iron monument at the corner and took available ties.***

***January 3, 1995. We checked the reference ties to the monument.***


EAST QUARTER corner, Section 9, Township 116 North, Range 27 West

# Certificate of Location of Government Corner

## SKETCH OF REFERENCE TIES (NO SCALE)

SECTION 9

SECTION 10

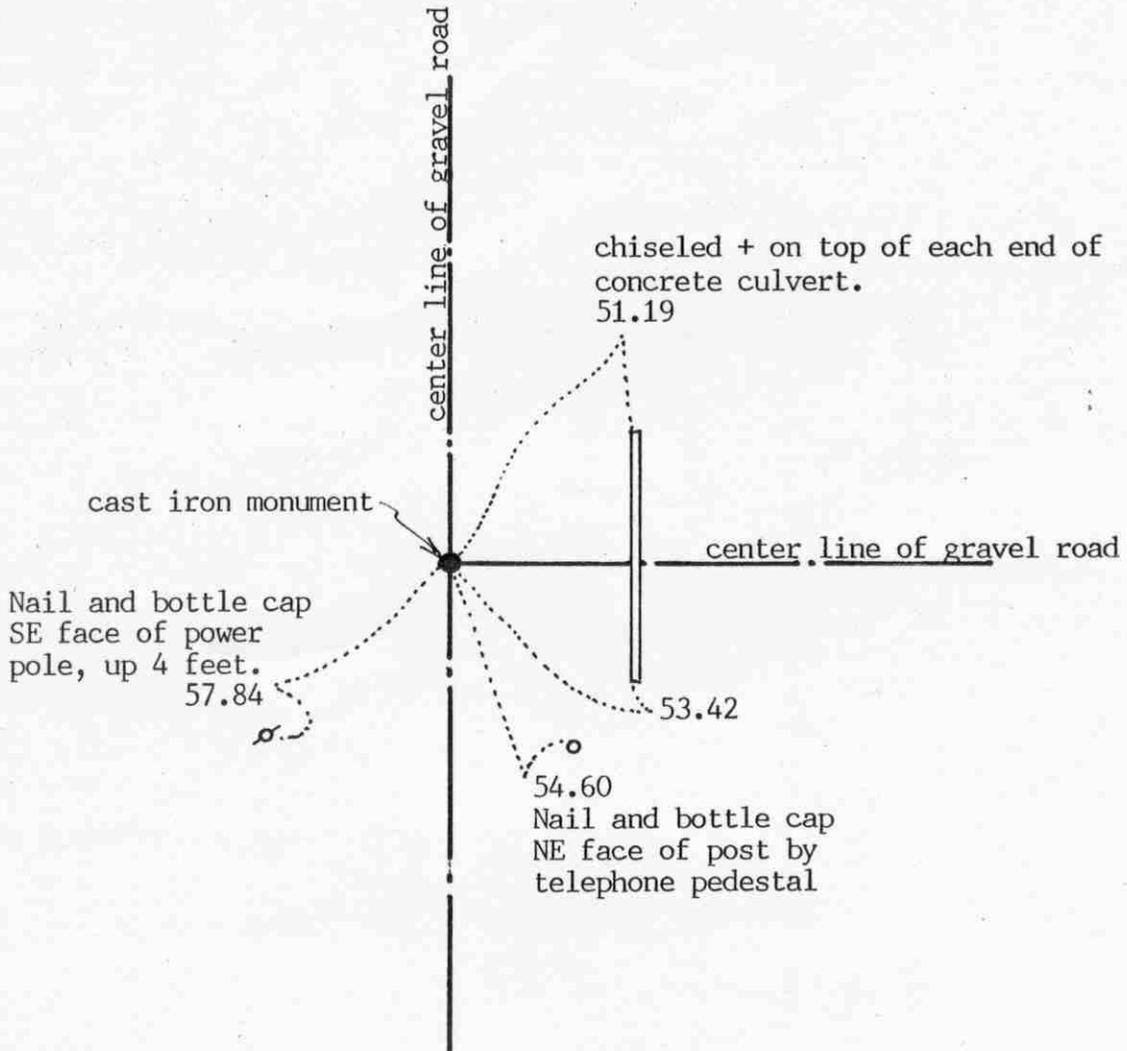

Statement of evidence relative to this corner location on sheet 2

I hereby certify that this document was prepared by me or under my direct supervision.

Willard Pellinen  
Willard Pellinen  
McLeod County Surveyor  
License No. 9626

Date April 11, 1994

OFFICE OF THE COUNTY RECORDER  
MCLEOD COUNTY, MINNESOTA.

I hereby certify that this document was filed in this office at 9 o'clock A.M. on the 20th day of April, 1994.

Carmen Ostlin Mulder, County Recorder

By \_\_\_\_\_, Deputy

Document No. 259045

## Certificate of Location of Government Corner

November, 1856. E. N. Darling of the General Land Office established this corner. He set a post and marked a 10 inch oak and a 10 inch linden for bearing trees.

July 16, 1982. Mr. Albert Walter, 74 years old and had lived in the Northeast Quarter of Section 9 since 1939 said the intersection of the roads has been accepted by adjoining land owners as being the quarter corner.

July 29, 1982. We measured the east line of Section 9 and set a temporary quarter corner at the center line intersection of the roads.

July, 1982. We dug for the corner, John Tupa from Hutchinson with a backhoe. We dug a hole 10 feet by 8 feet and down to original ground at 1899 distance by E. L. Higgins, county surveyor, from the northeast corner of Section 9. Found nothing. We dug at the center line intersection, 18 feet north of 1899 distance, and found a rotted wood stake down 4 feet below the road surface. This was half way between the section corners and 3.2 feet east of a straight line between the section corners. We took reference ties.


July 22, 1983. We set a McLeod County cast iron monument at the corner.

January 21, 1994. We found the monument in good condition and checked the reference ties.

# Certificate of Location of Government Corner

NORTHEAST corner, Section 9, Township 116 North, Range 27 West

SKETCH OF REFERENCE TIES (NO SCALE)

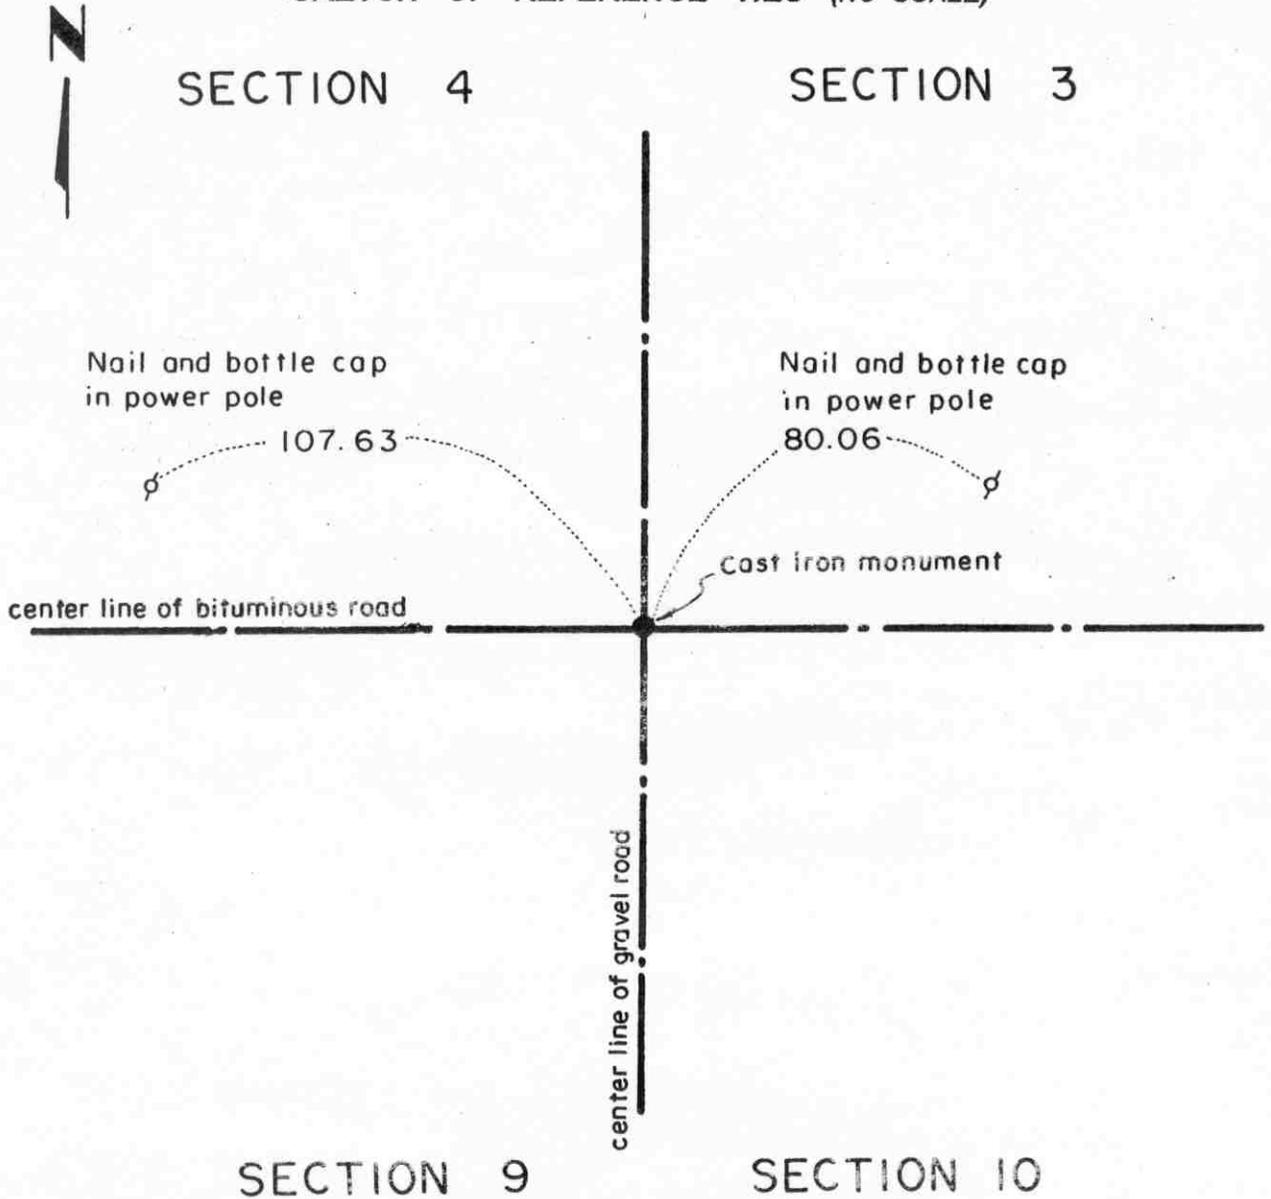

Statement of evidence relative to this corner location on sheet 2

I hereby certify that this document was prepared by me or under my direct supervision.

Willard Pellinen

Willard Pellinen  
McLeod County Surveyor  
License No. 9626.

Date August 25, 1994

OFFICE OF THE COUNTY RECORDER  
MCLEOD COUNTY, MINNESOTA

I hereby certify that this document was filed in this office at 9 o'clock A M. on the 9th day of Sept 19 94.

Carmin Otis Mulder, County Recorder

By \_\_\_\_\_, Deputy.

Document No. 261752

## **Certificate of Location of Government Corner**

**Northeast Corner, Section 9, Township 116 North, Range 27 West**

**November, 1856. E. N. Darling of the General Land Office set a post and marked a 10 inch oak, a 10 inch ash, an 8 inch linden and a 10 inch linden for bearing trees.**

**January, 1899. E. L. Higgins, county surveyor, found a stone at the corner.**

**October 2, 1970. Dickman Knutson, county surveyor, found a 3/4 inch iron pin down 1 foot below the surface of the bituminous road. This was within 1 1/2 feet of being the same distance to the north quarter corner of Section 9 as Higgins had in 1899.**

**December 10, 1974. State Highway Department set a 3/4 inch iron pin over the existing iron pin.**

**September 4, 1975. Knutson took available reference ties to the iron pin.**

**September 8, 1978. Knutson replaced the iron pin with a Mcleod County cast iron monument.**


**August 23, 1994. We found the monument in good condition and checked the reference ties.**

# Certificate of Location of Government Corner

North Quarter corner, Section 9, Township 116 North, Range 27 West

SKETCH OF REFERENCE TIES (NO SCALE)

## SECTION 4

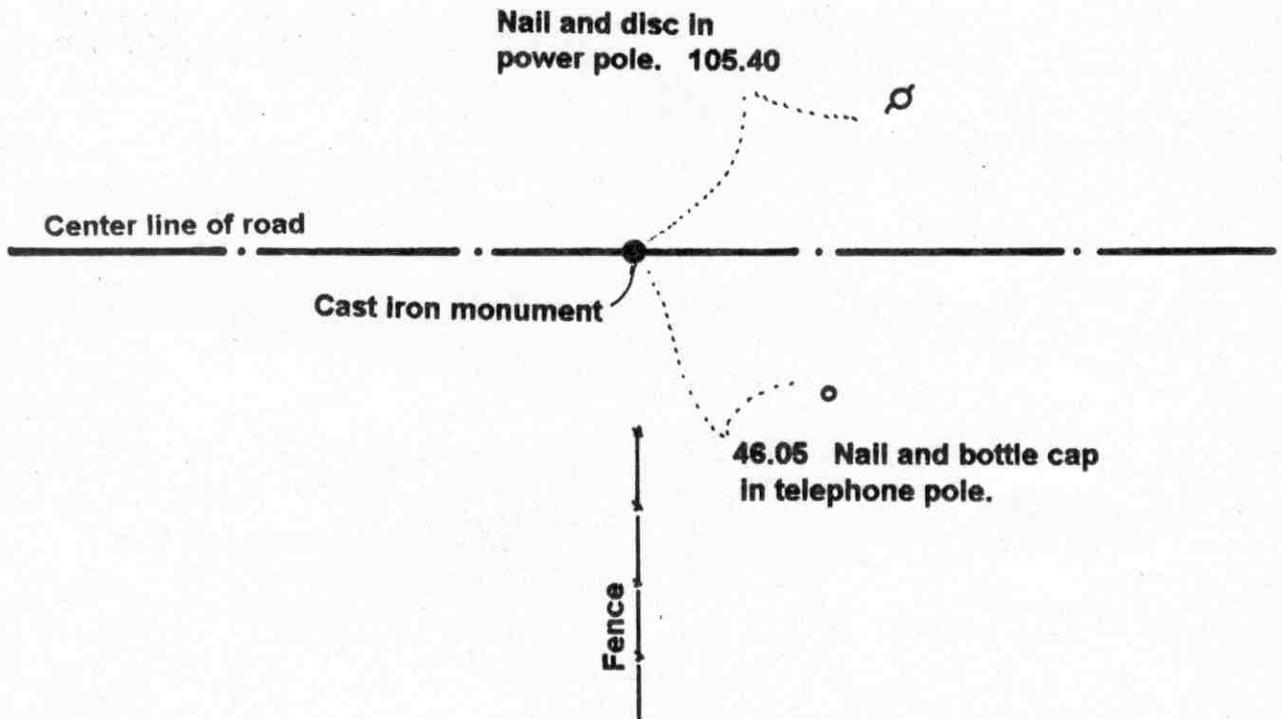

## SECTION 9

Statement of evidence relative to this corner location on sheet 2

I hereby certify that this document was prepared by me or under my direct supervision.

Willard Pellinen

Willard Pellinen  
McLeod County Surveyor  
License No. 9626.

Date Oct. 9, 1995

OFFICE OF THE COUNTY RECORDER  
MCLEOD COUNTY, MINNESOTA

I hereby certify that this document was filed in this office at 9 o'clock A. M. on the 13th day of October 19 95.

Carmen Ostlie Gulder County Recorder

By \_\_\_\_\_, Deputy.

Document No. 268591

## ***Certificate of Location of Government Corner***

***North Quarter Corner, Section 9 Township 116 North, Range 27 West***

***November, 1856. E. N. Darling of the General Land Office established this corner. He set a post and marked a 9 inch maple and a 16 inch ash for bearing trees.***

***January, 1899. E. L. Higgins, county surveyor, found a stone at the corner and a stump of a bearing tree. He measured 2674.4 feet to the northwest corner and 2671 feet to the northeast corner of Section 9.***

***October 2, 1970. Dickman Knutson, county surveyor, found an iron pin down 1 foot below the surface of the road. This was on the center line of the east-west road in line with a fence to the south. He measured 2675.15 feet to the northwest corner and 2672.41 feet to the northeast corner of section 9.***


***Knutson set a McLeod County cast iron monument at the corner and took available reference ties.***

***June, 1994. We checked the reference ties.***

# Certificate of Location of Government Corner

EAST QUARTER corner, Section 10, Township 116 North, Range 27 West

SKETCH OF REFERENCE TIES (NO SCALE)

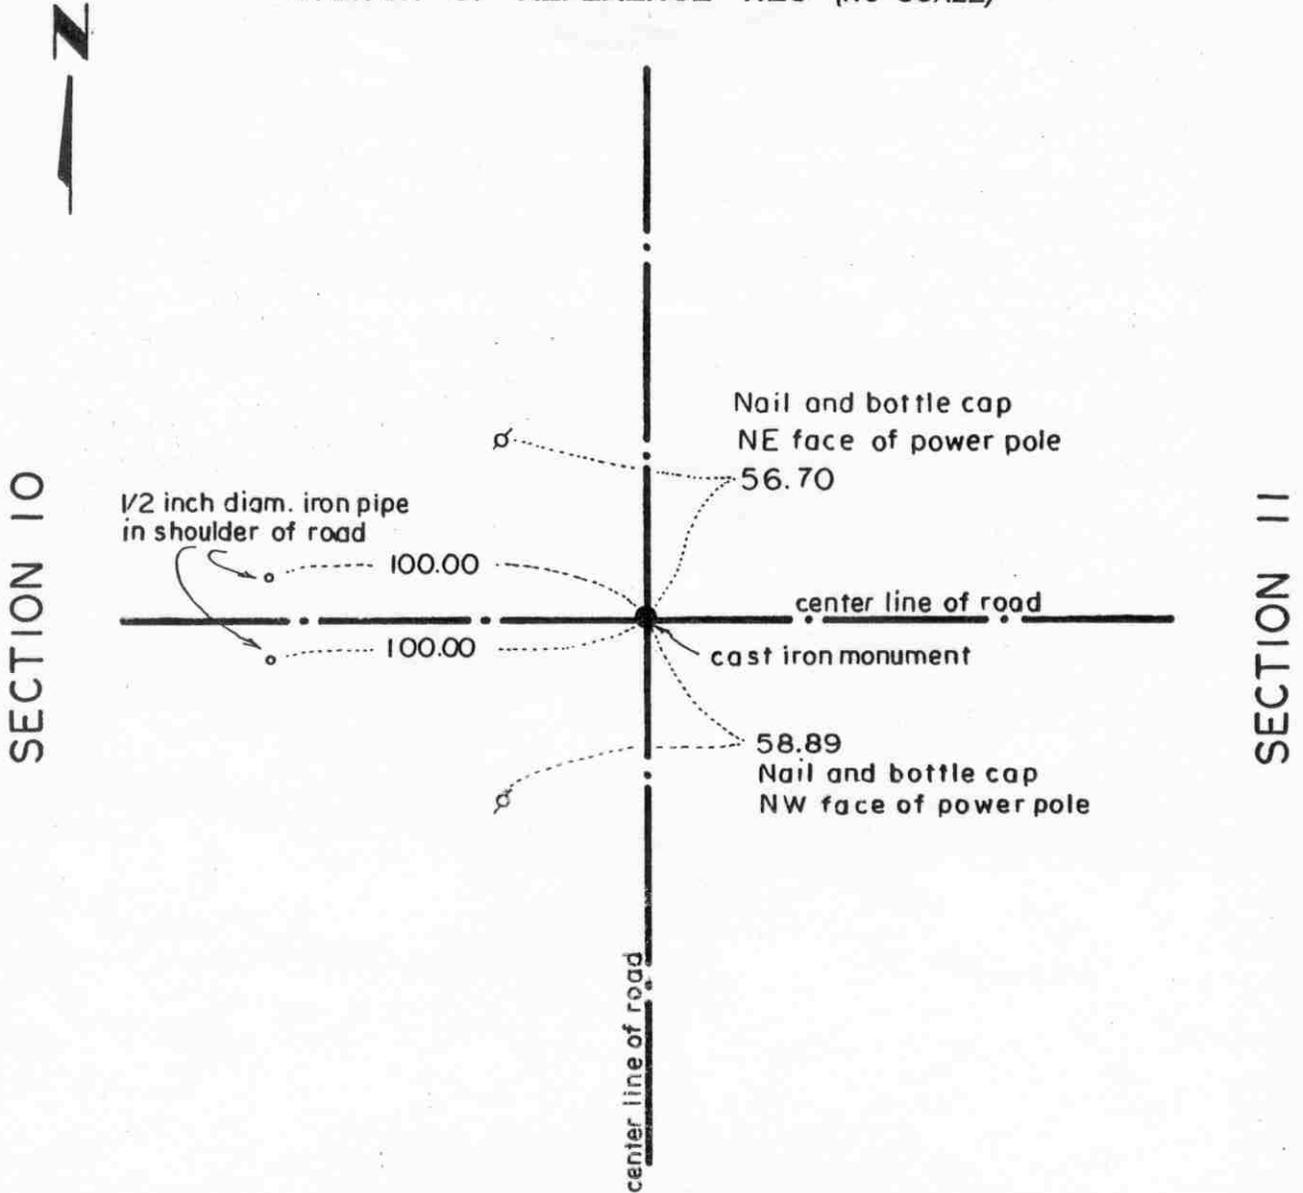

Statement of evidence relative to this corner location on sheet 2

I hereby certify that this document was prepared by me or under my direct supervision.

Willard Pellinen  
Willard Pellinen  
McLeod County Surveyor  
License No. 9626.

Date August 26, 1994

OFFICE OF THE COUNTY RECORDER  
MCLEOD COUNTY, MINNESOTA

I hereby certify that this document was filed in this office at 9 o'clock A. M. on the 9th day of Sept. 19 94.

Carmen O'Brien Mulder County Recorder

By \_\_\_\_\_, Deputy.

Document No. 261754

## **Certificate of Location of Government Corner**

**East Quarter Corner, Section 10, Township 116 North, Range 27 West**

**November, 1856. E. N. Darling of the General Land Office originally established this corner. He set a post and marked a 12 inch elm and a 7 inch oak for bearing trees.**

**May 11, 1972. Dickman Knutson, county surveyor, excavated for the corner. (John Tupa from Hutchinson, with a backhoe) They found an iron rod down 1/2 foot, a 6 inch bolt down 2 feet and a wood hub down 2 1/2 feet below the surface of the road. The bolt and the wood hub were directly below the iron rod. They tied the found corners off. This was in the center line intersection of roads north, south, east and west.**

**May 15, 1972. Knutson set a 1/2 inch diameter iron pipe at the corner.**

**August 15, 1974. Knutson set a McLeod County cast iron monument at the corner and took new reference ties.**


**August 23, 1994. We found the monument in good condition and checked the reference ties.**

**The monument set by Knutson is accepted as marking the correct location of the government corner. It fits long standing occupation lines (the center line intersection of the roads) and it perpetuates the location of older monuments.**

# Certificate of Location of Government Corner

NORTHEAST corner, Section 10, Township 116 North, Range 27 West

## SKETCH OF REFERENCE TIES (NO SCALE)

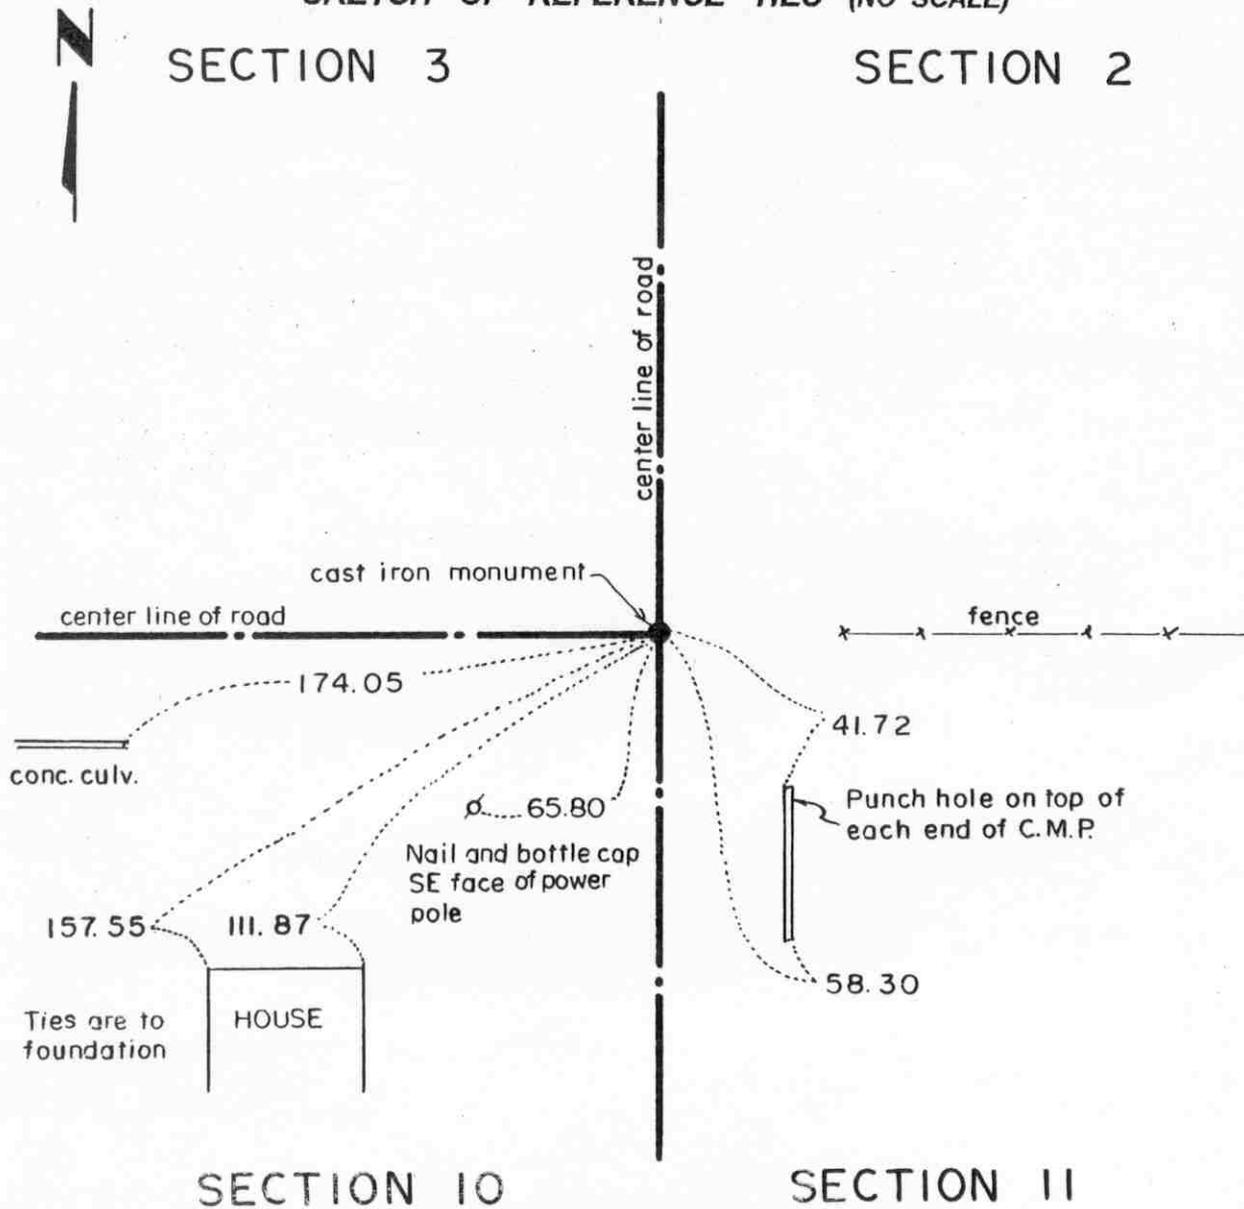

### Statement of evidence relative to this corner location on sheet 2

I hereby certify that this document was prepared by me or under my direct supervision.

Willard Pellinen  
 Willard Pellinen  
 McLeod County Surveyor  
 License No. 9626.

Date August 26, 1994

### OFFICE OF THE COUNTY RECORDER MCLEOD COUNTY, MINNESOTA

I hereby certify that this document was filed in this office at 9 o'clock A. M. on the 9th day of Sept 19 94.

Carmen Estlie Mulder, County Recorder

By \_\_\_\_\_, Deputy.

Document No. 261753

## **Certificate of Location of Government Corner**

**Northeast Corner, Section 10, Township 116 North, Range 27 West**

**November, 1856. E. N. Darling of the General Land Office originally established this corner. He set a post and marked an elm, an oak, a linden and an aspen for bearing trees.**

**May 11, 1972. Dickman Knutson, county surveyor, dug for the corner. (John Tupa from Hutchinson with a backhoe) Old county highway field notes show an oak hub at the corner. I. C. Christlieb, surveyor, shows a "stone post" at the corner. Knutson found an iron pin down 0.5 foot, 2 wood hubs down 1 foot, and a stone down 4 feet below the surface of the road. Stone was 18 inches long, 4 inches by 4 inches at the top and 4 inches by 8 inches at the bottom. Stone was directly below the iron pin and the wood hubs. Knutson took available reference ties and left the stone in place.**

**August 15, 1974. Knutson set a McLeod County cast iron monument at the corner.**


**August 23, 1994. We found the monument in good condition and checked the reference ties.**

# Certificate of Location of Government Corner

North Quarter corner, Section 10, Township 116 North, Range 27 West

SKETCH OF REFERENCE TIES (NO SCALE)

## SECTION 3

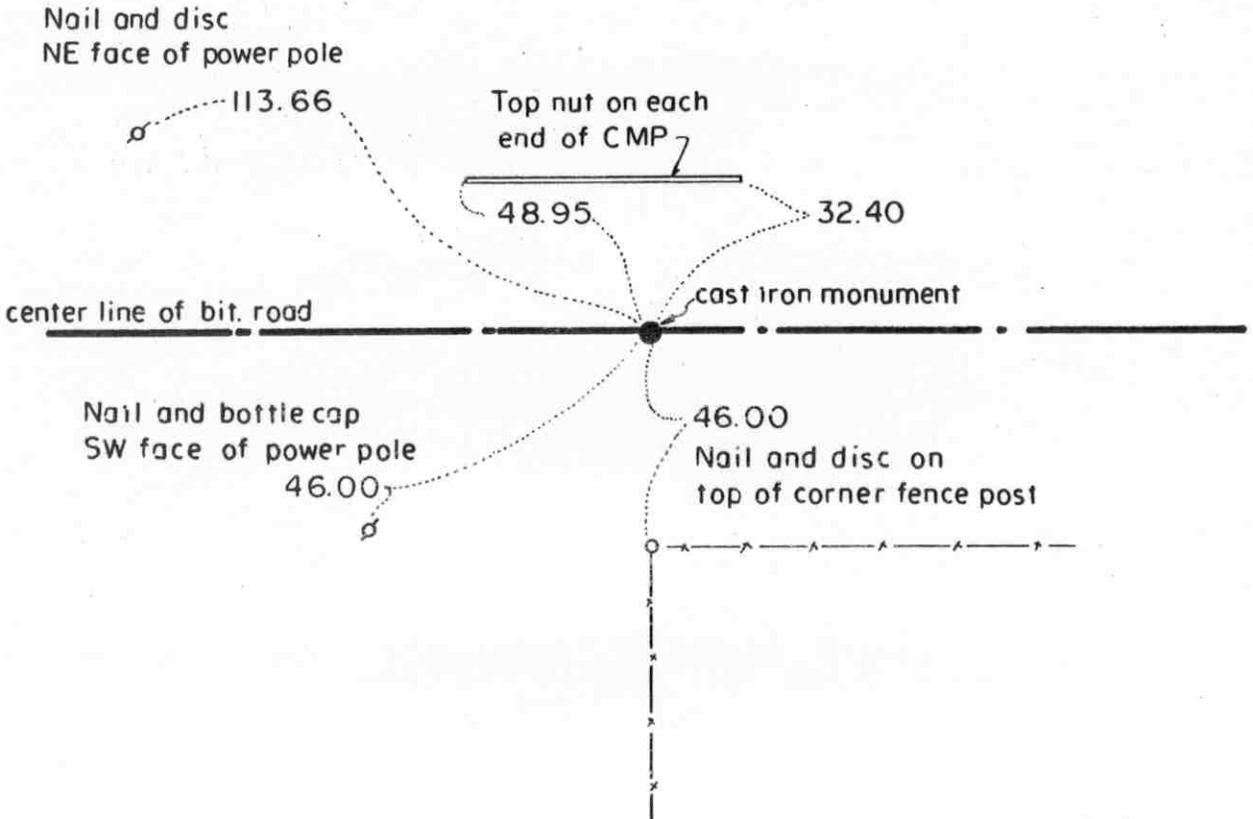

## SECTION 10

Statement of evidence relative to this corner location on sheet 2

I hereby certify that this document was prepared by me or under my direct supervision.

Willard Pellinen  
 Willard Pellinen  
 McLeod County Surveyor  
 License No. 9626.

Date August 25, 1994

OFFICE OF THE COUNTY RECORDER  
 MCLEOD COUNTY, MINNESOTA

I hereby certify that this document was filed in this office at 9 o'clock A. M. on the 9th day of Sept 19 94.

Carman Helio Mulder, County Recorder

By \_\_\_\_\_, Deputy.

Document No. 261755

## ***Certificate of Location of Government Corner***

***North Quarter Corner, Section 10, Township 116 North, Range 27 West***

***November, 1856. E. N. Darling of the General Land Office set a post and marked 2 ash trees for bearing trees.***

***June 5, 1974. State Highway Department found a 3/4 inch iron pin down 1 foot below the road surface. They placed a new 3/4 inch iron pin on top.***

***July 29, 1975. Dickman Knutson, county surveyor, found the iron pin and replaced it with a McLeod County cast iron monument and took available reference ties.***

***August 23, 1994. We found the monument in good condition and checked the reference ties.***

EAST QUARTER corner, Section 11, Township 116 North, Range 27 West


# Certificate of Location of Government Corner

SKETCH OF REFERENCE TIES  
(NO SCALE)



SECTION 11

SECTION 12

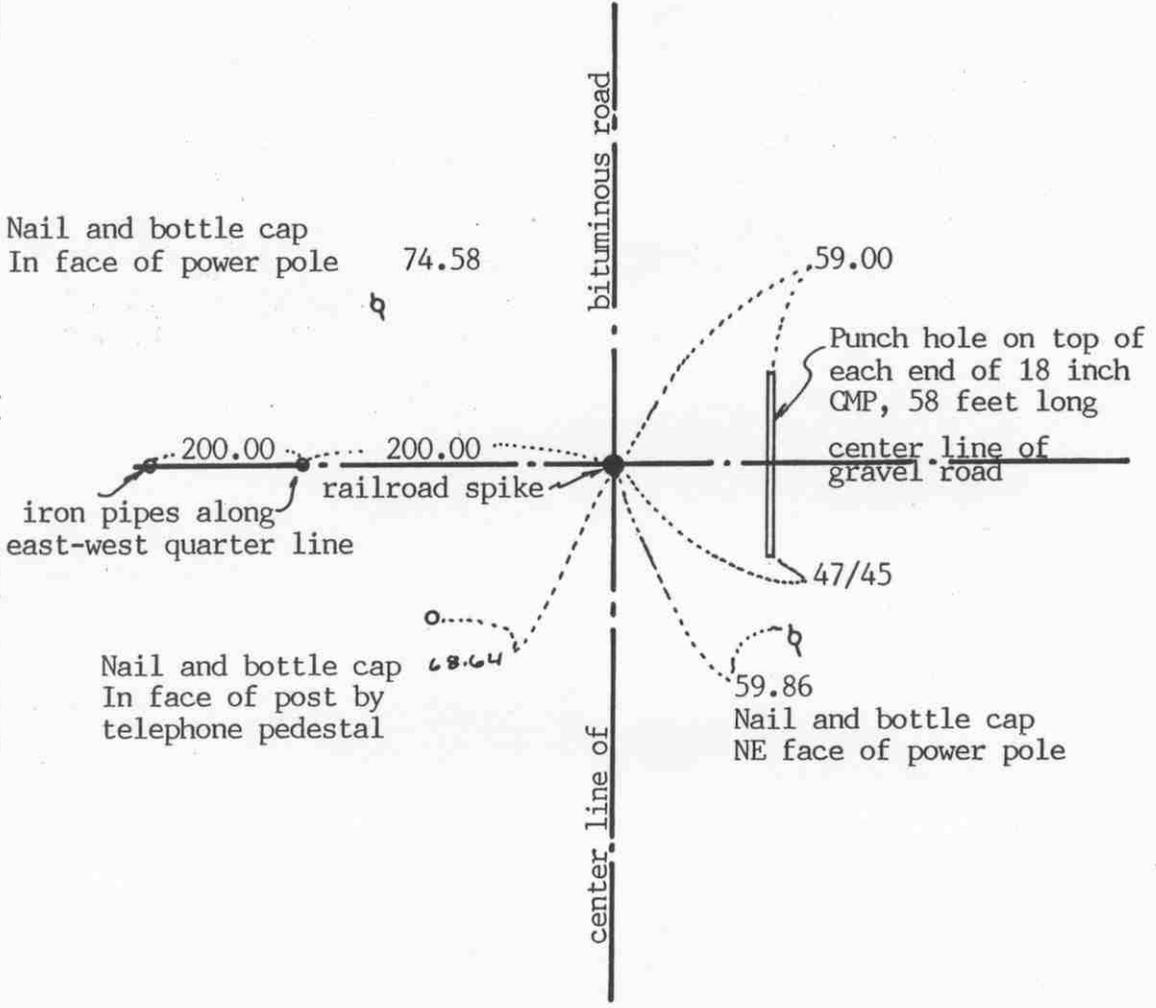

Statement of evidence relative to this corner location on sheet 2

I hereby certify that this document was prepared by me or under my direct supervision.

Willard Pellinen  
Willard Pellinen  
McLeod County Surveyor  
License No. 9626

Date August 16, 1993

OFFICE OF THE COUNTY RECORDER  
MCLEOD COUNTY, MINNESOTA.

I hereby certify that this document was filed in this office at 2 o'clock P.M. on the 5th day of Oct, 1993.

Carman Kollie Quelder, County Recorder

By \_\_\_\_\_, Deputy

Document No. 255173

EAST QUARTER corner, Section 11, Township 116 North, Range 27 West

## Certificate of Location of Government Corner

November 1856. E. N. Darling of the General Land Office first established this corner. He set a post and marked two 16 inch linden trees for bearing trees.

March 1974. Marvin Fenske, 55 years old and had lived in the Southwest Quarter of Section 12 since 1940 stated the county dug for the corner when the road was rebuilt in 1925. (His father told him) No corner was found so the road was rebuilt in the same location as the old road.

April 10, 1978. McCombs Knutson Associates (Dickman Knutson, county surveyor) set a railroad spike at the center line-center line intersection of the roads and took available reference ties.

September 8, 1978. Knutson set a McLeod County cast iron monument at the corner.


May 23, 1990. We set  $\frac{1}{2}$  inch diameter iron pipes along the east-west quarter line of Section 11 a distance of 200.00 and 400.00 feet west of the quarter corner as ties to replace the quarter corner after road construction.

July 29, 1993. We used the iron pipes to reset the quarter corner. We set a railroad spike and took new reference ties.

# Certificate of Location of Government Corner

Northeast corner, Section 11, Township 116 North, Range 27 West

SKETCH OF REFERENCE TIES (NO SCALE)

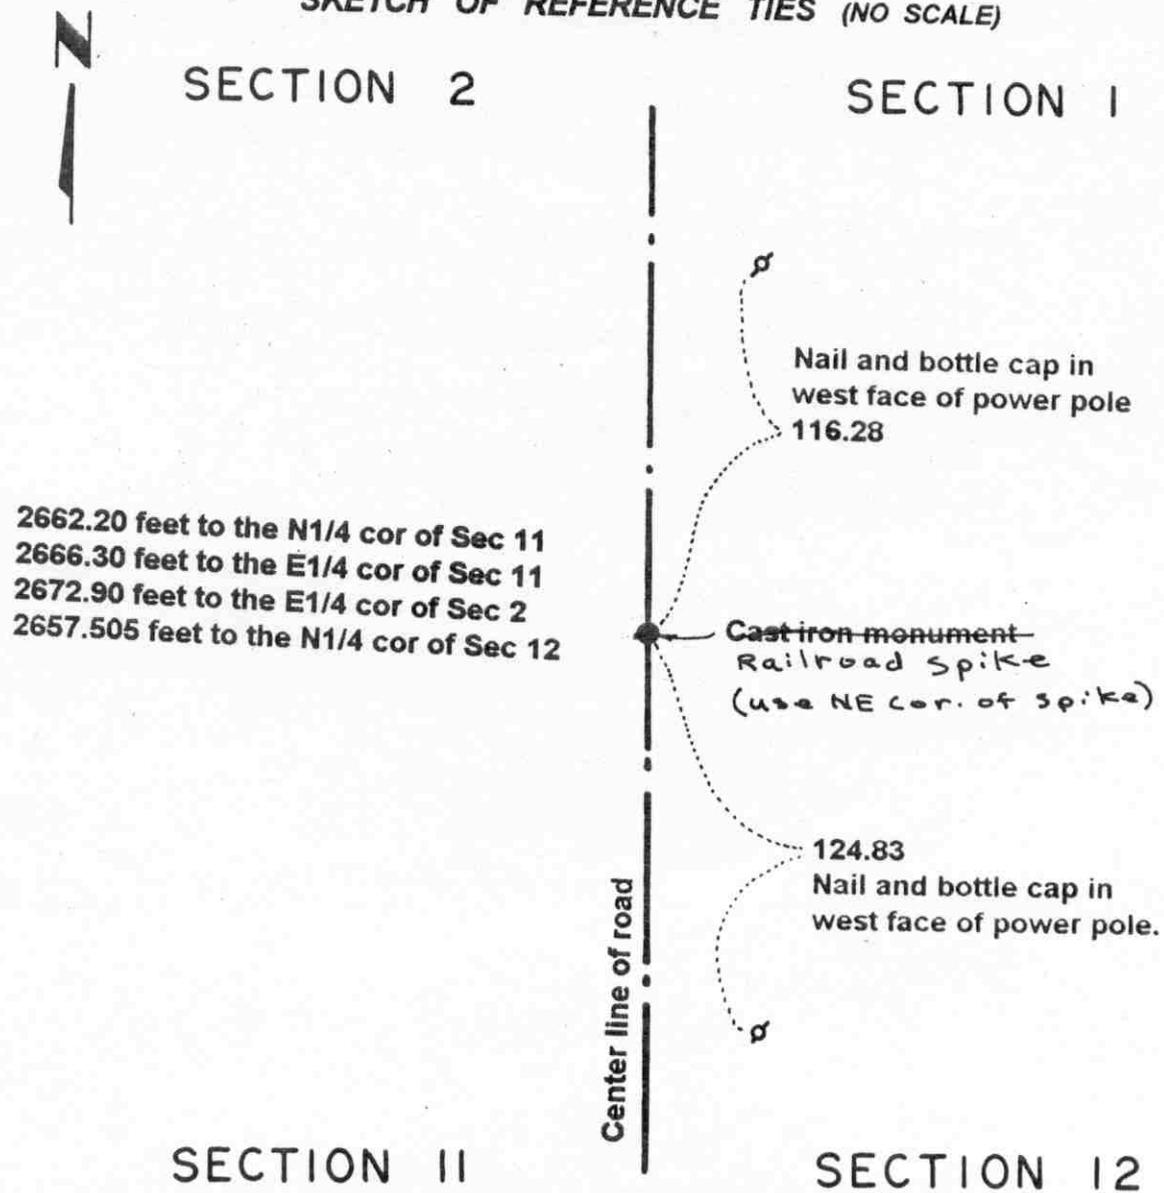

Statement of evidence relative to this corner location on sheet 2

I hereby certify that this document was prepared by me or under my direct supervision.

Willard Pellinen  
Willard Pellinen  
McLeod County Surveyor  
License No. 9626.

Date Nov. 3, 1995

OFFICE OF THE COUNTY RECORDER  
MCLEOD COUNTY, MINNESOTA

I hereby certify that this document was filed in this office at 9 o'clock A. M. on the 9th day of January, 1996.

Carmen Estelle Mulder, County Recorder

By Charleen Engelman, Deputy.

Document No. 270196

**Certificate of Location of Government Corner**  
**Northeast Corner, Section 11, Township 116 North, Range 27 West**

**November, 1856. E. N. Darling of the General Land Office established this corner. He set a post and marked an ironwood and 3 elms for bearing trees.**

**1971. Dickman Knutson, county surveyor, excavated for the corner, John Tupa from Hutchinson with a backhoe. They found no evidence of the government corner.**

**August, 1971. Knutson set an iron pipe at the corner, using improvements, occupation lines, etc. in Sections 1, 2, 11 and 12. This corner is on the center line of the north-south road.**

**October 13, 1971. Knutson replaced the iron pipe with a McLeod County cast iron monument and took available reference ties.**

**May 23, 1990. We found the monument in good condition and took new reference ties.**


**January, 1995. There being no evidence to the contrary, the monument set by Knutson is accepted as marking the location of the government corner.**

**November 2, 1995. Corner had been destroyed by road construction. We set a railroad spike at the corner and took new ties.**

# Certificate of Location of Government Corner

North Quarter corner, Section 11, Township 116 North, Range 27 West

SKETCH OF REFERENCE TIES (NO SCALE)

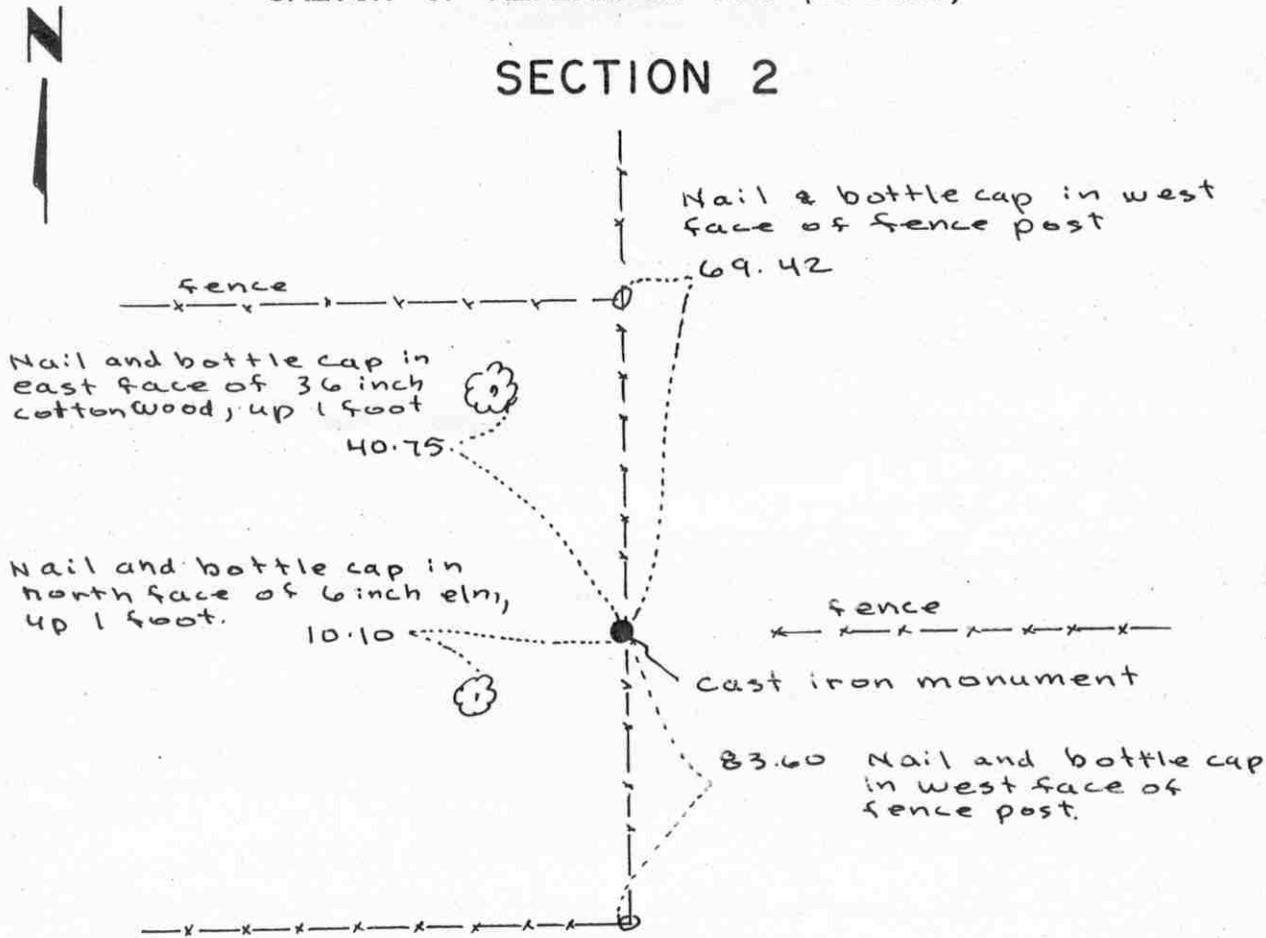

## SECTION 11

Statement of evidence relative to this corner location on sheet 2

I hereby certify that this document was prepared by me or under my direct supervision.

Willard Pellinen  
Willard Pellinen  
McLeod County Surveyor  
License No. 9626.

Date Jan 9, 1995

OFFICE OF THE COUNTY RECORDER  
MCLEOD COUNTY, MINNESOTA

I hereby certify that this document was filed in this office at 9 o'clock A. M. on the 13th day of January 19 95.

Carmen O'Brien Mulder, County Recorder

By \_\_\_\_\_, Deputy.

Document No. 263714

## ***Certificate of Location of Government Corner***

***North Quarter Corner, Section 11 Township 116 North, Range 27 West***

***November, 1856. E. N. Darling of the General Land Office established this corner. He set a post and marked a 10 inch and a 12 inch elm for bearing trees.***

***July 2, 1971. Dickman Knutson, county surveyor, found a stone, 2 feet long, with a sharp point up 1 foot north of the remains of an old corner fence post. A straight line between the stone and the north quarter corner of Section 11 checks good with the monumentation of plats in Lester Prairie. There was a fence running east from the stone.***


***Knutson dug out the stone and set a McLeod County cast iron monument and took available reference ties.***

***January 5, 1995. We found the monument in good condition and took new reference ties.***

# Certificate of Location of Government Corner

East Quarter corner, Section 12, Township 116 North, Range 27 West

SKETCH OF REFERENCE TIES (NO SCALE)

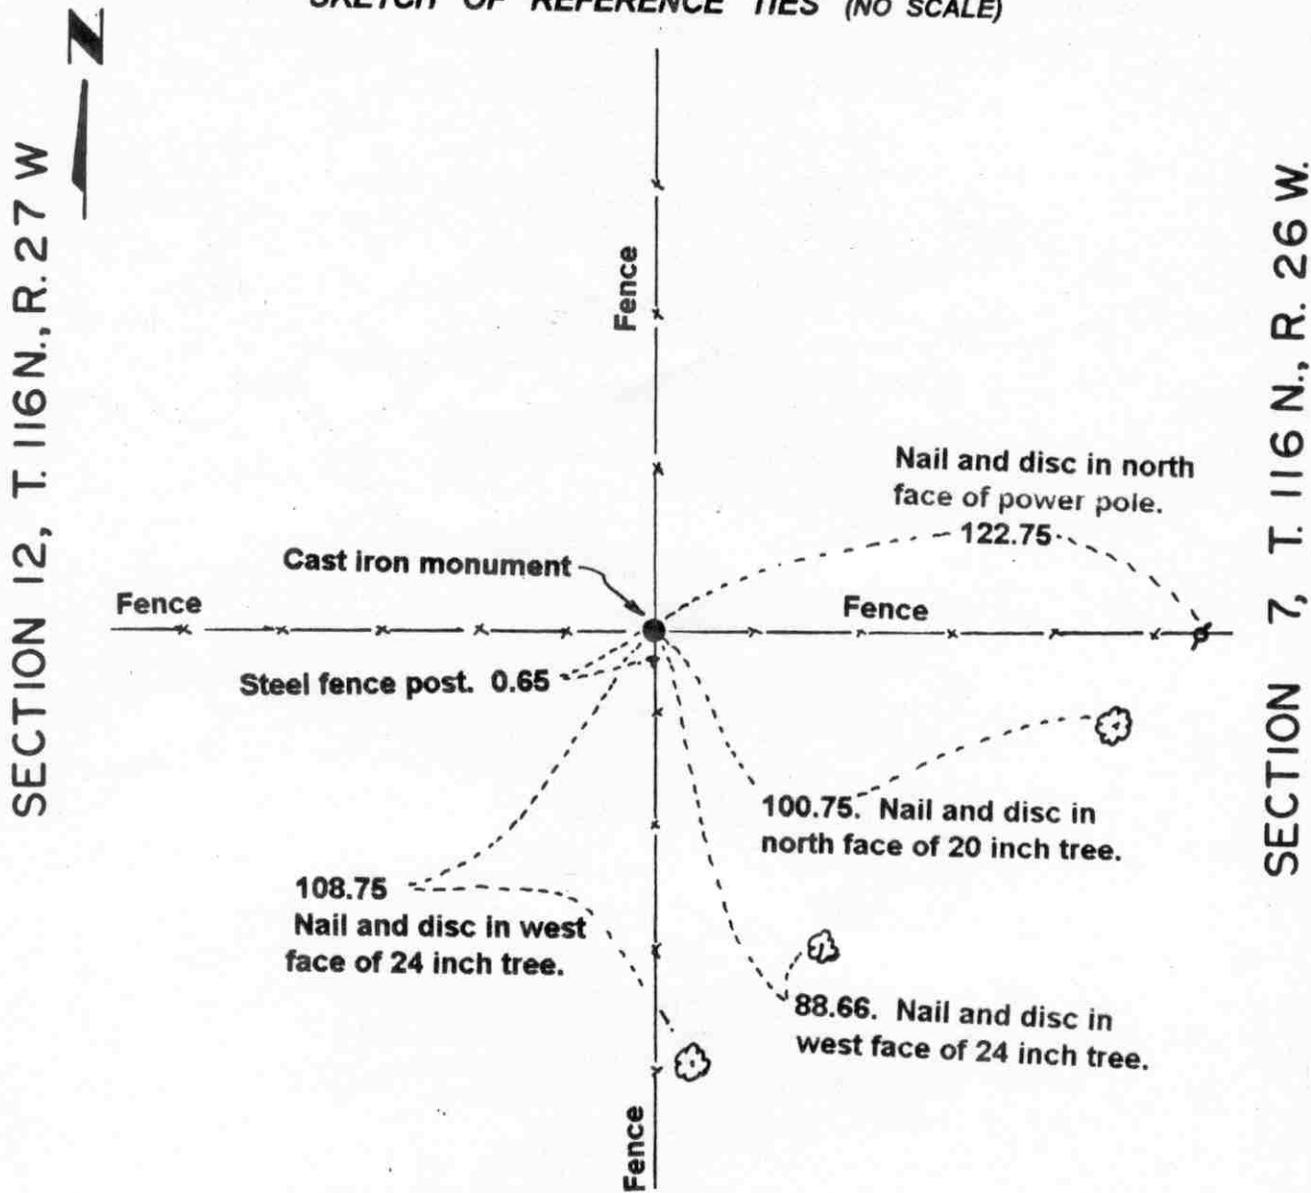

Statement of evidence relative to this corner location on sheet 2

I hereby certify that this document was prepared by me or under my direct supervision.

Willard Pellinen  
 Willard Pellinen  
 McLeod County Surveyor  
 License No. 9626.

Date July 5, 1995

OFFICE OF THE COUNTY RECORDER  
 MCLEOD COUNTY, MINNESOTA

I hereby certify that this document was filed in this office at 9 o'clock A.M. on the 18th day of July, 19 95.

Carmen Ostlie Mulder County Recorder

By \_\_\_\_\_ Deputy.

Document No. 267011

## ***Certificate of Location of Government Corner***

***East Quarter Corner, Section 12, Township 116 North, Range 27 West***

***1855. John Ryan of the General Land Office established this corner. He set a post in a swamp and marked 2 oaks for bearing trees.***

***1971. Dickman Knutson, county surveyor, searched for the corner at a fence intersection which adjoining land owners agree is the quarter corner. He found no evidence of the government corner.***


***October 24, 1972. Knutson set a McLeod County cast iron monument at the fence intersection, fences north, south, east and west, and took available ties.***

***December, 1994. The monument set by Knutson is accepted as marking the location of the government corner. It fits long standing occupation lines (the fences) which have been accepted by adjoining land owners as the section and quarter lines.***

# Certificate of Location of Government Corner

Northeast corner, Section 12, Township 116 North, Range 27 West

SKETCH OF REFERENCE TIES (NO SCALE)

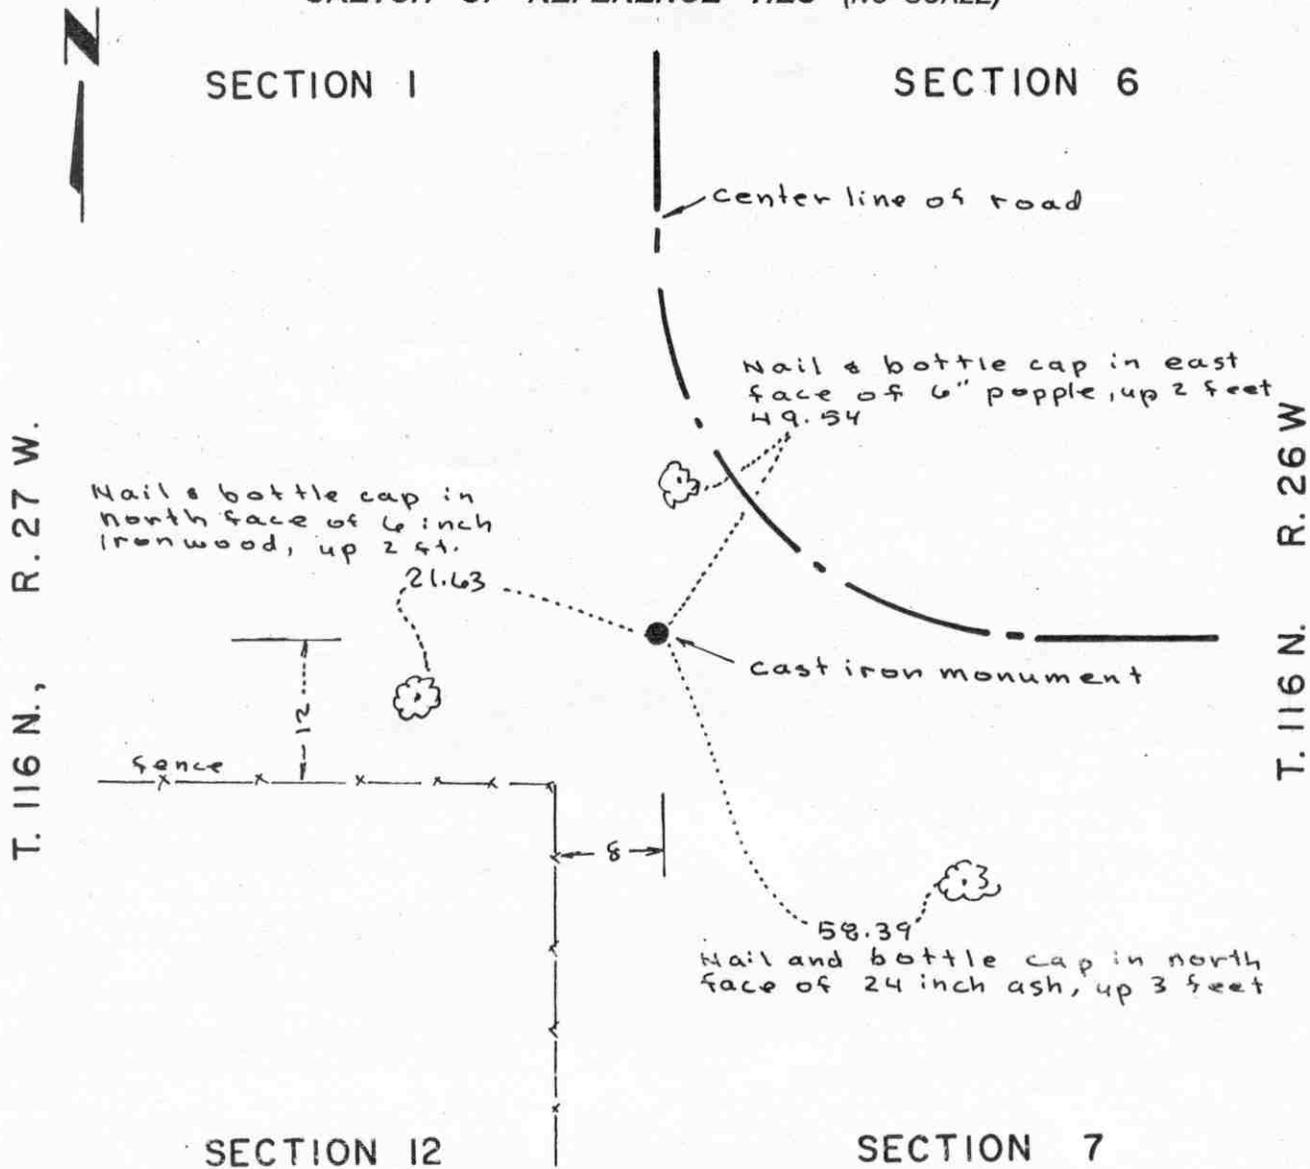

Statement of evidence relative to this corner location on sheet 2

I hereby certify that this document was prepared by me or under my direct supervision.

Willard Pellinen  
 Willard Pellinen  
 McLeod County Surveyor  
 License No. 9626.

Date Jan 9, 1995

OFFICE OF THE COUNTY RECORDER  
 MCLEOD COUNTY, MINNESOTA

I hereby certify that this document was filed in this office at 9 o'clock A. M. on the 13th day of January 19 95.

Carmen Estlin Mulder, County Recorder

By \_\_\_\_\_, Deputy.

Document No. 263715

## ***Certificate of Location of Government Corner***

***Northeast Corner, Section 12, Township 116 North, Range 27 West***

***1855. John Ryan of the General Land Office established this corner. He set a post and marked 3 elms and a maple for bearing trees.***

***August 25, 1971. Dickman Knutson, county surveyor, found a limestone monument and took available reference ties.***


***October 8, 1971. Knutson replaced the limestone monument with a McLeod County cast iron monument.***

***January 5, 1995. We found the monument in good condition and took new reference ties.***

# Certificate of Location of Government Corner

North Quarter corner, Section 12, Township 116 North, Range 27 West

## SKETCH OF REFERENCE TIES (NO SCALE)

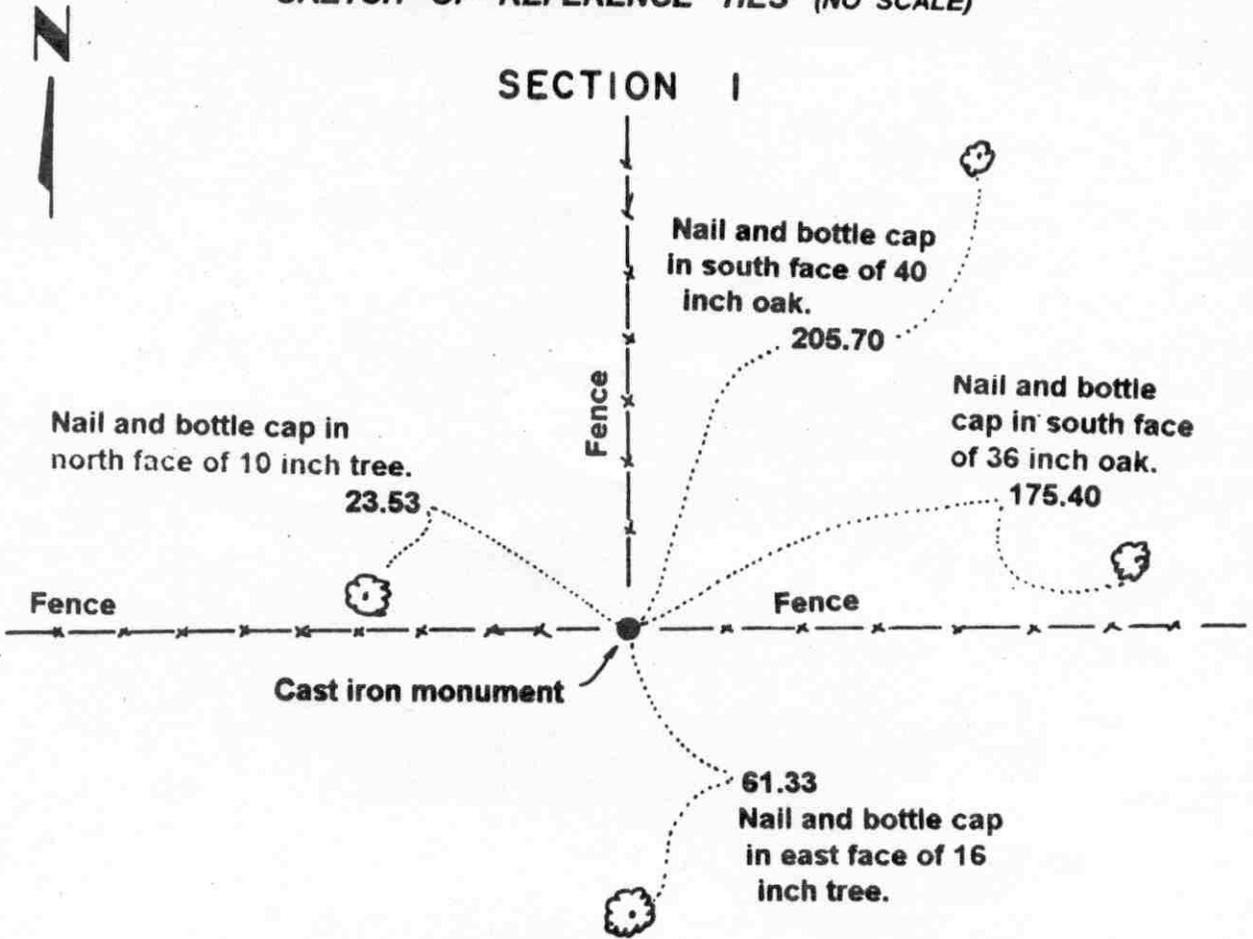

5337.79 feet to the S1/4 cor. of Sec 12.  
 2657.50 feet to the NW cor. of Sec. 12.  
 5374.18 feet to the N1/4 cor. of Sec. 1.

## SECTION 12

Statement of evidence relative to this corner location on sheet 2

I hereby certify that this document was prepared by me or under my direct supervision.

Willard Pellinen  
 Willard Pellinen  
 McLeod County Surveyor  
 License No. 9626.

Date July 5, 1995

OFFICE OF THE COUNTY RECORDER  
 MCLEOD COUNTY, MINNESOTA

I hereby certify that this document was filed in this office at 9 o'clock A. M. on the 18th day of July 19 95.

Armen Ostlie Mulder County Recorder

By \_\_\_\_\_, Deputy.

Document No. 267012

## ***Certificate of Location of Government Corner***

***North Quarter Corner, Section 12, Township 116 North, Range 27 West***

***November, 1856. E. N. Darling of the General Land Office established this corner. He set a post and marked 2 lindens for bearing trees.***

***1974. Hillard Matthews, 43 years old and had lived in the Southeast Quarter of Section 1 for 20 years, Walter Dose, 60 years old and had lived in the Northwest Quarter of Section 12 since 1937 and Orville Foust, 41 years old and had lived in the Northeast Quarter of Section 13 all his life (he owns North Half of Northeast Quarter of Section 12), all agree the fence intersection is the quarter corner. Fences running north, east and west.***


***August 15, 1974. Dickman Knutson, county surveyor, set a McLeod County cast iron monument at the fence intersection and took available reference ties.***

***December, 1994. The monument set by Knutson is accepted as marking the location of the government corner. It fits long standing occupation line (the fences) which have been accepted by adjoining land owners as the section and quarter section lines.***

# Certificate of Location of Government Corner

EAST QUARTER corner, Section 13, Township 116 North, Range 27 West

SKETCH OF REFERENCE TIES (NO SCALE)

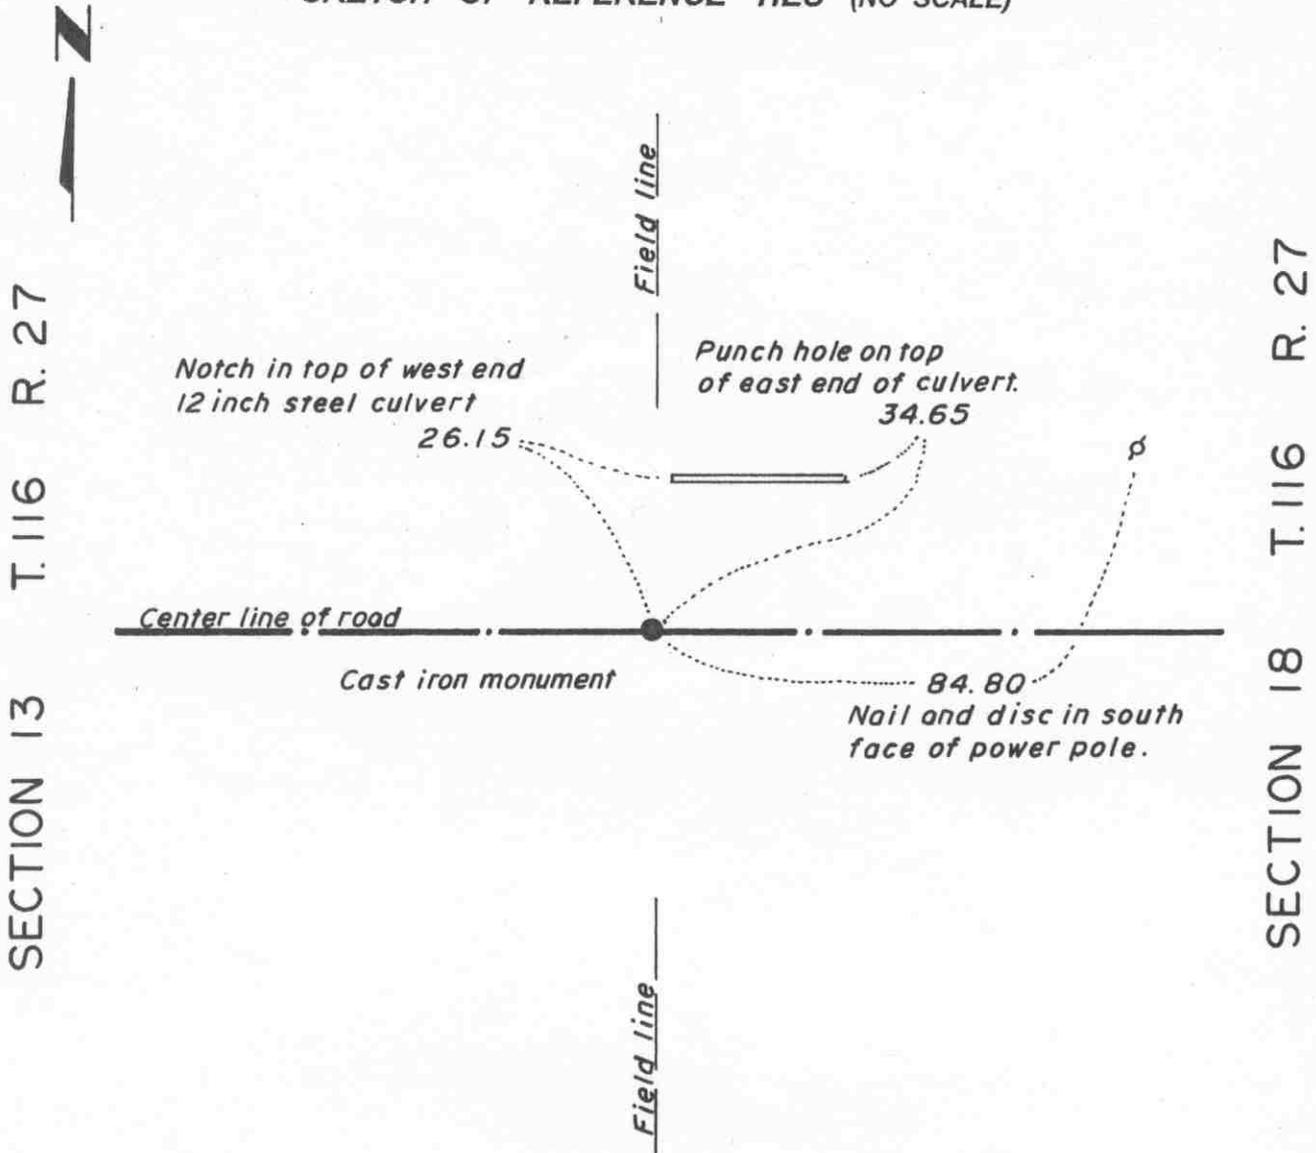

**Statement of evidence relative to this corner location on sheet 2**

I hereby certify that this document was prepared by me or under my direct supervision.

Willard Pellinen  
 Willard Pellinen  
 McLeod County Surveyor  
 License No. 9626.

Date Feb. 4, 1995.

**OFFICE OF THE COUNTY RECORDER  
 MCLEOD COUNTY, MINNESOTA**

I hereby certify that this document was filed in this office at 9 o'clock A. M. on the 6th day of February, 19 95.

Carmen Patricia Mulder County Recorder

By \_\_\_\_\_, Deputy.

Document No. 264031

# Certificate of Location of Government Corner

EAST QUARTER corner, Section 13, Township 116 North, Range 27 West

1855. John Ryan of the General Land Office set a post and marked a 10 inch oak and a 10 inch elm for bearing trees.

October 22, 1971. Dickman Knutson, county surveyor, excavated for the corner, John Tupa from Hutchinson with a backhoe. Down 3 feet below the road surface (in original ground) they found a 10 inch diameter field stone. They tied it off and below the stone they found some traces of a wood post. This was in the center line of the east-west road, in line with fences north and south.

October 29, 1971. Knutson set a McLeod County cast iron monument at the corner. H. Fenske, 70± years old and had lived in the Southwest Quarter of Section 18, Township 116, Range 26 for 46 years, said the stone we found is the quarter corner. H. Lempher, 60± years old agrees.


The monument set by Knutson is accepted as marking the correct location of the quarter corner. It fits long standing occupation lines, the center line of the road and the fences, and it perpetuates the location of older monuments, the stone and wood stake.

*January 5, 1995. We checked the reference ties to the monument.*

# Certificate of Location of Government Corner

Northeast corner, Section 13, Township 116 North, Range 27 West

SKETCH OF REFERENCE TIES (NO SCALE)

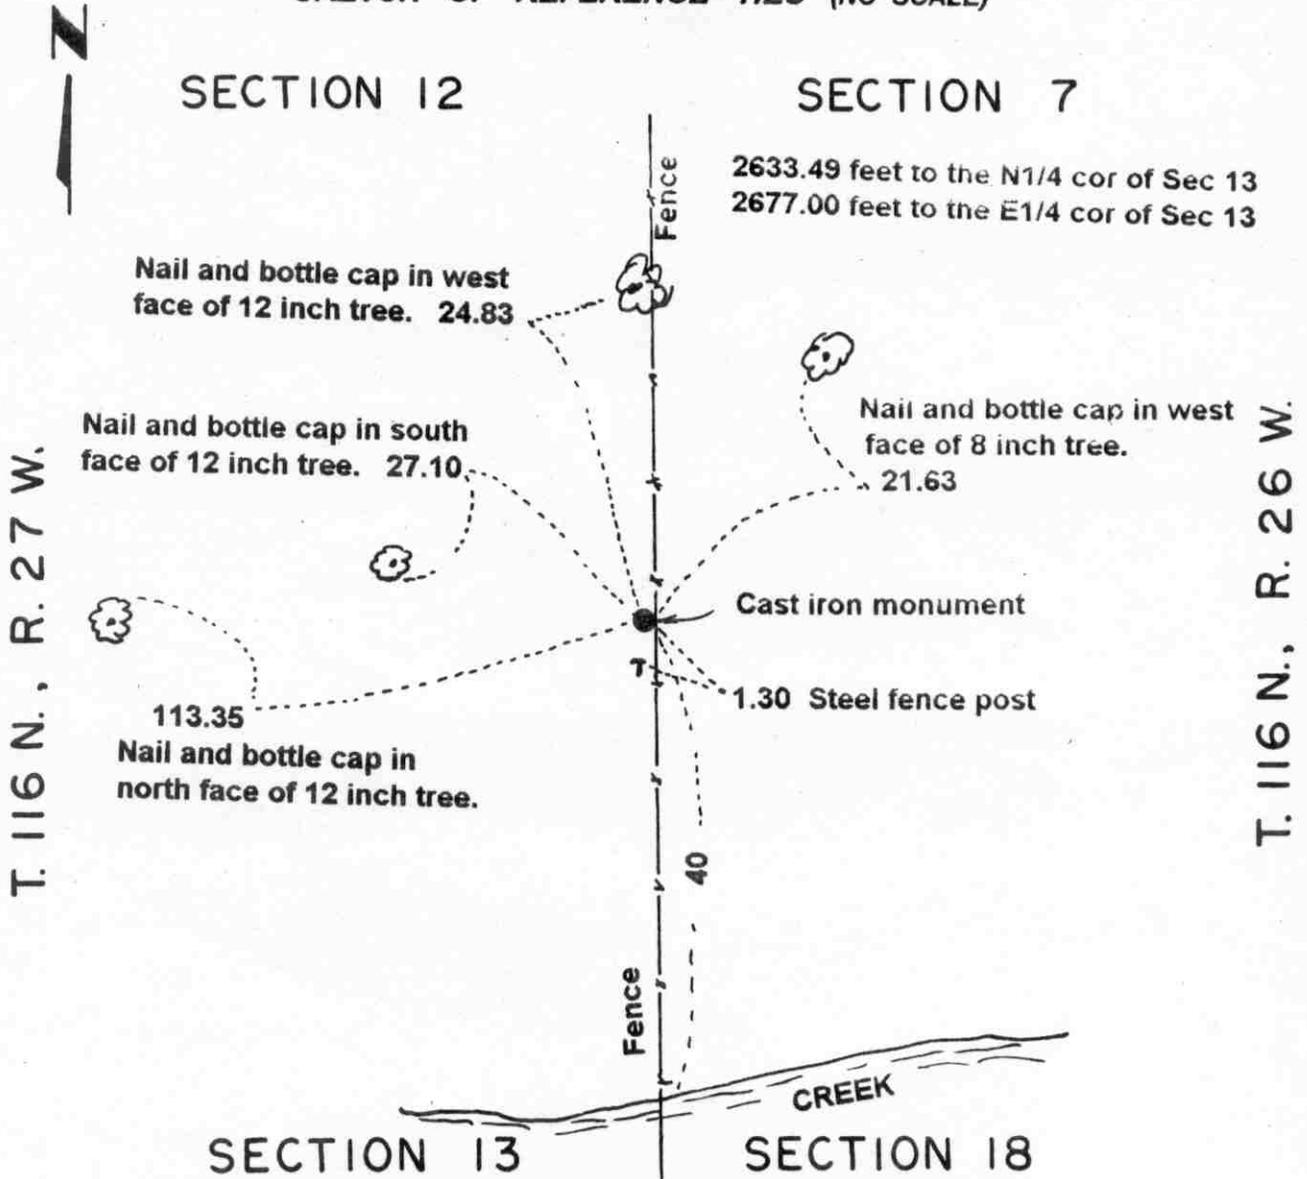

Statement of evidence relative to this corner location on sheet 2

I hereby certify that this document was prepared by me or under my direct supervision.

Willard Pellinen  
Willard Pellinen  
McLeod County Surveyor  
License No. 9626.

Date Dec. 13, 1995

OFFICE OF THE COUNTY RECORDER  
MCLEOD COUNTY, MINNESOTA

I hereby certify that this document was filed in this office at 9 o'clock A. M. on the 9th day of January 19 96.

Carmen Estelle Mulder, County Recorder

By Charles Engelman, Deputy.

Document No. 270197

**Certificate of Location of Government Corner**  
**Northeast Corner, Section 13, Township 116 North, Range 27 West**

**1855. John Ryan of the General Land Office established this corner. He set a post and marked 4 elms for bearing trees.**

**August 25, 1971. Dickman Knutson, county surveyor, found a limestone monument and took available reference ties. This was along the west side of a north-south fence.**

**October 13, 1971. Knutson replaced the limestone monument with a McLeod County cast iron monument.**


**January, 1995. The monument set by Knutson is accepted as marking the location of the government corner. It fits a long standing occupation line (the fence) and it perpetuates the location of an older monument (the limestone monument).**

# Certificate of Location of Government Corner

North Quarter corner, Section 13, Township 116 North, Range 27 West

SKETCH OF REFERENCE TIES (NO SCALE)

SECTION 12

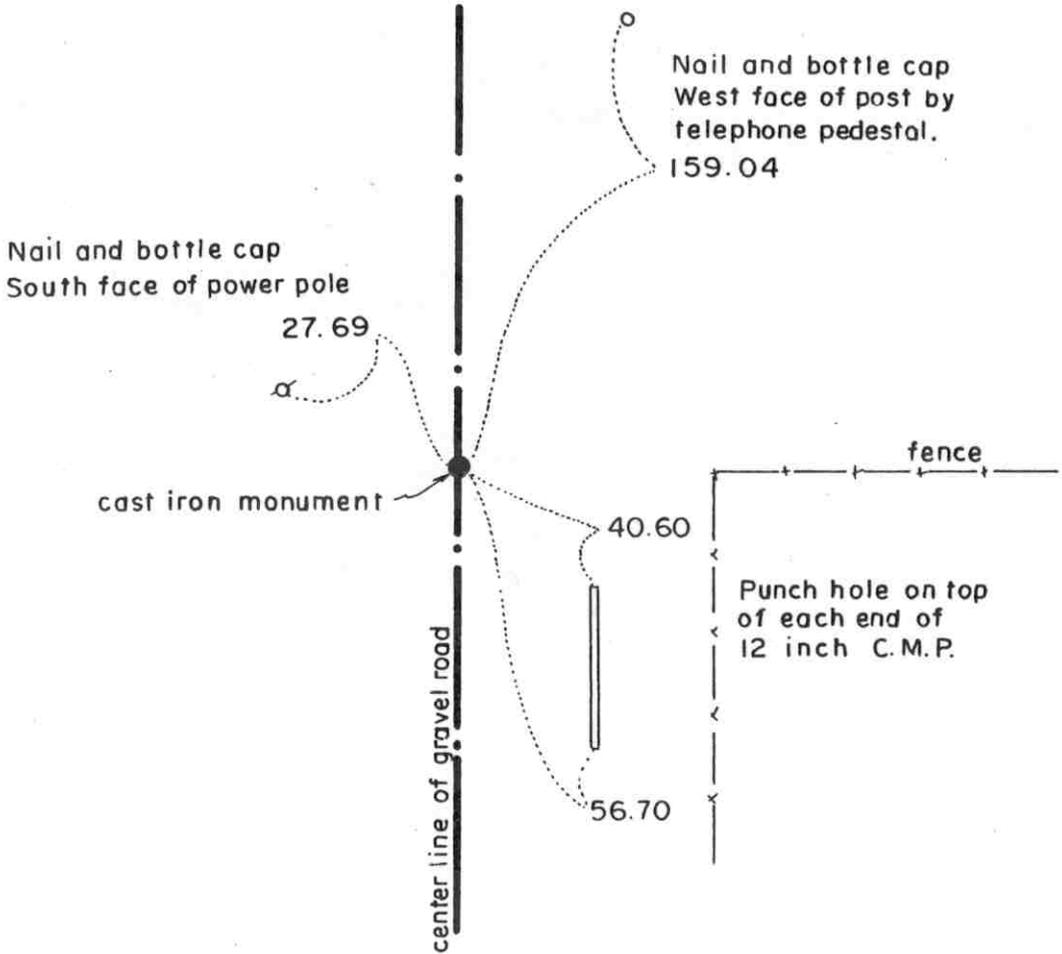

SECTION 13

Statement of evidence relative to this corner location on sheet 2

I hereby certify that this document was prepared by me or under my direct supervision.

*Willard Pellinen*

Willard Pellinen  
McLeod County Surveyor  
License No. 9626.

Date Sept 6, 1994

OFFICE OF THE COUNTY RECORDER  
MCLEOD COUNTY, MINNESOTA

I hereby certify that this document was filed in this office at 9 o'clock A. M. on the 22nd day of September 19 94.

*Carmen Estlie Mulder*, County Recorder

By \_\_\_\_\_, Deputy.

Document No. 261934

## ***Certificate of Location of Government Corner***

***North Quarter Corner, Section 13, Township 116 North, Range 27 West***

***November, 1856. E. N. Darling of the General Land Office originally established this corner. He set a post and marked a 6 inch aspen and a 5 inch elm for bearing trees.***

***April 17, 1978. Dickman Knutson, county surveyor, excavated for the corner. (John Tupa from Hutchinson, with a backhoe) They found a 2 inch by 2 inch by 12 inch rotted wood stake down 3 1/2 feet below the surface of the gravel road. They took available reference ties.***

***May 18, 1978. Knutson set a McLeod County cast iron monument at the corner.***

***This monument is 5.38 feet west of a split between the northeast and northwest corners of Section 13 and 5.6 feet south of a straight line between the corners.***

***August 23, 1994. We found the monument in good condition down 3 inches below the surface of the gravel road and took new reference ties.***


# Certificate of Location of Government Corner

SKETCH OF REFERENCE TIES  
(NO SCALE)



SECTION 14

SECTION 13

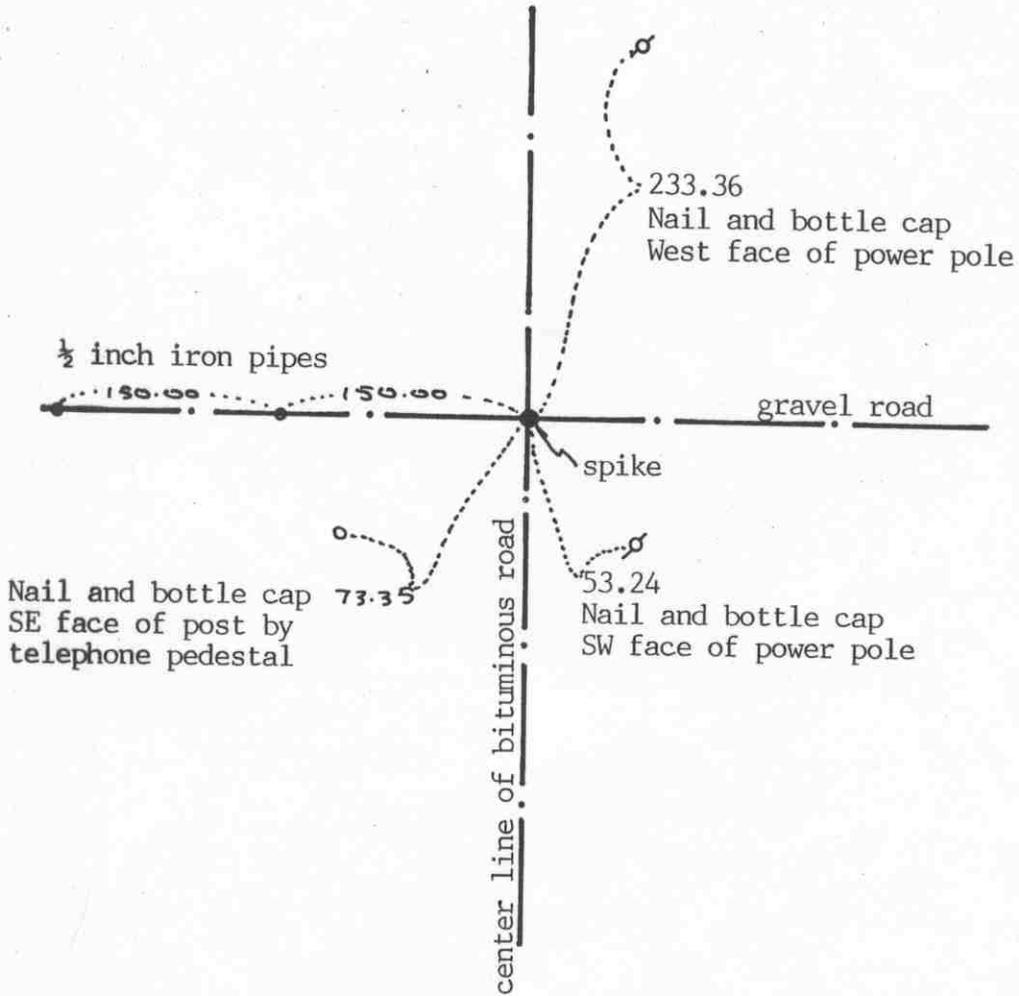

Statement of evidence relative to this corner location on sheet 2

I hereby certify that this document was prepared by me or under my direct supervision.

Willard Pellinen  
Willard Pellinen  
McLeod County Surveyor  
License No. 9626

Date August 1, 1992

OFFICE OF THE COUNTY RECORDER  
MCLEOD COUNTY, MINNESOTA.

I hereby certify that this document was filed in this office at 9 o'clock A.M. on the 20th day of Aug, 1992.

Garmen Ostlie, County Recorder

By \_\_\_\_\_, Deputy

Document No. 247337

EAST QUARTER corner, Section 14, Township 116 North, Range 27 West

## Certificate of Location of Government Corner

November, 1856. E. N. Darling of the General Land Office set a post and marked an oak and an elm for bearing trees.

March 21, 1974. We set a temporary corner at the center line intersection of the roads.

January 7, 1981. Mr. Harry Huser, 79 years old and had lived in the southeast quarter of Section 14 for 43 years, said the center lines of the roads has been accepted as being the quarter corner. When the road was rebuilt, they dug for the corner but found nothing.

1981. We found a 1 inch diameter iron pin down 2 feet below the surface of the road. We tied it off and dug below but found nothing else. The iron pin was probably set by the county highway department.

August 11, 1981. We set a  $\frac{1}{2}$  inch diameter iron pipe using the ties for the iron pin.


May 23, 1990. We set iron pipes 150.00 feet and 300.00 feet west of the corner along the east west quarter line of Section 14. Road will be rebuilt so the other ties will be destroyed.

December 31, 1991. We reset the corner, a spike, and took additional reference ties.

# Certificate of Location of Government Corner

NORTHEAST corner, Section 14, Township 116 North, Range 27 West

## SKETCH OF REFERENCE TIES (NO SCALE)

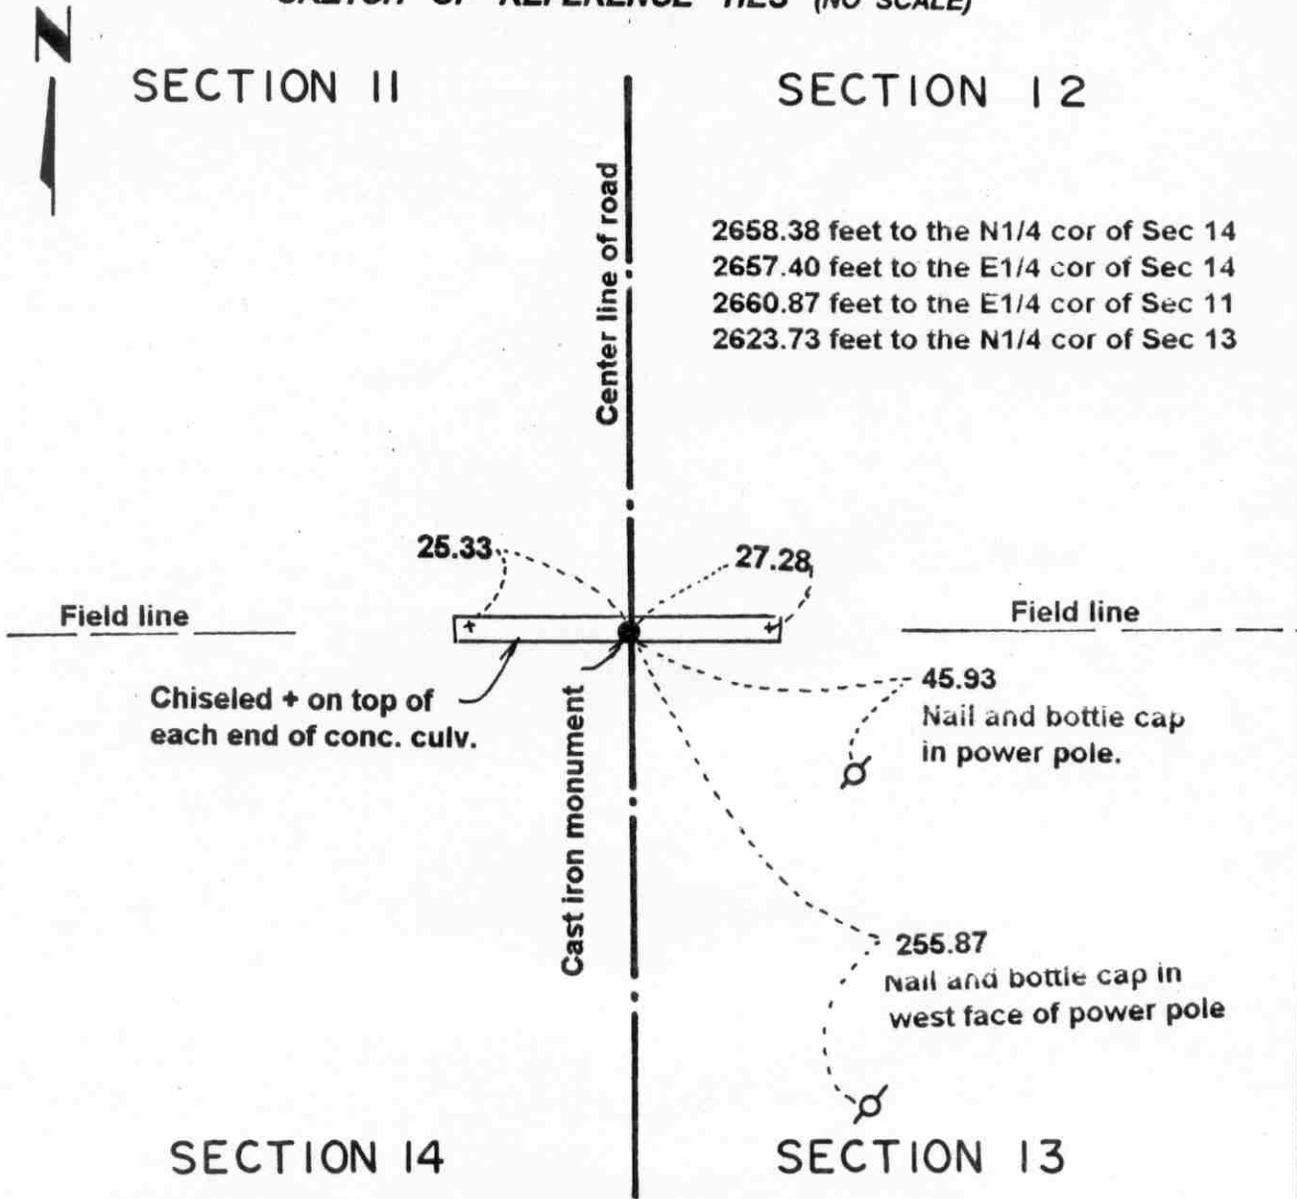

**Statement of evidence relative to this corner location on sheet 2**

I hereby certify that this document was prepared by me or under my direct supervision.

Willard Pellinen  
 Willard Pellinen  
 McLeod County Surveyor  
 License No. 9626.

Date Dec. 13, 1995

**OFFICE OF THE COUNTY RECORDER  
 MCLEOD COUNTY, MINNESOTA**

I hereby certify that this document was filed in this office at 9 o'clock A. M. on the 9th day of January, 19 96.

Carmen Ostlie Mueller, County Recorder

By Charleen Engelman, Deputy.

Document No. 270198

**Certificate of Location of Government Corner**  
**Northeast Corner, Section 14, Township 116 North, Range 27 West**

*November, 1856. E. N. Darling of the General Land Office established this corner. He set a post in a marsh and marked 3 elms and an aspen for bearing trees.*

*According to adjoining land owners, this corner was destroyed when a culvert was placed across the road. The culvert was supposed to be placed directly over the section corner.*

*April 10, 1978. Dickman Knutson, county surveyor, set a railroad spike in the center of the north-south road directly over the culvert. This was in line with field lines east and west. Land owners said there was a fence where the field line to the west is now.*

*September 8, 1978. Knutson replaced the railroad spike with a McLeod County cast iron monument and took available reference ties.*

*May 23, 1990. We found the monument in good condition and checked the ties.*


*January, 1995. The monument set by Knutson accepted as marking the correct location of the government corner. It fits long standing occupation lines, the field lines and the road, and adjoining land owners testified that this is the location of the section corner.*

# Certificate of Location of Government Corner

NORTH QUARTER corner, Section 14, Township 116 North, Range 27 West

SKETCH OF REFERENCE TIES (NO SCALE)

SECTION 11

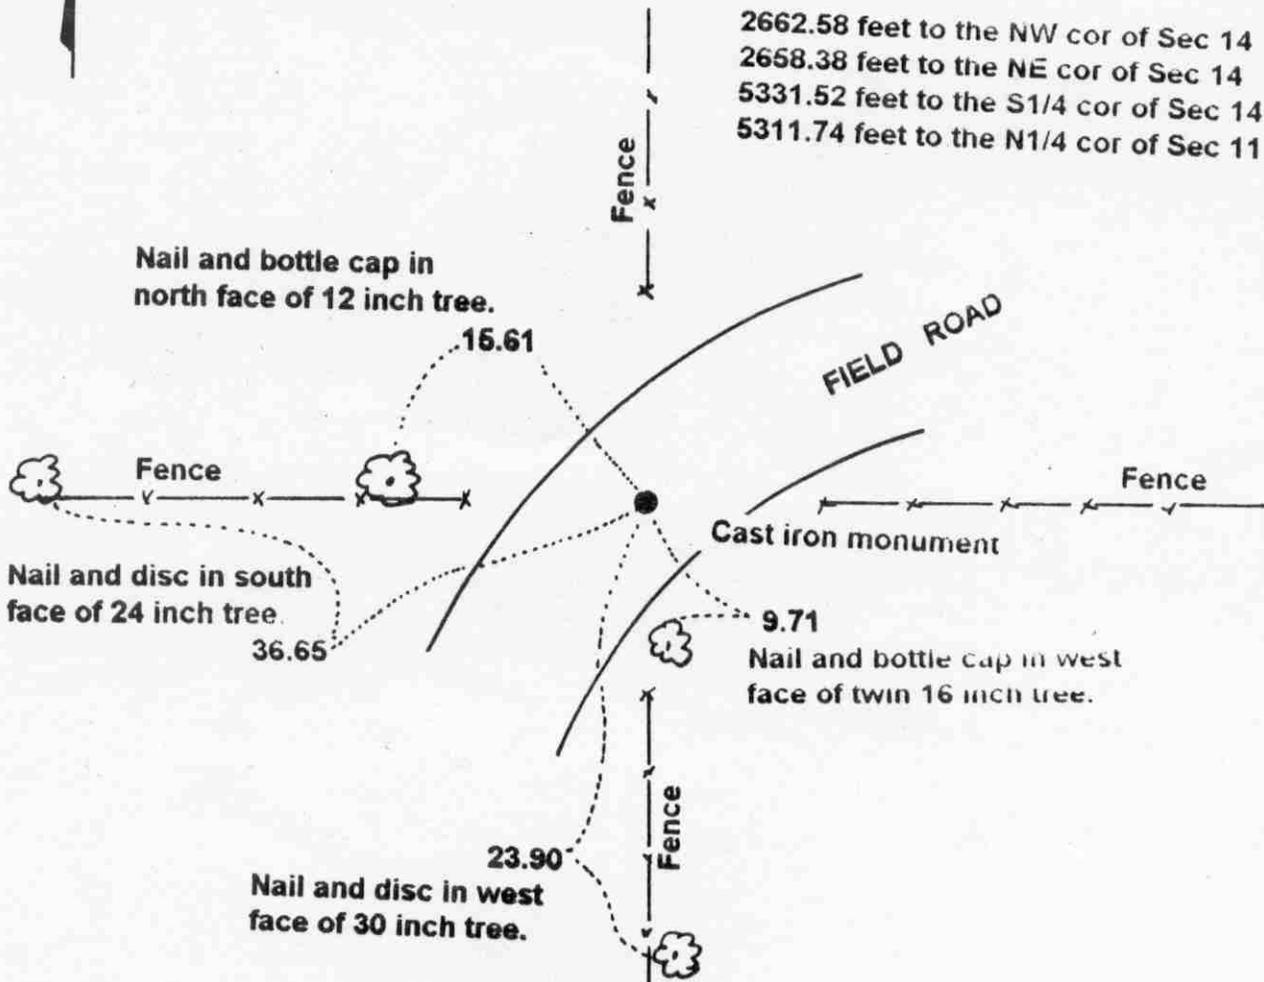

SECTION 14

Statement of evidence relative to this corner location on sheet 2

I hereby certify that this document was prepared by me or under my direct supervision.

Willard Pellinen  
Willard Pellinen  
McLeod County Surveyor  
License No. 9626.

Date Dec. 13, 1995

OFFICE OF THE COUNTY RECORDER  
MCLEOD COUNTY, MINNESOTA

I hereby certify that this document was filed in this office at 9 o'clock A. M. on the 9th day of January 19 96.

Carmen Estelle Mulder, County Recorder

By Charleen Engelmann, Deputy.

Document No. 270199

**Certificate of Location of Government Corner**  
**North Quarter Corner, Section 14, Township 116 North, Range 27 West**

**November, 1856.** *E. N. Darling of the General Land Office established this corner. He set a post and marked a 12 inch elm and a 6 inch linden for bearing trees.*

**1974.** *Adjoining land owners testified the intersection of the fences has always been accepted as the quarter corner.*

**August 15, 1974.** *Dickman Knutson, county surveyor, set a McLeod County cast iron monument at the intersection of fences north, south, east and west and took available reference ties.*


**May 23, 1990.** *We found the monument in good condition and checked the reference ties.*

**January, 1995.** *The monument set by Knutson is accepted as marking the location of the government corner. It fits long standing occupation lines, the fences, which have been accepted by adjoining land owners as running along the section and quarter section lines.*

# Certificate of Location of Government Corner

East Quarter corner, Section 15, Township 116 North, Range 27 West

## SKETCH OF REFERENCE TIES (NO SCALE)

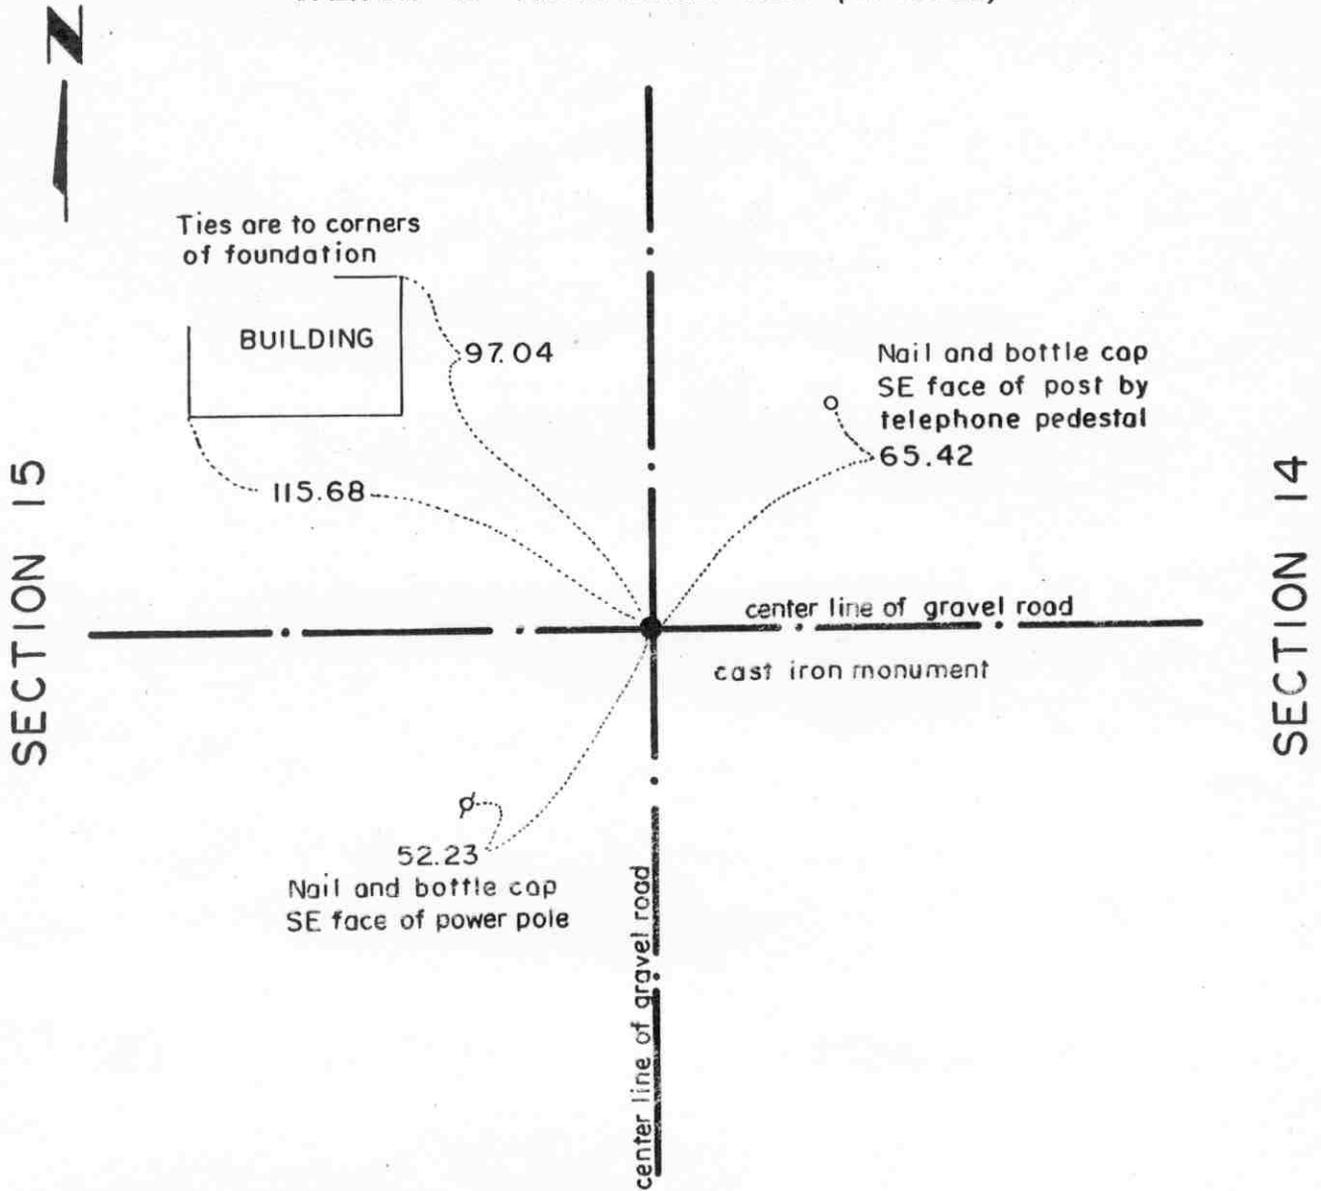

### Statement of evidence relative to this corner location on sheet 2

I hereby certify that this document was prepared by me or under my direct supervision.

Willard Pellinen

Willard Pellinen  
McLeod County Surveyor  
License No. 9626.

Date Sept. 6, 1994

### OFFICE OF THE COUNTY RECORDER MCLEOD COUNTY, MINNESOTA

I hereby certify that this document was filed in this office at 9 o'clock A. M. on the 22nd day of September 19 94.

Carmen Ottholm Mulder, County Recorder

By \_\_\_\_\_, Deputy.

Document No. 261936

## **Certificate of Location of Government Corner**

**East Quarter Corner, Section 15, Township 116 North, Range 27 West**

**November, 1856.** E. N. Darling of the General Land Office originally established this corner. He set a post and marked a 10 inch and a 12 inch linden for bearing trees.

**June 21, 1971.** Dickman Knutson, county surveyor, dug for the corner. (John Tupa from Hutchinson with a backhoe) Down 1 1/2 feet below the surface of the gravel road they found a 6 inch square by 16 inches long stone, set on end. They found an old wood stake beside the stone. This stone was at the center line intersection of gravel roads, north, south, east and west. The center line intersection has been accepted as being the quarter corner by adjoining land owners.

**July 21, 1971.** Knutson set a McLeod County cast iron monument at the corner.

**August 23, 1994.** We found the monument in good condition down 6 inches below the surface of the road and took new reference ties.

**The monument set by Knutson is accepted as marking the correct location of the quarter corner. It fits long standing occupation lines, the roads, and it perpetuates the location of an older monument.**

# Certificate of Location of Government Corner

NORTHEAST corner, Section 15, Township 116 North, Range 27 West

SKETCH OF REFERENCE TIES (NO SCALE)



SECTION 10

SECTION 11

Nail and bottle cap  
NE face of power pole

47.91

cast iron monument

39.25

Punch hole on top of  
each end of CMP

43.05

fence

center line of road

SECTION 15

SECTION 14

Statement of evidence relative to this corner location on sheet 2

I hereby certify that this document was prepared by me or under my direct supervision.

Willard Pellinen

Willard Pellinen  
McLeod County Surveyor  
License No. 9626.

Date Sept. 7, 1994

OFFICE OF THE COUNTY RECORDER  
MCLEOD COUNTY, MINNESOTA

I hereby certify that this document was filed in this office at 9 o'clock A.M. on the 22nd day of September 19 94.

Carmen Estlin Mulder, County Recorder

By \_\_\_\_\_, Deputy.

Document No. 261935

# **Certificate of Location of Government Corner**

**Northeast Corner, Section 15, Township 116 North, Range 27 West**

**November, 1856. E. N. Darling of the General Land Office originally established this corner. He set a post and marked an oak, 2 aspens and a linden for bearing trees.**

**May 11, 1972. Dickman Knutson, county surveyor, excavated for the corner. (John Tupa from Hutchinson, with a backhoe) They found a 1/2 inch iron pipe down 1/2 foot below the surface of the road. Directly below the iron pipe, down 3 1/2 feet below the surface, they found a stone, 6 inches by 8 inches by 18 inches long (set on end). This was on the center line of the north-south road in line with a fence to the east. They took reference ties to the stone.**

**May 15, 1972. Knutson set a 1/2 inch diameter iron pipe at the corner.**

**August 15, 1974. Knutson replaced the iron pipe with a McLeod County cast iron monument.**

**August 23, 1994. We found the monument in good condition and checked the reference ties.**

**The monument set by Knutson is accepted as marking the location of the section corner. It fits long standing occupation lines (the center line of the road and the fence to the east), and it perpetuates the location of an older monument (the stone).**


NORTH QUARTER corner, Section 15, Township 116 North, Range 27 West

# Certificate of Location of Government Corner

## SKETCH OF REFERENCE TIES

(NO SCALE)

### SECTION 10

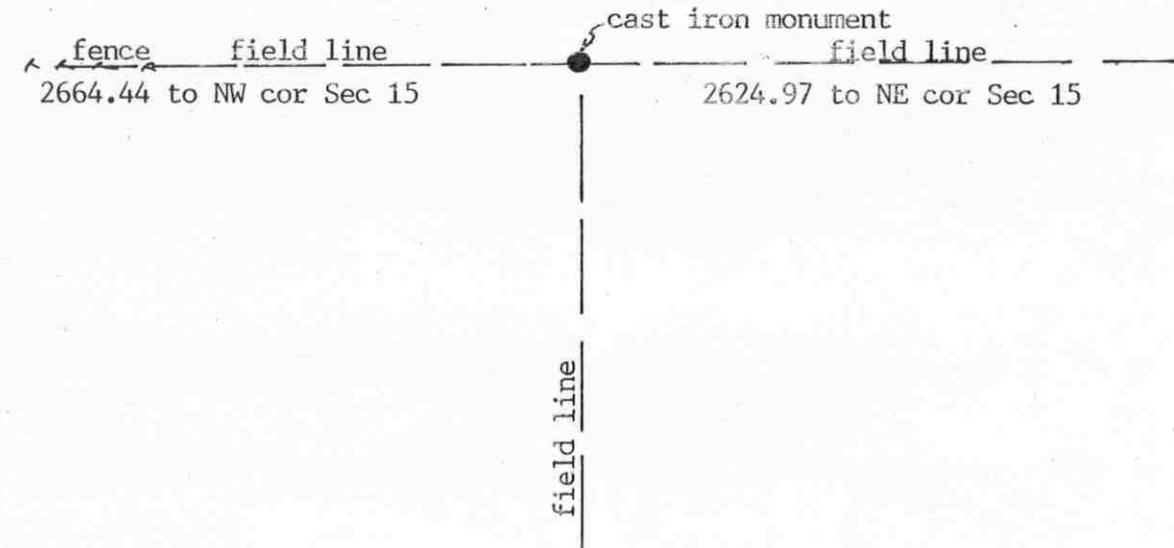

### SECTION 15

Statement of evidence relative to this corner location on sheet 2

I hereby certify that this document was prepared by me or under my direct supervision.

Willard Pellinen

Willard Pellinen  
McLeod County Surveyor  
License No. 9626

Date April 12, 1994

OFFICE OF THE COUNTY RECORDER  
MCLEOD COUNTY, MINNESOTA.

I hereby certify that this document was filed in this office at 9 o'clock A. M. on the 20th day of April, 19 94.

Carmen Estlin Mulder County Recorder

By \_\_\_\_\_, Deputy

Document No. 259046

NORTH QUARTER corner, Section 15, Township 116 North, Range 27 West

## Certificate of Location of Government Corner

November, 1856. E. N. Darling of the General Land Office established this corner. He set a post and marked a 12 inch and a 6 inch aspen for bearing trees.

March 19, 1984. We measured the north line of Section 15 and set a temporary quarter corner at the intersection of field lines east, west and south. There were a few fence posts at the intersection.

Larry Ide, who had lived in the Northwest Quarter of Section 15 for 15 years, said these posts have been accepted as marking the quarter corner. They have been there since he bought the farm. Harold Severson, 58 years old and had lived in Section 10 since he was 14 years old, agrees that the posts mark the quarter corner. Adjoining land owners have always accepted the posts as the corner.


September 17, 1984. We replaced the temporary corner with a McLeod County cast iron monument.

January 21, 1994. We found the monument in good condition at the field line intersection.

# Certificate of Location of Government Corner

East Quarter corner, Section 16, Township 116 North, Range 27 West

SKETCH OF REFERENCE TIES (NO SCALE)

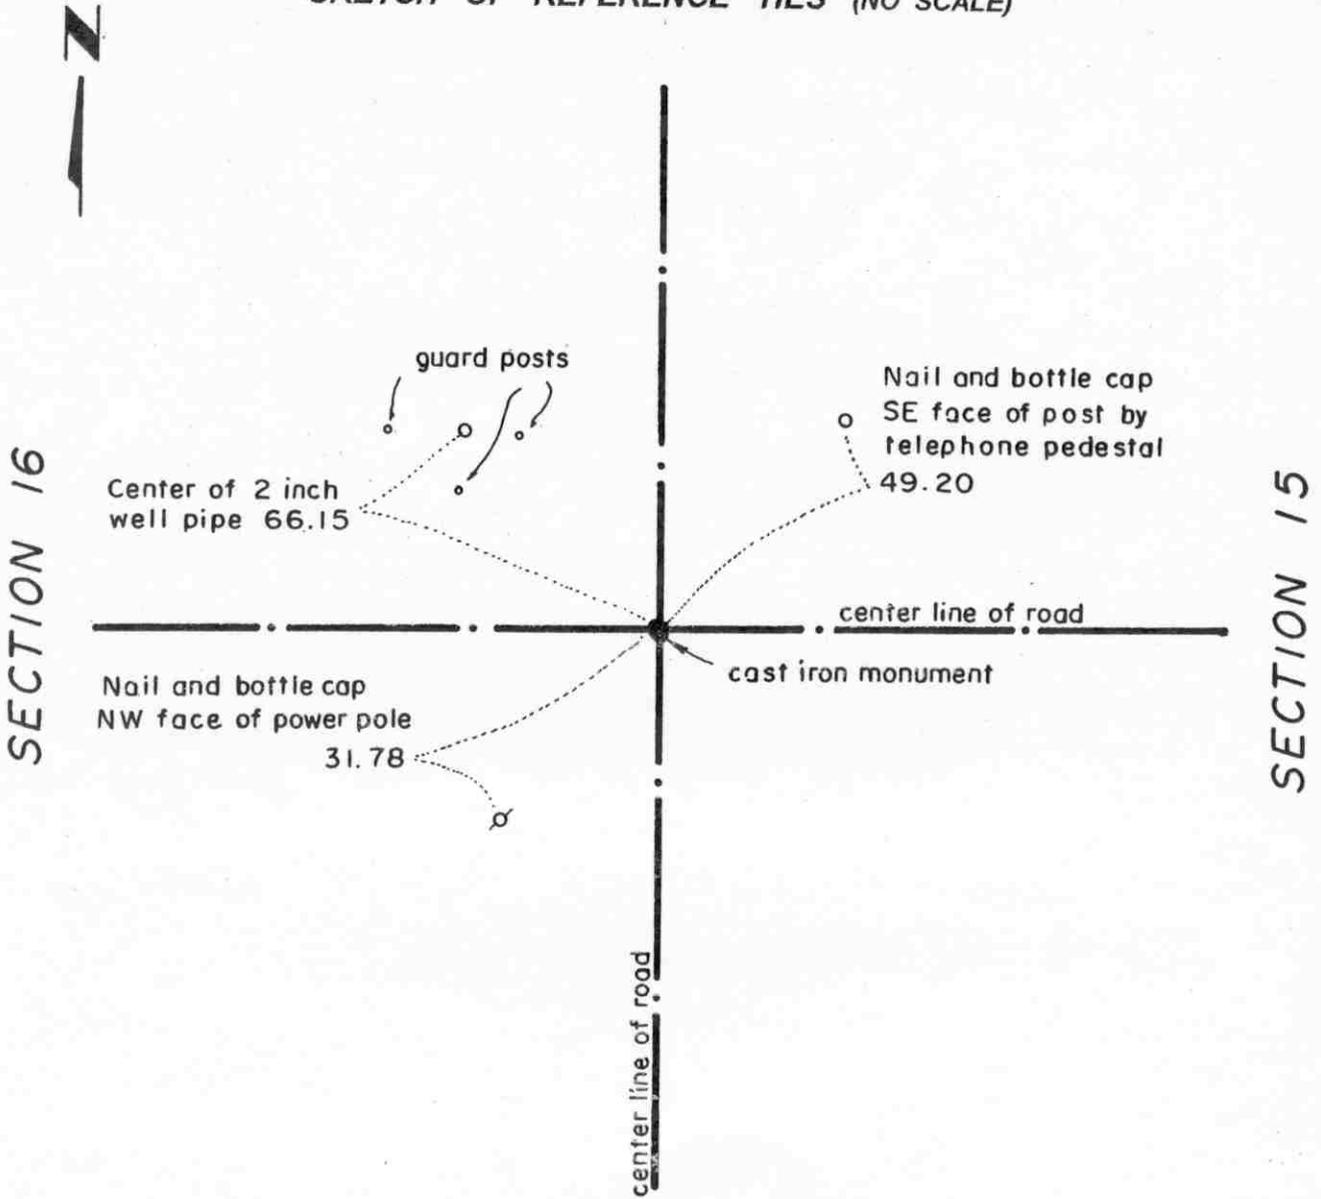

Statement of evidence relative to this corner location on sheet 2

I hereby certify that this document was prepared by me or under my direct supervision.

Willard Pellinen  
 Willard Pellinen  
 McLeod County Surveyor  
 License No. 9626.

Date Sept. 6, 1994

**OFFICE OF THE COUNTY RECORDER  
 MCLEOD COUNTY, MINNESOTA**

I hereby certify that this document was filed in this office at 9 o'clock A M. on the 9th day of Sept 19 94.

Carmen Ostlie Mulder, County Recorder

By \_\_\_\_\_, Deputy.

Document No. 261756

## **Certificate of Location of Government Corner**

**East Quarter Corner, Section 16, Township 116 North, Range 27 West**

**November, 1856. E. N. Darling of the General Land Office originally established this corner. He set a post and marked a 10 inch and a 14 inch oak for bearing trees.**

**June 21, 1971. Dickman Knutson, county surveyor, excavated for the corner. (John Tupa from Hutchinson with a backhoe) Down 1 foot below the surface of the gravel road they found a stone, 5 inches square, 10 inches long, set on end. They tied it off and moved it to make room for a monument. Below the stone they found a rotted wood stake.**


**July 21, 1971. Knutson set a McLeod County cast iron monument.**

**August 23, 1994. We found the monument in good condition down 12 inches below the surface of the gravel road and took new reference ties.**

NORTHEAST corner, Section 16, Township 116 North, Range 27 West

# Certificate of Location of Government Corner

SKETCH OF REFERENCE TIES  
(NO SCALE)

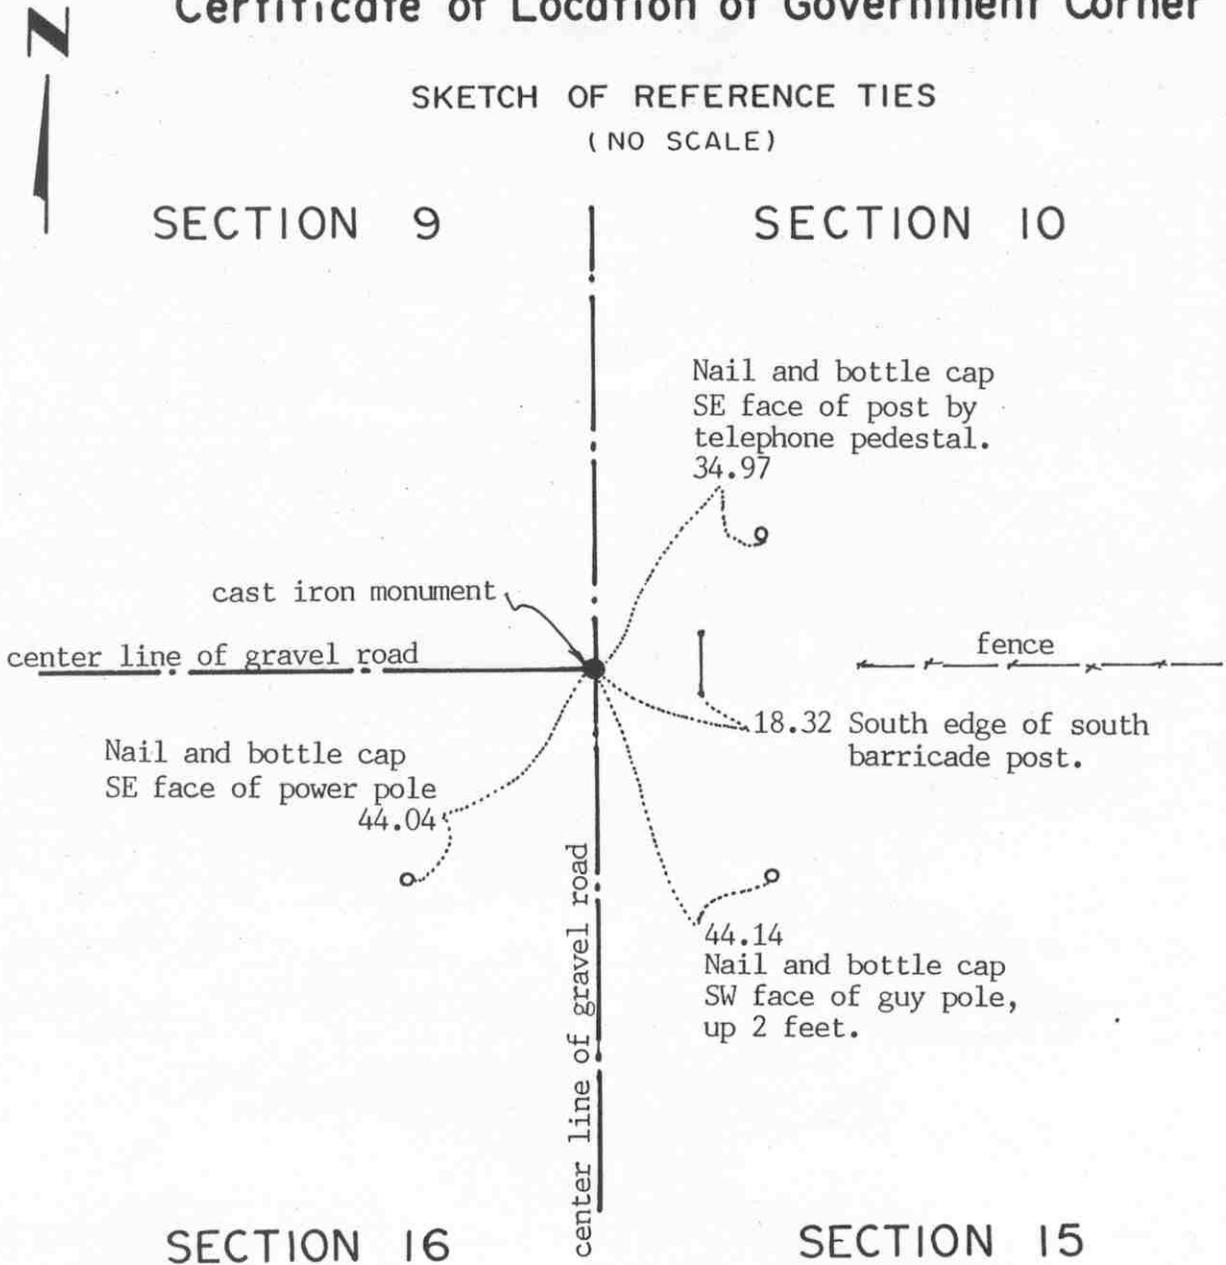

Statement of evidence relative to this corner location on sheet 2

I hereby certify that this document was prepared by me or under my direct supervision.

Willard Pellinen  
Willard Pellinen  
McLeod County Surveyor  
License No. 9626

Date April 12, 1994

OFFICE OF THE COUNTY RECORDER  
MCLEOD COUNTY, MINNESOTA.

I hereby certify that this document was filed in this office at 9 o'clock A.M. on the 20th day of April, 1994.

Carmen Estelle Mulder, County Recorder

By \_\_\_\_\_, Deputy

Document No. 259047

NORTHEAST \_\_\_\_\_ corner, Section 16, Township 116 North, Range 27 West

## *Certificate of Location of Government Corner*

November, 1856. E. N. Darling of the General Land Office set a post and marked 3 eight inch ironwoods and a 16 inch linden tree for bearing trees.

July 27, 1982. We dug for the corner at the intersection of the road center lines. Down 1 foot below the road surface we found an 8 inch diameter stone. We took ties and directly below the first stone, down 1½ feet below the road surface we found a 10 inch square, 6 inch high stone with a chiseled + on top.

Adjoining land owners have accepted the road intersection as marking the section corner.

August 20, 1982. We set a McLeod County cast iron monument at the corner and took additional reference ties.


January 21, 1994. We found the monument in good condition and checked the reference ties.

# Certificate of Location of Government Corner

North Quarter      corner, Section   16  , Township   116   North, Range   27   West

SKETCH OF REFERENCE TIES (NO SCALE)

SECTION 9

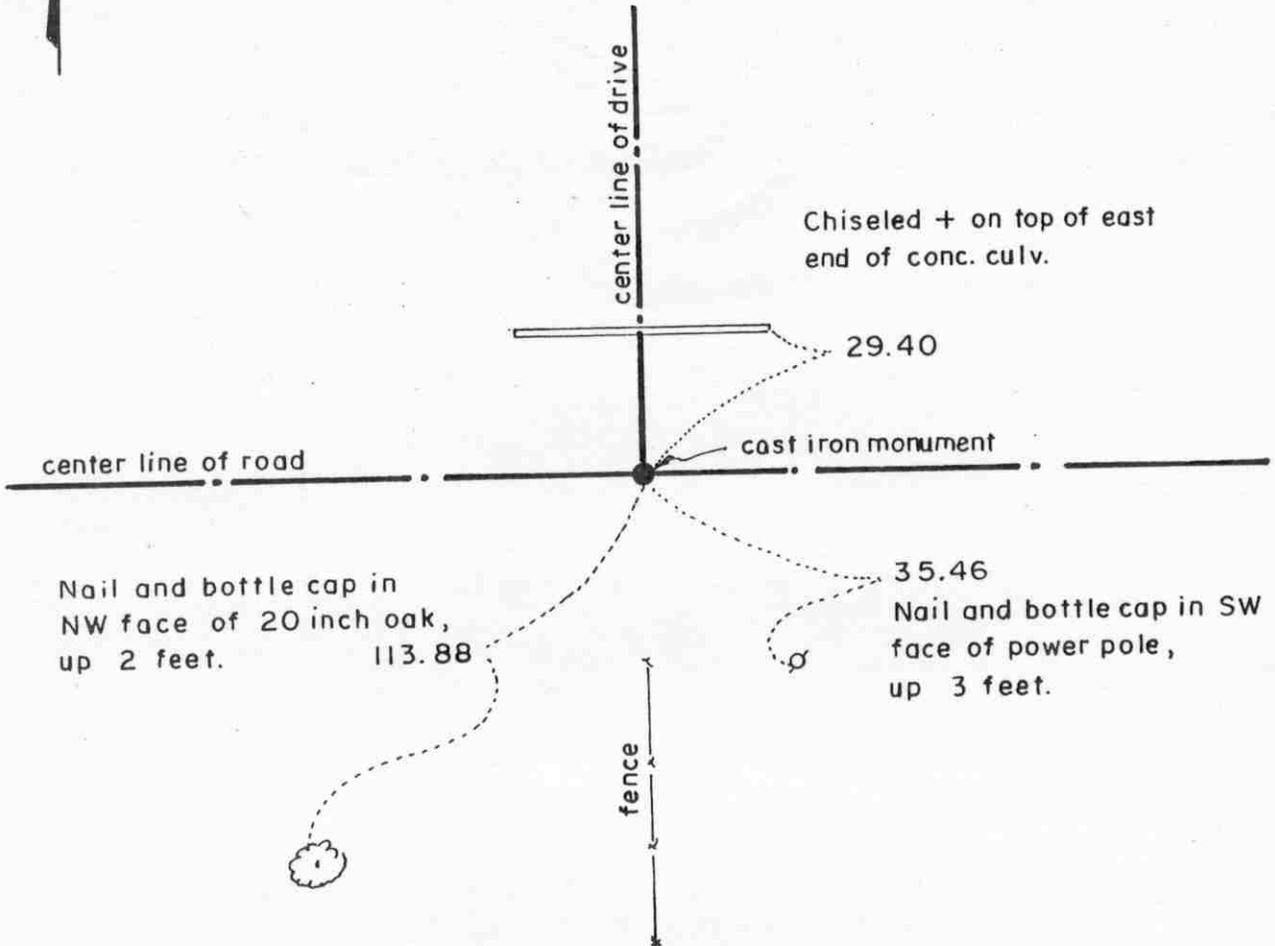

SECTION 16

Statement of evidence relative to this corner location on sheet 2

I hereby certify that this document was prepared by me or under my direct supervision.

Willard Pellinen  
 Willard Pellinen  
 McLeod County Surveyor  
 License No. 9626.

Date Jan 4, 1995

OFFICE OF THE COUNTY RECORDER  
 MCLEOD COUNTY, MINNESOTA

I hereby certify that this document was filed in this office at   9   o'clock   A   M. on the   10th   day of   January   19   95  .

Carmen Estlie Mulder, County Recorder

By \_\_\_\_\_, Deputy.

Document No.   263633

## **Certificate of Location of Government Corner**

**North Quarter Corner, Section 16, Township 116 North, Range 27 West**

**November, 1856.** *E. N. Darling of the General Land Office established this corner. He set a post, and marked an 8 inch oak and a 16 inch linden for bearing trees.*

**February, 1982.** *We measured the north line of Section 16 and set a temporary quarter corner on the center line of the east-west road in line with a fence to the south.*

**July 27, 1982.** *We excavated for the corner, John Tupa from Hutchinson with a backhoe. (1899 survey shows a stone at this corner) We found a stone about 1 foot down below the surface of the road. We tied it off and dug deeper and wider, but found nothing else.*

**July 16, 1982.** *Mr. Elmer Quast, 66 years old and had lived in the Southeast Quarter of Section 9 all his life didn't know of any corner but said the fence to the south is in the same place as an old fence used to be, and has been accepted by adjoining owners as being on the quarter line. Stephen Rasckes, in the Southwest Quarter of Section 9 for 13 years agrees.*

**August 20, 1982.** *We set a McLeod County cast iron monument at the location of the found stone. This was on the center line of the east-west road in line with the fence to the south. This is about 10 feet west and about 2 feet south of a lost position for the corner.*

**January 3, 1995.** *We checked the reference ties to the monument.*


# Certificate of Location of Government Corner

EAST QUARTER corner, Section 17, Township 116 North, Range 27 West

## SKETCH OF REFERENCE TIES (NO SCALE)



SECTION 17

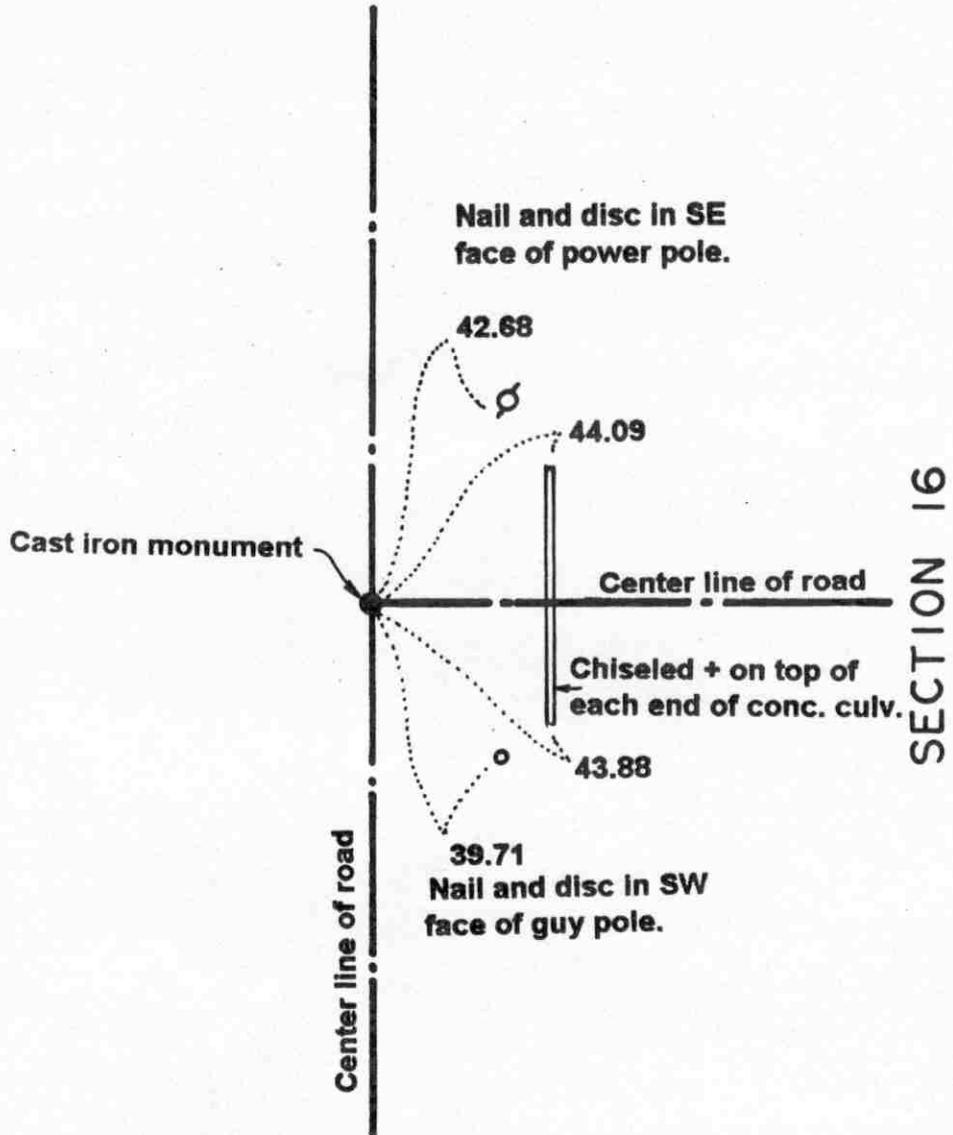

SECTION 16

### Statement of evidence relative to this corner location on sheet 2

I hereby certify that this document was prepared by me or under my direct supervision.

Willard Pellinen  
Willard Pellinen  
McLeod County Surveyor  
License No. 9626.

Date Oct. 9, 1995

### OFFICE OF THE COUNTY RECORDER MCLEOD COUNTY, MINNESOTA

I hereby certify that this document was filed in this office at 9 o'clock A. M. on the 13th day of October 19 95.

Carmen Ostlund-Julder, County Recorder

By \_\_\_\_\_, Deputy.

Document No. 268592

# Certificate of Location of Government Corner

EAST QUARTER corner, Section 17, Township 116 North, Range 27 West

November, 1856. E. N. Darling of the General Land Office set a post and marked 2 oaks for bearing trees.

November 19, 1973. Dickman Knutson, county surveyor, set a PK nail at the center line intersection of road north, south and east and a fence to the west.

1974. Knutson found an iron pin at the corner, below the nail set in 1973.

September 4, 1975. Knutson replaced the iron pin with a McLeod County cast iron monument and took available reference ties.

State Highway No. 261 right of way plans show a distance of 2646.5 feet to the southeast corner of Section 17. We measured 2649.69 feet; Highway distance to the northeast corner was 2645.6. We measured 2645.49 feet.


The monument set by Knutson is accepted as marking the location of the quarter corner. It fits long standing occupation lines and it fits the distances by the State Highway Department. It perpetuates the location of an older monument.

***May 15, 1995. We checked the reference ties to the monument.***

# Certificate of Location of Government Corner

NORTHEAST corner, Section 17, Township 116 North, Range 27 West

SKETCH OF REFERENCE TIES (NO SCALE)

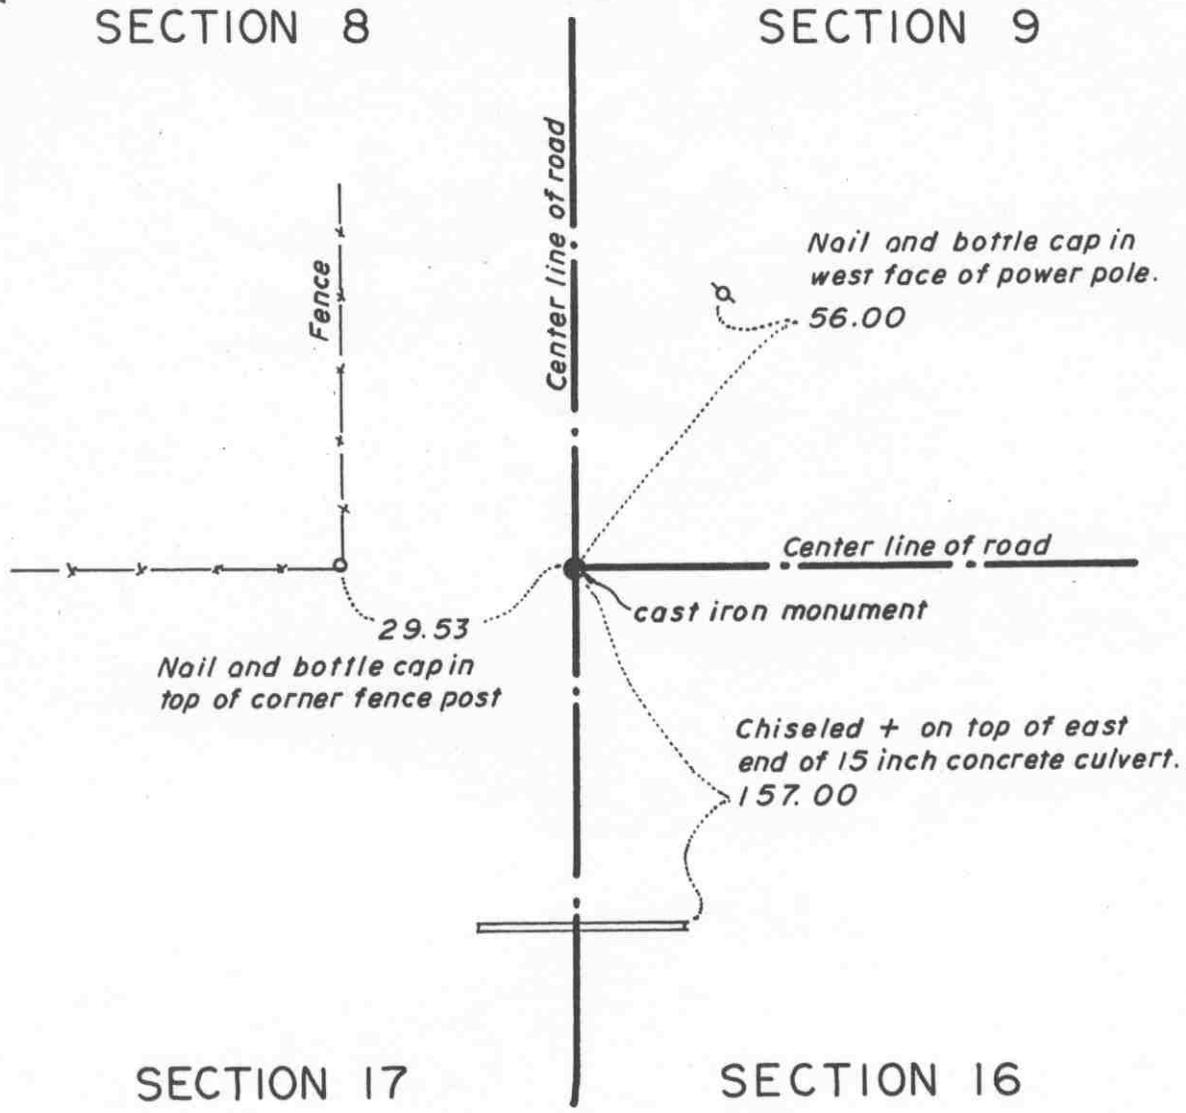

Statement of evidence relative to this corner location on sheet 2

I hereby certify that this document was prepared by me or under my direct supervision.

Willard Pellinen  
 Willard Pellinen  
 McLeod County Surveyor  
 License No. 9626.

Date Feb. 4, 1995

OFFICE OF THE COUNTY RECORDER  
 MCLEOD COUNTY, MINNESOTA

I hereby certify that this document was filed in this office at 9 o'clock A. M. on the 6th day of February, 19 95.

Carmen Odette Muller, County Recorder

By \_\_\_\_\_, Deputy.

Document No. 264032

## ***Certificate of Location of Government Corner***

***Northeast Corner, Section 17, Township 116 North, Range 27 West***

***November, 1856. E. N. Darling of the General Land Office established this corner. He set a post, and marked 2 oaks, an elm and a linden for bearing trees.***

***June 14, 1979. Dickman Knutson, county surveyor, replaced an iron pin which had been used by the State Highway Department as the corner, with a McLeod County cast iron monument and took reference ties.***

***January 11, 1995. We found the monument in good condition down 4 inches below the surface of the road and took new reference ties.***


NORTH QUARTER corner, Section 17, Township 116 North, Range 27 West

# Certificate of Location of Government Corner

## SKETCH OF REFERENCE TIES (NO SCALE)



SECTION 8

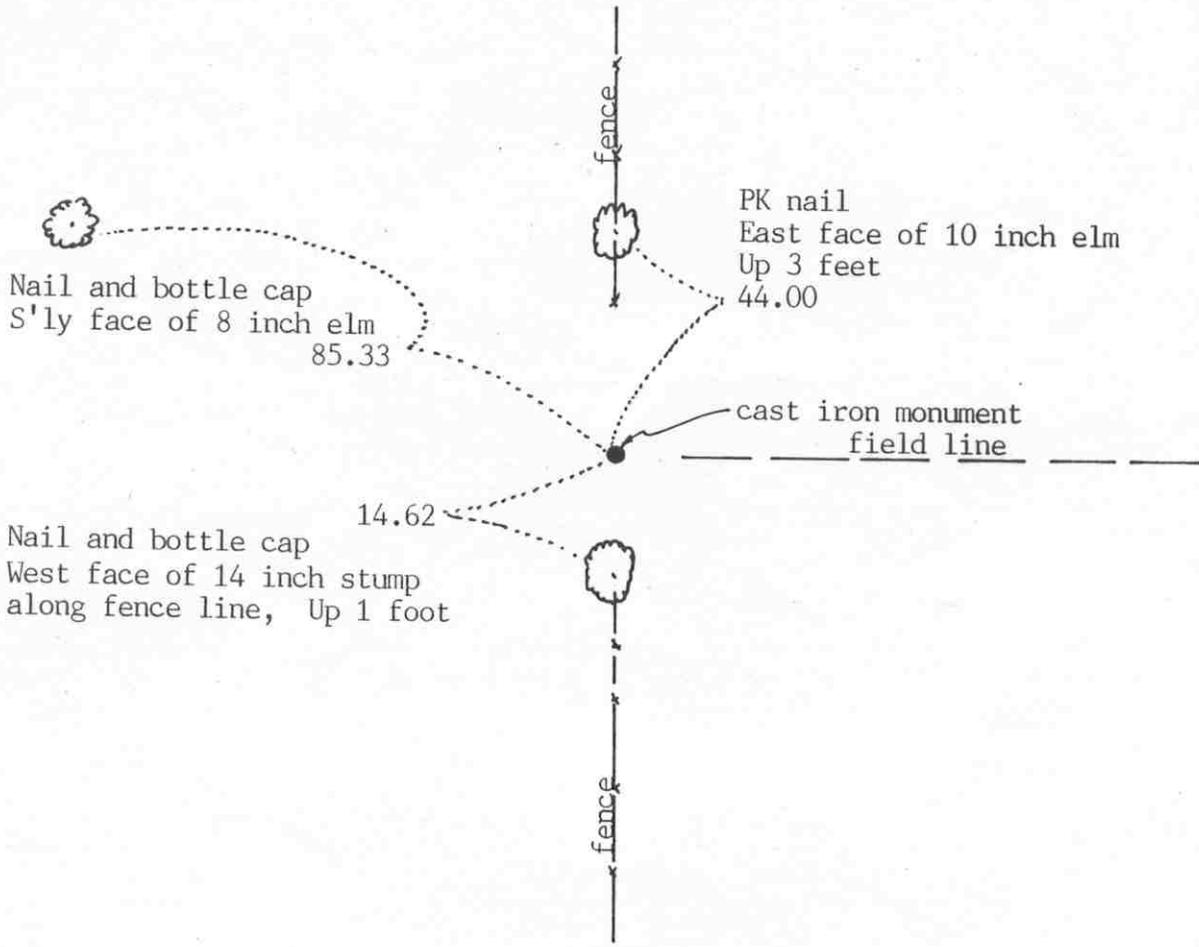

SECTION 17

Statement of evidence relative to this corner location on sheet 2

I hereby certify that this document was prepared by me or under my direct supervision.

Willard Pellinen  
 Willard Pellinen  
 McLeod County Surveyor  
 License No. 9626  
 Date 1/14, 91

OFFICE OF THE COUNTY RECORDER  
MCLEOD COUNTY, MINNESOTA.

I hereby certify that this document was filed in this office at 9 o'clock A. M. on the 22nd day of Jan, 19 91.

Carmen Ostlie, County Recorder  
 By \_\_\_\_\_, Deputy

Document No. 237193

## *Certificate of Location of Government Corner*

November, 1856. This corner was originally set by E.N. Darling of the General Land Office. He set a post and marked 2 bur oaks for bearing trees.

November 19, 1973. McCombs Knutson Associates (Dickman Knutson, county surveyor) set a 1 inch diameter iron pin at the fence intersection, fences north, south and east. These were old fences and according to Harvey Adams, 62 years old and Earl Ehrke, 46 years old, adjoining land owners, this intersection is the quarter corner.

August 15, 1974. Knutson replaced the iron pin with a McLeod County cast iron monument.


December 6, 1989. We found the monument had been removed due to tree removal in the area. All the reference ties had also been destroyed. We had done some surveys in the Northwest Quarter of Section 17, using the quarter corner, so we reset a cast iron monument using measurements from these surveys. We took new reference ties.

We accept the old fence intersection as having perpetuated the correct location of the quarter corner.

# Certificate of Location of Government Corner

East Quarter corner, Section 18, Township 116 North, Range 27 West

SKETCH OF REFERENCE TIES (NO SCALE)

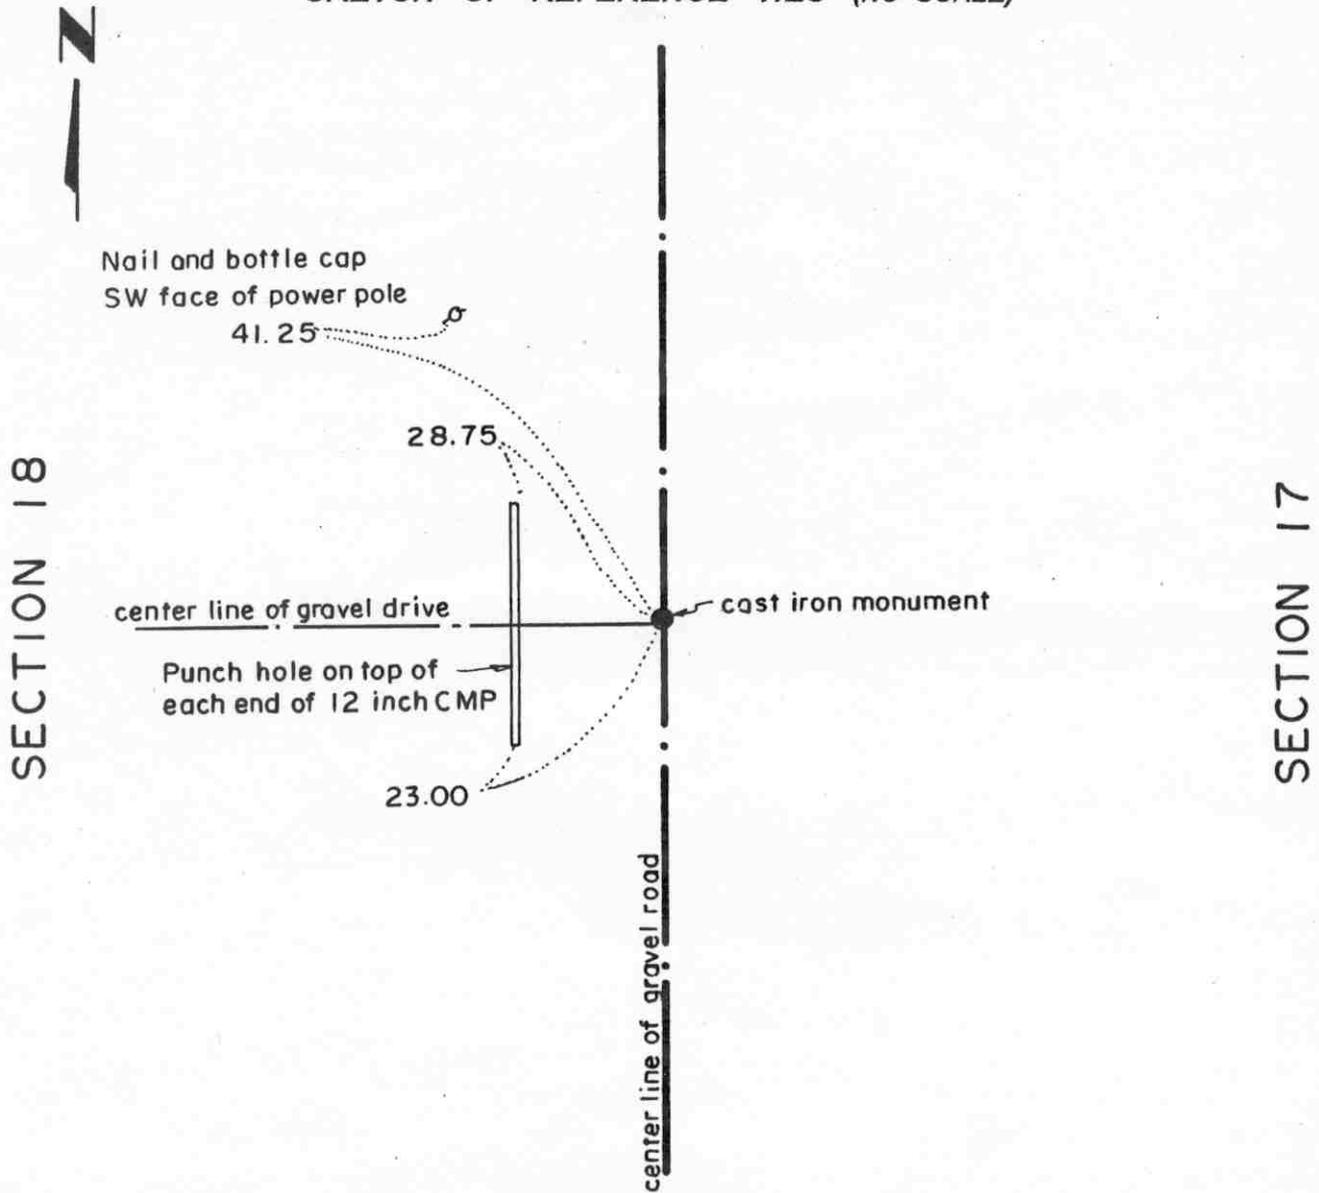

Statement of evidence relative to this corner location on sheet 2

I hereby certify that this document was prepared by me or under my direct supervision.

Willard Pellinen

Willard Pellinen  
McLeod County Surveyor  
License No. 9626.

Date Sept. 12, 1994

OFFICE OF THE COUNTY RECORDER  
MCLEOD COUNTY, MINNESOTA

I hereby certify that this document was filed in this office at 9 o'clock A. M. on the 22nd day of September 19 94.

Carmen Stlie Mulder, County Recorder

By \_\_\_\_\_, Deputy.

Document No. 261937

## **Certificate of Location of Government Corner**

### **East Quarter Corner, Section 18, Township 116 North, Range 27 West**

**November, 1856.** *E. N. Darling of the General Land Office originally established this corner. He set a post and marked a 24 inch linden and a 20 inch oak for bearing trees.*

**November, 1973.** *Dickman Knutson, county surveyor, measured the east line of Section 18 and set a temporary east quarter corner on the center line of the north-south road and the center line of a gravel drive to the west. Earl Ehrke, in the Northwest Quarter of Section 17, said there used to be fence running east from this location.*

**July, 1973.** *Knutson excavated for the corner, John Tupa from Hutchinson with a backhoe. They found a stone and a wood stake down in the original ground. They took reference ties. Mr. Harold Herrmann, who used to own the Southwest Quarter of the Northwest Quarter of Section 17 said this was the correct location of the corner.*

**November 7, 1974.** *Knutson set a McLeod County cast iron monument at the corner.*


*This corner is 7 1/2 feet east and 22.4 feet south of a lost position for the corner.*

**August 26, 1994.** *We found the monument in good condition and checked the reference ties.*

# Certificate of Location of Government Corner

Northeast            corner, Section   18  , Township   116   North, Range   27   West

SKETCH OF REFERENCE TIES (NO SCALE)

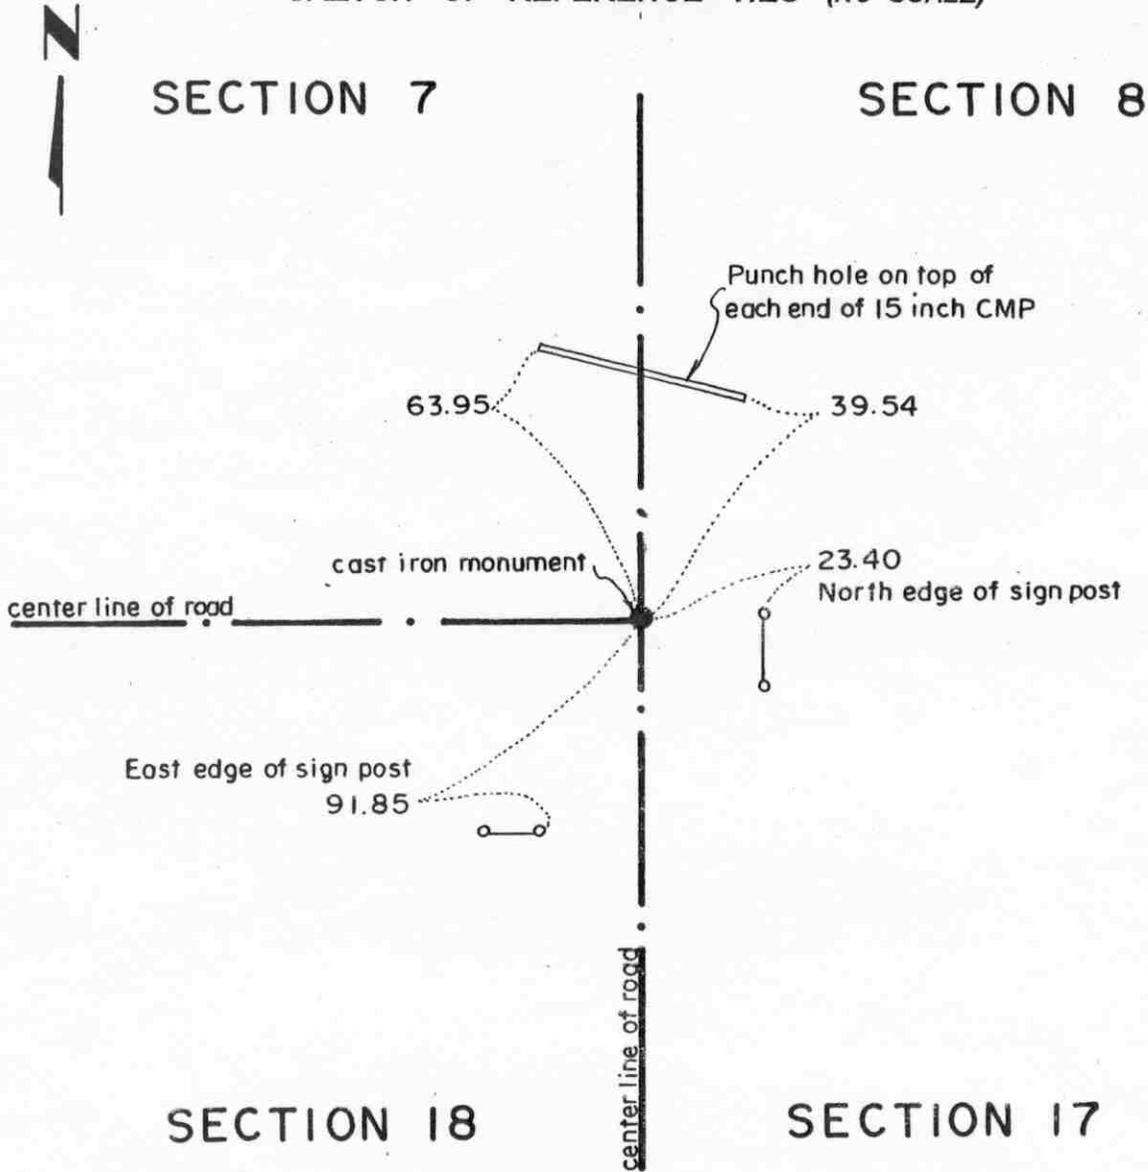

Statement of evidence relative to this corner location on sheet 2

I hereby certify that this document was prepared by me or under my direct supervision.

Willard Pellinen  
Willard Pellinen  
McLeod County Surveyor  
License No. 9626.

Date Sept. 22, 1994.

OFFICE OF THE COUNTY RECORDER  
MCLEOD COUNTY, MINNESOTA

I hereby certify that this document was filed in this office at 9 o'clock A. M. on the 10th day of January, 19 95.

Carmen Helie Mulder, County Recorder

By \_\_\_\_\_, Deputy.

Document No. 263634

## **Certificate of Location of Government Corner**

**Northeast Corner, Section 18, Township 116 North, Range 27 West**

**November, 1856. E. N. Darling of the General Land Office established this corner. He set a post and marked 4 aspens for bearing trees.**

**November 19, 1973. Dickman Knutson, county surveyor, set a temporary section corner at the center line intersection of roads north, south and west. Harold Herrmann, 64 years old and had lived in the Southeast Quarter of Section 7 all his life, said his father told him there was an iron monument at the intersection, but it would now be about 6 feet deep.**

**1974. Knutson dug for the corner, John Tupa from Hutchinson with a backhoe. They found an iron stake down 5-6 feet below the road surface.**


**November 7, 1974. Knutson set a McLeod County cast iron monument.**

**August 26, 1994. We found the bottom portion of the monument down 8 inches below the surface of the road, top of monument broken off. We took new reference ties.**

# Certificate of Location of Government Corner

North Quarter corner, Section 18, Township 116 North, Range 27 West

SKETCH OF REFERENCE TIES (NO SCALE)

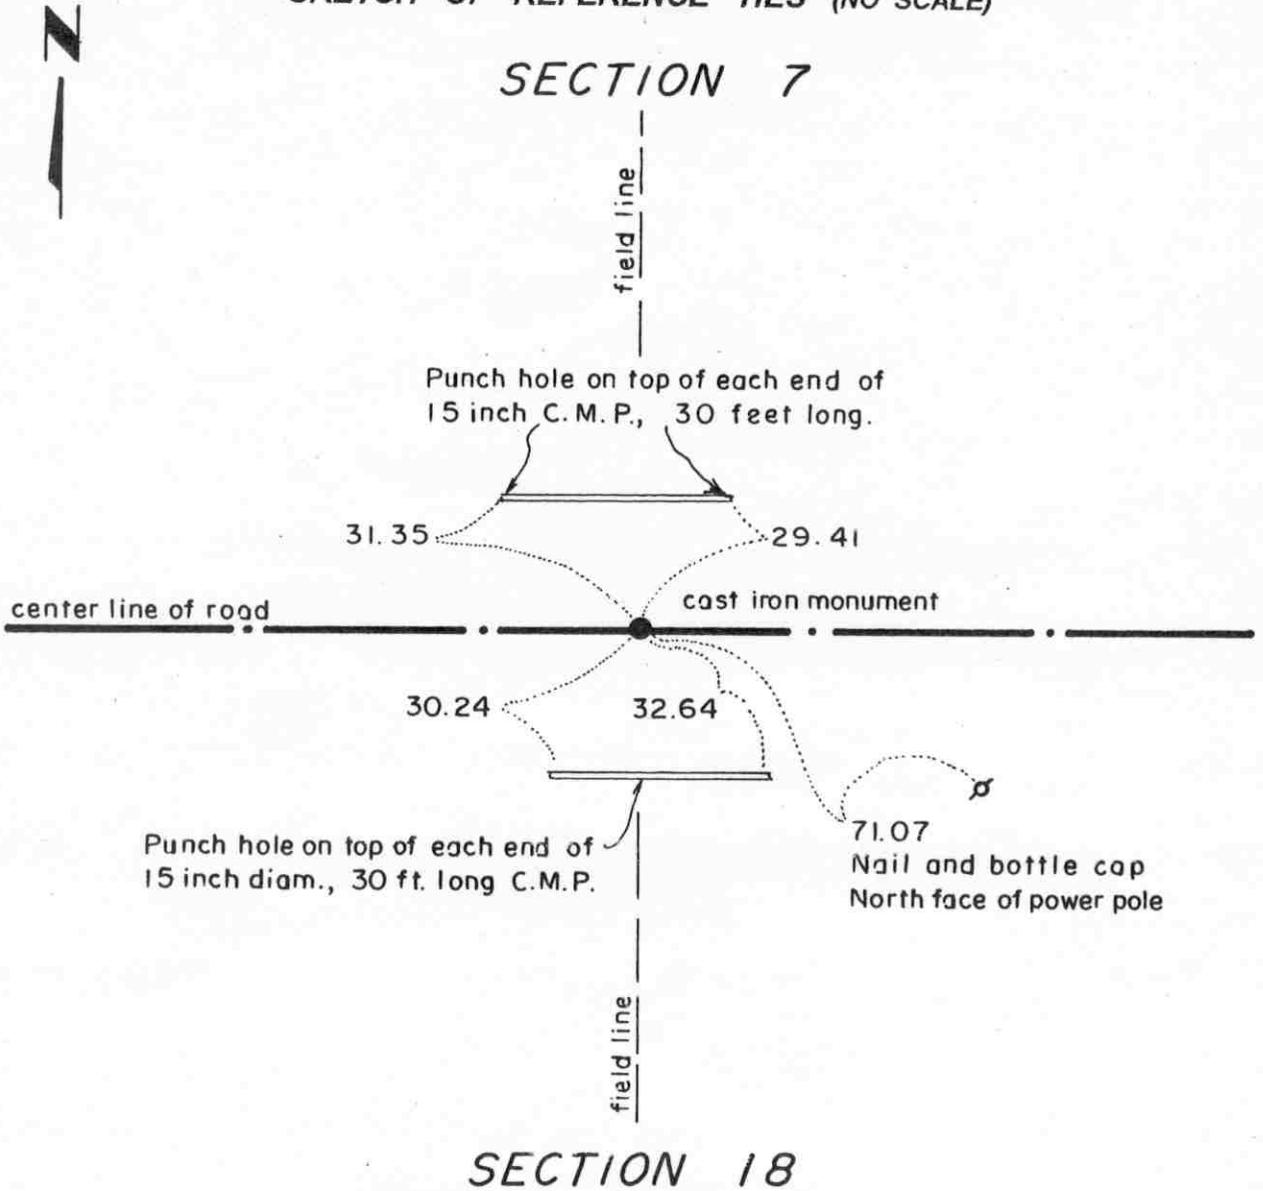

Statement of evidence relative to this corner location on sheet 2

I hereby certify that this document was prepared by me or under my direct supervision.

*Willard Pellinen*

Willard Pellinen  
McLeod County Surveyor  
License No. 9626.

Date Sept. 6, 1994

OFFICE OF THE COUNTY RECORDER  
MCLEOD COUNTY, MINNESOTA

I hereby certify that this document was filed in this office at 9 o'clock A. M. on the 22nd day of September 19 94.

*Carmen Ottilie Mulder*, County Recorder

By \_\_\_\_\_, Deputy.

Document No. 261938

## **Certificate of Location of Government Corner**

**NORTH Quarter Corner, Section 18, Township 116 North, Range 27 West**

**November, 1856.** *E. N. Darling of the General Land Office originally established this corner. He set a post and marked 2 five inch aspens for bearing trees.*

**January 30, 1979.** *We measured the north line of Section 18 and set a temporary quarter corner on the center line of the east-west road in line with a fence to the north and a field line to the south.*

**February 3, 1981.** *Richard Dolezal, 38 years old and had lived in the Northeast Quarter of Section 18 for 10 years, said that when he bought the place, he was told the field line running south was on the north-south quarter line of Section 18.*

**Lillian Tucholke, in the Northwest Quarter of Section for 38 years said her husband said the field line is the quarter line.**

**Harold Inselmann, 66 years old, bought the farm in the Southwest Quarter of Section 7 in 1967, said the fence running north is the north-south quarter line of Section 7.**

**Maynard Zebell, 52 years old, said the fence running north is the quarter line.**

**June, 1981.** *We dug for the corner, John Tupa from Hutchinson with a backhoe. We found no evidence of the government corner.*

**May 26, 1982.** *We set a McLeod County cast iron monument on the center line of the east-west road in line with the fence to the north and field line to the south, and took available reference ties.*


**This monument falls 21.64 feet east and 5.14 feet north of a lost position for the corner.**

**August 26, 1994.** *We found the monument in good condition and checked the reference ties.*

NORTHEAST corner, Section 13, Township 116 North, Range 28 West

# Certificate of Location of Government Corner

SKETCH OF REFERENCE TIES  
(NO SCALE)

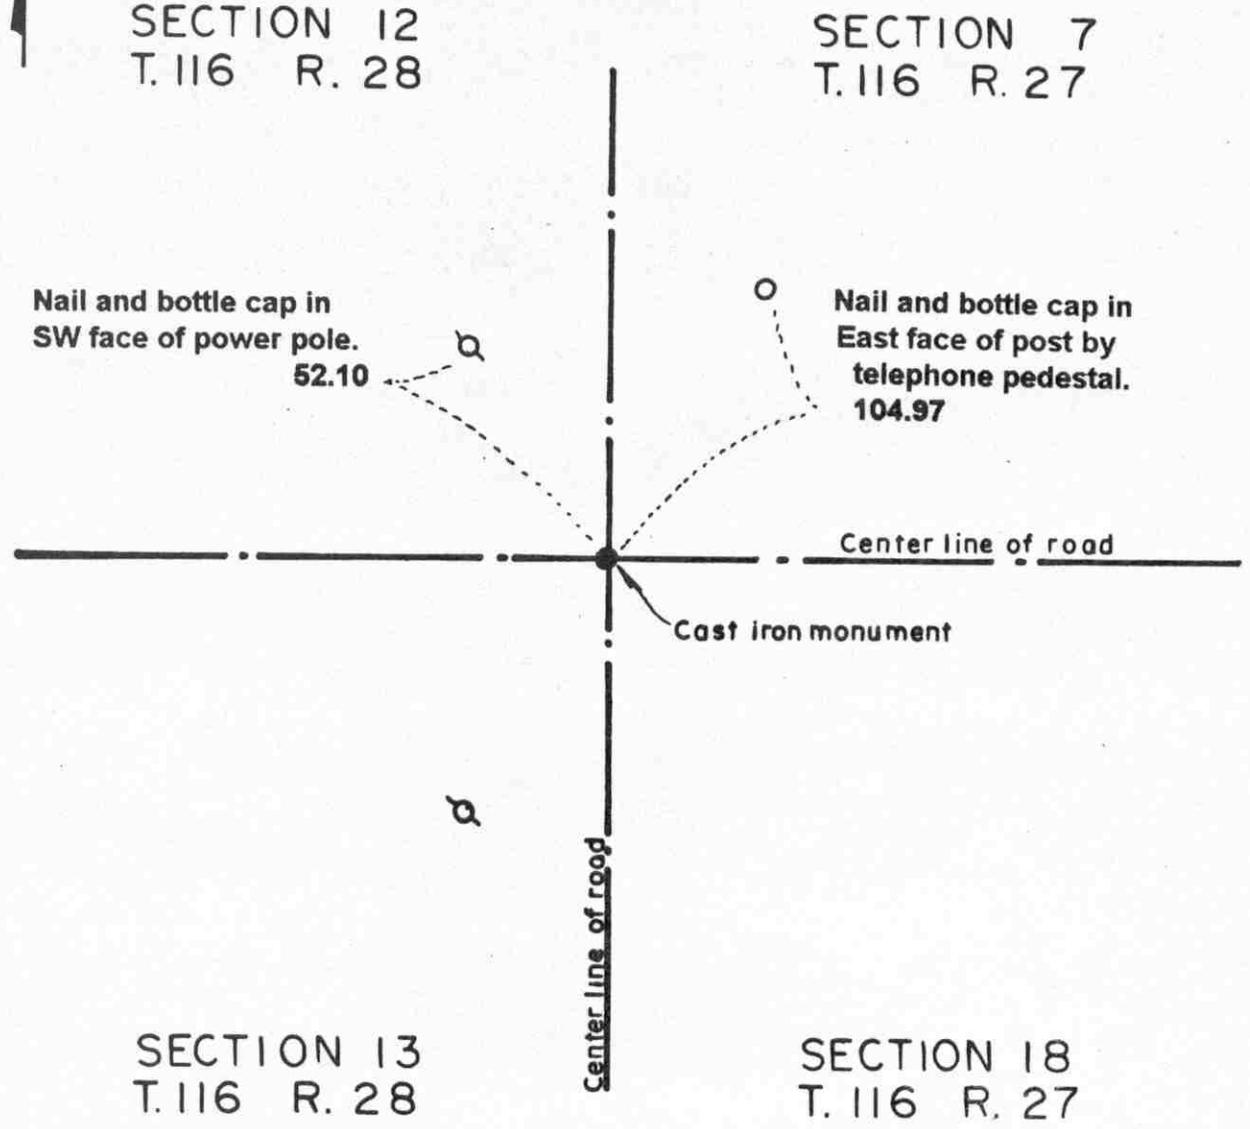

Statement of evidence relative to this corner location on sheet 2

I hereby certify that this document was prepared by me or under my direct supervision.

Willard Pellinen  
Willard Pellinen  
McLeod County Surveyor  
License No. 9626

Date Oct. 9, 1995

OFFICE OF THE COUNTY RECORDER  
MCLEOD COUNTY, MINNESOTA.

I hereby certify that this document was filed in this office at 9 o'clock A.M. on the 13th day of October, 1995.

Carmen Ostlie Gulder, County Recorder

By \_\_\_\_\_, Deputy

Document No. 268598

NORTHEAST corner, Section 13, Township 116 North, Range 28 West

## *Certificate of Location of Government Corner*

1855. John Ryan of the General Land Office established this corner. He set a post and marked 3 elms and an aspen for bearing trees.

1969. Dickman Knutson, county surveyor, dug and found a stone at the center line intersection of the roads. He set a McLeod County cast iron monument and took available reference ties.

February 17, 1981. We found the monument in good condition.

April 11, 1987. We found the monument in good condition and took new reference ties.

The monument set by Knutson is accepted as marking the correct location of the section corner. It fits long standing occupation lines, the road center lines.


***May 15, 1995. We checked the reference ties to the monument.***

EAST QUARTER corner, Section 13, Township 116 North, Range 28 West

# Certificate of Location of Government Corner

## SKETCH OF REFERENCE TIES

(NO SCALE)

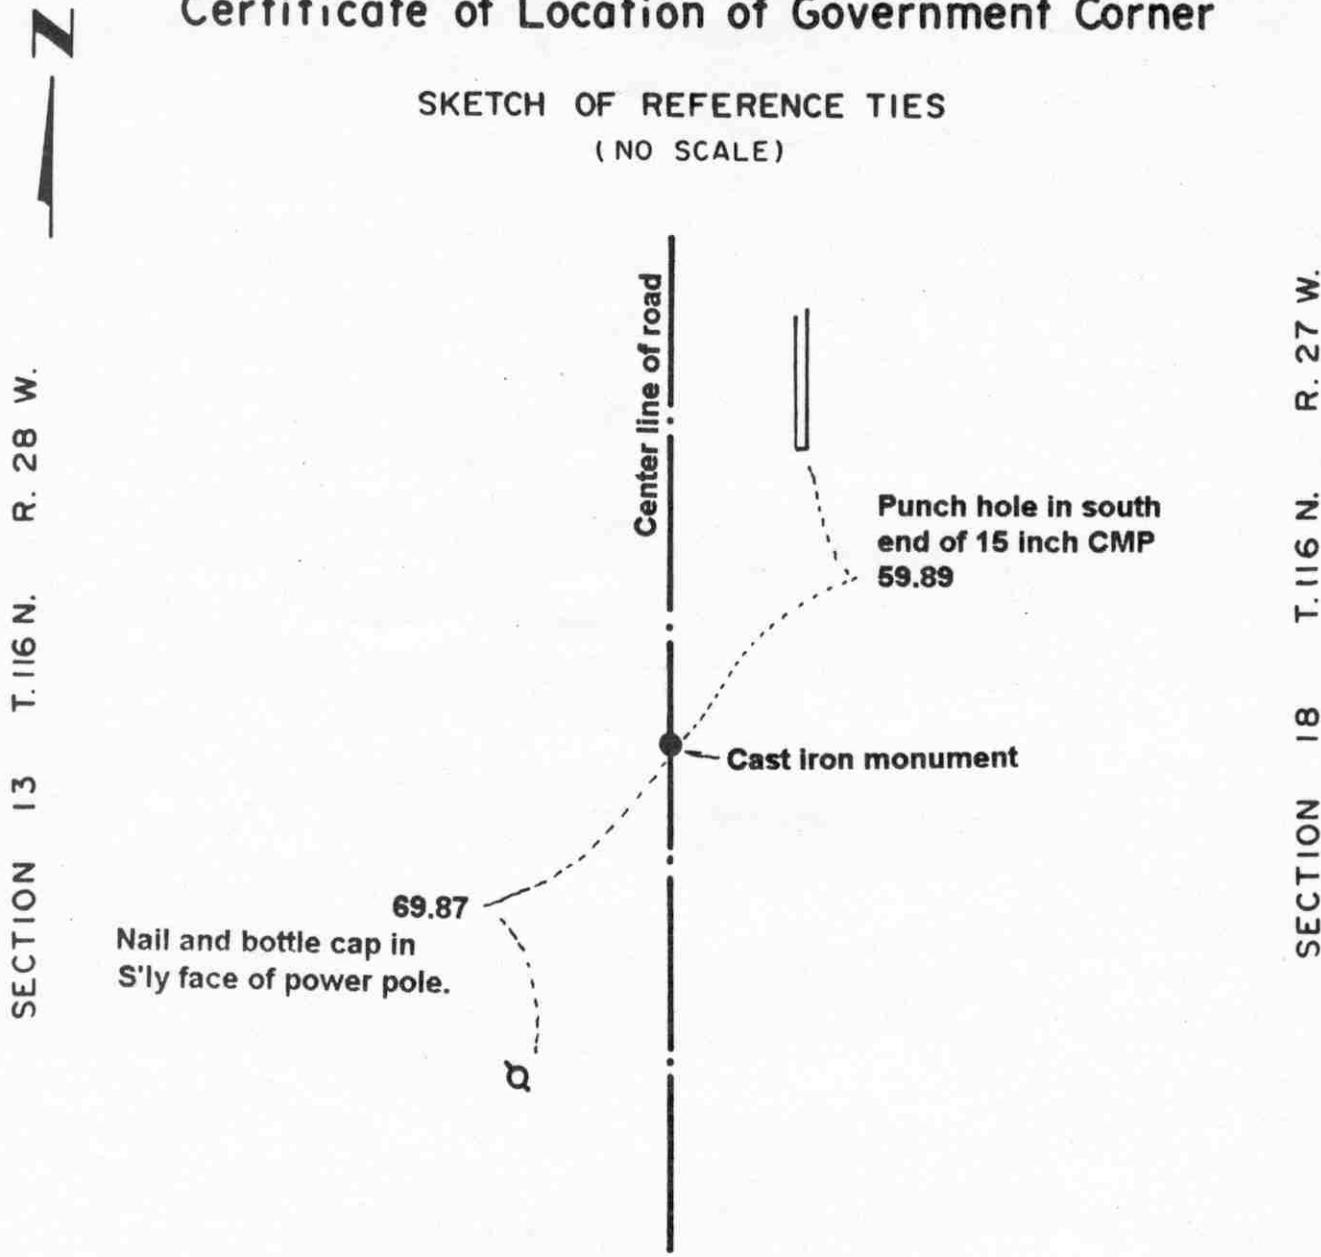

Statement of evidence relative to this corner location on sheet 2

I hereby certify that this document was prepared by me or under my direct supervision.

Willard Pellinen  
Willard Pellinen  
McLeod County Surveyor  
License No. 9626

Date Oct. 9, 1995

OFFICE OF THE COUNTY RECORDER  
MCLEOD COUNTY, MINNESOTA.

I hereby certify that this document was filed in this office at 9 o'clock A. M. on the 13th day of October, 19 95.

Norman Austin Guldner, County Recorder

By \_\_\_\_\_, Deputy

Document No. 268599

EAST QUARTER            corner, Section 13, Township 116 North, Range 28 West

## Certificate of Location of Government Corner

1855. John Ryan of the General Land Office established this corner. He set a post and marked 2 cherry trees for bearing trees.

1968. Dickman Knutson, county surveyor, measured the east line and set a temporary quarter corner on the center line of the north-south road, half way between the section corners.

1969. Knutson dug for the corner, John Tupa from Hutchinson with a backhoe. They found a stone and wood stake very close to to temporary corner. Knutson set a McLeod County cast iron monument.

February 17, 1981. We found the monument in good condition.

July 23, 1987. No reference ties remaining for the corner. We found the monument down 4 inches below the surface of the bituminous road and took new available ties.


The monument set by Knutson is accepted as marking the correct location of the quarter corner. It fits long standing occupation lines, the center line of the road and it perpetuates the location of an older monument.

*June, 1994. We checked the reference ties.*

# Certificate of Location of Government Corner

East Quarter corner, Section 19, Township 116 North, Range 27 West

SKETCH OF REFERENCE TIES (NO SCALE)

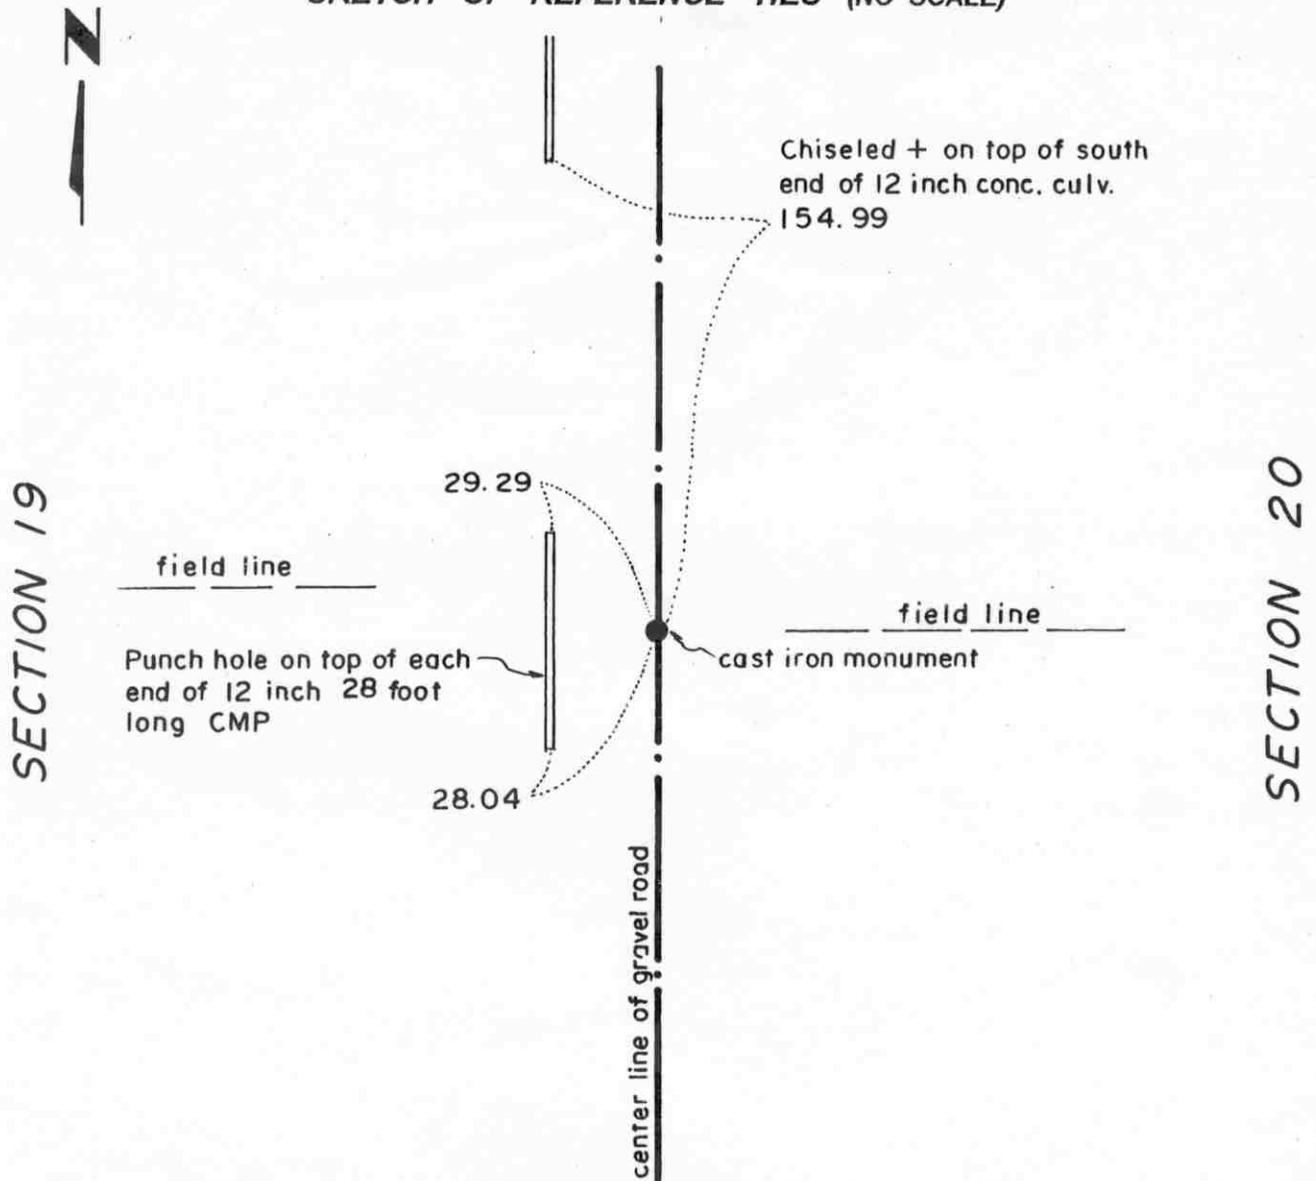

**Statement of evidence relative to this corner location on sheet 2**

I hereby certify that this document was prepared by me or under my direct supervision.

Willard Pellinen  
 Willard Pellinen  
 McLeod County Surveyor  
 License No. 9626.

Date Sept. 13, 1994

**OFFICE OF THE COUNTY RECORDER  
 MCLEOD COUNTY, MINNESOTA**

I hereby certify that this document was filed in this office at 9 o'clock A. M. on the 22nd day of September 19 94.

Carmen Ottilie Mulder, County Recorder

By \_\_\_\_\_, Deputy.

Document No. 261939

## **Certificate of Location of Government Corner**

### **East Quarter Corner, Section 19, Township 116 North, Range 27 West**

**November, 1856.** *E. N. Darling of the General Land Office originally established this corner. He set a post and marked a 6 inch walnut and a 16 inch linden for bearing trees.*

**January, 1979.** *We measured the east line of Section 19 and set a temporary east quarter corner on the center line of the north-south road in line with a field line to the west.*

**July 16, 1982.** *Mr. Ted Dammann, 76 year old and who had lived in the West Half of Section 20 since 1931 said he thinks the field line running west is on the quarter line. He said there is something in the road marking the corner.*

**July 26, 1982.** *We dug for the corner, John Tupa from Hutchinson with a backhoe. We dug a hole about 15 feet long and 5 to 6 feet wide along the center line of the road. About 8 feet south of our temporary corner we found a 1 inch diameter iron pin. This is in line with a field line to the east.*

**August 25, 1982.** *We set a McLeod County cast iron monument and took ties. This corner is 11.57 feet north and 4.5 feet east of a lost position for the corner.*

NORTHEAST corner, Section 19, Township 116 North, Range 27 West


# Certificate of Location of Government Corner

SKETCH OF REFERENCE TIES  
(NO SCALE)



SECTION 18

SECTION 17

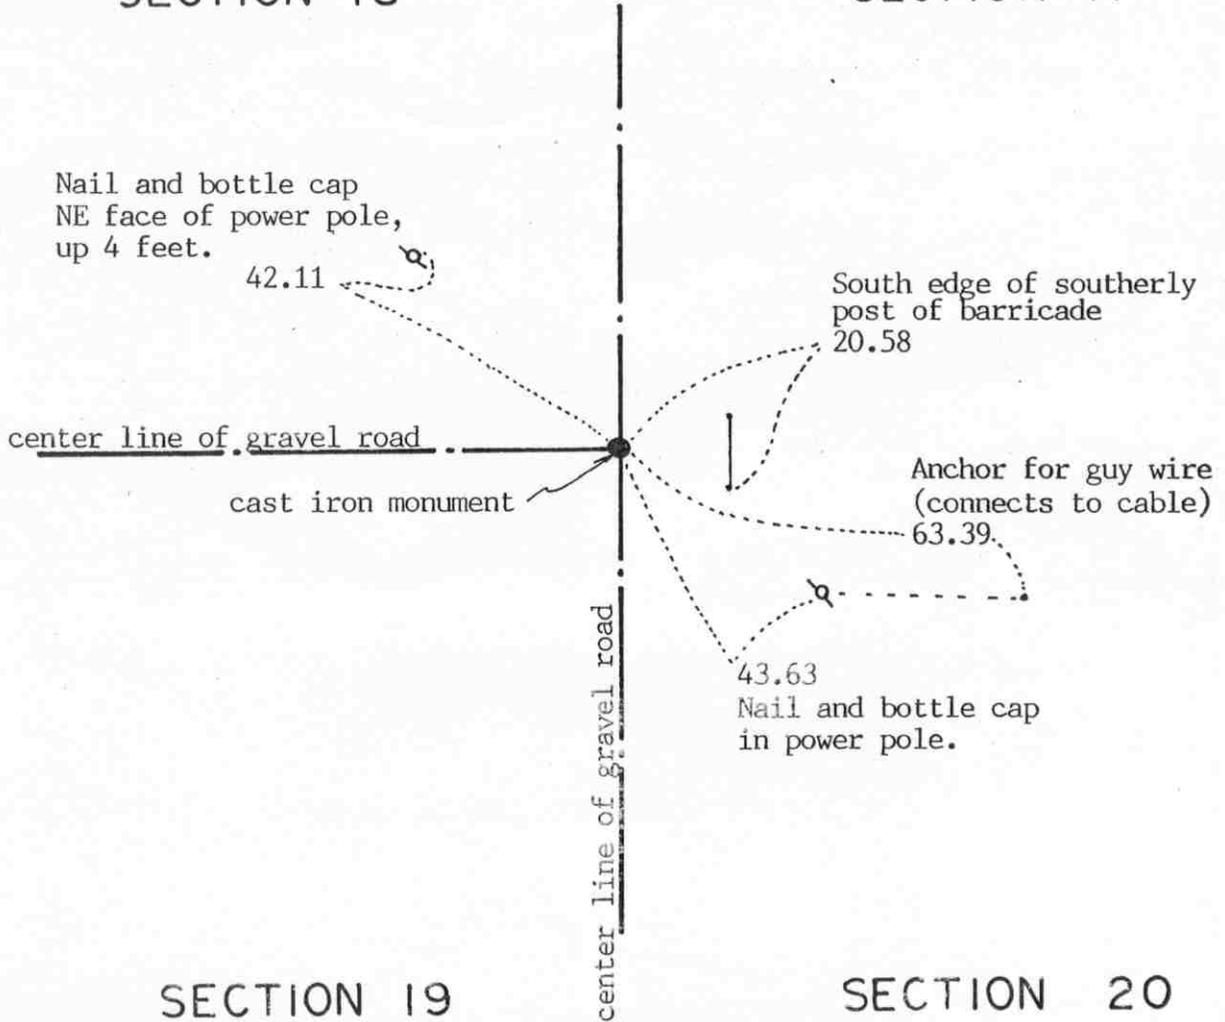

SECTION 19

SECTION 20

Statement of evidence relative to this corner location on sheet 2

I hereby certify that this document was prepared by me or under my direct supervision.

Willard Pellinen  
Willard Pellinen  
McLeod County Surveyor  
License No. 9626

Date April 12, 1994

OFFICE OF THE COUNTY RECORDER  
MCLEOD COUNTY, MINNESOTA.

I hereby certify that this document was filed in this office at 9 o'clock A. M. on the 20th day of April, 1994.

Carmin Ottilie Mulder, County Recorder

By \_\_\_\_\_, Deputy

Document No. 259048

## *Certificate of Location of Government Corner*

November, 1856. E. N. Darling of the General Land Office established this corner. He set a post and marked 3 oaks and an elm for bearing trees.

July 26, 1982. We dug for the corner, John Tupa from Hutchinson, with a backhoe. We dug a hole 10 feet by 8 feet by 6 feet deep but found no evidence of the government corner.

Adjoining land owners have always accepted the center line intersection of the roads as being the section corner.

August 20, 1982. We set a McLeod County cast iron monument at the center line intersection of roads north-south-west and took available reference ties.


January 21, 1994. We found the monument in good condition and checked the reference ties.

# Certificate of Location of Government Corner

North Quarter corner, Section 19, Township 116 North, Range 27 West

SKETCH OF REFERENCE TIES (NO SCALE)

## SECTION 18

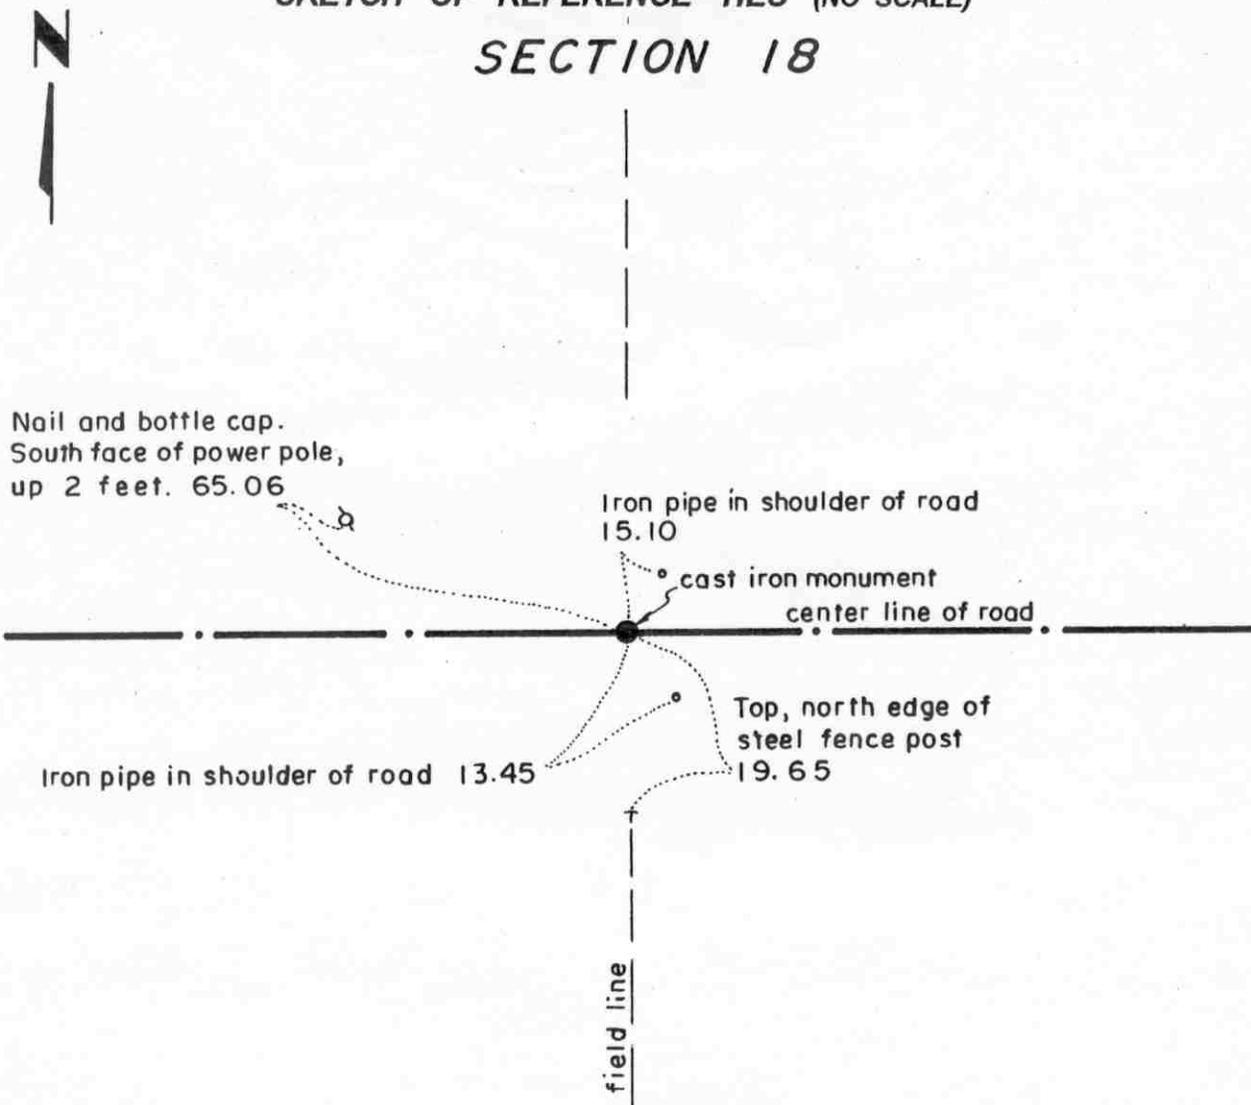

## SECTION 19

Statement of evidence relative to this corner location on sheet 2

I hereby certify that this document was prepared by me or under my direct supervision.

Willard Pellinen

Willard Pellinen  
McLeod County Surveyor  
License No. 9626.

Date Sept. 13, 1994

OFFICE OF THE COUNTY RECORDER  
MCLEOD COUNTY, MINNESOTA

I hereby certify that this document was filed in this office at 9 o'clock A. M. on the 22nd day of September 19 94.

Carmen Botlie Mulder, County Recorder

By \_\_\_\_\_, Deputy.

Document No. 261940

## ***Certificate of Location of Government Corner***

***North Quarter Corner, Section 19, Township 116 North, Range 27 West***

***November, 1856. E. N. Darling of the General Land Office originally established this corner. He set a post and marked a 10 inch oak and a 10 inch elm for bearing trees.***

***January 30, 1979. We measured the north line of Section 19 and set a temporary quarter corner in the center line of the east-west road in line with a field line to the south.***

***July 26, 1982. We excavated for the corner, John Tupa from Hutchinson with a backhoe. Down 4 feet below the surface of the gravel road we found a rotted wood stake. We tied off the wood stake. Found nothing else.***

***February 17, 1981. Mr Vernon Ide, 43, and owns the Northwest Quarter of Section 19 said the field line to the south is on the quarter line.***

***August 20, 1982. We set a McLeod County cast iron monument at the corner. This corner is approximately 10 feet west of a proration of the government distances between the section corners.***


NORTHEAST corner, Section 24, Township 116 North, Range 28 West

# Certificate of Location of Government Corner

SKETCH OF REFERENCE TIES  
(NO SCALE)

SECTION 13  
T. 116, R. 28

SECTION 18  
T. 116, R. 27

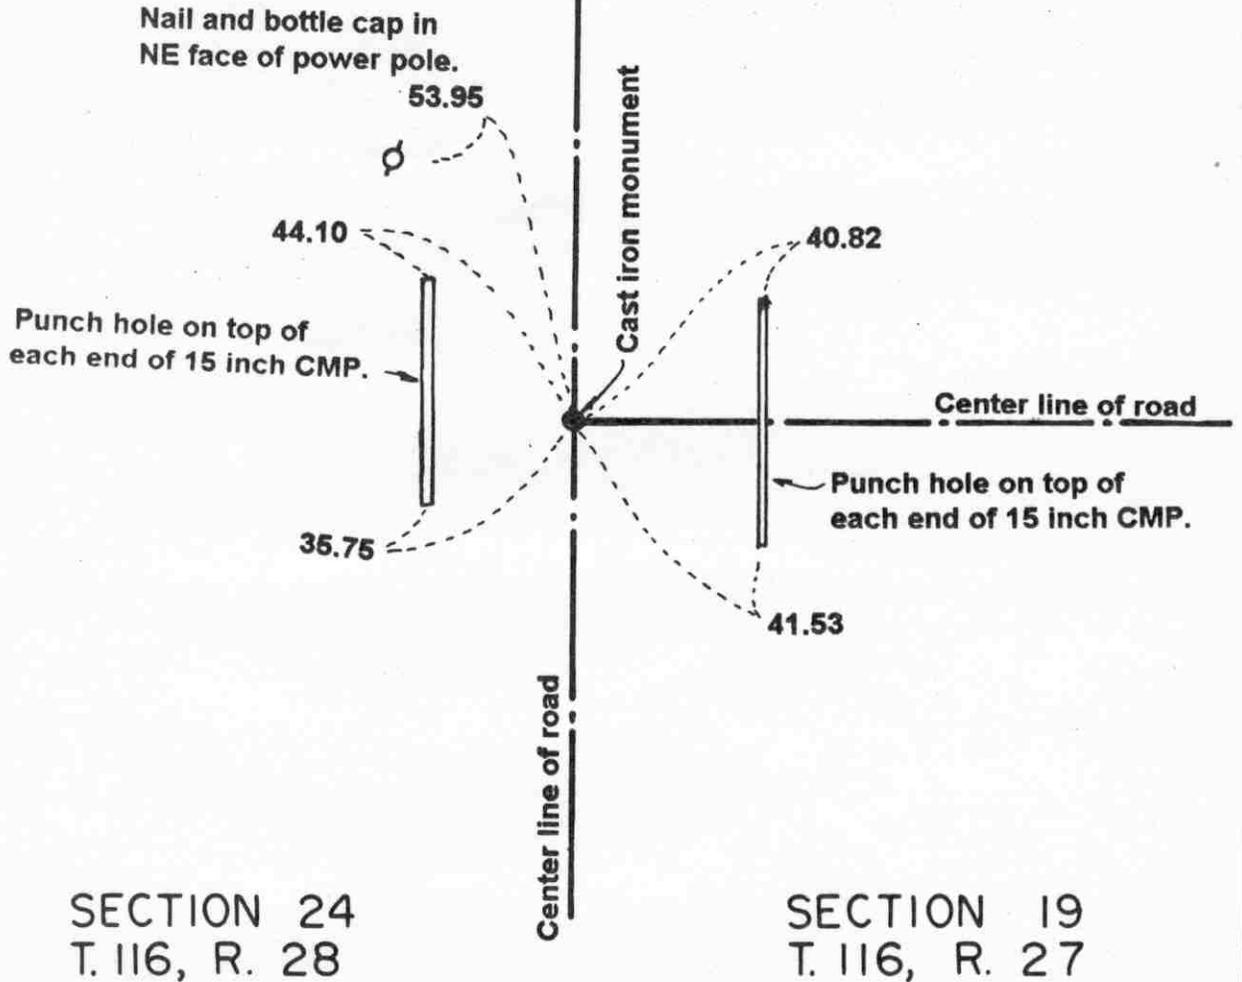

SECTION 24  
T. 116, R. 28

SECTION 19  
T. 116, R. 27

Statement of evidence relative to this corner location on sheet 2

I hereby certify that this document was prepared by me or under my direct supervision.

Willard Pellinen  
Willard Pellinen  
McLeod County Surveyor  
License No. 9626

Date Oct. 9, 1995

OFFICE OF THE COUNTY RECORDER  
MCLEOD COUNTY, MINNESOTA.

I hereby certify that this document was filed in this office at 9 o'clock A. M. on the 13th day of October, 1995.

Armenia Estlin Miller, County Recorder

By \_\_\_\_\_, Deputy

Document No. 268601

NORTHEAST \_\_\_\_\_ corner, Section 24, Township 116 North, Range 28 West

## *Certificate of Location of Government Corner*

1855. John Ryan of the General Land Office established this corner. He set a post and marked an oak, 2 elms and a linden for bearing trees.

County Highway Department field notes show an iron pin at the corner.

1969. Dickman Knutson, county surveyor, found an iron pin at the corner and replaced it with a McLeod County cast iron monument and took available reference ties.

July 23, 1987. All the reference ties had been destroyed. We found the monument in good condition and took new ties.

***June, 1994. We checked the reference ties.***

EAST QUARTER corner, Section 24, Township 116 North, Range 28 West


# Certificate of Location of Government Corner

## SKETCH OF REFERENCE TIES

(NO SCALE)

SECTION 24 T. 116, R. 28

SECTION 19 T. 116, R. 27

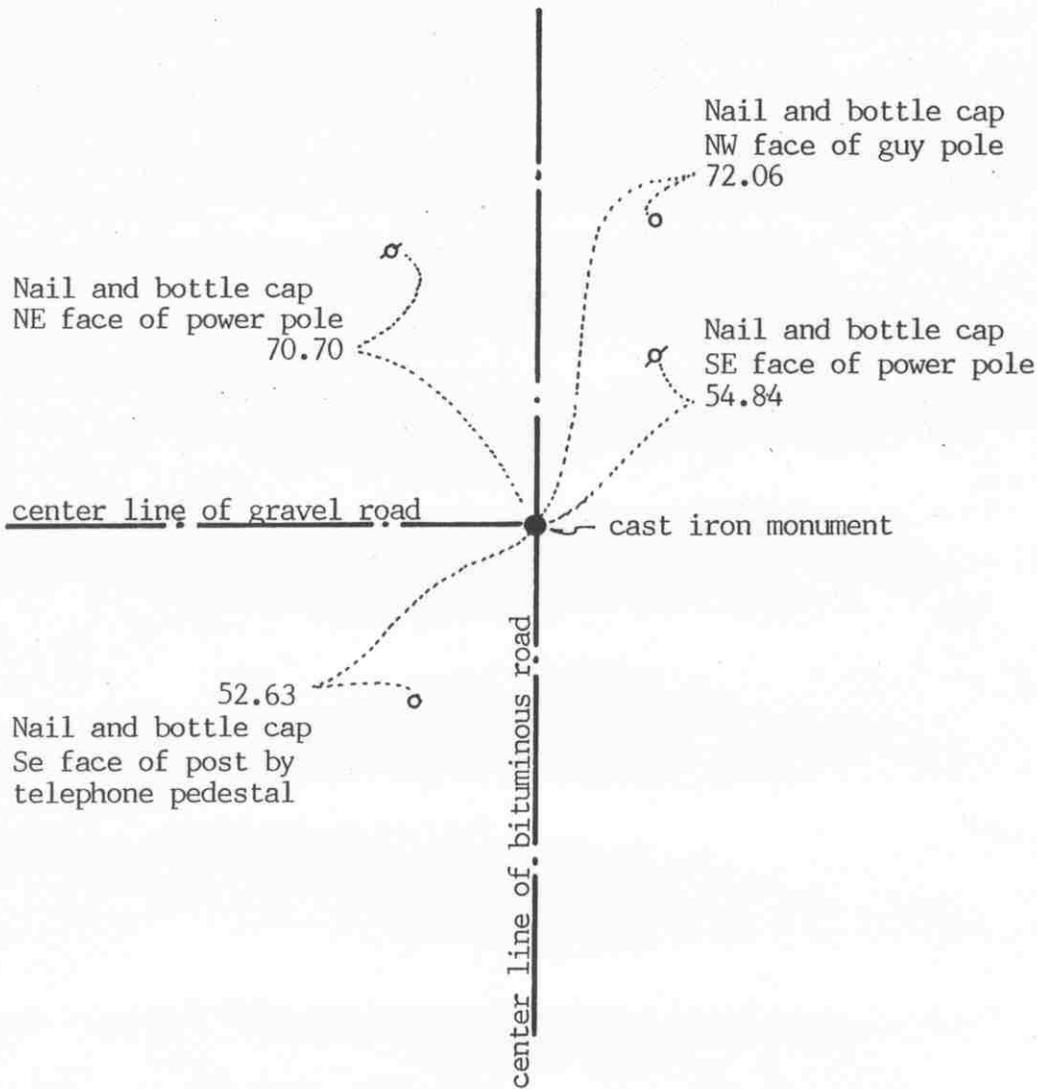

Statement of evidence relative to this corner location on sheet 2

I hereby certify that this document was prepared by me or under my direct supervision.

Willard Pellinen

Willard Pellinen  
McLeod County Surveyor  
License No. 9626

Date July 26, 1993

OFFICE OF THE COUNTY RECORDER  
MCLEOD COUNTY, MINNESOTA.

I hereby certify that this document was filed in this office at 4 o'clock P.M. on the 5th day of August, 1993.

Carmen Patricia Muelde, County Recorder

By \_\_\_\_\_, Deputy

Document No. 253998

EAST QUARTER        corner, Section 24, Township 116 North, Range 28 West

## Certificate of Location of Government Corner

1855. John Ryan of the General Land Office established this corner. He set a post and marked 2 aspens for bearing trees.

December, 1968. McCombs Knutson Associates (Dickman Knutson, county surveyor) measured the east line of Section 24 and set a temporary quarter corner on the center line intersection of the roads.

1969. Knutson dug for the corner and found an iron pin down 1 feet below the surface of the road. They replace the iron pin with a McLeod County cast iron monument and took available reference ties.

July 23, 1987. We found the monument in good condition down 4 inches below the bituminous surface, and took new ties.

November, 1990. We measured the east line of Section 24 and found the monument to be 5.55 feet north and 3.36 feet east of a lost position for the corner.

March 3, 1993. We checked the reference ties to the corner.

The monument set by Knutson is accepted as marking the location of the quarter corner. It fits occupation lines, the center lines of the roads and it perpetuates the position of an older monument, the iron pin.


# Certificate of Location of Government Corner

EAST QUARTER corner, Section 20, Township 116 North, Range 27 West

SKETCH OF REFERENCE TIES (NO SCALE)

SECTION 20

SECTION 21

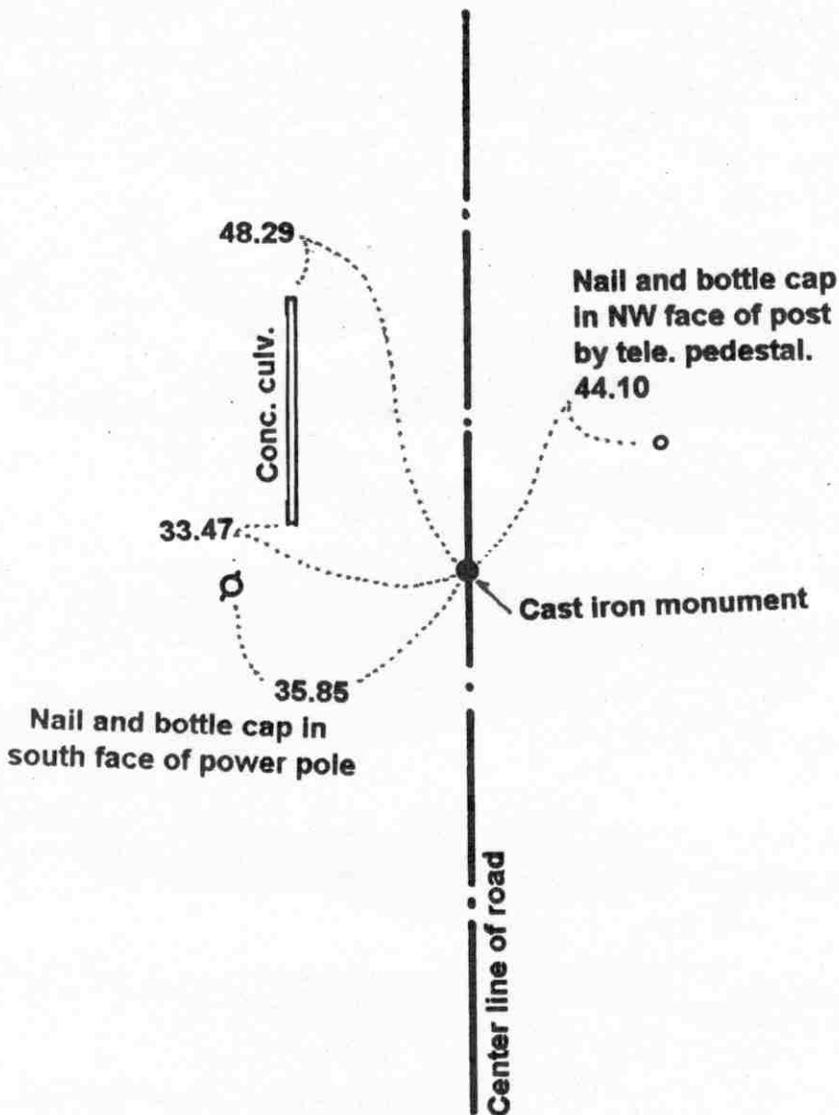

**Statement of evidence relative to this corner location on sheet 2**

I hereby certify that this document was prepared by me or under my direct supervision.

Willard Pellinen  
 Willard Pellinen  
 McLeod County Surveyor  
 License No. 9626.

Date Oct. 9, 1995

**OFFICE OF THE COUNTY RECORDER  
 MCLEOD COUNTY, MINNESOTA**

I hereby certify that this document was filed in this office at 9 o'clock A. M. on the 13th day of October 19 95.

Carmen Postlema, County Recorder

By \_\_\_\_\_, Deputy.

Document No. 268593

## ***Certificate of Location of Government Corner***

***East Quarter Corner, Section 20, Township 116 North, Range 27 West***

***November, 1856. E. N. Darling of the General Land Office established this corner. He set a post, and marked 2 linden trees for bearing trees.***

***June 8, 1979. Walter Tonn, 64 years old and had lived in the Northeast Quarter of Section 20 all his life said the fence running west is on the quarter line. We extended the fence east to the center of Highway No. 261 and found an iron pin at this location.***


***June 27, 1979. We replaced the iron pin with a McLeod County cast iron monument and took available reference ties. The corner is on a straight line between the section corners and 12 feet south of being on a split between the corners.***

***May 15, 1995. We checked the reference ties.***

# Certificate of Location of Government Corner

NORTHEAST corner, Section 20, Township 116 North, Range 27 West

SKETCH OF REFERENCE TIES (NO SCALE)

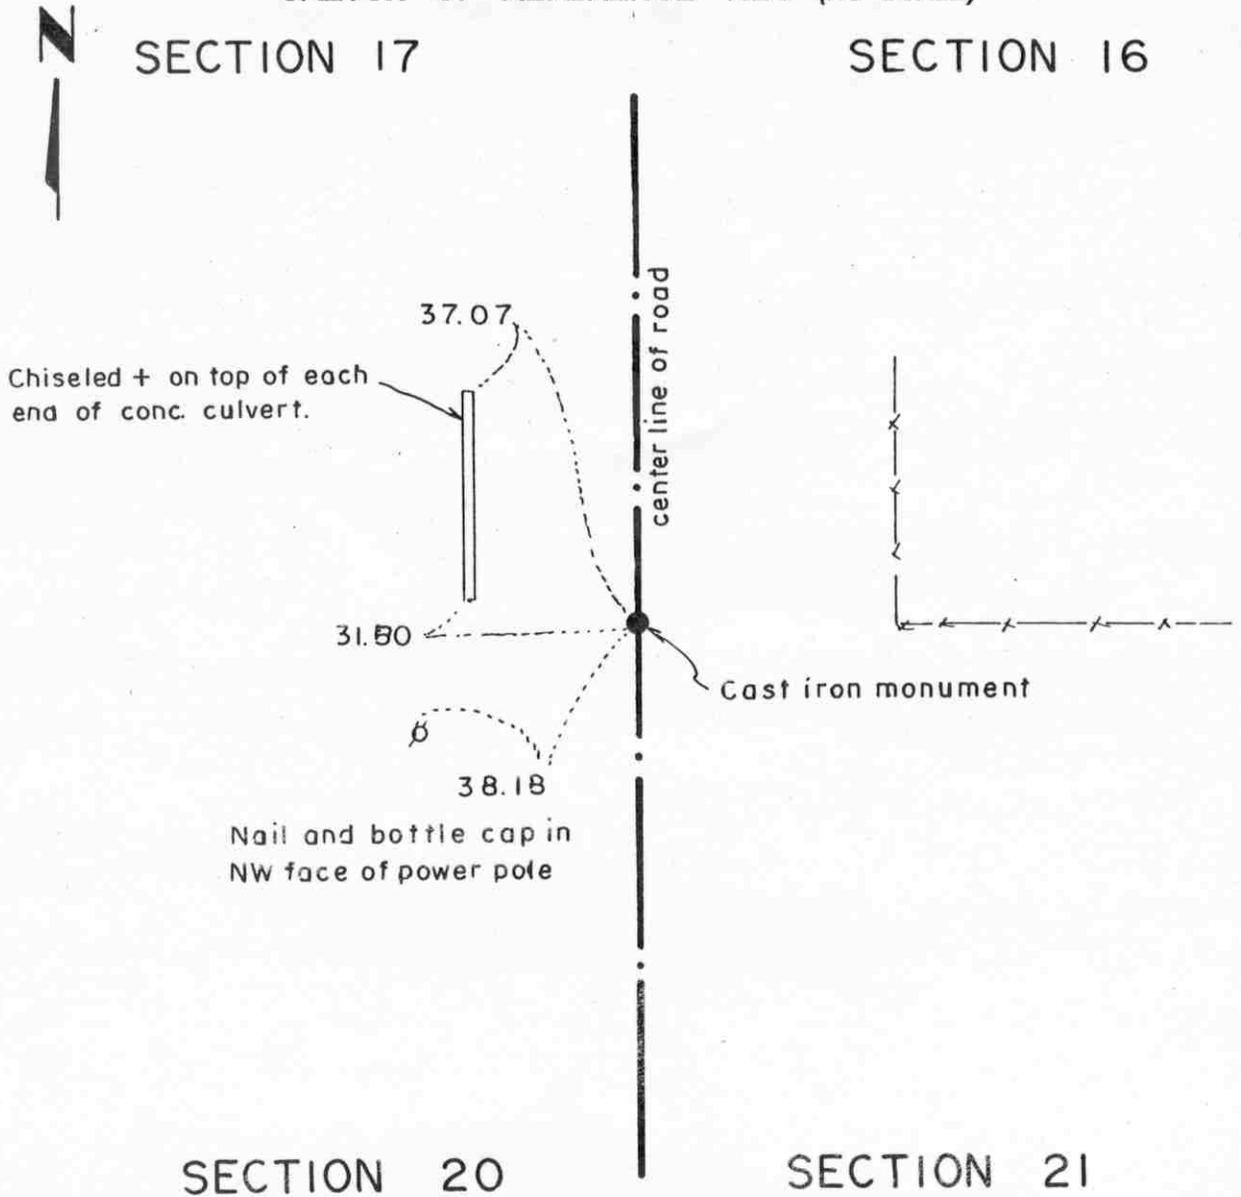

Statement of evidence relative to this corner location on sheet 2

I hereby certify that this document was prepared by me or under my direct supervision.

Willard Pellinen  
Willard Pellinen  
McLeod County Surveyor  
License No. 9626.

Date Jan. 4, 1995

OFFICE OF THE COUNTY RECORDER  
MCLEOD COUNTY, MINNESOTA

I hereby certify that this document was filed in this office at 9 o'clock A. M. on the 10th day of January, 1995.

Carmen Ottilie Mulder, County Recorder

By \_\_\_\_\_, Deputy.

Document No. 263635

## ***Certificate of Location of Government Corner***

***Northeast Corner, Section 20, Township 116 North, Range 27 West***

***November, 1856. E. N. Darling of the General Land Office established this corner. He set a post, and marked 4 trees for bearing trees.***


***September 4, 1975. Dickman Knutson, county surveyor, replaced an iron pin used by the State Highway Department as the corner, with a McLeod County cast iron monument and took available reference ties.***

***January 3, 1995. We checked the reference ties to the monument.***

# Certificate of Location of Government Corner

North Quarter corner, Section 20, Township 116 North, Range 27 West

SKETCH OF REFERENCE TIES (NO SCALE)

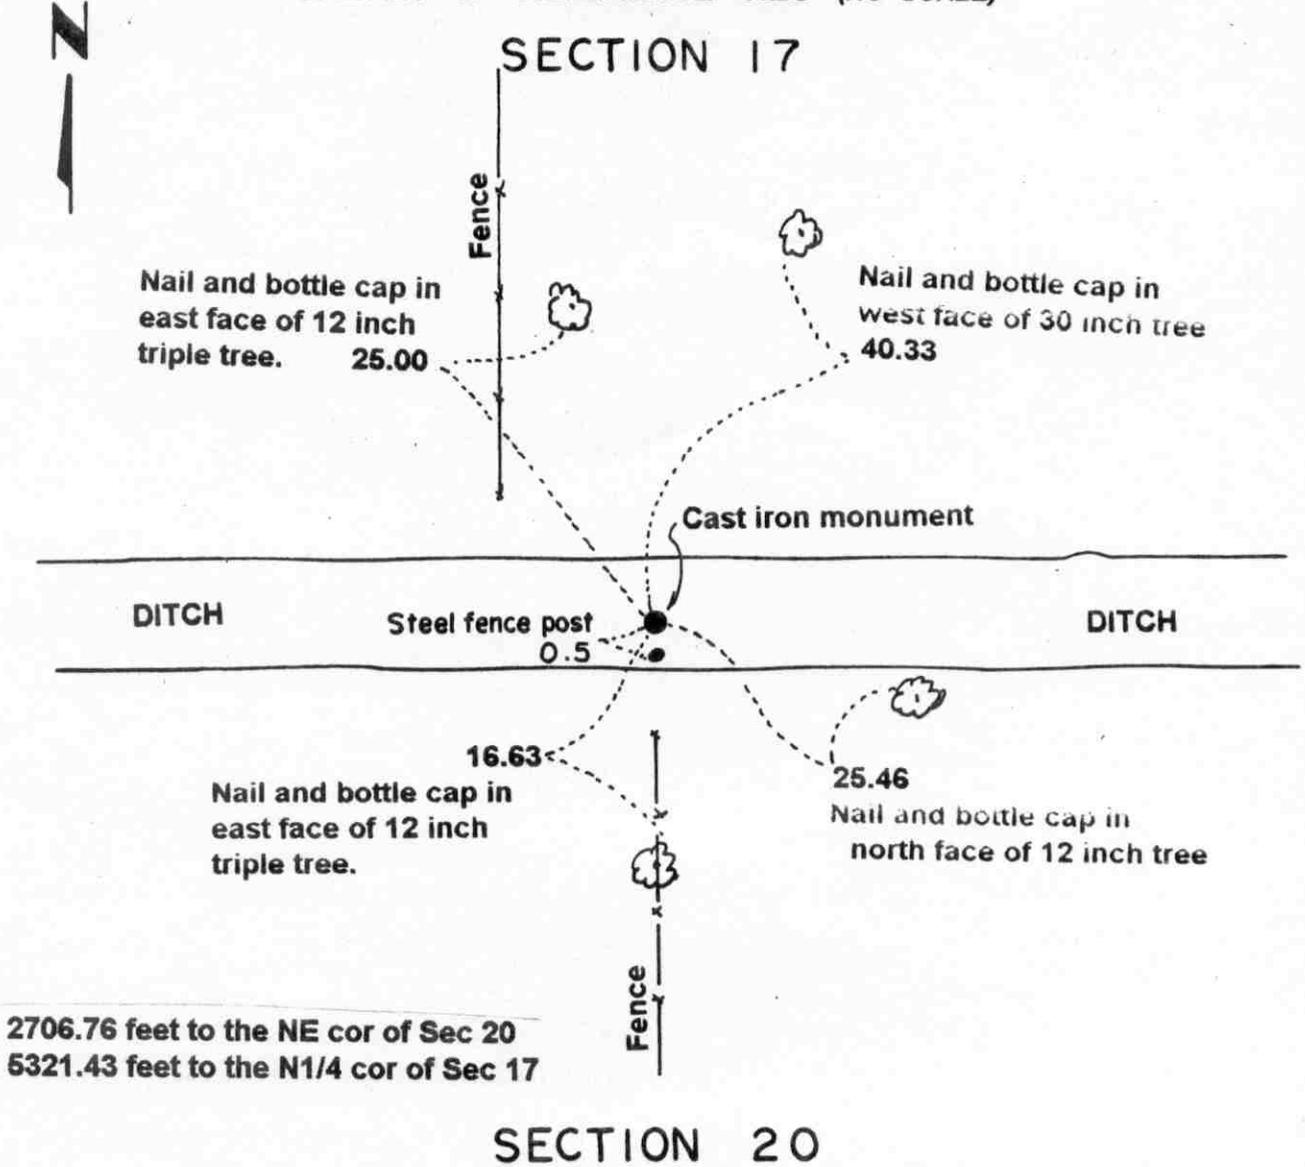

**Statement of evidence relative to this corner location on sheet 2**

I hereby certify that this document was prepared by me or under my direct supervision.

Willard Pellinen  
 Willard Pellinen  
 McLeod County Surveyor  
 License No. 9628.

Date Dec. 13, 1995

**OFFICE OF THE COUNTY RECORDER  
 MCLEOD COUNTY, MINNESOTA**

I hereby certify that this document was filed in this office at 9 o'clock A. M. on the 9th day of January, 19 96.

Carmen Ostlie Mulder, County Recorder

By Charleen Engelman, Deputy.

Document No. 270200

## **Certificate of Location of Government Corner**

**North Quarter Corner, Section 20, Township 116 North, Range 27 West**

**November, 1856. E. N. Darling of the General Land Office established this corner. He set a post in a marsh and marked a 12 inch oak and a 5 inch willow for bearing trees.**

**November 19, 1973. Dickman Knutson, county surveyor, set a 1 inch iron pin at the intersection of the center line of an east-west ditch and fence running south. Adjoining property owners agree this is the correct location of the quarter corner. No old survey information to help locate this corner.**

**August 15, 1974. Knutson replaced the iron pin with a McLeod County cast iron monument and took reference ties. This corner is 18.15 feet west and 26.65 feet south of a lost position for this corner.**

**January, 1995. The monument set by Knutson is accepted as marking the location of the government corner. It fits long standing occupation lines, the fence and ditch, and the location has been accepted as the corner by adjoining land owners.**

# Certificate of Location of Government Corner

EAST QUARTER corner, Section 21, Township 116 North, Range 27 West


## SKETCH OF REFERENCE TIES (NO SCALE)



2673.64 feet to the NE cor of Sec 21  
 2614.95 feet to the SE cor of Sec 21  
 5275.32 feet to the W1/4 cor of Sec 21  
 Angle at east side to sec corners 180-06-25.3

SECTION 21

SECTION 22

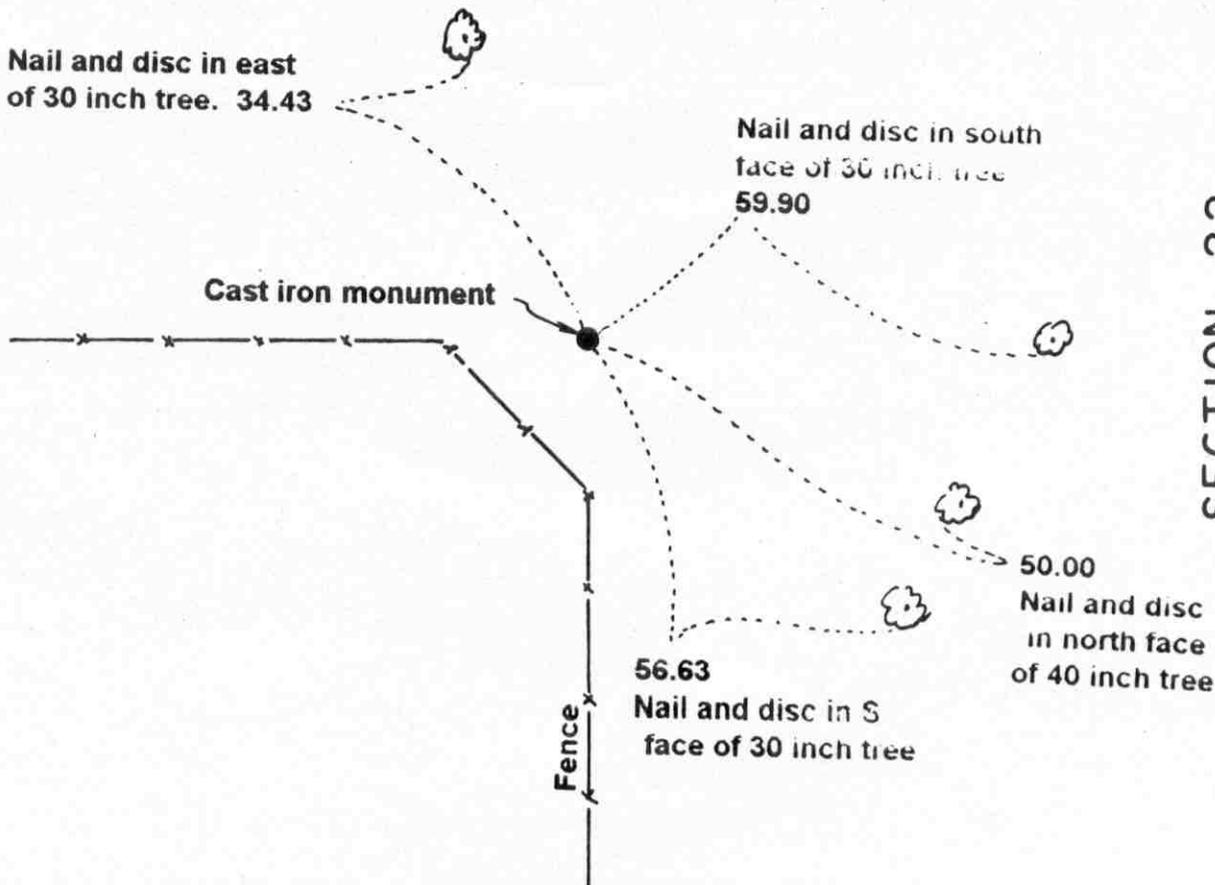

### Statement of evidence relative to this corner location on sheet 2

I hereby certify that this document was prepared by me or under my direct supervision.

Willard Pellinen

Willard Pellinen  
 McLeod County Surveyor  
 License No. 9626.

Date Dec. 13, 1990

### OFFICE OF THE COUNTY RECORDER MCLEOD COUNTY, MINNESOTA

I hereby certify that this document was filed in this office at 9 o'clock A. M. on the 9th day of January 19 96.

Carmen Estelle Mulder, County Recorder

By Charleen Engstrom, Deputy.

Document No. 270202

## ***Certificate of Location of Government Corner***

***East Quarter Corner, Section 21, Township 116 North, Range 27 West***

***November, 1856. E. N. Darling of the General Land Office established this corner. He set a post, and marked two 14 inch oaks for bearing trees.***

***June 11, 1979. We set a McLeod County cast iron monument at the intersection of fences running south and west as per testimony by Daavid Huser, in the Northwest Quarter of Section 22 and Lawrence Goga, who owned the Northeast Quarter of the Southeast Quarter of Section 21.***

# Certificate of Location of Government Corner


NORTHEAST corner, Section 21, Township 116 North, Range 27 West

SKETCH OF REFERENCE TIES (NO SCALE)



SECTION 16

SECTION 15

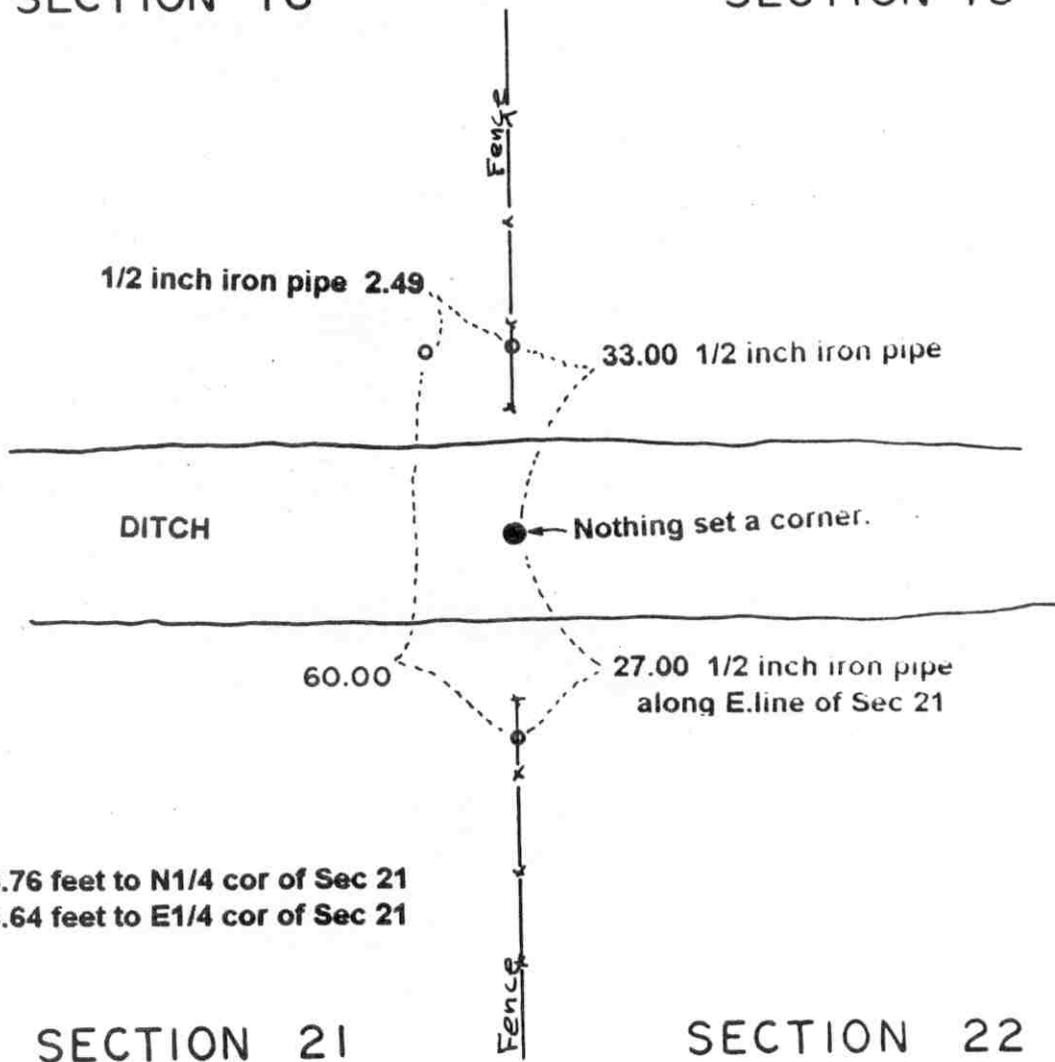

**Statement of evidence relative to this corner location on sheet 2**

I hereby certify that this document was prepared by me or under my direct supervision.

Willard Pellinen  
 Willard Pellinen  
 McLeod County Surveyor  
 License No. 9626.

Date Dec. 13, 1990

OFFICE OF THE COUNTY RECORDER  
 MCLEOD COUNTY, MINNESOTA

I hereby certify that this document was filed in this office at 9 o'clock A. M. on the 9th day of January, 19 96.

Carmen Estelle Mulder, County Recorder

By Charleen Engelmann, Deputy.

Document No. 270201

## ***Certificate of Location of Government Corner***

***Northeast Corner, Section 21, Township 116 North, Range 27 West***

***November, 1856. E. N. Darling of the General Land Office established this corner. He set a post, and marked two 12 inch and two 14 inch oaks for bearing trees.***

***June 8, 1979. Adjacent land owners say the corner is in the center of the east-west ditch and along the north-south fence.***


***June 22, 1979. We located the center of the ditch and set iron pipes along the east lines of Sections 21 and 16. 27.00 feet south and 33.00 feet north of the corner.***

# Certificate of Location of Government Corner

NORTH QUARTER corner, Section 21, Township 116 North, Range 27 West

SKETCH OF REFERENCE TIES (NO SCALE)

SECTION 16

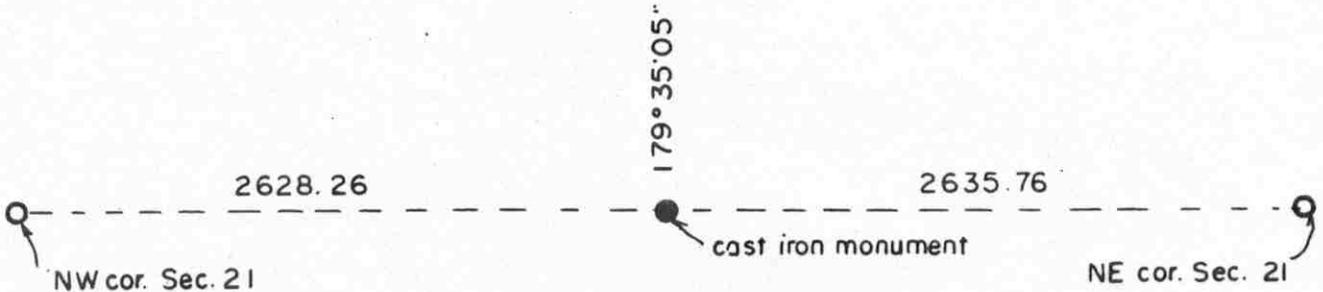

5270.73 to S 1/4 corner of Sec. 21

SECTION 21

## Statement of evidence relative to this corner location on sheet 2

I hereby certify that this document was prepared by me or under my direct supervision.

Willard Pellinen  
Willard Pellinen  
McLeod County Surveyor  
License No. 9626.

Date Dec. 13, 1990

## OFFICE OF THE COUNTY RECORDER MCLEOD COUNTY, MINNESOTA

I hereby certify that this document was filed in this office at 9 o'clock A. M. on the 9th day of January 19 96.

Carmen Estelle Mulder, County Recorder

By Charleen Engelman, Deputy.

Document No. 270203

## ***Certificate of Location of Government Corner***

***North Quarter Corner, Section 21, Township 116 North, Range 27 West***


***November, 1856. E. N. Darling of the General Land Office established this corner. He set a post, and marked 2 linden trees for bearing trees.***

***June 22, 1979. We set a McLeod County cast iron monument at the intersection of field lines north, south and west. Adjoining land owners agree this is the correct location of the quarter corner. Milan Dammann, 52 years old and had lived in the Southeast Quarter of Section 16 all his life and Emmet Gebhardt, in the Northwest Quarter of Section 21 had set a post at the corner. This point is 3.75 feet west and 9.5 feet south of a lost position for the corner.***

# Certificate of Location of Government Corner

East Quarter corner, Section 22, Township 116 North, Range 27 West

## SKETCH OF REFERENCE TIES (NO SCALE)

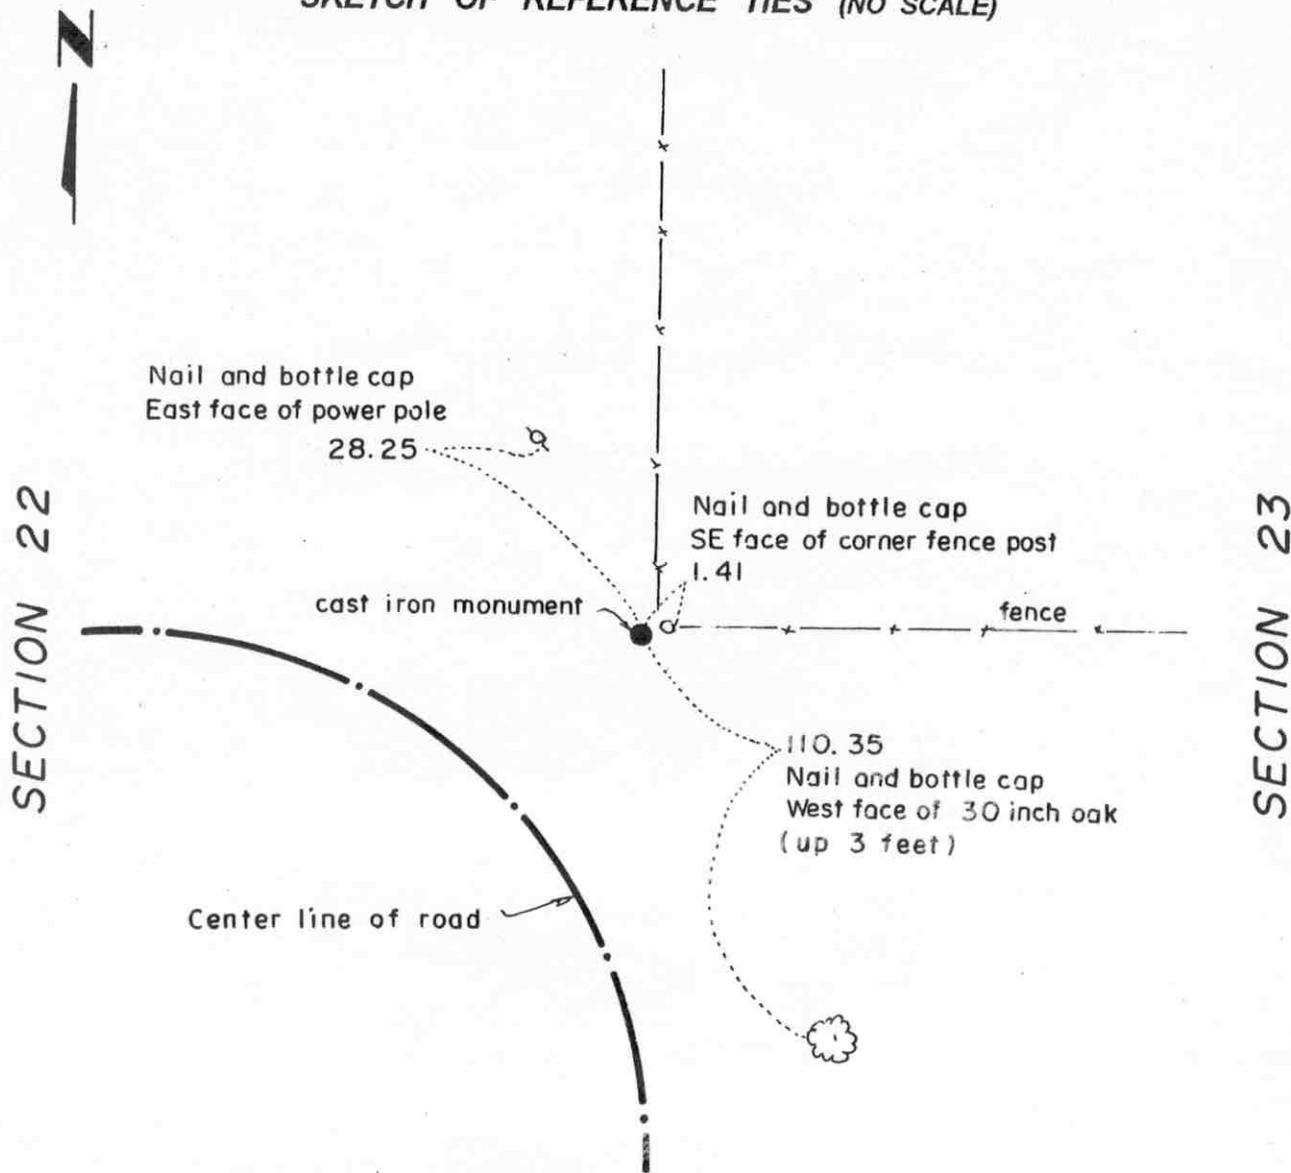

### Statement of evidence relative to this corner location on sheet 2

I hereby certify that this document was prepared by me or under my direct supervision.

Willard Pellinen  
Willard Pellinen  
McLeod County Surveyor  
License No. 9626.

Date Sept. 6, 1994

### OFFICE OF THE COUNTY RECORDER MCLEOD COUNTY, MINNESOTA

I hereby certify that this document was filed in this office at 9 o'clock A. M. on the 22nd day of September 19 94.

Carmen Ottilie Mulder, County Recorder

By \_\_\_\_\_, Deputy.

Document No. 261941

## ***Certificate of Location of Government Corner***

### ***East Quarter Corner, Section 22, Township 116 North, Range 27 West***

***November, 1856. E. N. Darling of the General Land Office originally established this corner. He set a post and marked a 30 inch and a 12 inch elm for bearing trees.***

***July 21, 1971. Dickman Knutson, county surveyor, set a McLeod County cast iron monument at the fence intersection, fences north and east. Marvin Huser, in the Northeast Quarter of Section 22, said there used to be a tree at the corner and this was at the fence intersection. Harry Huser also said this was the correct location for the corner. Knutson dug at the intersection and found some old tree roots, no stump remaining. Knutson set a McLeod County cast iron monument at the corner and took available reference ties.***

***August 23, 1994. We found the monument down 14 inches below the surface but no old reference ties remained. We took new available ties.***

# Certificate of Location of Government Corner

NORTHEAST corner, Section 22, Township 116 North, Range 27 West

SKETCH OF REFERENCE TIES (NO SCALE)



SECTION 15

SECTION 14

Nail and bottle cap in west face of cluster of 6 to 10 inch box elders, up 2 feet.

7.39

Nail and bottle cap in east face of 10 inch elm, up 2 feet.

5.66

Cast iron monument

12.32

Nail and bottle cap in east face of 10 inch ash, up 3 feet.

SECTION 22

SECTION 23



Statement of evidence relative to this corner location on sheet 2

I hereby certify that this document was prepared by me or under my direct supervision.

Willard Pellinen  
Willard Pellinen  
McLeod County Surveyor  
License No. 9626.

Date April 20, 1995

OFFICE OF THE COUNTY RECORDER  
MCLEOD COUNTY, MINNESOTA

I hereby certify that this document was filed in this office at 9 o'clock A M. on the 24th day of Apr 19 95.

Carmen Estlin Mulder, County Recorder

By \_\_\_\_\_, Deputy.

Document No. 265323

## ***Certificate of Location of Government Corner***

***Northeast Corner, Section 22, Township 116 North, Range 27 West***

***November, 1856. E. N. Darling of the General Land Office established this corner. He set a post, and marked 3 lindens and an elm for bearing trees.***

***No good testimony and no occupation lines running east or west to help locate this corner, except adjoining land owners have accepted the north-south fence as being on the section lines.***

***July, 1971. Dickman Knutson, county surveyor, set a temporary corner midway between the east quarter corner of Section 22 and the east quarter corner of Section 15. (along the north-south fence)***

***July 21, 1971. Knutson found a steel shaft with gear on top very close to the temporary corner and replaced it with a McLeod County cast iron monument and took available reference ties. Near the steel shaft Knutson found a rotted wood stake.***

***February 2, 1995. We found the monument in good condition and took new ties.***

# Certificate of Location of Government Corner

NORTH QUARTER corner, Section 22, Township 116 North, Range 27 West

SKETCH OF REFERENCE TIES (NO SCALE)

SECTION 15



Nail and bottle cap in west face of 36 inch oak, up 5 feet. 60.68

Nail and bottle cap in east face of 12 inch oak, up 4 feet. 36.05

Cast iron monument

Field line

Fence

SECTION 22

Statement of evidence relative to this corner location on sheet 2

I hereby certify that this document was prepared by me or under my direct supervision.

Willard Pellinen

Willard Pellinen  
McLeod County Surveyor  
License No. 9626.

Date April 20, 1995

OFFICE OF THE COUNTY RECORDER  
MCLEOD COUNTY, MINNESOTA

I hereby certify that this document was filed in this office at 9 o'clock A. M. on the 24th day of Apr 19 95.

Carmen Patricia Spelder County Recorder

By \_\_\_\_\_, Deputy.

Document No. 265324

## **Certificate of Location of Government Corner**

**North Quarter Corner, Section 22, Township 116 North, Range 27 West**

**November, 1856. E. N. Darling of the General Land Office established this corner. He set a post, and marked 2 trees for bearing trees.**

**July 21, 1971. Dickman Knutson, county surveyor, set a McLeod County cast iron monument along a north-south fence on the easterly prolongation of a fence to the west. Adjoining land owners agree this is the correct location and they had set a stake at this location.**

**February 2, 1995. We found the monument in good condition along a north-south fence and took new available ties.**

# Certificate of Location of Government Corner




## SKETCH OF REFERENCE TIES

(NO SCALE)

SECTION 23

SECTION 24

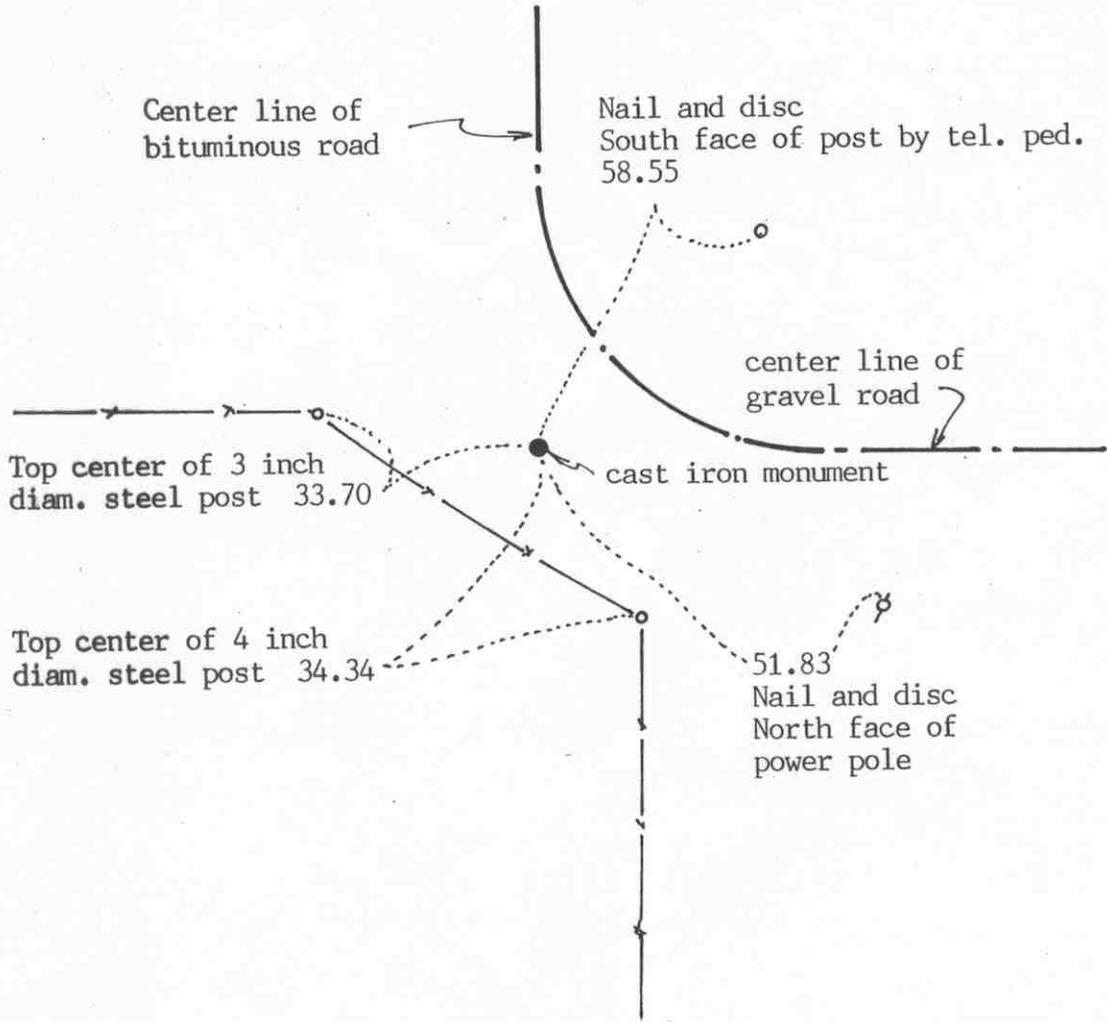

Statement of evidence relative to this corner location on sheet 2

I hereby certify that this document was prepared by me or under my direct supervision.

Willard Pellinen

Willard Pellinen  
McLeod County Surveyor  
License No. 9626

Date August 10, 1992

OFFICE OF THE COUNTY RECORDER  
MCLEOD COUNTY, MINNESOTA.

I hereby certify that this document was filed in this office at 9 o'clock A.M. on the 20th day of Aug, 1992.

Armon Ostlie, County Recorder

By \_\_\_\_\_, Deputy

Document No. 247339

## Certificate of Location of Government Corner

NOVEMBER, 1856. E. N. Darling of the General Land Office set a post and marked 2 aspens for bearing trees.

1976. Norman Heldt, 40± years old, inherited farm to the west of this corner from his dad, says the center line of the north-south bituminous road is the section line and the E-W  $\frac{1}{4}$  line of Section 23 misses his barn by approximately 11 feet.

April, 1976. McCombs Knutson Associates (Dickman Knutson, county surveyor) dug for the corner but found nothing. They set the corner on the center line-center line intersection of the roads.

July 16, 1979. We replaced the iron pipe set by Knutson with a McLeod County cast iron monument and took reference ties.


May 23, 1990. We found the monument in good condition and took ties to replace the monument after road construction.

December 31, 1991. The monument was not moved by the road construction. We set a PK nail over the monument and took new reference ties.

The center line intersection of the roads had perpetuated the correct location of the quarter corner. The east-west quarter line of Section 23 is approximately 10-11 feet south of Mr Heldt's barn as per testimony by Mr. Heldt. The center of Section 24 falls on the center of the east west road. A lost position for this corner would fall about 15 feet north and 13½ feet west of the monument ✓.

# Certificate of Location of Government Corner

## SKETCH OF REFERENCE TIES

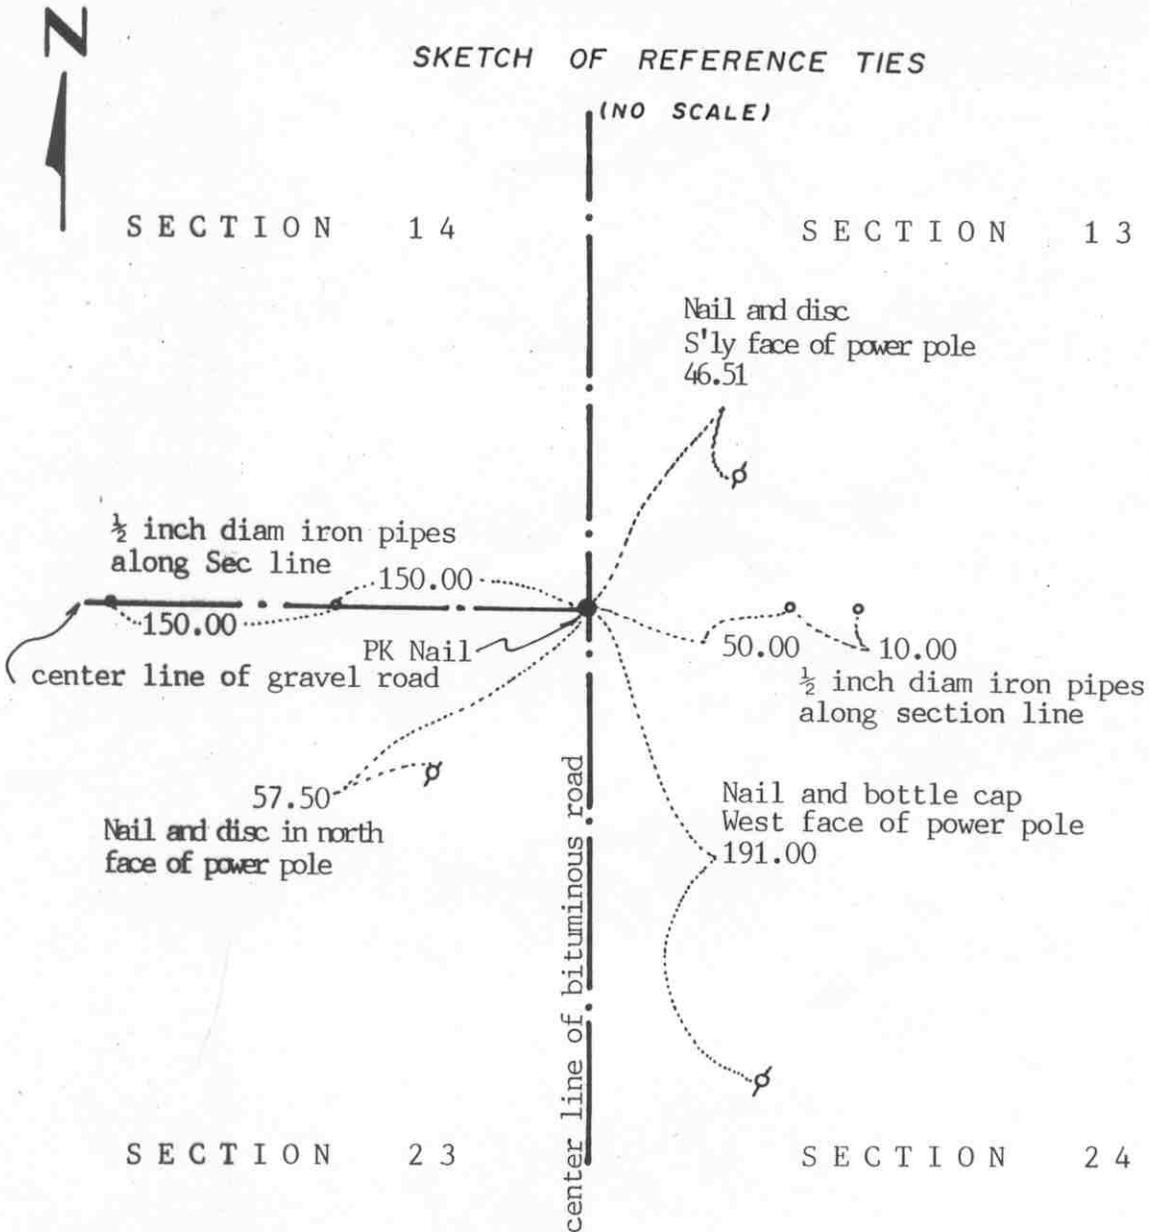

Statement of evidence relative to this corner location on sheet 2

I hereby certify that this document was prepared by me or under my direct supervision.

Willard Pellinen  
Willard Pellinen  
McLeod County Surveyor  
License No. 9626  
Date Aug. 1, 1992

OFFICE OF THE COUNTY RECORDER  
MCLEOD COUNTY, MINNESOTA.

I hereby certify that this document was filed in this office at 9 o'clock A.M. on the 28th day of Aug, 1992.

Carmen Ostlie, County Recorder  
By \_\_\_\_\_, Deputy

Document No. 247338

NORTHEAST corner, Section 23, Township 117 North, Range 27 West

## Certificate of Location of Government Corner

1856. E. N. Darling of the General Land Office set a post and marked an ironwood, 2 elms and a linden tree for bearing trees.

1977. Marvin Fenske who owned land west of this corner said when the road was built, it was built on the north south section line and the cartway running west also was built on the section line. Mr. Harry Huser, 76, on farm north and west of this corner all his life, agrees with Mr. Fenske. He said there also used to be a road running east from this corner.

1977. RCM, surveyors, used the center line intersection as the section corner.

1977. McCombs Knutson Associates, dug for the corner but found nothing.

July 16, 1979. McCombs Knutson Associates (Dickman Knutson county surveyor) set a McLeod County cast iron monument at the center line intersection and took reference ties.

May 23, 1990. We found the monument in good condition and took ties from which to reset the corner after road construction.

December 31, 1991. We reset the corner using the reference ties and took additional ties.


This corner was an obliterated corner whose location had been perpetuated by the center line intersection of the roads.

# Certificate of Location of Government Corner

North Quarter corner, Section 23, Township 116 North, Range 27 West

SKETCH OF REFERENCE TIES (NO SCALE)

## SECTION 14

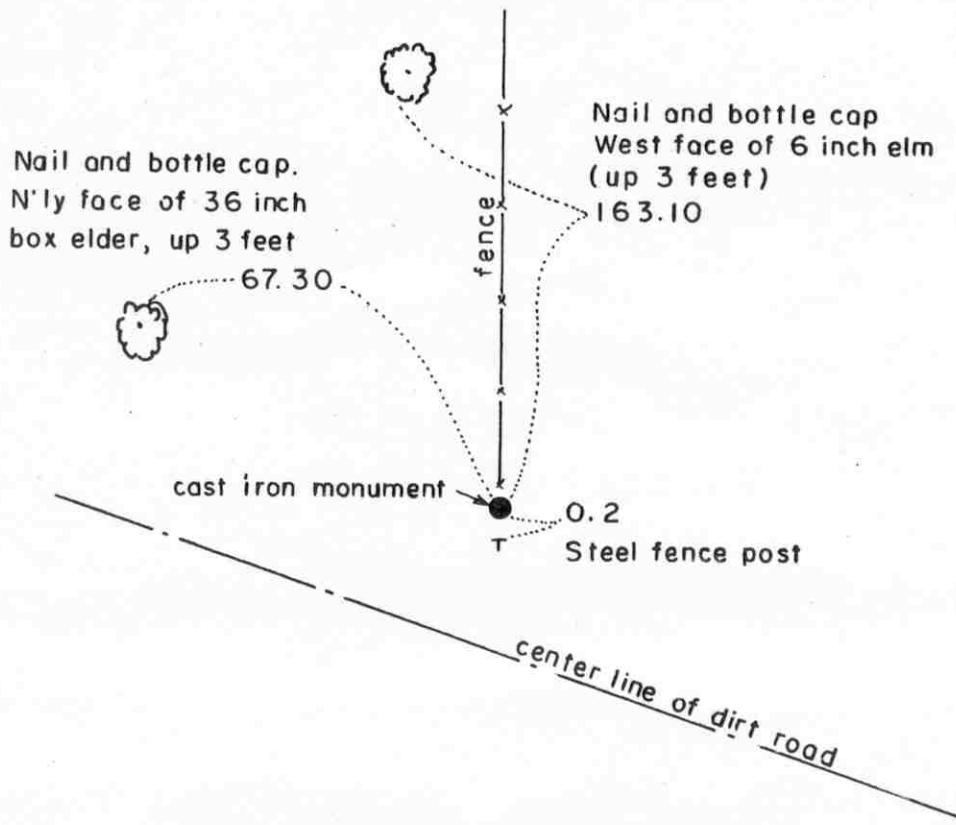

## SECTION 23

Statement of evidence relative to this corner location on sheet 2

I hereby certify that this document was prepared by me or under my direct supervision.

Willard Pellinen

Willard Pellinen  
McLeod County Surveyor  
License No. 9626.

Date Sept. 6, 1994

OFFICE OF THE COUNTY RECORDER  
MCLEOD COUNTY, MINNESOTA

I hereby certify that this document was filed in this office at 9 o'clock A. M. on the 22nd day of September 19 94.

Carmen Ottilie Mulder, County Recorder

By \_\_\_\_\_, Deputy.

Document No. 261942

## **Certificate of Location of Government Corner**

### **North Quarter Corner, Section 23, Township 116 North, Range 27 West**

*November, 1856. E. N. Darling of the General Land Office originally established this corner. He set a post and marked an 8 inch linden and a 5 inch ironwood for bearing trees.*

*January 7, 1981. Mr. Francis Burch, 45 years old and had lived in the North Half of Section 23 for 17 years, said fence running north is on the quarter line of Section 14.*

*April 3, 1984. We set a temporary quarter corner on the southerly extension of the fence on the westerly extension of the straight portion of the road to the east. No definite occupation line running east or west.*

*Harold Lempher, has owned land in the Northwest and Northeast Quarters of Section 23 and in the Southwest Quarter of Section 14, said fence running north is on the north-south quarter line of Section 14. Has been accepted by adjoining property owners.*

*September 17, 1984. We set a McLeod County cast iron monument on the southerly extension of the fence on the westerly extension of the straight portion of the gravel road to the east. The road has been accepted as being on the section line by adjoining property owners.*

*August 23, 1994. We found the cast iron monument in good condition, flush with the surface of the ground and took new reference ties.*


# Certificate of Location of Government Corner

EAST QUARTER corner, Section 24, Township 116 North, Range 27 West

SKETCH OF REFERENCE TIES (NO SCALE)

SECTION 24 T. 116 N. R. 27 W.

SECTION 19 T. 116 N. R. 26 W.

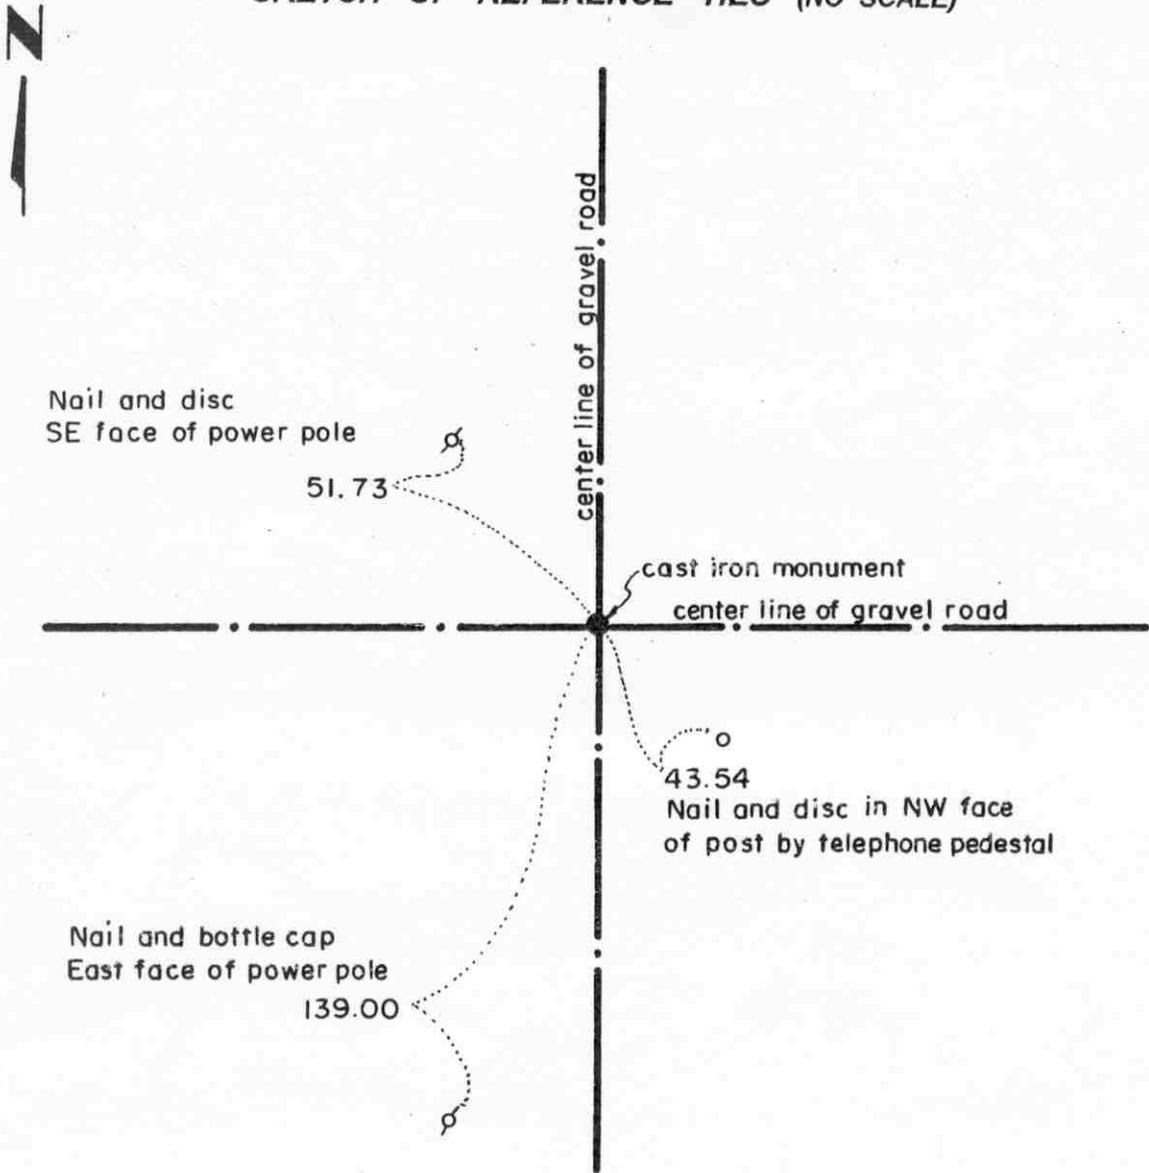

**Statement of evidence relative to this corner location on sheet 2**

I hereby certify that this document was prepared by me or under my direct supervision.

Willard Pellinen  
 Willard Pellinen  
 McLeod County Surveyor  
 License No. 9626.

Date August 25, 1994

**OFFICE OF THE COUNTY RECORDER  
 MCLEOD COUNTY, MINNESOTA**

I hereby certify that this document was filed in this office at 9 o'clock A. M. on the 9th day of Sept 19 94.

Carmen Estlie Mulder, County Recorder

By \_\_\_\_\_, Deputy.

Document No. 261757

## ***Certificate of Location of Government Corner***

### ***East Quarter Corner, Section 24, Township 116 North, Range 27 West***

***1855. John Ryan of the General Land Office set a post and marked a 6 inch and a 12 inch elm for bearing trees.***

***This corner was reestablished by the Carver County Surveyor who set a cast iron monument at the corner.***


***January 14, 1986. We found the monument in good condition and took reference ties. This corner falls in the center line intersection of gravel roads north, south, east and west.***

***August 23, 1994. We found the monument in good condition and checked the reference ties.***

# Certificate of Location of Government Corner

Northeast corner, Section 24, Township 116 North, Range 27 West

SKETCH OF REFERENCE TIES (NO SCALE)

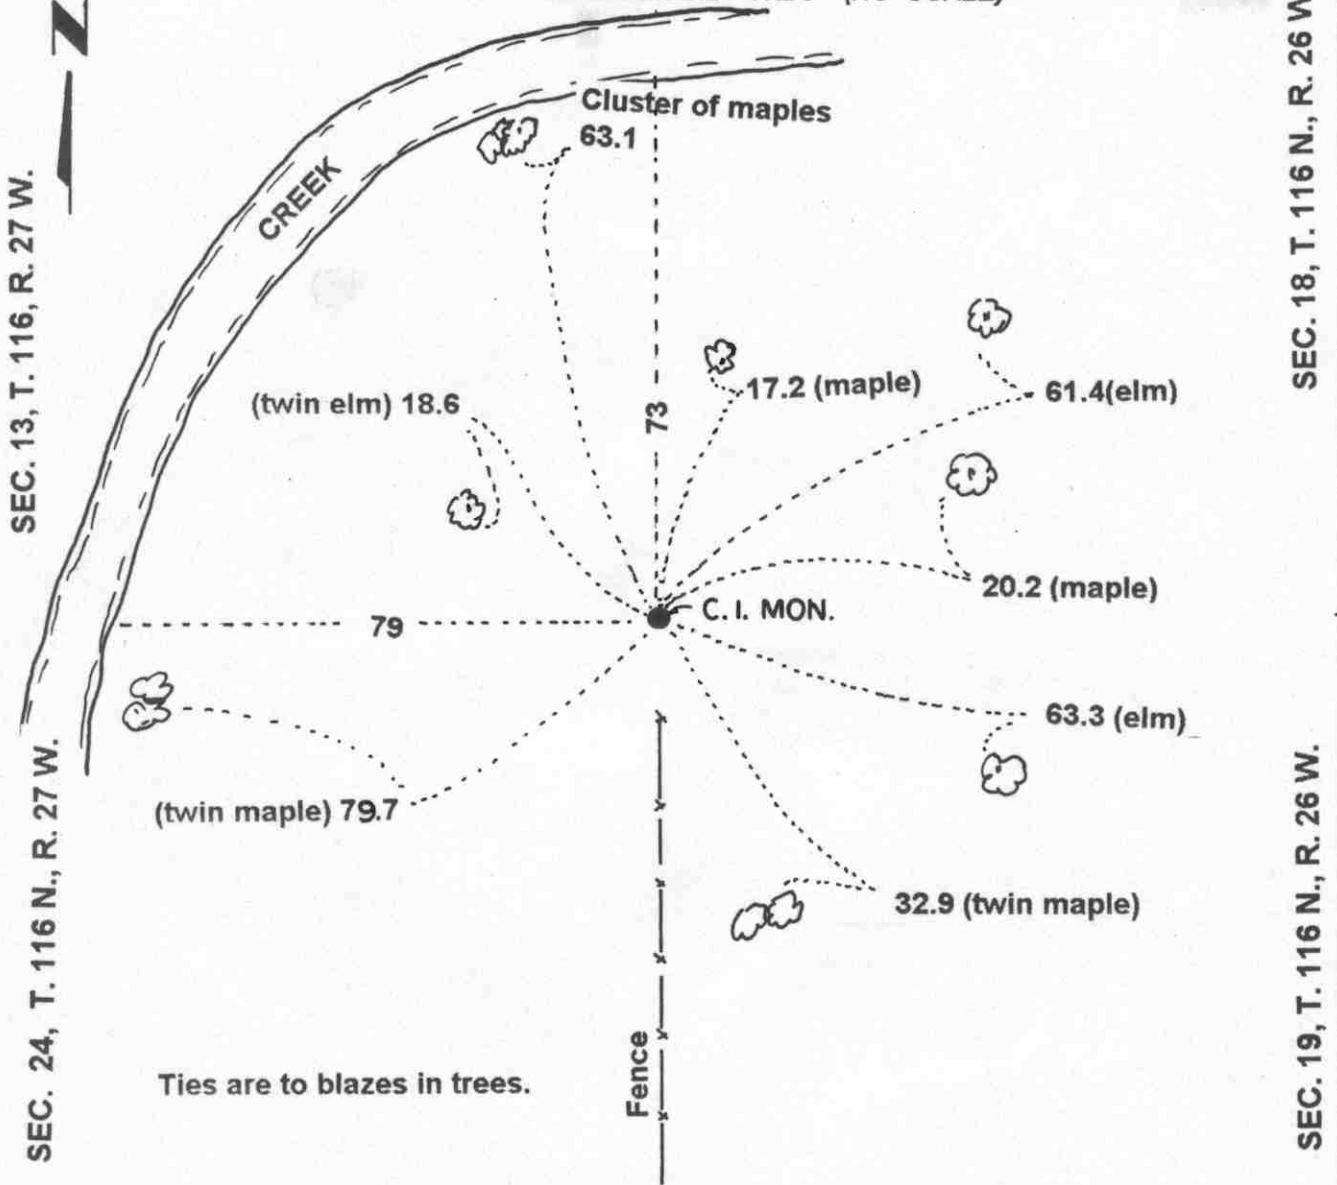

Ties are to blazes in trees.

Statement of evidence relative to this corner location on sheet 2

I hereby certify that this document was prepared by me or under my direct supervision.

*Willard Pellinen*  
 Willard Pellinen  
 McLeod County Surveyor  
 License No. 9626.

Date Oct. 9, 1995

**OFFICE OF THE COUNTY RECORDER  
 MCLEOD COUNTY, MINNESOTA**

I hereby certify that this document was filed in this office at 9 o'clock A M. on the 13th day of October 19 95.

*Carmen Potlitz-Gulder*, County Recorder

By \_\_\_\_\_, Deputy.

Document No. 268594

***Certificate of Location of Government Corner***  
***Northeast corner, Section 24, Township 116 North, Range 27 West***

***1855. John Ryan of the General Land Office originally established this corner.***

***1971. The Carver County Surveyor found a limestone monument inscribed with numbers 13, 18, 19 and 24, separated with an inscribed "cross." He took available reference ties and set a cast iron monument in place of the limestone monument. The monument was accepted by Dickman Knutson, McLeod County Surveyor, as marking the location of the corner.***


***May 15, 1995. We found the monument in good condition.***

# Certificate of Location of Government Corner

NORTH QUARTER corner, Section 24, Township 116 North, Range 27 West

SKETCH OF REFERENCE TIES (NO SCALE)

SECTION 13

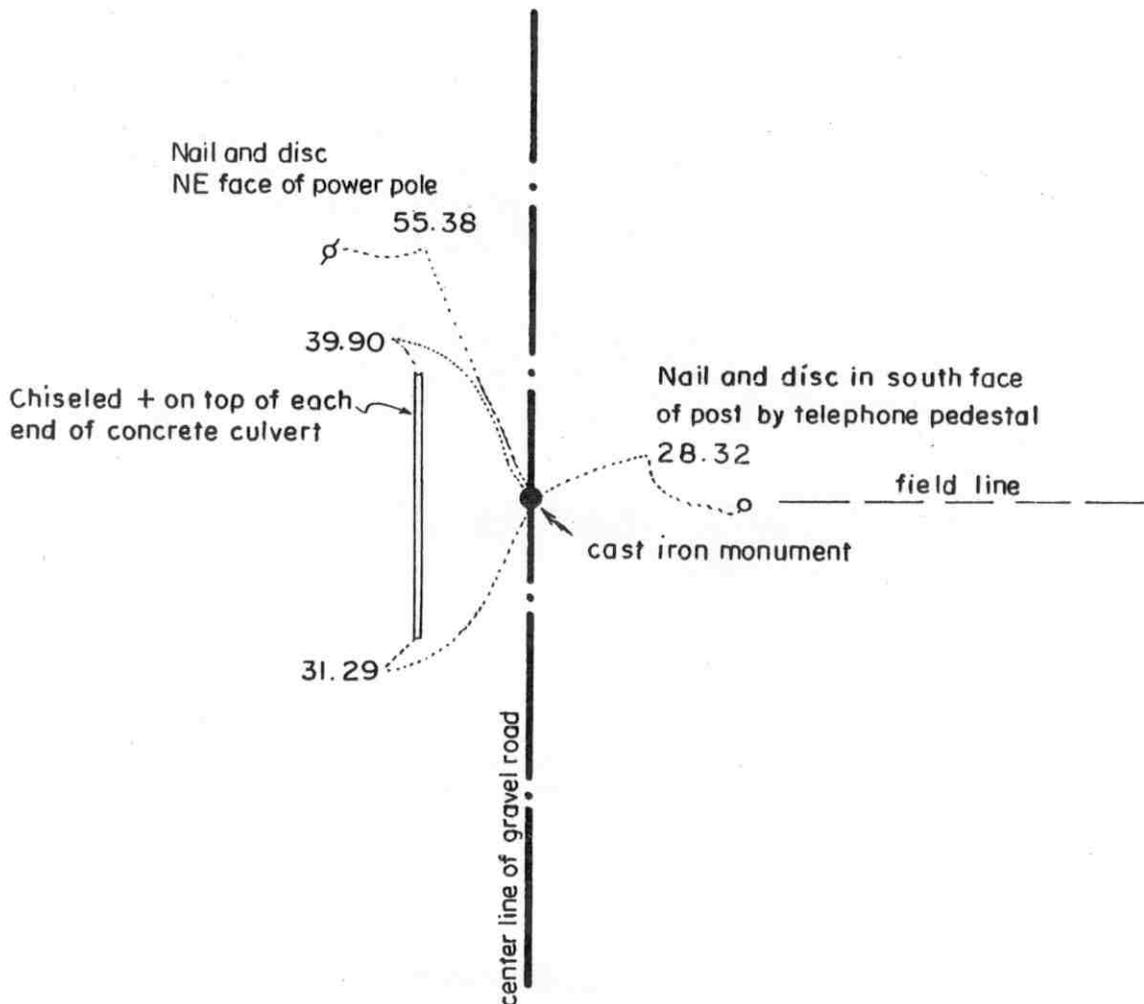

SECTION 24

Statement of evidence relative to this corner location on sheet 2

I hereby certify that this document was prepared by me or under my direct supervision.

Willard Pellinen  
Willard Pellinen  
McLeod County Surveyor  
License No. 9626.

Date August 26, 1994

OFFICE OF THE COUNTY RECORDER  
MCLEOD COUNTY, MINNESOTA

I hereby certify that this document was filed in this office at 9 o'clock A. M. on the 9th day of Sept 19 94.

Carmen Ostlie Mulder County Recorder

By \_\_\_\_\_, Deputy.

Document No. 261758

## **Certificate of Location of Government Corner**

**North Quarter Corner, Section 24, Township 116 North, Range 27 West**

**November, 1856. E. N. Darling of the General Land Office originally established this corner. He set a post and marked a 7 inch and a 5 inch aspen for bearing trees.**

**May 19, 1976. Dickman Knutson, county surveyor, excavated for the corner (John Tupa) from Hutchinson with a backhoe). They found an 18 inch by 18 inch by 12 inch stone with a 1/2 inch diameter iron pipe beside the stone. They took available reference ties. This was on the center line of the north-south gravel road in line with a field line to the east and a gravel drive to the west.**


**April 10, 1978. Knutson set a McLeod County cast iron monument at the corner and took additional ties.**

**August 23, 1994. We found the monument in good condition and checked the reference ties.**

# Certificate of Location of Government Corner

East Quarter corner, Section 25, Township 116 North, Range 27 West

## SKETCH OF REFERENCE TIES (NO SCALE)

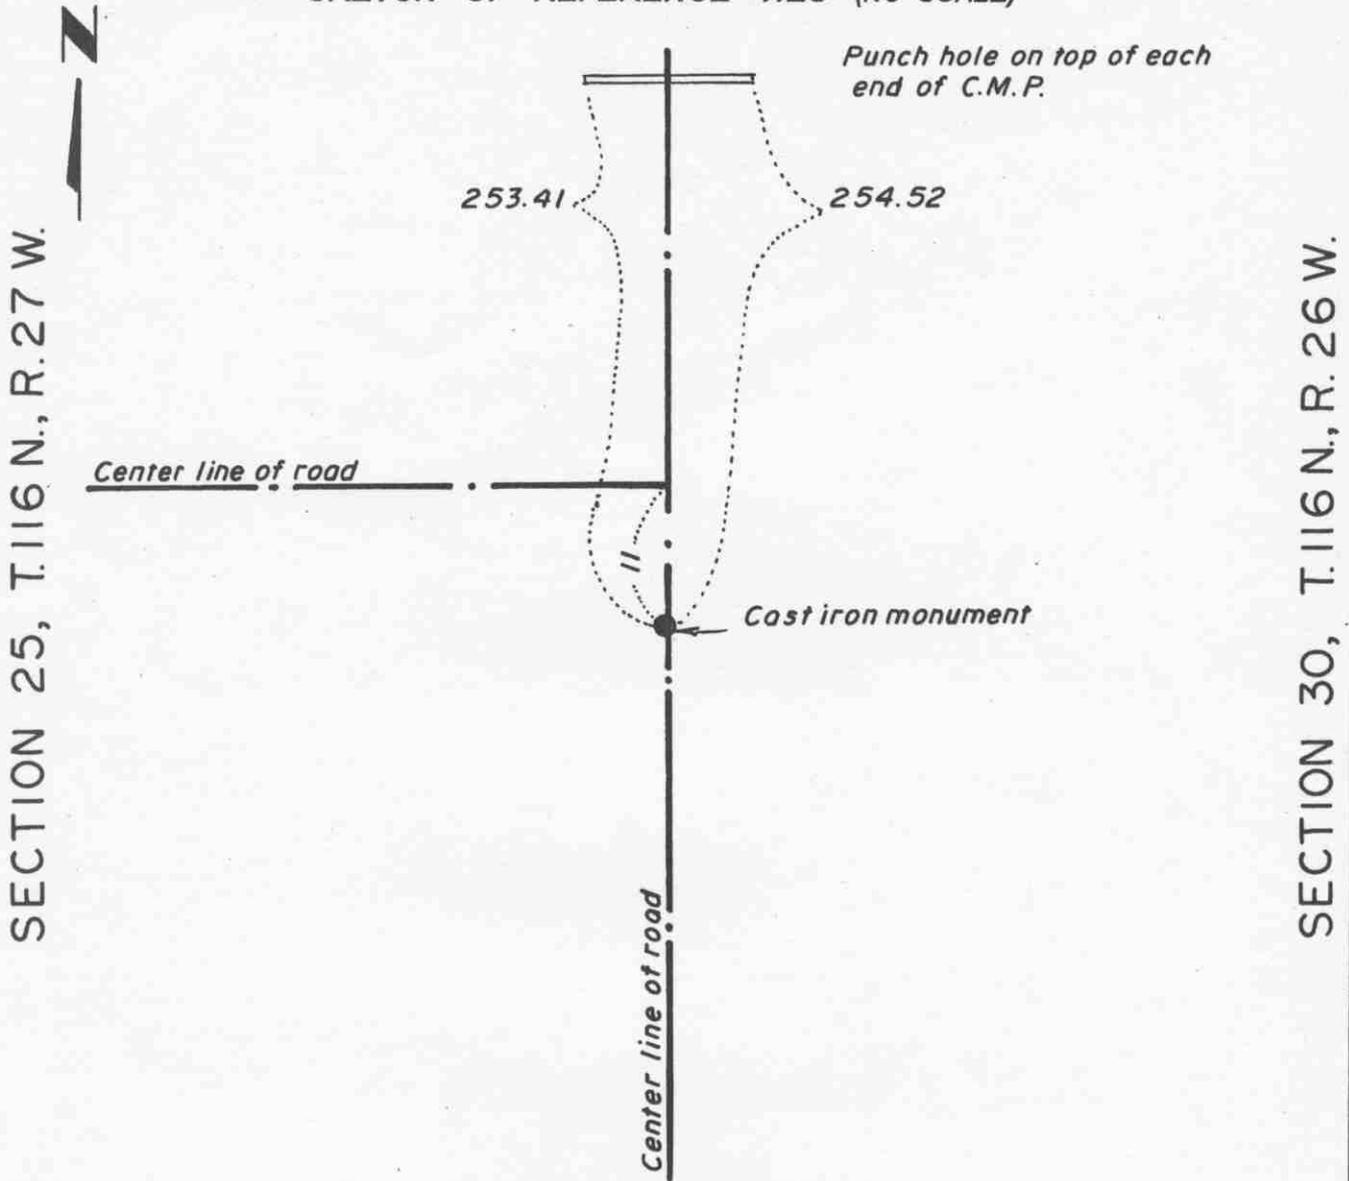

### Statement of evidence relative to this corner location on sheet 2

I hereby certify that this document was prepared by me or under my direct supervision.

Willard Pellinen  
Willard Pellinen  
McLeod County Surveyor  
License No. 9626.

Date Feb. 4, 1995.

### OFFICE OF THE COUNTY RECORDER MCLEOD COUNTY, MINNESOTA

I hereby certify that this document was filed in this office at 9 o'clock A. M. on the 6th day of February 19 95.

Carmen Obelia Mulder County Recorder

By \_\_\_\_\_, Deputy.

Document No. 264033

## ***Certificate of Location of Government Corner***

***East Quarter Corner, Section 25, Township 116 North, Range 27 West***

***1855. John Ryan of the General Land Office established this corner. He set a post and marked 2 elms for bearing trees.***

***August 31, 1971. The Carver County Surveyor excavated for the corner with a backhoe. He dug a hole about 14 feet in diameter and about 4 feet deep but found no evidence of the government corner.***

***December 8, 1972. Carver County Surveyor set a temporary quarter corner on line and split between the section corners.***


***September 26, 1973. A Carver County cast iron monument was set at the location of the temporary corner by the Carver County Surveyor.***

***January 5, 1995. We checked the reference ties to the monument.***

# Certificate of Location of Government Corner

Northeast corner, Section 25, Township 116 North, Range 27 West

SKETCH OF REFERENCE TIES (NO SCALE)

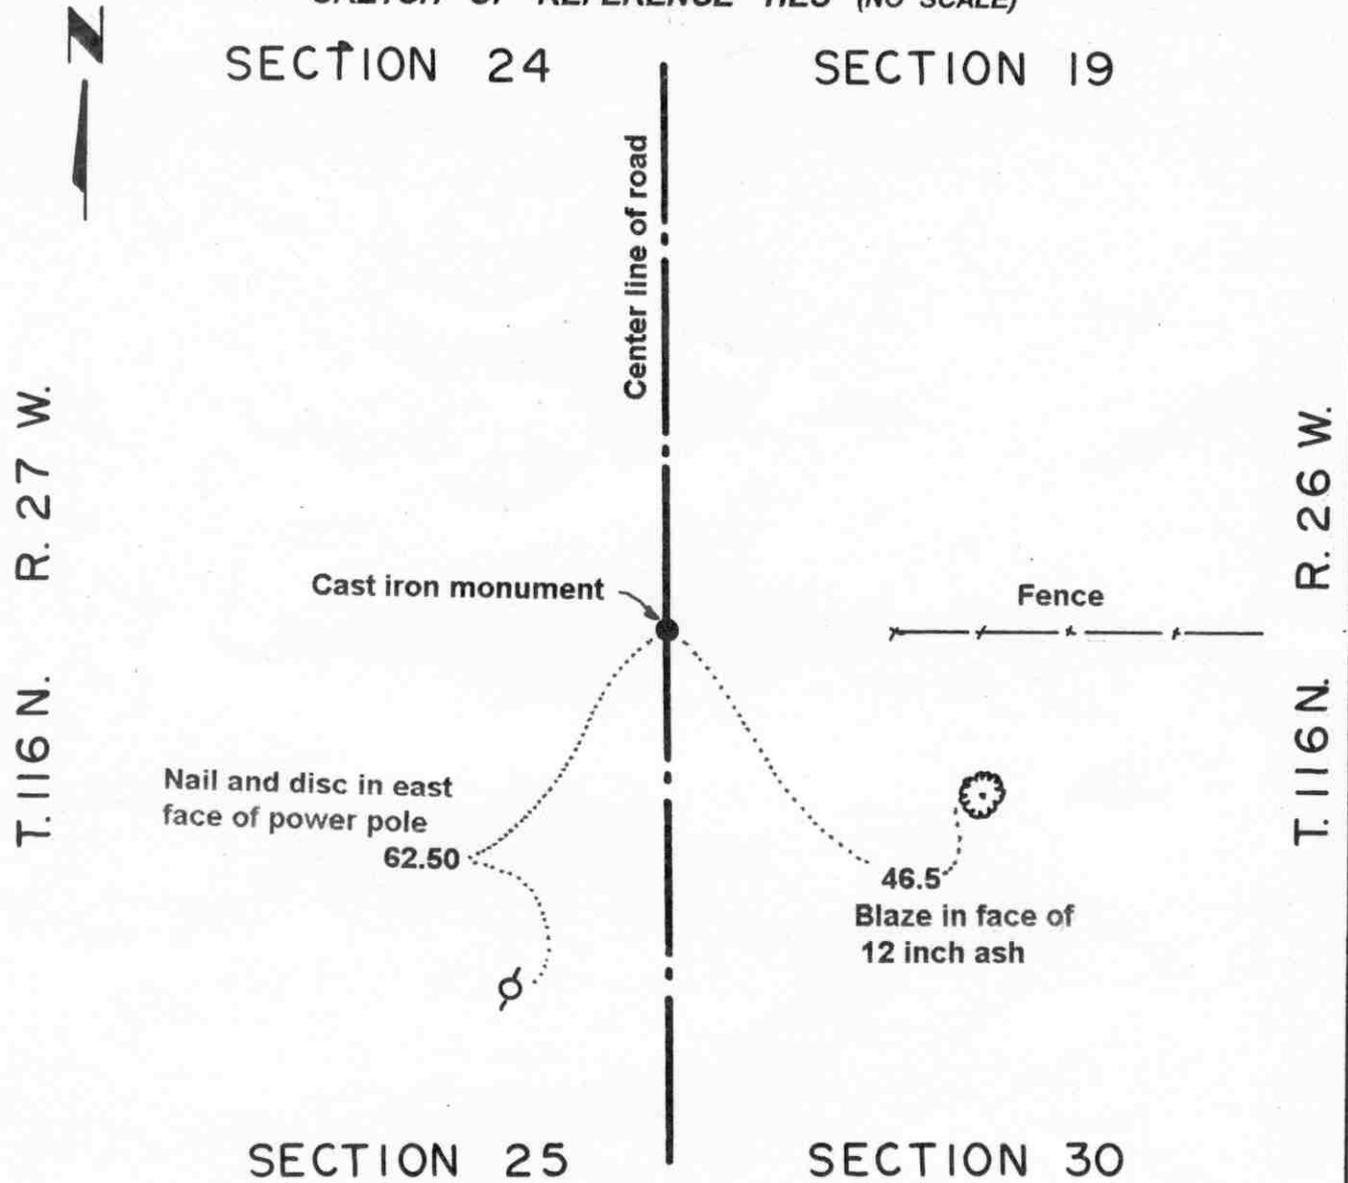

Statement of evidence relative to this corner location on sheet 2

I hereby certify that this document was prepared by me or under my direct supervision.

Willard Pellinen  
 Willard Pellinen  
 McLeod County Surveyor  
 License No. 9626.

Date Oct. 9, 1995

OFFICE OF THE COUNTY RECORDER  
 MCLEOD COUNTY, MINNESOTA

I hereby certify that this document was filed in this office at 9 o'clock A. M. on the 13th day of October 19 95.

Carmen Ostling County Recorder

By \_\_\_\_\_, Deputy.

Document No. 268595

***Certificate of Location of Government Corner  
Northeast Corner, Section 25, Township 116 North, Range 27 West***

***1855. John Ryan of the General Land Office originally established this corner.***

***1968. Lindsey Engineering found a sandstone monument.***

***1971. The Carver County Surveyor dug for the corner with a backhoe. Down 1.3 feet they found a limestone monument. They broke the top 6 inches off and set a cast iron monument over the stone and took new ties. This location was accepted by Dickman Knutson, McLeod County Surveyor.***

***May 15, 1995. We checked the reference ties.***

# Certificate of Location of Government Corner

NORTH QUARTER corner, Section 25, Township 116 North, Range 27 West

SKETCH OF REFERENCE TIES (NO SCALE)



SECTION 24

Nail and bottle cap  
East face of power pole

96.85

cast iron monument

20.00

1/2 inch diam. iron pipes  
in shoulder of road

20.00

Nail and disc  
East face of power pole

220.59

center line of gravel road

SECTION 25

Statement of evidence relative to this corner location on sheet 2

I hereby certify that this document was prepared by me or under my direct supervision.

Willard Pellinen  
Willard Pellinen  
McLeod County Surveyor  
License No. 9626.

Date August 25, 1994.

OFFICE OF THE COUNTY RECORDER  
MCLEOD COUNTY, MINNESOTA

I hereby certify that this document was filed in this office at 9 o'clock A. M. on the 9th day of Sept 19 94.

Carmen Estlie Mulder, County Recorder

By \_\_\_\_\_, Deputy.

Document No. 261759

## ***Certificate of Location of Government Corner***

***North Quarter Corner, Section 25, Township 116 North, Range 27 West***

***November, 1856. E. N. Darling of the General Land Office set a post and marked a 5 inch and a 6 inch aspen for bearing trees.***

***May 19, 1975. Dickman Knutson, county surveyor, dug for the corner (John Tupa from Hutchinson with a backhoe). Down 1 1/2 feet below the surface of the gravel road they found a 6 inch diameter stone, a 1/2 inch diameter iron pipe beside the stone. They took reference ties. This was on the center line of the north-south road, field lines east and west. This iron pipe was the same type found at the north quarter corner of Section 24.***


***April 12, 1978. Knutson set a McLeod County cast iron monument at the corner.***

***August 23, 1994. We found the monument in good condition and checked the reference ties.***

# Certificate of Location of Government Corner

EAST QUARTER corner, Section 26, Township 116 North, Range 27 West

## SKETCH OF REFERENCE TIES (NO SCALE)

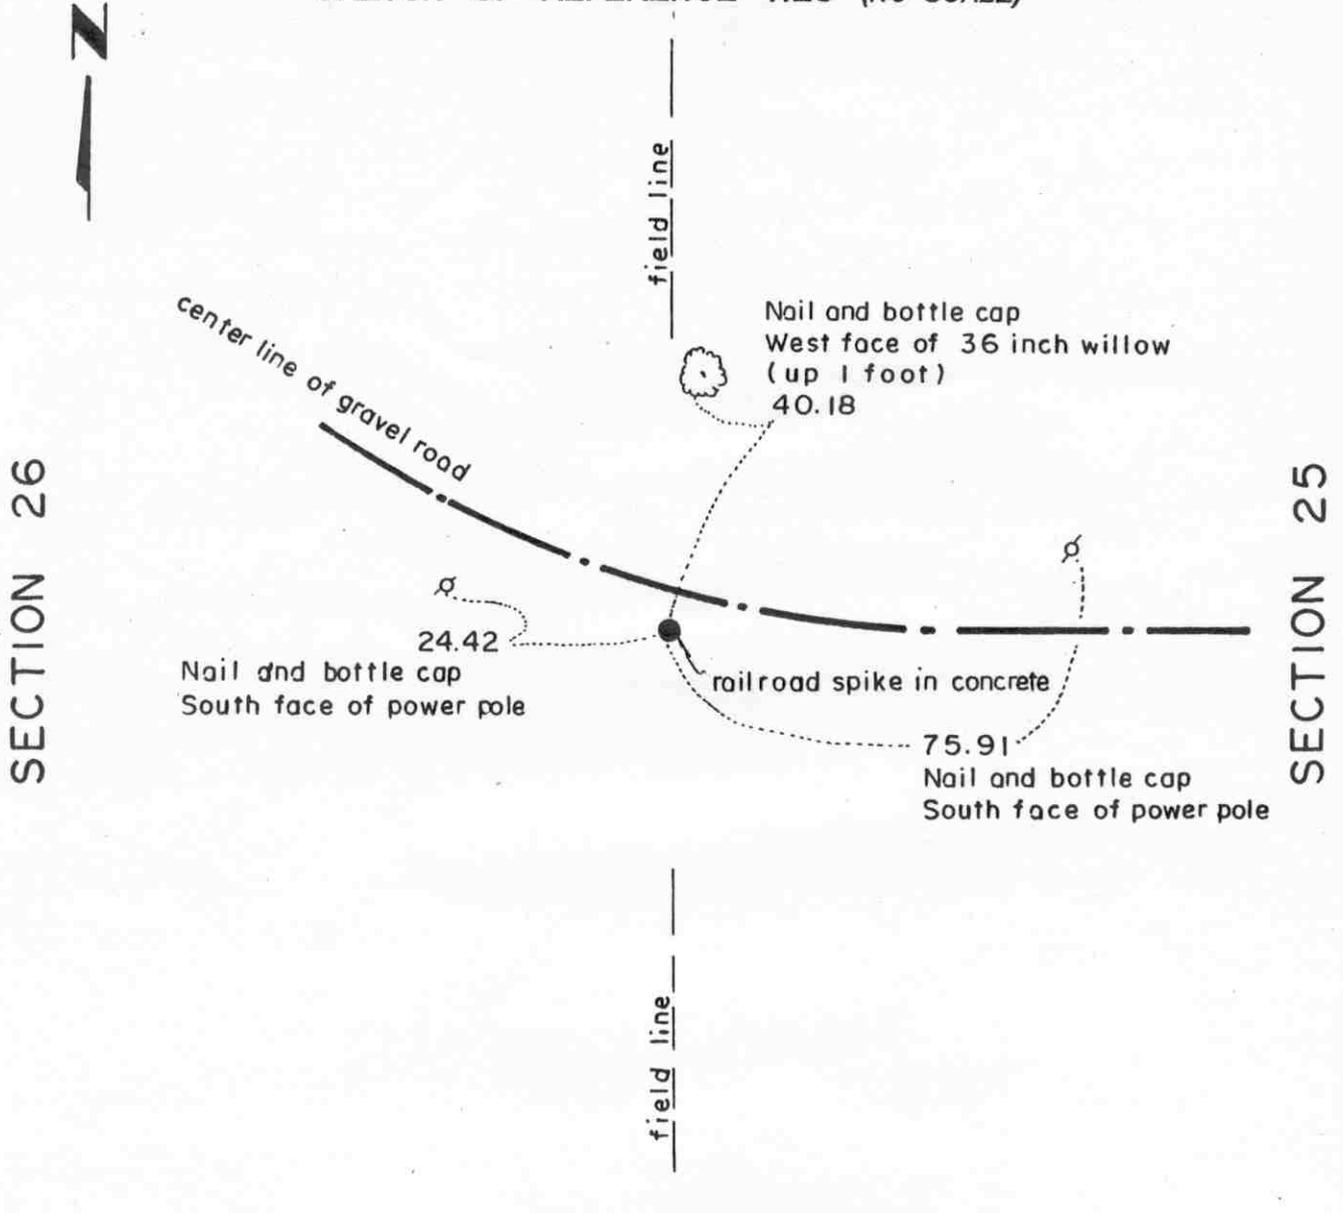

**Statement of evidence relative to this corner location on sheet 2**

I hereby certify that this document was prepared by me or under my direct supervision.

Willard Pellinen  
 Willard Pellinen  
 McLeod County Surveyor  
 License No. 9626.

Date Sept. 7, 1994

**OFFICE OF THE COUNTY RECORDER  
 MCLEOD COUNTY, MINNESOTA**

I hereby certify that this document was filed in this office at 9 o'clock A. M. on the 22nd day of September 19 94.

Carmen Ottilie Mulder, County Recorder

By \_\_\_\_\_, Deputy.

Document No. 261943

## **Certificate of Location of Government Corner**

### **East Quarter Corner, Section 26, Township 116 North, Range 27 West**

**November, 1856. E. N. Darling of the General Land Office originally established this corner. He set a post and marked a 5 inch and a 6 inch aspen for bearing trees.**

**July 9, 1982. Mr. Delmer Herrmann, who had lived in the West Half of the Northwest Quarter of Section 25 for 31 years, said the corner is a steel post set in concrete. It was set by Henry Templin Sr. before Mr. Herrmann moved to the farm. It has been accepted by adjoining land owners as marking the quarter corner.**

**August 30, 1982. We took available reference ties to the post.**

**August 23, 1994. The steel post was gone. We dug and found the concrete base with part of the steel post down 1 foot below the surface. We used the old ties and set a railroad spike in the concrete and took additional ties.**

**This corner is 7.75 feet north and 6.8 feet west of a lost position for the corner.**

# Certificate of Location of Government Corner

NORTHEAST corner, Section 26, Township 116 North, Range 27 West

SKETCH OF REFERENCE TIES (NO SCALE)



SECTION 23

SECTION 24

Field line

Cast iron monument

0.4 North face of wood post.

- 2619.11 feet to the N1/4 cor of Sec 26
- 2621.32 feet to the E1/4 cor of Sec 26
- 2680.23 feet to the E1/4 cor of Sec 23
- 2645.86 feet to the N1/4 cor of Sec 25

Field line

SECTION 26

SECTION 25

Statement of evidence relative to this corner location on sheet 2

I hereby certify that this document was prepared by me or under my direct supervision.

Willard Pellinen

Willard Pellinen  
McLeod County Surveyor  
License No. 9626.

Date Dec. 13, 1990

OFFICE OF THE COUNTY RECORDER  
MCLEOD COUNTY, MINNESOTA

I hereby certify that this document was filed in this office at 9 o'clock A. M. on the 9th day of January 19 96.

Carmen Ostlie Mulder, County Recorder

By Charles Engelman, Deputy

Document No. 270204

**Certificate of Location of Government Corner**  
**Northeast Corner, Section 26, Township 116 North, Range 27 West**

*November, 1856. E. N. Darling of the General Land Office established this corner. He set a post and marked a 10 inch oak, 2 ten inch elms and a 7 inch aspen for bearing trees.*

*July 9, 1982. Mr. Delmer Herrmann, who had lived in the Northwest Quarter of Section 25 for 31 years, testified that a post at the northwest corner of Section 25 has been accepted by adjoining land owners as the the section corner. He said the post was there when he moved to the farm.*

*March 19, 1984. Mr. Clarence Bonine, who had lived in the Northeast Quarter of Section 26 for 16 years, also said the post is the section corner.*


*July 18, 1985. We set a McLeod County cast iron monument at the corner and moved the post to the south side of the monument.*

NORTH QUARTER corner, Section 26, Township 116 North, Range 27 West

# Certificate of Location of Government Corner

SKETCH OF REFERENCE TIES  
(NO SCALE)

SECTION 23

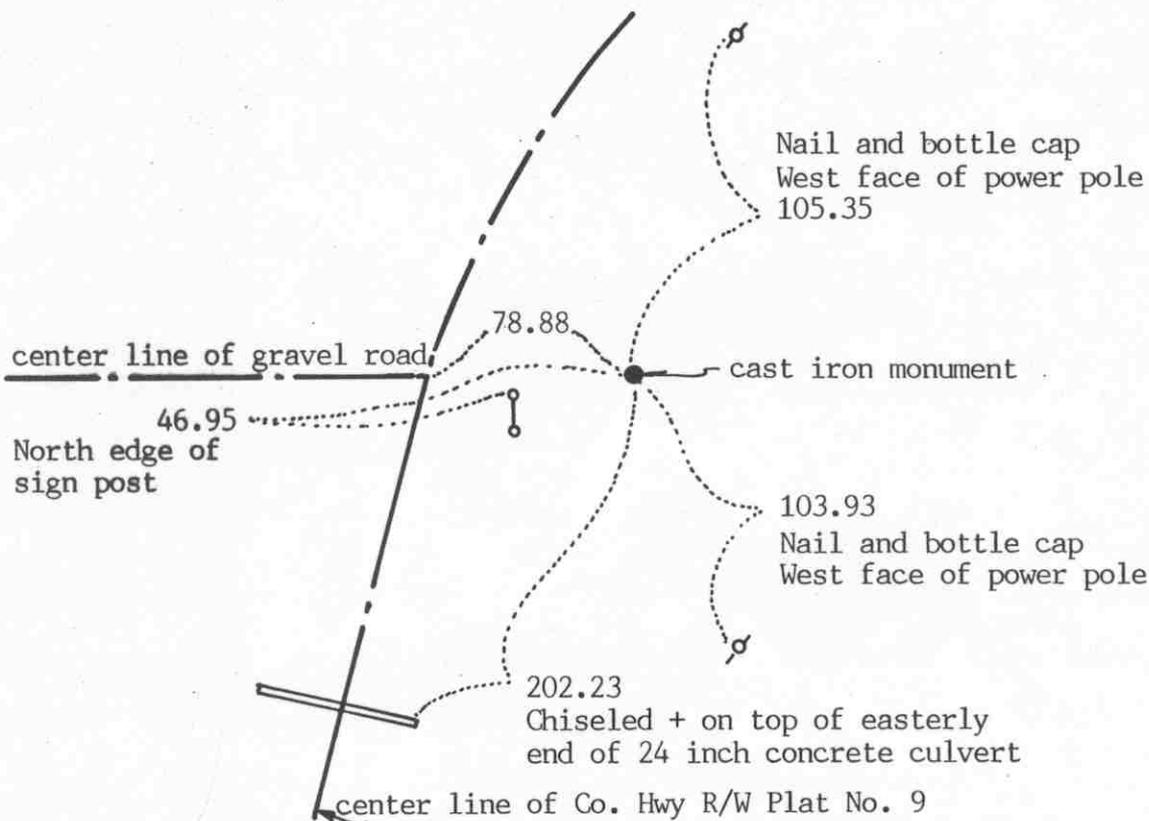

SECTION 26

Statement of evidence relative to this corner location on sheet 2

I hereby certify that this document was prepared by me or under my direct supervision.

Willard Pellinen

Willard Pellinen  
McLeod County Surveyor  
License No. 9626

Date June 7, 1992

OFFICE OF THE COUNTY RECORDER  
MCLEOD COUNTY, MINNESOTA.

I hereby certify that this document was filed in this office at 9 o'clock A.M. on the 9th day of June, 19 92.

Armer Ostlie, County Recorder

By \_\_\_\_\_, Deputy

Document No. 245778

NORTH QUARTER corner, Section 26, Township 116 North, Range 27 West

## Certificate of Location of Government Corner

November, 1856. E. N. Darling of the General Land Office first established this corner. He set a post and marked 2 aspens for bearing trees.

June 21, 1971. McCombs Knutson Associates (Dickman Knutson, county surveyor) dug for the corner, John Tupa from Hutchinson with a backhoe. Down  $5\frac{1}{2}$  feet below the road surface they found a rotted wood stake with 4 stones around it. They left the stake in place and took reference ties. This was in the center line of the east-west road, in line with a fence to the north.

July 21, 1971. Knutson set a McLeod County cast iron monument at the corner.


August 15, 1991. We found the monument gone through road construction and all the old reference ties destroyed. We reset the corner using ties we had taken before the construction and took new reference ties.

The location used by Knutson in setting the monument is accepted as marking the location of the quarter corner. It perpetuates the location of an older monument, the wood stake, and it fits the old occupation lines, the center of the road and the fence to the north.

# Certificate of Location of Government Corner

## SKETCH OF REFERENCE TIES

(NO SCALE)

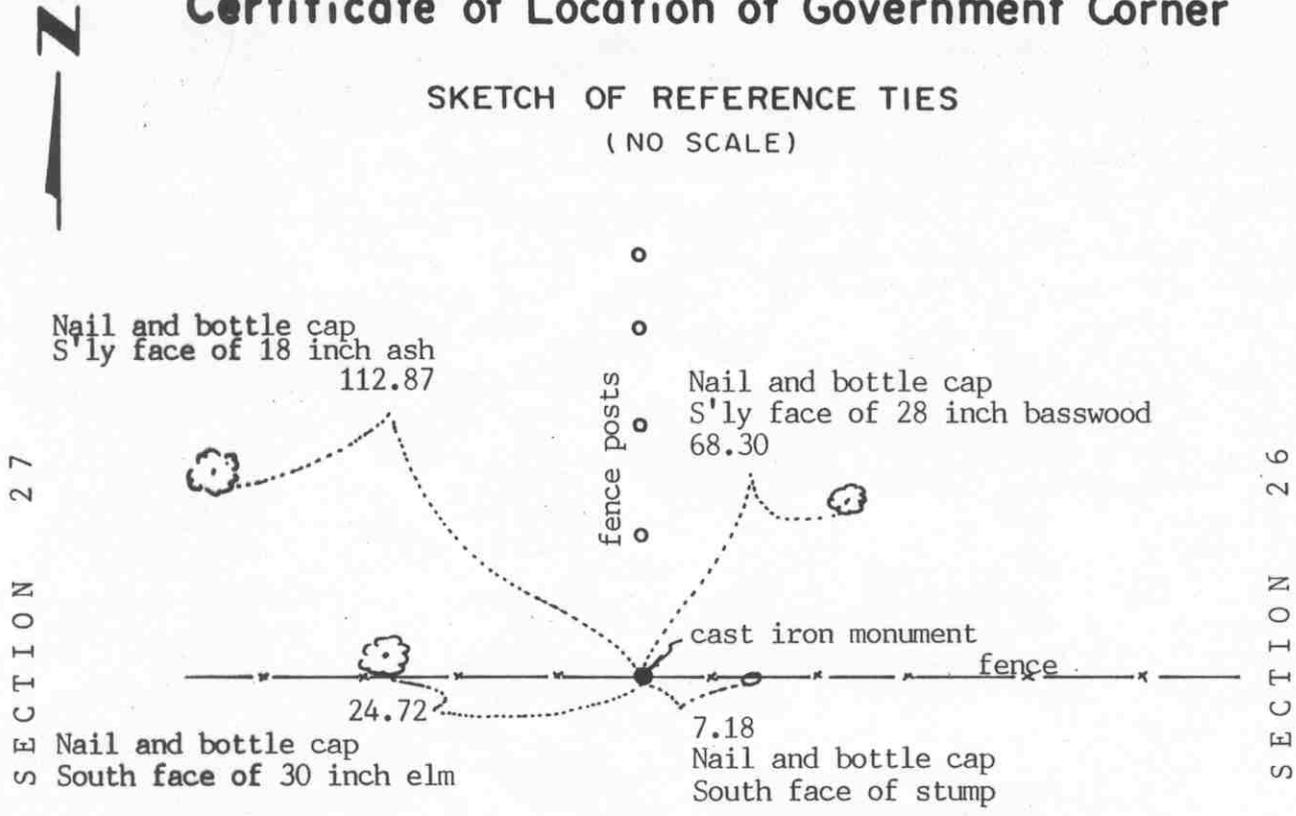

### Statement of evidence relative to this corner location on sheet 2

I hereby certify that this document was prepared by me or under my direct supervision.

Willard Pellinen  
Willard Pellinen  
McLeod County Surveyor  
License No. 9626

Date June 7, 1992

### OFFICE OF THE COUNTY RECORDER MCLEOD COUNTY, MINNESOTA.

I hereby certify that this document was filed in this office at 9 o'clock A.M. on the 9th day of June, 1992.

Armen (Belle), County Recorder

By \_\_\_\_\_, Deputy

Document No. 245780

EAST QUARTER corner, Section 27, Township 116 North, Range 27 West

## *Certificate of Location of Government Corner*

November, 1856. E. N. Darling of the General Land Office first established this corner. He set a post and marked 2 bur oaks for bearing trees.

April 2, 1984. We set a temporary corner, a  $\frac{1}{2}$  inch diameter iron pipe along the east west fence line in line with some wood fence posts to the north.

July 18, 1985. Mr. Marvin Prehn who owns land in Sections 26 and 27, the only land owner adjoining this corner, says he thinks our temporary corner is in the correct location. We replaced the iron pipe with a McLeod County cast iron monument and took reference ties.

This corner is within a half a foot of being half way between the section corners but is about 24 feet east of a straight line between the section corners.

There being no evidence to the contrary, we accept this location as marking the quarter corner.

NORTHEAST corner, Section 27, Township 116 North, Range 27 West




# Certificate of Location of Government Corner

## SKETCH OF REFERENCE TIES (NO SCALE)

SECTION 22

SECTION 23

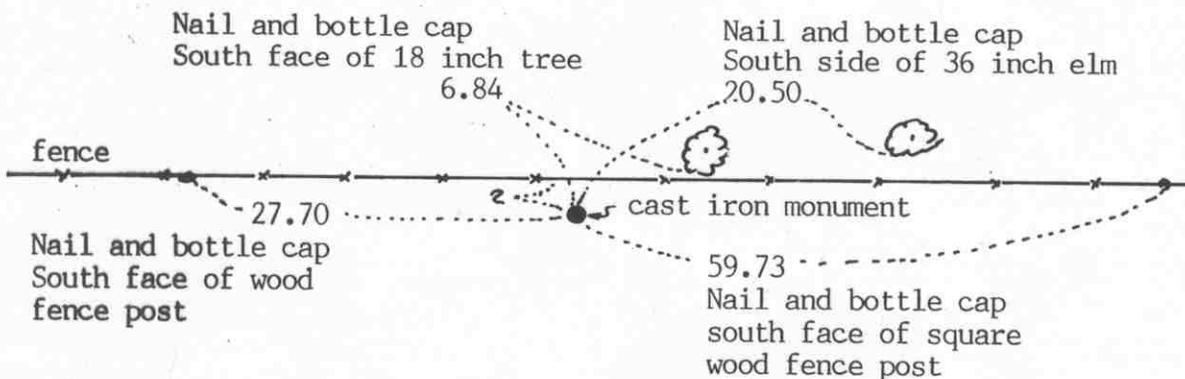

SECTION 27

SECTION 26

Statement of evidence relative to this corner location on sheet 2

I hereby certify that this document was prepared by me or under my direct supervision.

Willard Pellinen

Willard Pellinen  
McLeod County Surveyor  
License No. 9626

Date June 7, 1992

OFFICE OF THE COUNTY RECORDER  
MCLEOD COUNTY, MINNESOTA.

I hereby certify that this document was filed in this office at 9 o'clock A. M. on the 9th day of June, 1992.

Carmen Ostlie, County Recorder

By \_\_\_\_\_, Deputy

Document No. 245779

## Certificate of Location of Government Corner

November, 1856. E. N. Darling of the General Land Office first established this corner. He set a post and marked 4 bur oaks for bearing trees.

1984. Adjoining land owners don't know where the corner is. There are no property lines running north or south from this corner. Owners say fence was put on the north side of the section line about 60 years ago.

We measured the north line of Section 26 and 27 and set a temporary corner half way between the north quarter corner of section 26 and the north quarter corner of section 27.

November 25, 1984. We found a rotted wood stake and an iron pipe within a few feet of our temporary corner about 2 feet south of the east-west fence line. We set a McLeod County cast iron monument and took reference ties.

August 15, 1991. We found the monument in good condition and the reference ties good.

There being no evidence to the contrary, we accept the iron pipe and wood stake as having perpetuated the location of the section corner.


NORTH QUARTER corner, Section 27, Township 116 North, Range 27 West

# Certificate of Location of Government Corner

## SKETCH OF REFERENCE TIES

(NO SCALE)

### SECTION 22

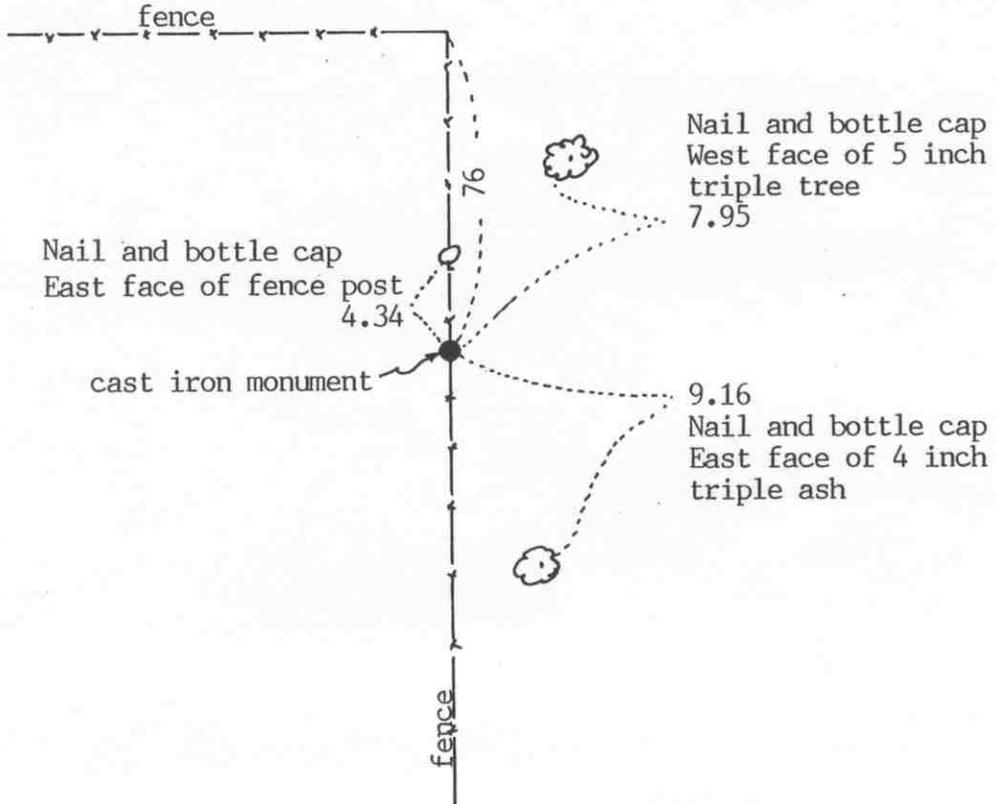

### SECTION 27

Statement of evidence relative to this corner location on sheet 2

I hereby certify that this document was prepared by me or under my direct supervision.

Willard Pellinen

Willard Pellinen  
McLeod County Surveyor  
License No. 9626

Date July 23, 1993

OFFICE OF THE COUNTY RECORDER  
MCLEOD COUNTY, MINNESOTA.

I hereby certify that this document was filed in this office at 4 o'clock P.M. on the 5th day of August, 19 93.

Carman Estlin Mulder, County Recorder

By \_\_\_\_\_, Deputy

Document No. 253989

NORTH QUARTER corner, Section 27, Township 116 North, Range 27 West

## Certificate of Location of Government Corner

November, 1856. E.N.Darling of the General Land Office established this corner. He set a post and marked a 10 inch and a 14 inch oak for bearing trees.

March, 1984. We measured the north line of Section 27 and set a temporary quarter corner along a north-south fence. Mr. Harold Wroge, in the Northwest Quarter of Section 27 said the fence has always been accepted as being on the north-south quarter line of Section 27 and Section 22. No property lines to the east and west, same owners in Sections 22 and 27.

September 17, 1984. We set a McLeod County cast iron monument along the north-south fence line 2 feet south of the westerly extension of a fence to the east. This fence, according to property owners, was set north of the section line. We found the northeast corner of Section 27 to be 2 feet south of the fence.

The cast iron monument is 57.75 feet west and 32.6 feet north of a lost position for the corner.

March 9, 1993. We found the monument in good condition and checked the reference ties.

EAST QUARTER corner, Section 28, Township 116 North, Range 27 West


# Certificate of Location of Government Corner

## SKETCH OF REFERENCE TIES (NO SCALE)



SECTION 28

SECTION 27

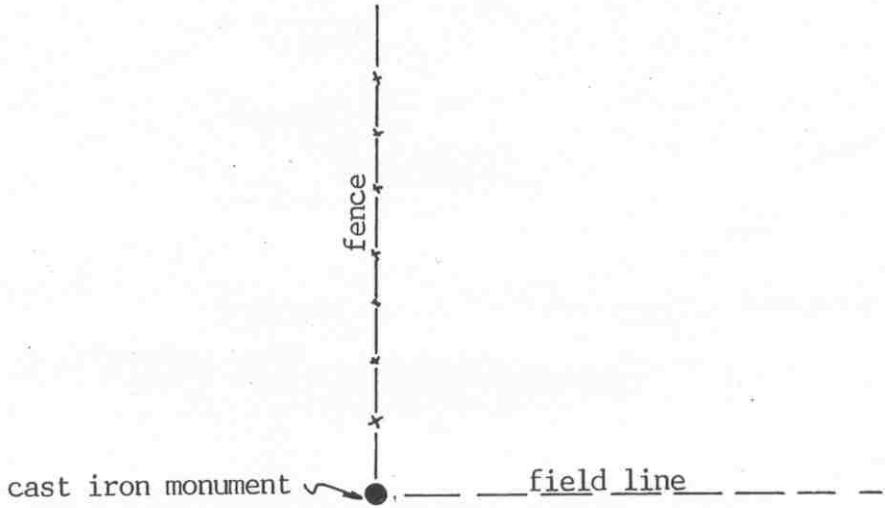

- 2672.34 feet to the northeast corner of Section 28
- 2631.66 feet to the southeast corner of Section 28
- 5311.66 feet to the east quarter corner of Section 27

Angle at east side of quarter corner turned from the northeast corner of Section 28 to the southeast corner of Section 28 is  $179^{\circ} 01' 21''$ .

Statement of evidence relative to this corner location on sheet 2

I hereby certify that this document was prepared by me or under my direct supervision.

Willard Pellinen

Willard Pellinen  
McLeod County Surveyor  
License No. 9626

Date July 26, 1993

OFFICE OF THE COUNTY RECORDER  
MCLEOD COUNTY, MINNESOTA.

I hereby certify that this document was filed in this office at 4 o'clock P. M. on the 5th day of August, 1993.

Carmen Estelle Mulder, County Recorder

By \_\_\_\_\_, Deputy

Document No. 253990

EAST QUARTER \_\_\_\_\_ corner, Section 28, Township 116 North, Range 27 West

## *Certificate of Location of Government Corner*

November, 1856. E.N.Darling of the General Land Office established this corner. He set a post and marked a 14 inch and a 5 inch oak for bearing trees.

September 22, 1977. Dickman Knutson, county surveyor, set a cast iron monument at a fence corner, fences north and east. Mr. Ed Hoernemann, 76 years old and had lived in the Southwest Quarter of Section 27 for 51 years said these fences are on the section and quarter lines.

This corner falls 20.34 feet south and 22.42 feet west of a lost position for this corner.

March 9, 1993. We found the monument in good condition. No available reference ties. There is a fence running north and a field line to the east now.

The monument set by Knutson is accepted as marking the correct location of the quarter corner. It fits long standing occupation lines, the fences.

# Certificate of Location of Government Corner

NORTHEAST corner, Section 28, Township 116 North, Range 27 West

SKETCH OF REFERENCE TIES (NO SCALE)



SECTION 21

SECTION 22

2631.01 feet to N1/4 cor Sec 28  
2672.34 feet to E1/4 cor Sec 28  
2614.95 feet to E1/4 cor Sec 21  
2634.10 feet to N1/4 cor Sec 27

Nail and disc in south  
face of wood post. 0.78

Cast iron monument

63.00 1/2 inch iron pipe

25.00 1/2 inch iron pipe

DITCH

40.70 1/2 inch iron pipe

SECTION 28

SECTION 27

Statement of evidence relative to this corner location on sheet 2

I hereby certify that this document  
was prepared by me or under my  
direct supervision.

Willard Pellinen  
Willard Pellinen  
McLeod County Surveyor  
License No. 9626.

Date Dec. 13, 1995

OFFICE OF THE COUNTY RECORDER  
MCLEOD COUNTY, MINNESOTA

I hereby certify that this document was filed in this office at 9  
o'clock A.M. on the 9th day of January  
19 96.

Carmen Estlie Mulder, County Recorder

By Charleen Engelman, Deputy.

Document No. 270205

**Certificate of Location of Government Corner**  
**Northeast Corner, Section 28, Township 116 North, Range 27 West**

**November, 1856. E. N. Darling of the General Land Office established this corner. He set a post and marked a 12 inch oak for a bearing tree and built a mound of earth.**

**September 22, 1977. Adjoining land owners agree a wood post at the corner is the section corner.**

**June 27, 1979. We set a McLeod County cast iron monument at the location of the wood post and moved the post to the east of the monument and took available reference ties.**


# Certificate of Location of Government Corner

## SKETCH OF REFERENCE TIES

(NO SCALE)



SECTION 21

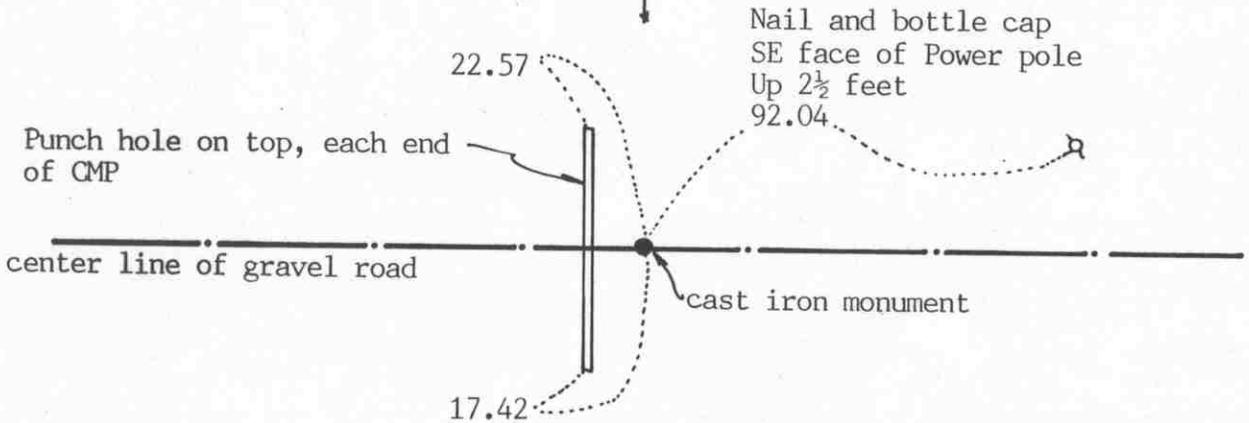

SECTION 28

### Statement of evidence relative to this corner on sheet 2

I hereby certify that this document was prepared by me or under my direct supervision.

Willard Pellinen  
Willard Pellinen  
McLeod County Surveyor  
License No. 9626.

Date January 18, 1992

OFFICE OF THE COUNTY RECORDER  
MCLEOD COUNTY, MINNESOTA.

I hereby certify that this document was filed in this office at 1 o'clock P.M. on the 27th day of January, 1992.

Carmen O'Brien, County Recorder.

By \_\_\_\_\_ Deputy.

Document No. 243062 NO FEE.

NORTH QUARTER corner, Section 28, Township 116 North, Range 27 West

## Certificate of Location of Government Corner

This corner was originally established by the government in November, 1856. E.N.Darling set a post and marked 2 oaks for bearing trees.

September 23, 1977. McCombs Knutson Associates (Dickman Knutson, county surveyor) dug for the corner. (John Tupa from Hutchinson with a backhoe) They dug at the center line of the east west road in line with a fence to the north which as been accepted by the adjoining land owners as being on the quarter line. Down 4 feet below the road surface they found a 4 inch square stone 10 inches long, set on end. They tied it off and left the stone in place.

Knutson set a  $\frac{1}{2}$  inch diameter iron pipe over the stone.

June 11, 1979. We replaced the iron pipe with a McLeod County cast iron monument.


February 6, 1991. We found the monument in good condition and checked the reference ties.

We accept the stone found by Knutson as having perpetuated the correct location of the quarter corner. It fits the occupation lines, the fence to the north and the center line of the east-west road.

# Certificate of Location of Government Corner

EAST QUARTER corner, Section 29, Township 116 North, Range 27 West

SKETCH OF REFERENCE TIES (NO SCALE)

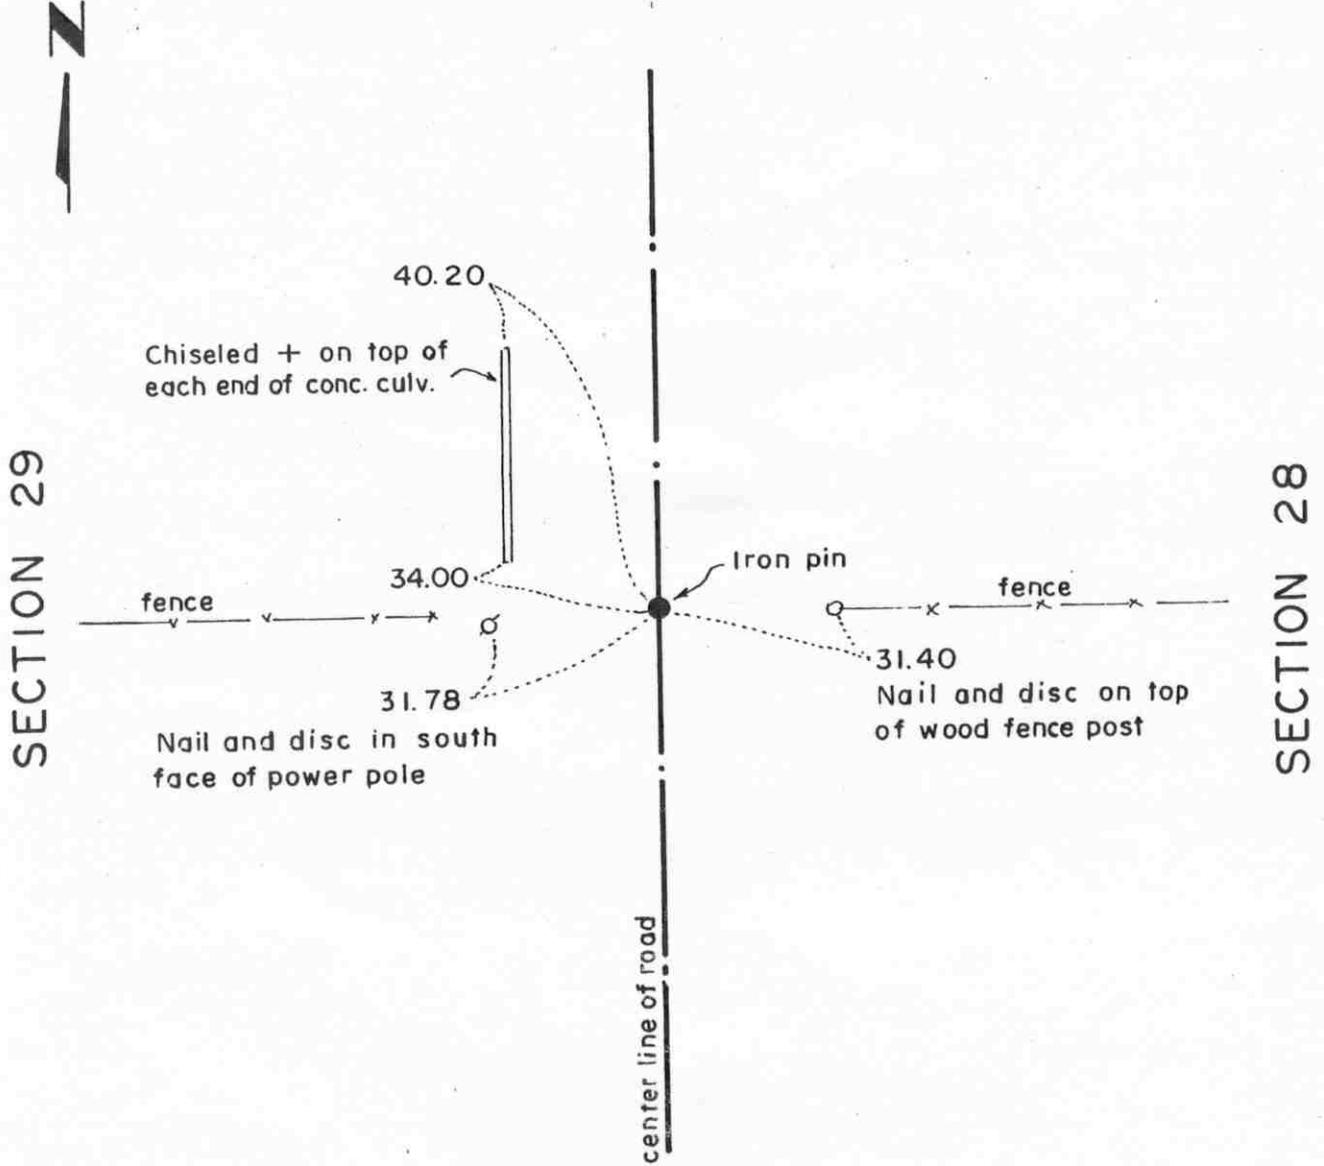

Statement of evidence relative to this corner location on sheet 2

I hereby certify that this document was prepared by me or under my direct supervision.

Willard Pellinen  
 Willard Pellinen  
 McLeod County Surveyor  
 License No. 9626.

Date Jan 4, 1995

OFFICE OF THE COUNTY RECORDER  
 MCLEOD COUNTY, MINNESOTA

I hereby certify that this document was filed in this office at 9 o'clock A.M. on the 10th day of January, 1995.

Carmen Helie Mulder County Recorder

By \_\_\_\_\_, Deputy.

Document No. 263636

## ***Certificate of Location of Government Corner***

***East Quarter Corner, Section 29, Township 116 North, Range 27 West***

***November, 1856. E. N. Darling of the General Land Office established this corner. He set a post in a wet marsh and marked a 5 inch oak and a 6 inch aspen for bearing trees.***

***1935. County engineer found a railroad spike at the corner.***

***January 23, 1975. State Highway Department searched the area with a metal locator but found nothing. They placed a 3/4 inch iron pin at the location according to the 1941 alignment notes received from the county engineer who found a railroad spike at this location in 1935.***


***This corner is 2.73 feet south and 1.07 feet west of a lost position for this corner.***

***January 3, 1995. We checked the reference ties***

# Certificate of Location of Government Corner

## SKETCH OF REFERENCE TIES

(NO SCALE)

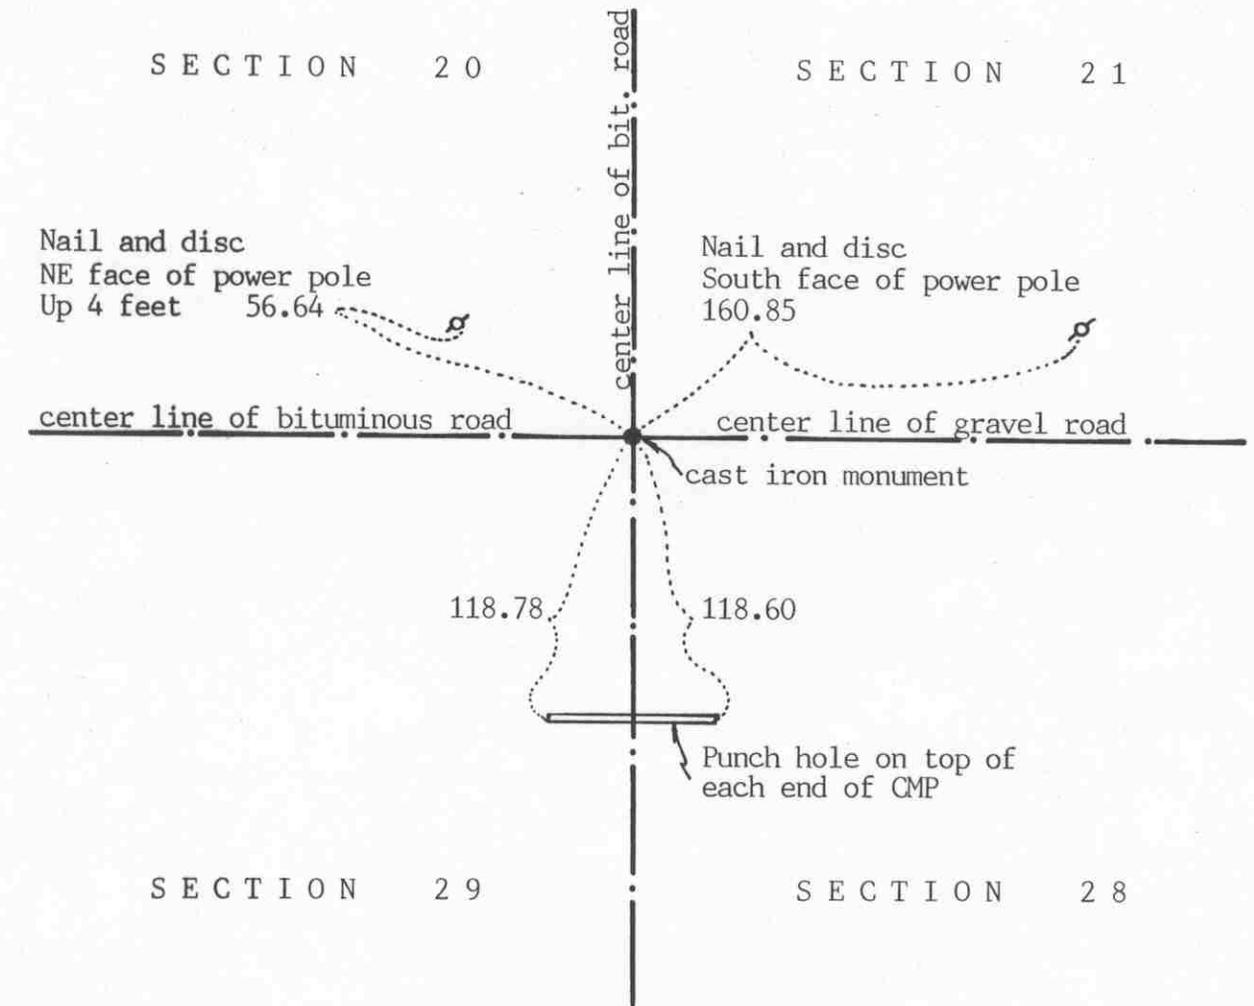

### Statement of evidence relative to this corner on sheet 2

I hereby certify that this document was prepared by me or under my direct supervision.

Willard Pellinen  
Willard Pellinen  
McLeod County Surveyor  
License No. 9626.

Date January 18, 1992

OFFICE OF THE COUNTY RECORDER  
MCLEOD COUNTY, MINNESOTA.

I hereby certify that this document was filed in this office at 1 o'clock P.M. on the 27th day of January, 1992.

Carmen Botlie, County Recorder.

By \_\_\_\_\_ Deputy.

Document No. 243063 NO FEE.

NORTHEAST corner, Section 29, Township 116 North, Range 27 West

## Certificate of Location of Government Corner

November, 1856. E.N.Darling of the General Land Office set a post at the corner and marked 4 trees for bearing trees.

January 23, 1975. The State Highway Department placed a 3/4 inch iron pin as per 1941 alignment notes from the the county engineer who found a railroad spike at the location in 1935.

July 29, 1975. McCombs Knutson Associates (Dickman Knutson, county surveyor) found the iron pin and took reference ties.

June 14, 1979. We replaced the iron pin with a McLeod County cast iron monument.

February 6, 1991. We found the cast iron monument in good condition and checked the reference ties.

There being no evidence to the contrary, we accept the iron pin set by the State Highway Department as having perpetuated the correct location of the section corner.

# Certificate of Location of Government Corner


NORTH QUARTER corner, Section 29, Township 116 North, Range 27 West

SKETCH OF REFERENCE TIES (NO SCALE)

SECTION 20

T. 116 N.

R. 27 W.

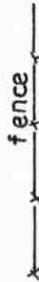

Nail and bottle cap in south face of power pole, up 4 feet.

89.93


cast iron monument

center line of road

39.86

40.64

Punch hole on top of each end of C.M.P.

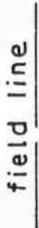

SECTION 29

T. 116 N.

R. 27 W.

Statement of evidence relative to this corner location on sheet 2

I hereby certify that this document was prepared by me or under my direct supervision.

Willard Pellinen  
Willard Pellinen  
McLeod County Surveyor  
License No. 9626.

Date Jan 4, 1995

OFFICE OF THE COUNTY RECORDER  
MCLEOD COUNTY, MINNESOTA

I hereby certify that this document was filed in this office at 9 o'clock A. M. on the 10th day of January, 1995.

Carmen Helie Mulder County Recorder

By \_\_\_\_\_, Deputy.

Document No. 263637

## ***Certificate of Location of Government Corner***

***North Quarter Corner, Section 29, Township 116 North, Range 27 West***

***November, 1856. E. N. Darling of the General Land Office established this corner. He set a post in a slough and marked two 20 inch elms for bearing trees.***

***February 4, 1982. We set a temporary quarter corner on the center of the east-west road in line with a fence and tree line to the north.***

***July 26, 1982. We excavated for the corner. We dug a hole 8 feet wide, 15 feet long along the center line but found no evidence of the corner.***


***July 22, 1983. We set a McLeod County cast iron monument at our temporary corner location. The fence to the north has been accepted as being on the quarter line by adjoining land owners. This corner is 9-10 feet west of being on a split between the section corners.***

***January 3, 1995. We checked the reference ties to the monument.***

# Certificate of Location of Government Corner

EAST QUARTER corner, Section 30, Township 116 North, Range 27 West

## SKETCH OF REFERENCE TIES (NO SCALE)

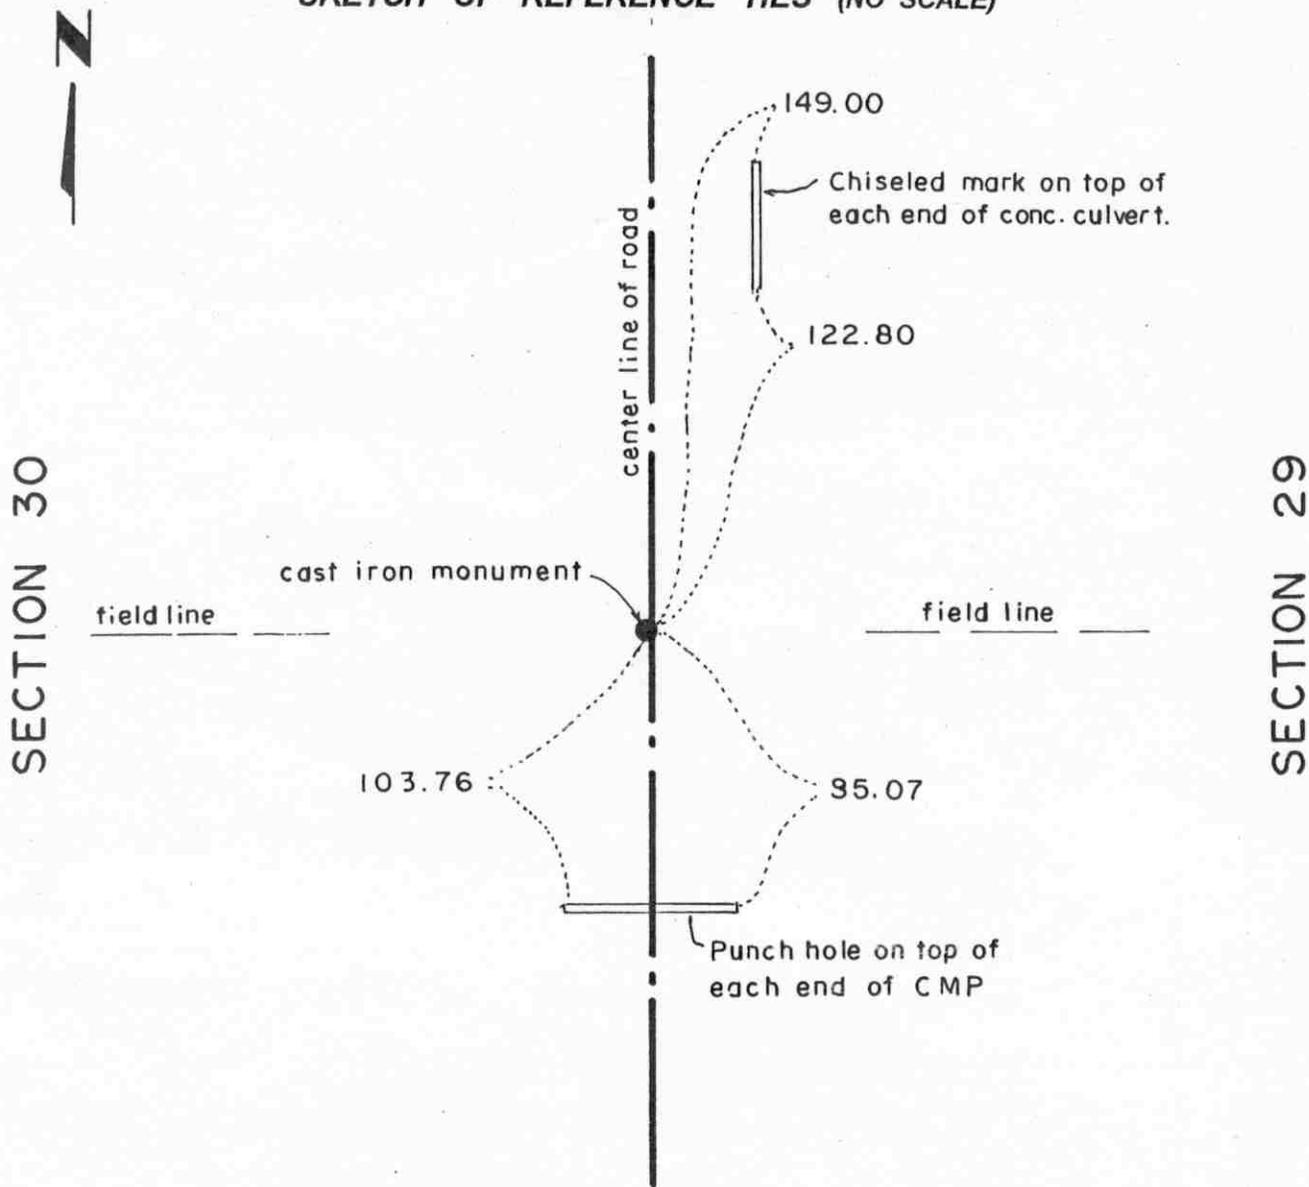

**Statement of evidence relative to this corner location on sheet 2**

I hereby certify that this document was prepared by me or under my direct supervision.

Willard Pellinen  
 Willard Pellinen  
 McLeod County Surveyor  
 License No. 9626.

Date Jan. 4, 1995

**OFFICE OF THE COUNTY RECORDER  
 MCLEOD COUNTY, MINNESOTA**

I hereby certify that this document was filed in this office at 9 o'clock A. M. on the 10th day of January, 19 95.

Carmen Ottilie Mulder, County Recorder

By \_\_\_\_\_, Deputy.

Document No. 263638

## **Certificate of Location of Government Corner**

**East Quarter Corner, Section 30, Township 116 North, Range 27 West**

**November, 1856. E. N. Darling of the General Land Office established this corner. He set a post in a wet slough and marked a 6 inch willow and an 8 inch aspen for bearing trees.**

**November, 1974. R.C.M., surveyors from Gaylord Mn., excavated for the corner and found a broken off fence post down 3 feet below the surface of the road. Post was rotted, 4 inches in diameter and 4 feet long. This was in the center of the north-south road, in line with field lines east and west. They tied off the post and set an iron pipe at the surface of the road.**

**July 29, 1975. Dickman Knutson, county surveyor, replaced the iron pipe with a McLeod County cast iron monument and took available ties.**


**This corner is 10.98 feet north of a split between the section corners and 0.14 west of a straight line between the section corners.**

**January 3, 1995. We checked the reference ties to the monument.**

# Certificate of Location of Government Corner

Northeast corner, Section 30, Township 116 North, Range 27 West

## SKETCH OF REFERENCE TIES (NO SCALE)

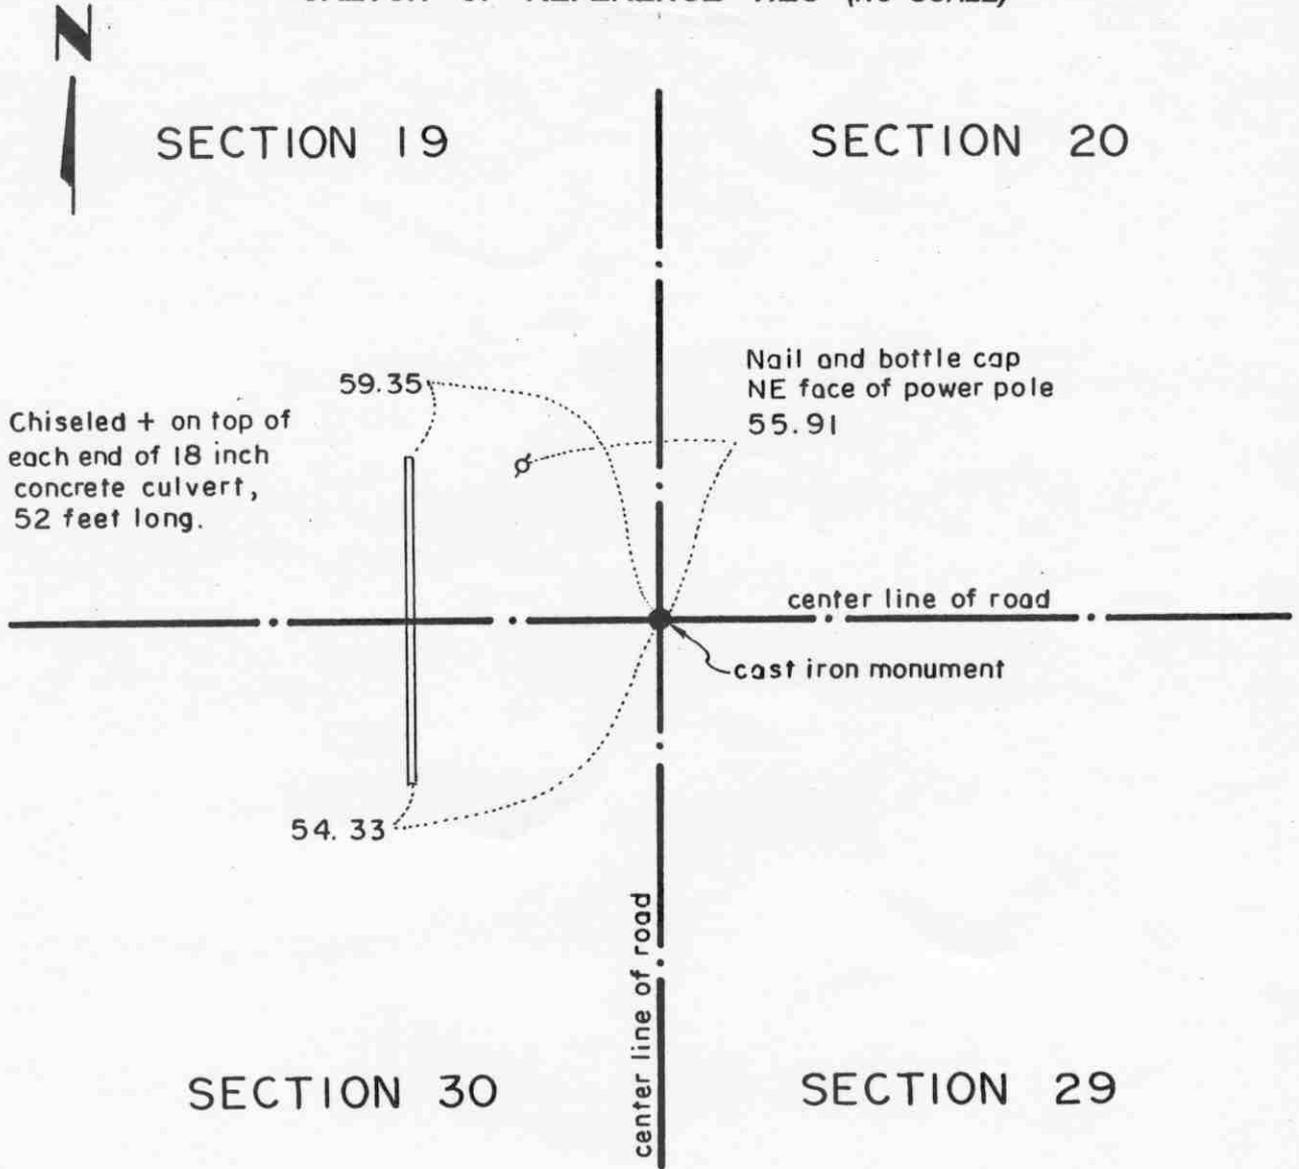

**Statement of evidence relative to this corner location on sheet 2**

I hereby certify that this document was prepared by me or under my direct supervision.

Willard Pellinen

Willard Pellinen  
McLeod County Surveyor  
License No. 9626.

Date Sept. 13, 1994

**OFFICE OF THE COUNTY RECORDER  
MCLEOD COUNTY, MINNESOTA**

I hereby certify that this document was filed in this office at 9 o'clock A M. on the 22nd day of September 19 94.

Carmen Ottilie Mulder, County Recorder

By \_\_\_\_\_, Deputy.

Document No. 261944

## ***Certificate of Location of Government Corner***

### ***Northeast Corner, Section 30, Township 116 North, Range 27 West***

***November, 1856. E. N. Darling of the General Land Office originally established this corner. He set a post and marked a 6 inch aspen, a 7 inch aspen, a 10 inch elm and an 8 inch elm for bearing trees.***

***February, 1982. We set a temporary section corner on the intersection of the center lines of roads north, south, east and west.***

***July 16, 1982. Ruben Michaletz, 55 years old and lived in the Northwest Quarter of Section 29 since 1949, said there is a "marker" at the corner.***

***July 26, 1982. We excavated for the corner, John Tupa from Hutchinson with a backhoe. Down 2 feet below the surface of the gravel road we found a half inch diameter iron pipe. We dug a hole 8 feet by 8 feet by 6 feet deep but found no evidence of the original government corner. We took available reference ties to the iron pipe before we dug deeper.***

***August 25, 1982. We set a McLeod County cast iron monument at the corner.***


# Certificate of Location of Government Corner

North Quarter corner, Section 30, Township 116 North, Range 27 West

SKETCH OF REFERENCE TIES (NO SCALE)



## SECTION 19

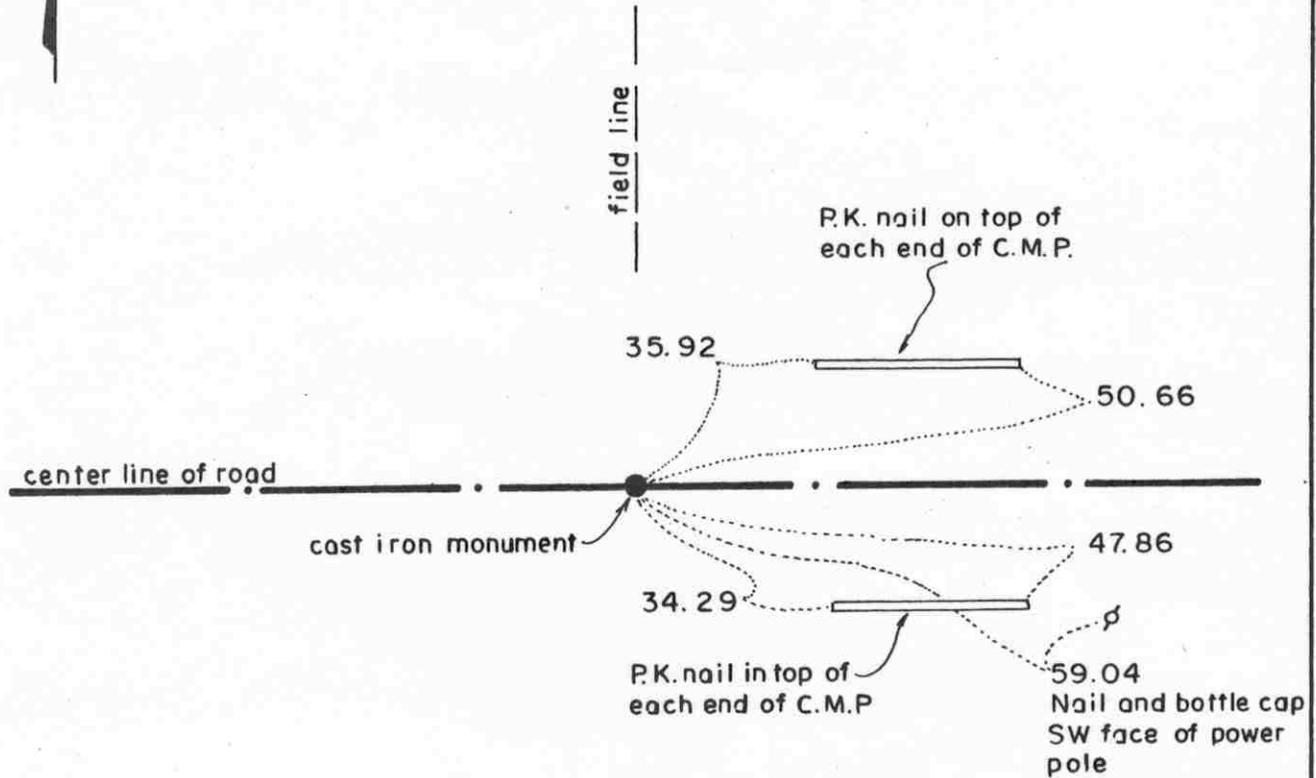

## SECTION 30

Statement of evidence relative to this corner location on sheet 2

I hereby certify that this document was prepared by me or under my direct supervision.

Willard Pellinen

Willard Pellinen  
McLeod County Surveyor  
License No. 9626.

Date Sept. 19, 1994

OFFICE OF THE COUNTY RECORDER  
MCLEOD COUNTY, MINNESOTA

I hereby certify that this document was filed in this office at 9 o'clock A. M. on the 22nd day of September 19 94.

Carmen Helie Mulder, County Recorder

By \_\_\_\_\_, Deputy.

Document No. 261945

## **Certificate of Location of Government Corner**

### **North Quarter Corner, Section 30, Township 116 North, Range 27 West**

*November, 1856. E. N. Darling of the General Land Office originally established this corner. He set a post and marked a 20 inch oak and an 8 inch elm for bearing trees.*

*November 7, 1974. R. C. M., surveyors from Gaylord, dug for the corner and found 2 six inch round granite stones side by side down 2 feet below the surface of the road. They dug 3 feet below the stones but found nothing else. They set a 1/2 inch diameter iron pipe at the location of the stones and took reference ties.*

*January 1975. Dickman Knutson, county surveyor, found the iron pipe set by RCM and checked the reference ties.*

*July 29, 1975. Knutson replaced the iron pipe with a McLeod County cast iron monument. The monument is 27.18 feet west and 0.10 feet south of a lost position for the corner.*

*The monument set by Knutson is accepted as marking the correct location of the quarter corner. It fits long standing occupation lines and perpetuates the location of an older monument, (the stones).*

*1994. We found the monument in good condition and checked the reference ties.*

NORTHEAST corner, Section 25, Township 116 North, Range 28 West

# Certificate of Location of Government Corner

SKETCH OF REFERENCE TIES  
(NO SCALE)



SECTION 24  
T. 116 R. 28

SECTION 19  
T. 116 R. 27

Nail and bottle cap in post  
by telephone pedestal.

52.93

Nail and bottle cap in  
south face of post by  
telephone pedestal.

83.65

Cast iron monument

Center line of road

Center line of road

101.15

Nail and bottle cap in  
west face of power pole.

SECTION 25  
T. 116 R. 28

SECTION 30  
T. 116 R. 27

Statement of evidence relative to this corner location on sheet 2

I hereby certify that this document  
was prepared by me or under my  
direct supervision.

Willard Pellinen

Willard Pellinen  
McLeod County Surveyor  
License No. 9626

Date Oct. 9, 1995

OFFICE OF THE COUNTY RECORDER  
MCLEOD COUNTY, MINNESOTA.

I hereby certify that this document was filed in this  
office at 9 o'clock A. M. on the 13th day  
of October, 1995.

Armenia Rothlie G. Jelder, County Recorder

By \_\_\_\_\_, Deputy

Document No. 268602

NORTHEAST \_\_\_\_\_ corner, Section 25, Township 116 North, Range 28 West***Certificate of Location of Government Corner***

1855. John Ryan of the General Land Office set a post and marked 3 oaks and an elm for bearing trees.

July, 1929. County Highway Department field notes show a stone at the corner.

December, 1968. Dickman Knutson, county surveyor, measured the east line of Sections 24 and 25 and found a spike at the center line intersection of the roads.

June, 1969. Knutson dug for the corner and found a stone and rotted wood stake.

19 ????. Knutson set a McLeod County cast iron monument at the corner. No record found when monument was set.

***May 15, 1995. We checked the reference ties to the monument.***

EAST QUARTER corner, Section 25, Township 116 North, Range 28 West


# Certificate of Location of Government Corner

SKETCH OF REFERENCE TIES  
(NO SCALE)



SECTION 25 T.116 R.28

SECTION 30 T.116 R.27

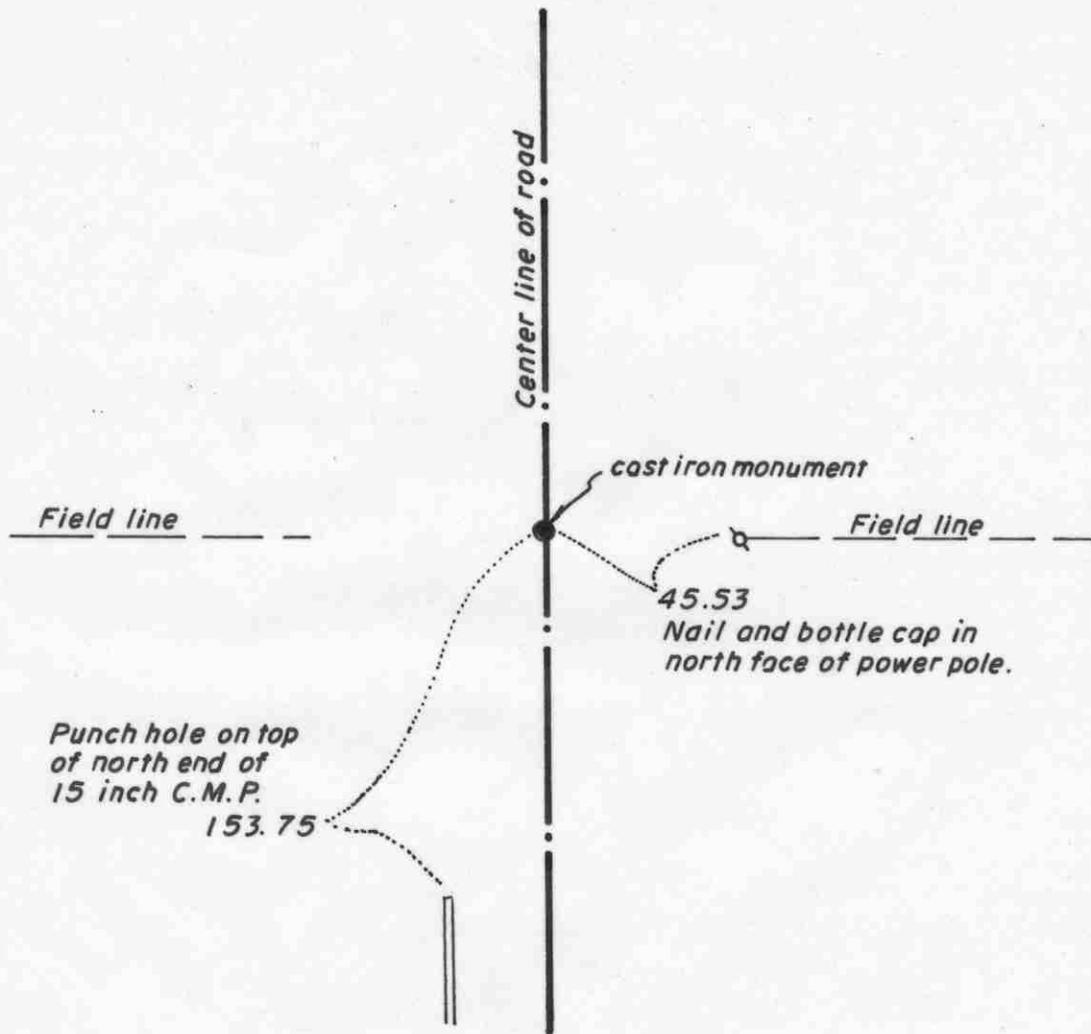

Statement of evidence relative to this corner location on sheet 2

I hereby certify that this document was prepared by me or under my direct supervision.

Willard Pellinen  
Willard Pellinen  
McLeod County Surveyor  
License No. 9626

Date Feb. 4, 1995

OFFICE OF THE COUNTY RECORDER  
MCLEOD COUNTY, MINNESOTA.

I hereby certify that this document was filed in this office at 9 o'clock A.M. on the 6th day of February, 1995.

Armen Botli Mulder, County Recorder

By \_\_\_\_\_, Deputy

Document No. 264037

EAST QUARTER corner, Section 25, Township 116 North, Range 28 West

## Certificate of Location of Government Corner

1855. John Ryan of the General Land Office established this corner. He set a post and marked 2 aspens for bearing trees.

December, 1968. Dickman Knutson, county surveyor, measured the east line of Section 25 and set a temporary quarter at the center line of the north-south road in line with a fence to the east.

1969. William Dols, in the Northwest Quarter of Section 30 for 30 years, said the corner is in the center line of the road in line with the fence. Knutson dug for the corner at the temporary corner and found a stone and an iron pin.

19 ??? . Knutson set a McLeod County cast iron monument. No records found as to when the monument was set.

November 29, 1990. We found the monument in good condition. This was 5.12 feet south of a split and 13.64 feet west of a straight line between the section corners.


---

**January 11, 1995. We found the monument in good condition down 10 inches below the surface of the road and took new reference ties.**

# Certificate of Location of Government Corner

EAST QUARTER corner, Section 31, Township 116 North, Range 27 West

SKETCH OF REFERENCE TIES (NO SCALE)

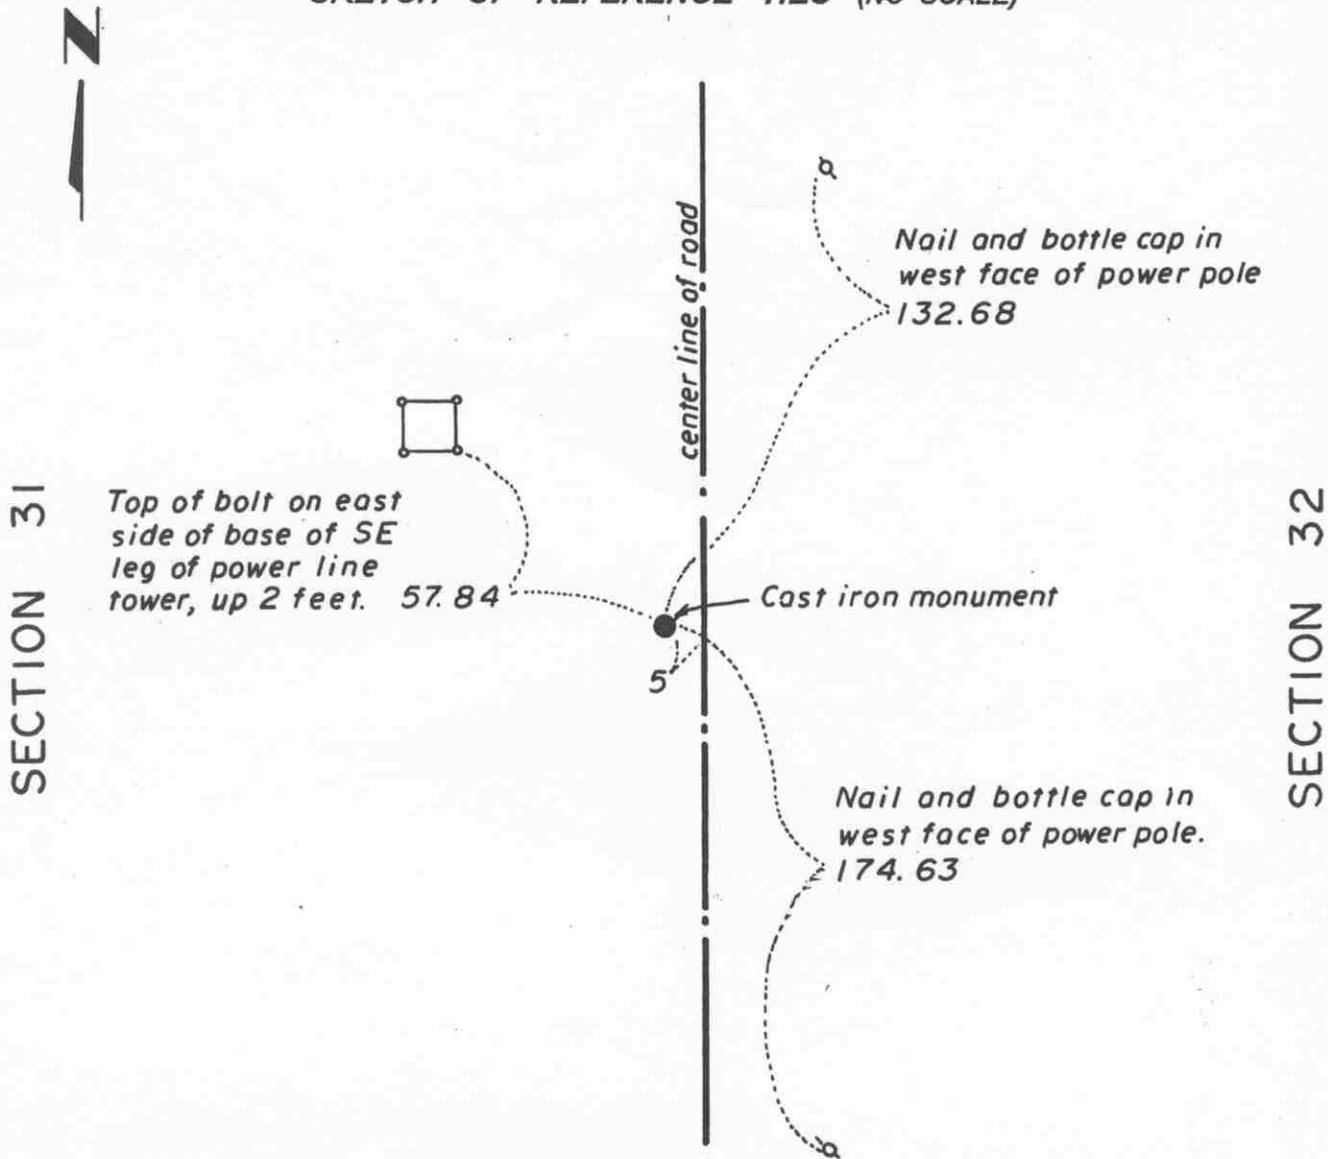

**Statement of evidence relative to this corner location on sheet 2**

I hereby certify that this document was prepared by me or under my direct supervision.

Willard Pellinen  
 Willard Pellinen  
 McLeod County Surveyor  
 License No. 9626.

Date Feb. 4, 1995.

**OFFICE OF THE COUNTY RECORDER  
 MCLEOD COUNTY, MINNESOTA**

I hereby certify that this document was filed in this office at 9 o'clock A. M. on the 6th day of February, 19 95.

Carmen Ottilie Mulder, County Recorder

By \_\_\_\_\_, Deputy.

Document No. 264034

## **Certificate of Location of Government Corner**

**East Quarter Corner, Section 31, Township 116 North, Range 27 West**

**November, 1856. E. N. Darling of the General Land Office established this corner. He set a post in a dry marsh and marked an 8 inch aspen and a 7 inch elm for bearing trees.**

**September 8, 1939. Survey notes show a found old stake down 3 1/2 feet in line with a fence to the east. A 1 inch by 30 inch steel stake was set with a large stone on top.**

**July 26, 1982. We excavated for the corner, John Tupa from Hutchinson with a backhoe. We found a 16 inch diameter stone down 1 1/2 feet and a 1 inch diameter steel stake down 2 1/2 feet. We took available ties and left steel stake in place.**

**August 25, 1982. We set a McLeod County cast iron monument at the corner.**


**We measured 2655.67 feet to the southeast corner of Section 31, compared with a distance of 2656.5 in 1939. We measured 2626.47 feet to the northeast corner of Section 31. We had an angle of 180 degrees 15 minutes 39 seconds at the corner at the west side of the section line.**

**January 11, 1995. We found the monument in good condition down 10 inches below the surface of the road and took new reference ties.**

# Certificate of Location of Government Corner

NORTHEAST corner, Section 31, Township 116 North, Range 27 West

SKETCH OF REFERENCE TIES (NO SCALE)

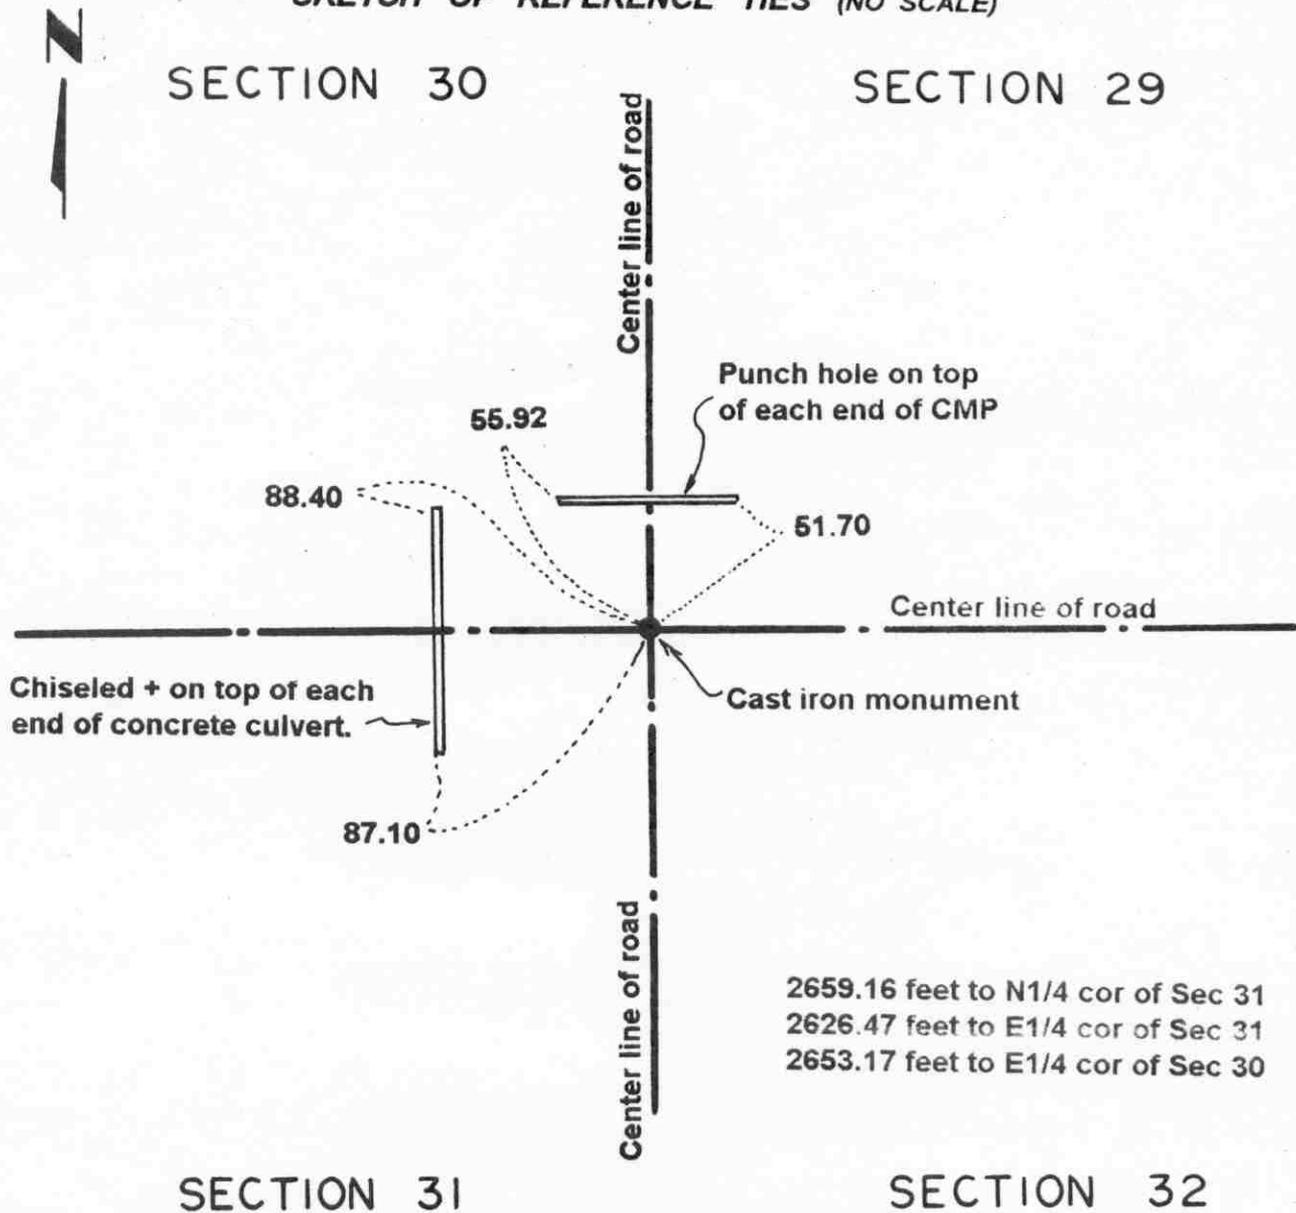

2659.16 feet to N1/4 cor of Sec 31  
 2626.47 feet to E1/4 cor of Sec 31  
 2653.17 feet to E1/4 cor of Sec 30

Statement of evidence relative to this corner location on sheet 2

I hereby certify that this document was prepared by me or under my direct supervision.

Willard Pellinen  
 Willard Pellinen  
 McLeod County Surveyor  
 License No. 9626.

Date Dec. 13, 1995

OFFICE OF THE COUNTY RECORDER  
 MCLEOD COUNTY, MINNESOTA

I hereby certify that this document was filed in this office at 9 o'clock A. M. on the 9th day of January, 19 96.

Carmen Ostlie Mulder, County Recorder

By Charleen Engstrom, Deputy.

Document No. 270206

**Certificate of Location of Government Corner**  
**Northeast Corner, Section 31, Township 116 North, Range 27 West**

**November, 1856. E. N. Darling of the General Land Office established this corner. He set a post and marked 4 aspens for bearing trees.**

**November, 1975. R. C. M., surveyors from Gaylord, MN., dug for the corner at the center line intersection of roads north, south, east and west. Down 6 feet below the surface of the road they found a broken fence post with the bottom portion standing upright. They took ties and set an iron pipe at the surface.**

**July 29, 1976. Dickman Knutson, county surveyor, replaced the iron pipe with a McLeod County cast iron monument and took available ties.**


**December, 1994. The monument set by Knutson is accepted as marking the location of the government corne. It fits long standing occupation lines (the roads) and it perpetuates the location of an older monument (the fence post).**

# Certificate of Location of Government Corner

NORTH QUARTER corner, Section 31, Township 116 North, Range 27 West

SKETCH OF REFERENCE TIES (NO SCALE)

## SECTION 30

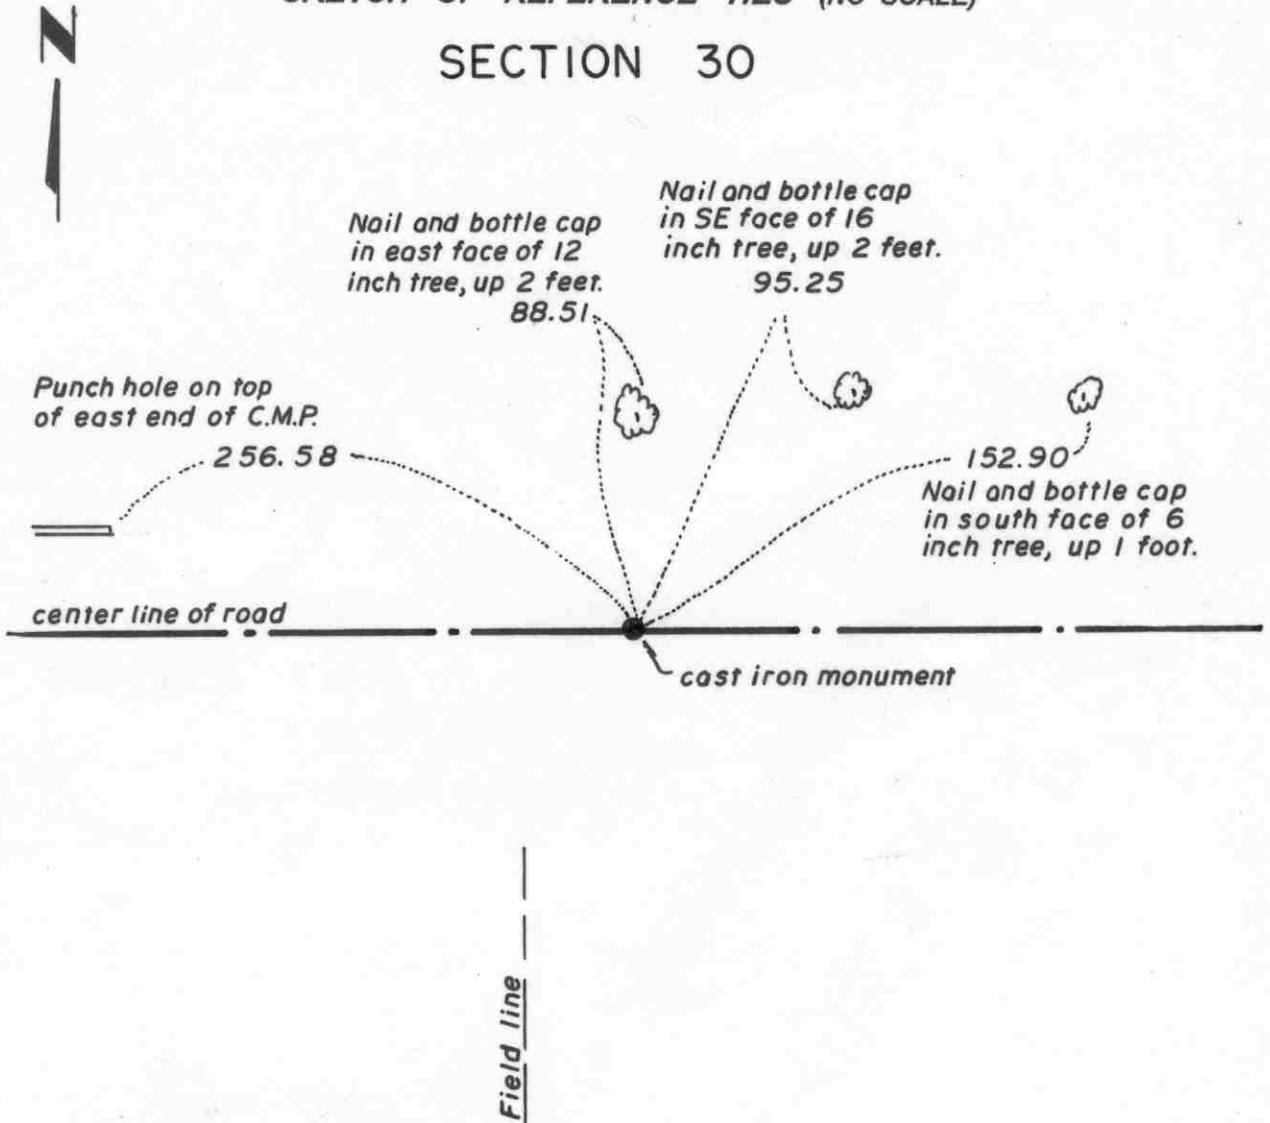

## SECTION 31

Statement of evidence relative to this corner location on sheet 2

I hereby certify that this document was prepared by me or under my direct supervision.

Willard Pellinen  
Willard Pellinen  
McLeod County Surveyor  
License No. 9626.

Date Feb 4, 1995

OFFICE OF THE COUNTY RECORDER  
MCLEOD COUNTY, MINNESOTA

I hereby certify that this document was filed in this office at 9 o'clock A.M. on the 6th day of February, 19 95.

(Carmen) Obelia Mulder, County Recorder

By \_\_\_\_\_, Deputy.

Document No. 264035

## ***Certificate of Location of Government Corner***

***North Quarter Corner, Section 31, Township 116 North, Range 27 West***

***November, 1856. E. N. Darling of the General Land Office established this corner. He set a post in a dry marsh and marked 2 aspens for bearing trees.***

***November 13, 1974. R.C.M., surveyors from Gaylord, MN., excavated for this corner. They found an oblong granite stone, 1 foot long, 8 inches in diameter, down 1 1/2 feet below the surface of the road. This was on the center of the east-west road in line with a field line to the south. They took ties and set an iron pipe at the surface of the road.***

***July 29, 1975. Dickman Knutson, county surveyor, replaced the iron pipe with a McLeod County cast iron monument and took available ties.***


***We measured 2429.52 feet to the northwest corner and 2661.71 feet to the northeast corner of Section 30. This corner is 27.18 feet west and 0.10 feet south of a lost position for this corner.***

***January 11, 1995. We found the monument in good condition down 8 inches below the surface of the road and took new reference ties.***

# Certificate of Location of Government Corner

Northeast corner, Section 36, Township 116 North, Range 28 West

## SKETCH OF REFERENCE TIES (NO SCALE)

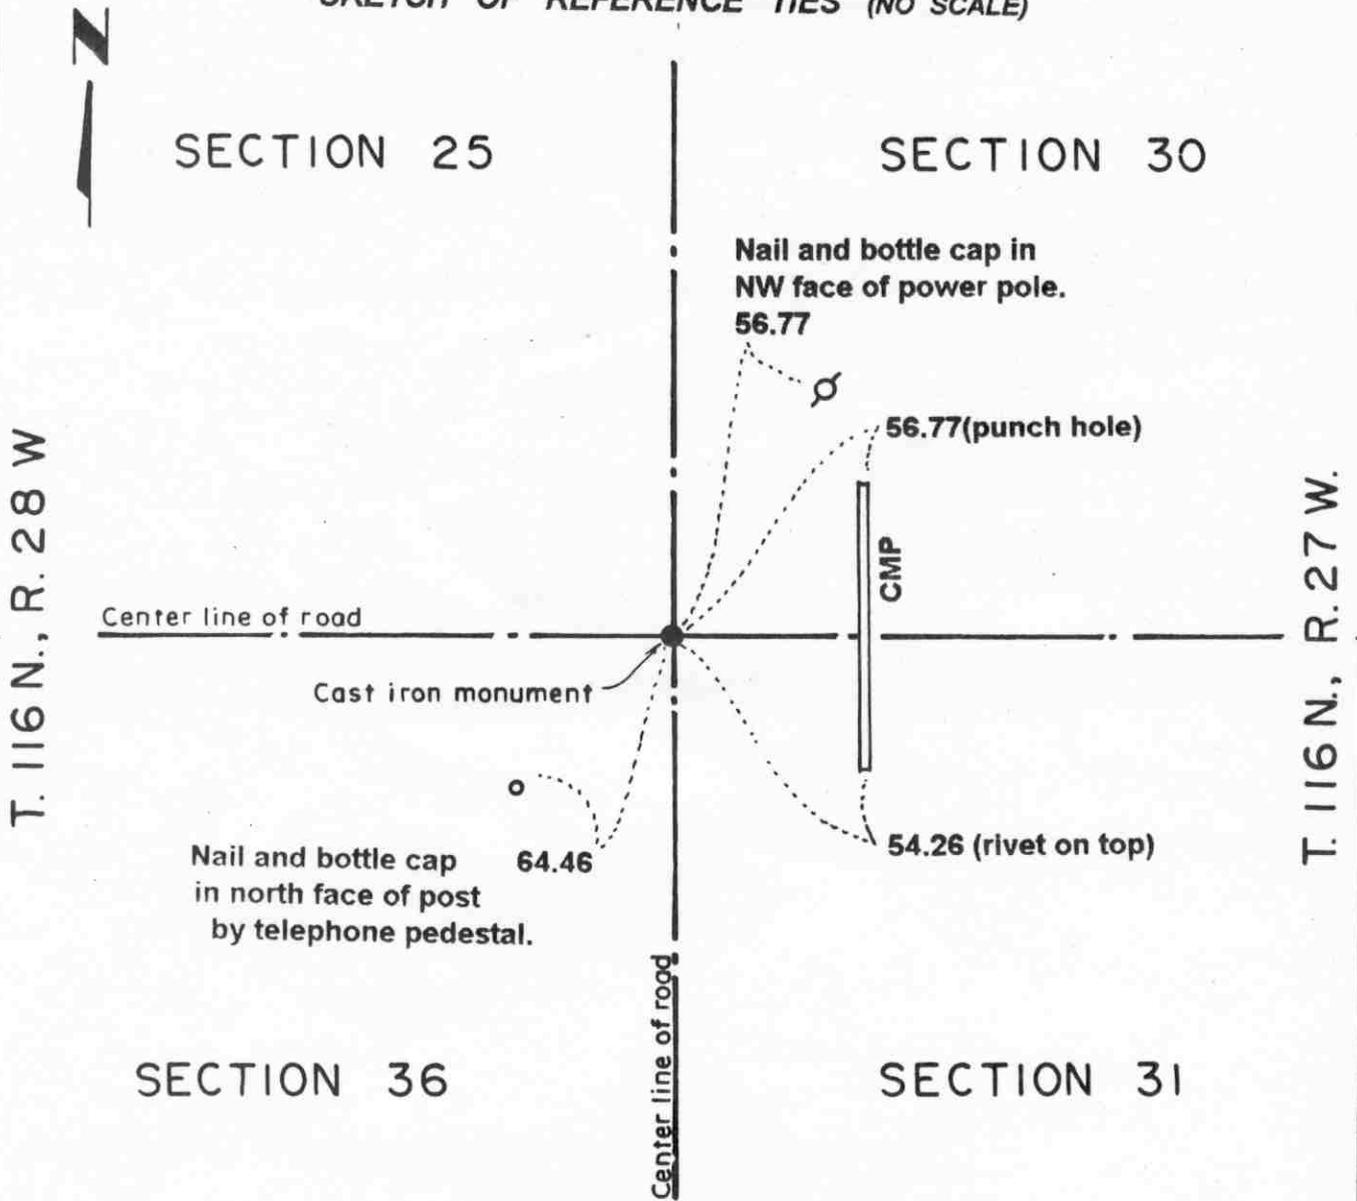

### Statement of evidence relative to this corner location on sheet 2

I hereby certify that this document was prepared by me or under my direct supervision.

Willard Pellinen  
 Willard Pellinen  
 McLeod County Surveyor  
 License No. 9626.

Date Oct. 9, 1995

### OFFICE OF THE COUNTY RECORDER MCLEOD COUNTY, MINNESOTA

I hereby certify that this document was filed in this office at 9 o'clock A. M. on the 13th day of October 19 95.

Carmen Josie Gulder, County Recorder

By \_\_\_\_\_, Deputy.

Document No. 268603

**Certificate of Location of Government Corner**  
**Northeast Corner, Section 36, Township 116 North, Range 28 West**

*1855. John Ryan of the General Land Office established this corner. He set a post in a wet marsh and marked a 7 inch cherry tree, a 7 inch aspen and a 14 inch aspen for bearing trees.*

*1968. Adjoining land owners agree the corner is the center line intersection of the roads.*

*December, 1968. Dickman Knutson, county surveyor, dug for the corner. He found an iron pin and a wood stake and took reference ties. This was at the center line of the roads, north, south, east and west.*

*1969. Knutson set a McLeod County cast iron monument.*

*July 7, 1987. We found the monument in good condition down 4 inches below the surface of the bituminous road and took new available ties.*

*June, 1994. We checked the reference ties.*


# Certificate of Location of Government Corner

East Quarter corner, Section 36, Township 116 North, Range 28 West

SKETCH OF REFERENCE TIES (NO SCALE)

SECTION 36, T.116N., R.28W.

SECTION 31, T.116N., R.27W.

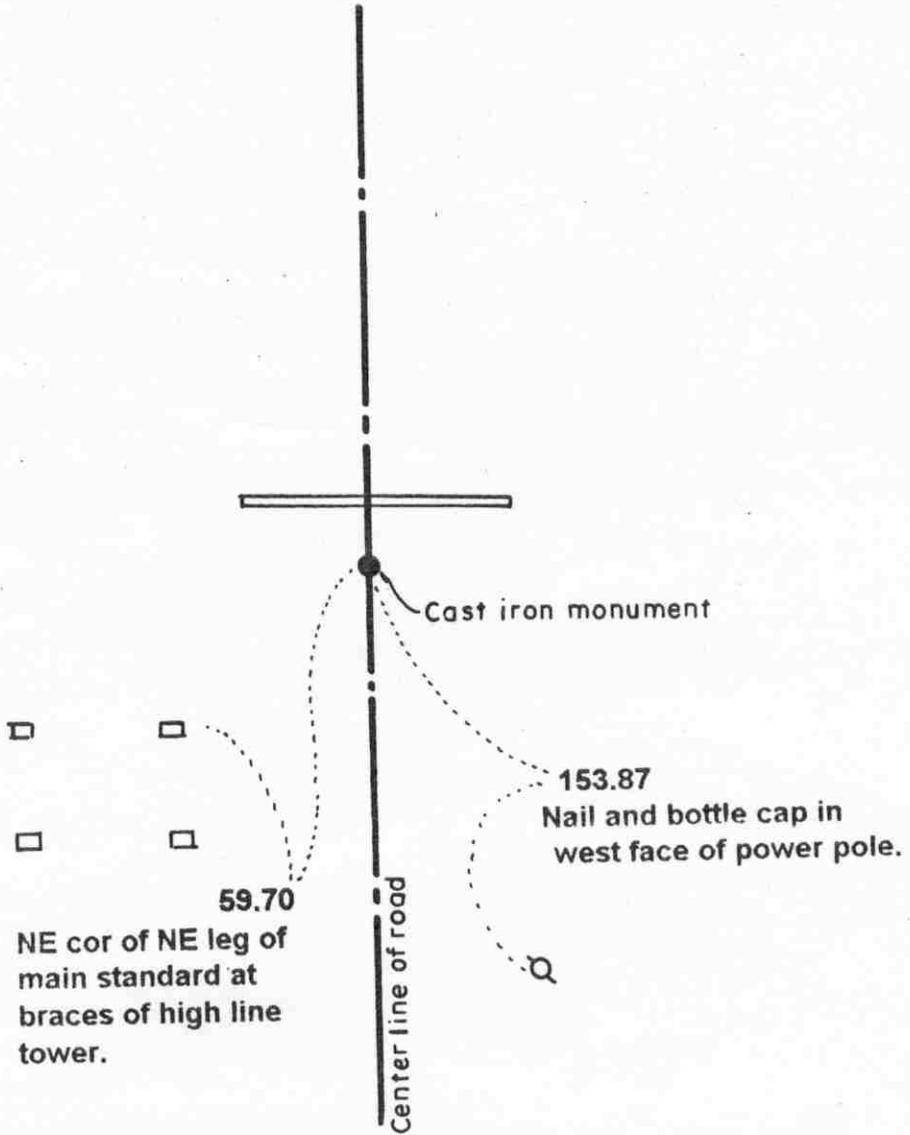

Statement of evidence relative to this corner location on sheet 2

I hereby certify that this document was prepared by me or under my direct supervision.

Willard Pellinen  
Willard Pellinen  
McLeod County Surveyor  
License No. 9626.

Date Oct. 9, 1995

OFFICE OF THE COUNTY RECORDER  
MCLEOD COUNTY, MINNESOTA

I hereby certify that this document was filed in this office at 9 o'clock A M. on the 13th day of October 19 95.

Carmen Estlin Mulder, County Recorder

By \_\_\_\_\_, Deputy.

Document No. 268604

***Certificate of Location of Government Corner***  
***East Quarter Corner, Section 36, Township 116 North, Range 28 West***

***1855. This corner was originally established by the General Land Office. John Ryan set a post, in a wet marsh, and marked an 18 inch oak and a 10 inch oak for bearing trees.***

***December, 1968. Dickman Knutson, county surveyor, excavated for the corner and found an iron pin.***


***Knutson replaced the iron pin with a McLeod County cast iron monument and took reference ties.***

***July 28, 1987. We found the monument in good condition down 4 inches below the surface of the bituminous road and took new reference ties.***

***May 15, 1995. We checked the reference ties to the monument***

# Certificate of Location of Government Corner

SKETCH OF REFERENCE TIES  
(NO SCALE)

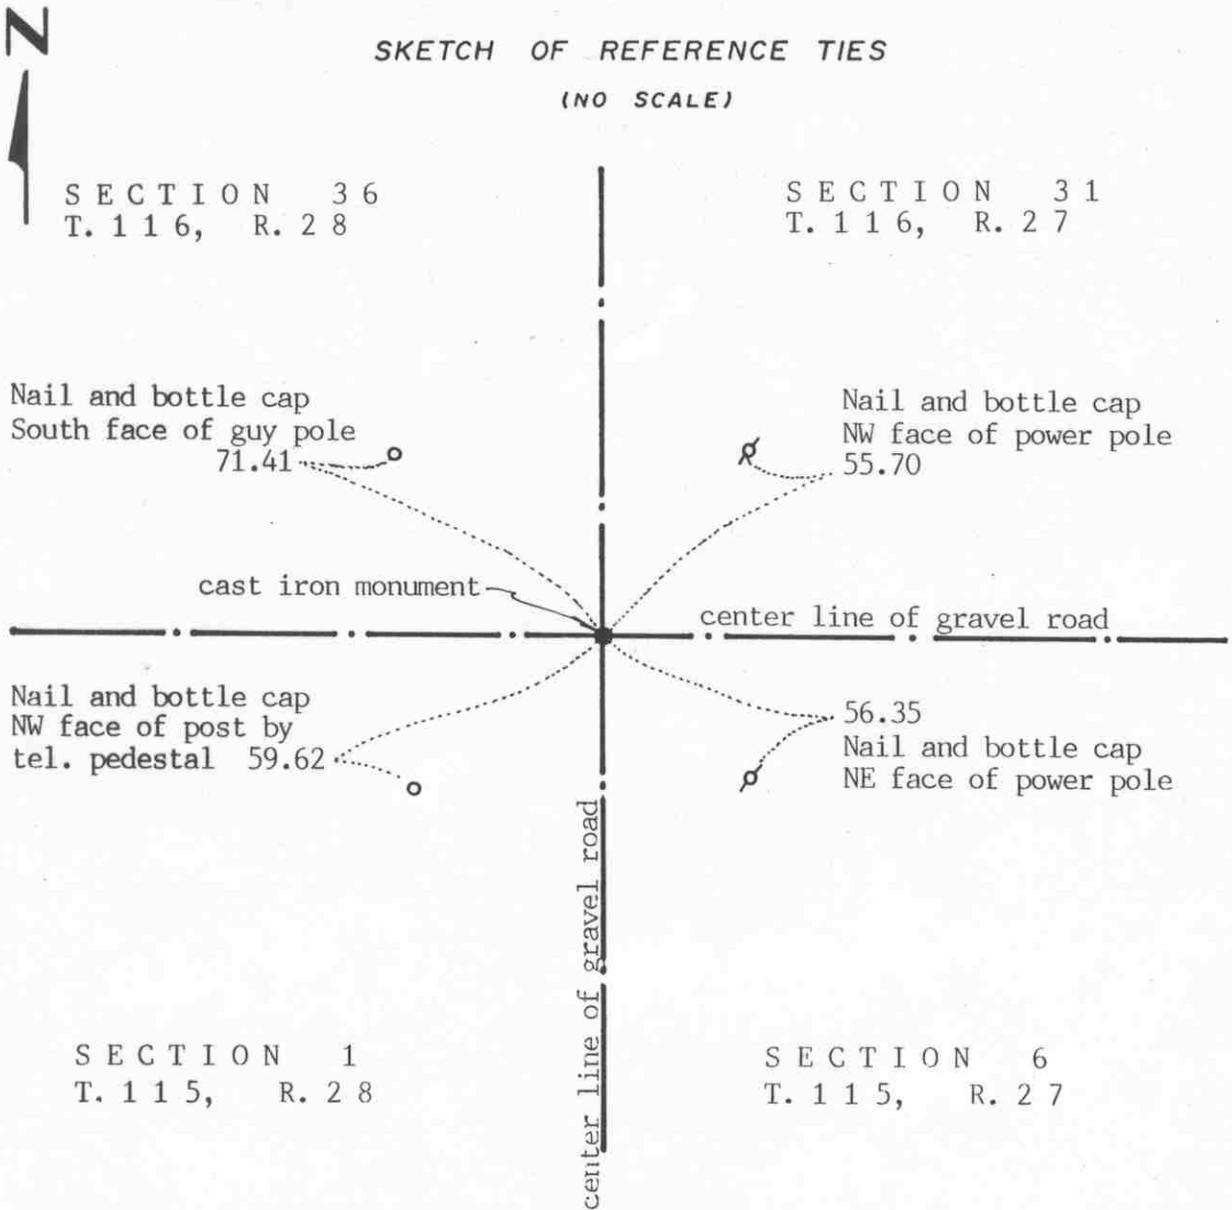

Statement of evidence relative to this corner location on sheet 2

I hereby certify that this document was prepared by me or under my direct supervision.

Willard Pellinen  
Willard Pellinen  
McLeod County Surveyor  
License No. 9626  
Date Oct. 3, 1991

OFFICE OF THE COUNTY RECORDER  
MCLEOD COUNTY, MINNESOTA.

I hereby certify that this document was filed in this office at 1 o'clock P.M. on the 21st day of Oct, 1991.

Carmen Hotliu, County Recorder  
By \_\_\_\_\_, Deputy  
Document No. 241584

NORTHEAST corner, Section 1, Township 115 North, Range 28 West

## Certificate of Location of Government Corner

1855. John Ryan of the General Land Office set a post and marked 3 elms and an ironwood for bearing trees.

January, 1900. E.L.Higgins found an old stake 2 rods from a fence corner and put in a stone and a stake. He measured 2661 feet to the east quarter corner of Section 1.

December, 1968. McCombs Knutson Associates (Dickman Knutson, county surveyor) measured the east line of Section 1 and set a temporary corner at the center line intersection of the roads.

1969. Knutson dug for the corner but found nothing.

October 26, 1970. Knutson set a McLeod County cast iron monument at the center line intersection of the roads and took available reference ties.

November, 1990. We found the monument in good condition and measured 2661.05 feet to the east quarter corner compared with 2661 feet by Higgins. We took new reference ties.


There being no evidence to the contrary, we accept the monument set by Knutson as marking the section corner. It is on old occupation lines, the center lines of the roads and the distance to the east quarter corner is the same as in 1900.

# Certificate of Location of Government Corner

NORTH QUARTER corner, Section 6, Township 115 North, Range 27 West

SKETCH OF REFERENCE TIES (NO SCALE)

SECTION 31, T.116N., R. 27 W.

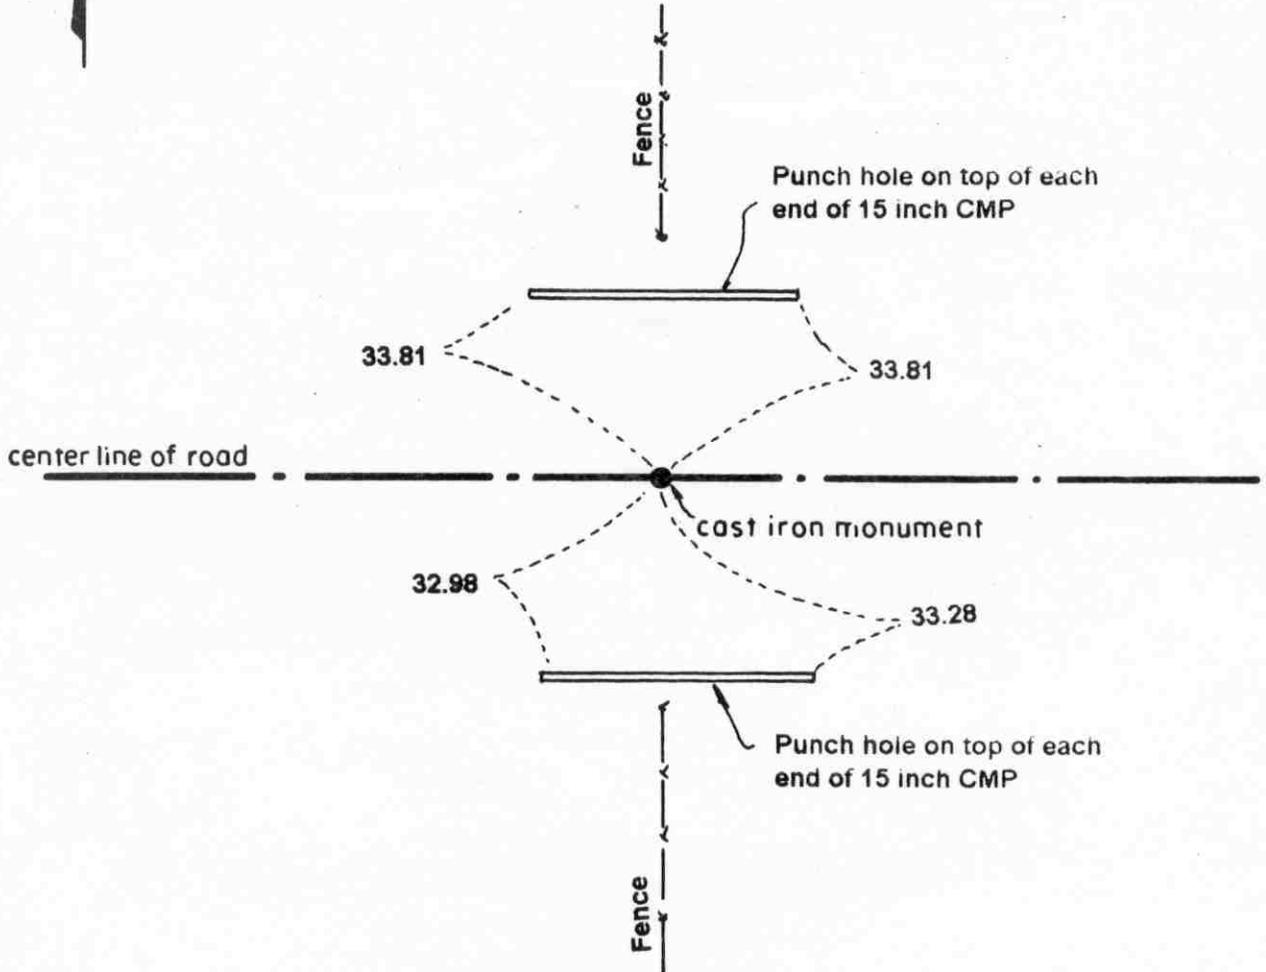

SECTION 6, T.115N., R. 27 W.

Statement of evidence relative to this corner location on sheet 2

I hereby certify that this document was prepared by me or under my direct supervision.

Willard Pellinen  
Willard Pellinen  
McLeod County Surveyor  
License No. 9626.

Date Aug. 7, 1995

OFFICE OF THE COUNTY RECORDER  
MCLEOD COUNTY, MINNESOTA

I hereby certify that this document was filed in this office at 9 o'clock A. M. on the 07th day of August 19 95.

GARMEN OSTLIE MULDER, MCLEOD COUNTY RECORDER

County Recorder

By Phyllis Jozkowski, Deputy.

Document No. 267423

**Certificate of Location of Government Corner**  
**North Quarter Corner, Section 6, Township 115 North, Range 27 West**

*1855. John Ryan of the General Land Office established this corner. He set a post in a marsh and marked an 8 inch aspen and a 14 inch oak for bearing trees.*

*September 11, 1969. Dickman Knutson, county surveyor set a temporary corner on the center of the east-west road in line with fences north and south. This point has been accepted by adjoining land owners as the quarter corner.*

*April 16, 1970. Knutson dug for the corner (John Tupa from Hutchinson with a backhoe.) Down 1 1/2 feet below the surface of the road they found a wood stake. They took available reference ties.*

*1970. Knutson set a McLeod County cast iron monument at the corner.*


*March 29, 1995. We found iron pipe down 6 inches below the surface of the gravel road. Pipe over cast iron monument. We took new available reference ties.*

# Certificate of Location of Government Corner

NORTHEAST corner, Section 6, Township 115 North, Range 27 West

SKETCH OF REFERENCE TIES (NO SCALE)

T. 116 N., R. 27 W.

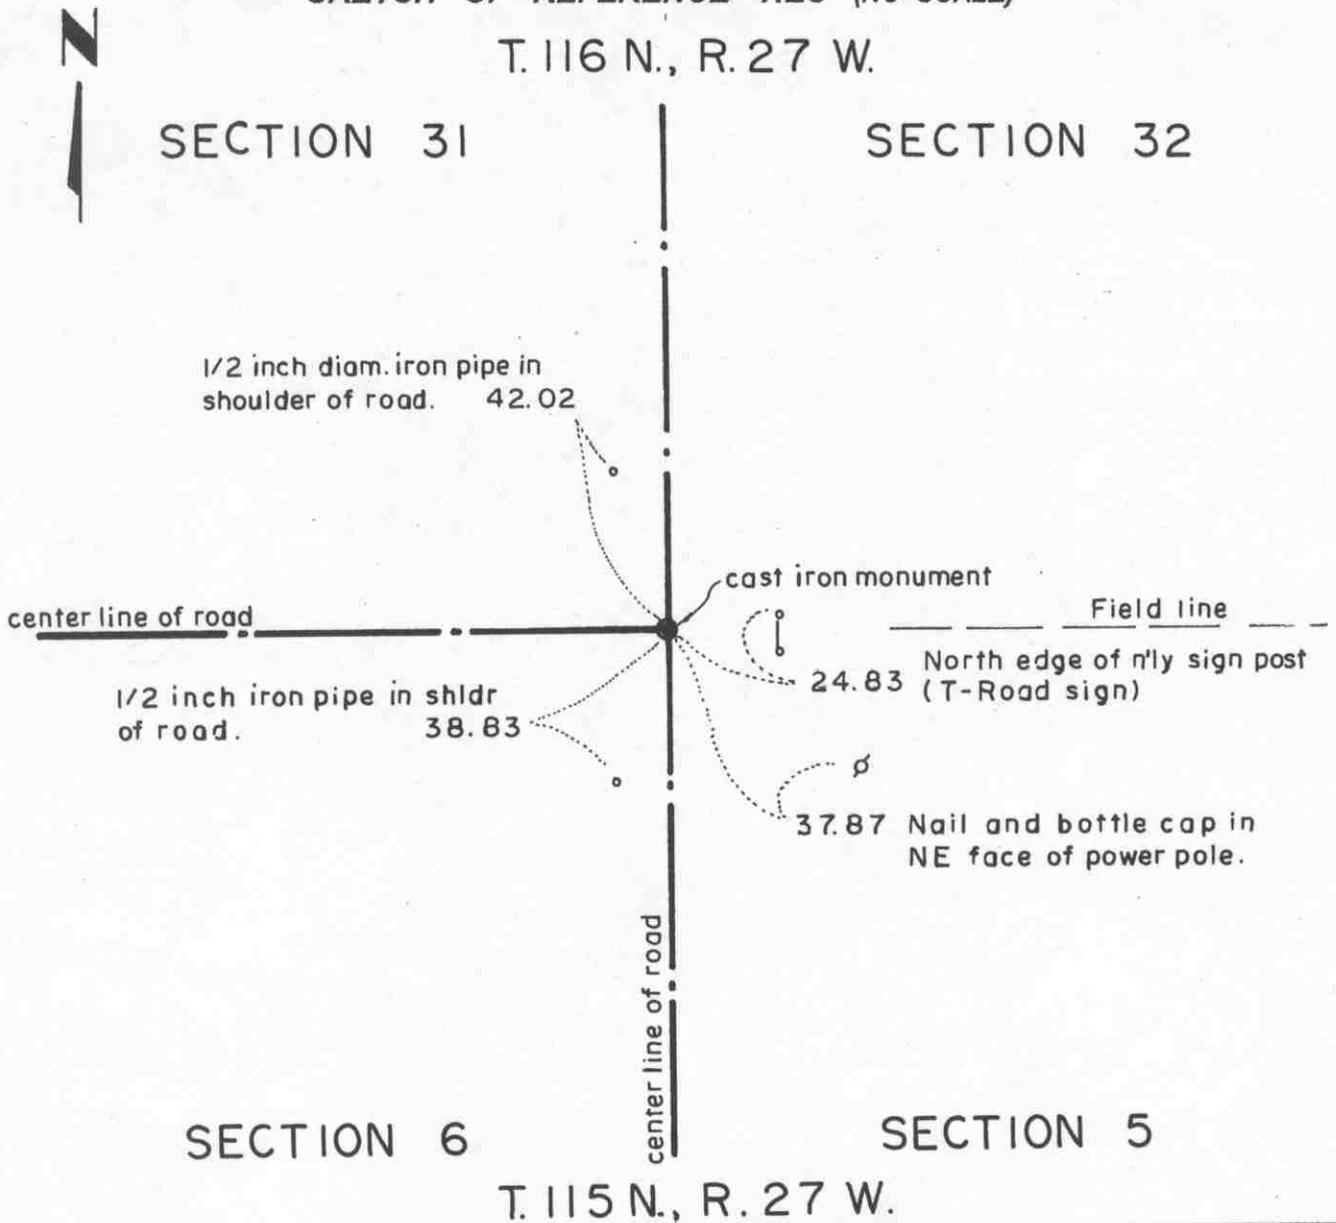

Statement of evidence relative to this corner location on sheet 2

I hereby certify that this document was prepared by me or under my direct supervision.

Willard Pellinen  
 Willard Pellinen  
 McLeod County Surveyor  
 License No. 9626.

Date April 17, 1995

OFFICE OF THE COUNTY RECORDER  
 MCLEOD COUNTY, MINNESOTA

I hereby certify that this document was filed in this office at 9 o'clock A .M. on the 24th day of Apr 19 95.

Carmen (Patricia) Mulder County Recorder

By \_\_\_\_\_, Deputy.

Document No. 265299

**Certificate of Location of Government Corner**  
**Northeast Corner, Section 6, Township 115 North, Range 27 West**

**1855. John Ryan of the General Land Office established this corner. He set a post and marked a 6 inch elm, a 7 inch aspen, a 12 inch oak and a 16 inch oak for bearing trees.**

**September, 1969. Dickman Knutson, county surveyor, found a stone and wood stake. He took reference ties and directly below the stone he found a 1 inch diameter solid iron pin. The iron was 3 feet below the surface of the road. He left the iron in place and set a McLeod County cast iron monument over it.**

**February 2, 1995. We found the monument in good condition down 6 inches below the surface of the gravel road and took new reference ties.**

# Certificate of Location of Government Corner

EAST QUARTER corner, Section 32, Township 116 North, Range 27 West

SKETCH OF REFERENCE TIES (NO SCALE)

SECTION 32

SECTION 33



Nail and bottle cap in  
NE face of power pole

57.62

Nail and disc in east face  
of power pole

263.52

center line of road

cast iron monument

200.73 Bolt hole at SW  
leg of power line tower,  
up 3 feet

Statement of evidence relative to this corner location on sheet 2

I hereby certify that this document  
was prepared by me or under my  
direct supervision.

Willard Pellinen  
Willard Pellinen  
McLeod County Surveyor  
License No. 9626.

Date Jan. 4, 1995

OFFICE OF THE COUNTY RECORDER  
MCLEOD COUNTY, MINNESOTA

I hereby certify that this document was filed in this office at 9  
o'clock A. M. on the 10th day of January,  
19 95.

Armen Estlie Mulder, County Recorder

By \_\_\_\_\_, Deputy.

Document No. 263640

***Certificate of Location of Government Corner  
East Quarter Corner, Section 32, Township 116 North, Range 27 West***

***November, 1856. E. N. Darling of the General Land Office established this corner. He set a post and marked a 6 inch and an 8 inch aspen for bearing trees.***

***No property lines east or west nor testimony to help re-establish this corner.***

***November 14, 1979. We set a railroad spike on line and split between the section corners and took available ties.***

***1980. We dug for the corner but found no evidence of the corner.***

***July 17, 1980. We set a McLeod County cast iron monument.***

***January 3, 1995. We took new reference ties to the monument.***

# Certificate of Location of Government Corner

NORTHEAST corner, Section 32, Township 116 North, Range 27 West

SKETCH OF REFERENCE TIES (NO SCALE)

SECTION 29

SECTION 28



Chiseled + on top of south end of conc. culvert.

118.76

79.98

Chiseled + on top of each end of concrete culvert.

cast iron monument

center line of road

Nail and bottle cap in SE face of power pole

41.83

76.04

center line of road

SECTION 32

SECTION 33

Statement of evidence relative to this corner location on sheet 2

I hereby certify that this document was prepared by me or under my direct supervision.

Willard Pellinen  
Willard Pellinen  
McLeod County Surveyor  
License No. 9626.

Date Jan 4, 1995

OFFICE OF THE COUNTY RECORDER  
MCLEOD COUNTY, MINNESOTA

I hereby certify that this document was filed in this office at 9 o'clock A M. on the 10th day of January, 1995.

Carmen Helie Mulder, County Recorder

By \_\_\_\_\_, Deputy.

Document No. 263639

## ***Certificate of Location of Government Corner***

***Northeast Corner, Section 32, Township 116 North, Range 27 West***

***November, 1856. E. N. Darling of the General Land Office established this corner. He set a post and marked a 6 inch and an 8 inch aspen for bearing trees.***

***June 11, 1940. County Highway Engineer found a spike in a wood hub.***

***January 23, 1975. Minnesota Highway Department placed a 3/4 inch iron pin using 1941 ties and alignment notes received from county engineer.***

***July 29, 1975. Dickman Knutson, county surveyor, replaced the iron pin with a McLeod County cast iron monument and took available ties.***

***January 3, 1995. We found the monument in good condition and checked the reference ties.***

# Certificate of Location of Government Corner

NORTH QUARTER corner, Section 32, Township 116 North, Range 27 West

SKETCH OF REFERENCE TIES (NO SCALE)

SECTION 29



fence

Nail and bottle cap in south face of post by telephone pedestal.

48.85

cast iron monument

center line of road

34.85

37.64

Punch hole on top of each end of 15 inch C.M.P.

60.10

Nail and bottle cap North face of power pole.

center line of gravel drive

SECTION 32

Statement of evidence relative to this corner location on sheet 2

I hereby certify that this document was prepared by me or under my direct supervision.

Willard Pellinen  
Willard Pellinen  
McLeod County Surveyor  
License No. 9626.

Date Feb. 4, 1995

OFFICE OF THE COUNTY RECORDER  
MCLEOD COUNTY, MINNESOTA

I hereby certify that this document was filed in this office at 9 o'clock A. M. on the 6th day of February, 19 95.

Carmin O. Helms-Julder, County Recorder

By \_\_\_\_\_, Deputy.

Document No. 264036

## **Certificate of Location of Government Corner**

**North Quarter Corner, Section 32, Township 116 North, Range 27 West**

**November, 1856. E. N. Darling of the General Land Office established this corner. He set a post and marked two 8 inch aspens for bearing trees.**

**February 5, 1982. We measured the north line of Section 32 and set a temporary quarter corner on the center line of the east-west road in line with a fence to the north and center line of a drive to the south.**

**July 16, 1982. Mr. Larry Michaletz, who lives in the Southeast Quarter of Section 29, said fence running north has been accepted as the quarter line. Mr. Roy Lueck, 70 years old, and had lived in the Southwest Quarter of Section 29 all his life (his father owned the farm before him) said when he was 18 years old he saw a stone at the corner when the road was being rebuilt. It was in the center of the road, fence to the north.**

**July 26, 1982. We excavated for the corner, John Tupa from Hutchinson with a backhoe. We found a stone, 10 inches square, 18 inches long, set on end.**

**August 25, 1982. We set a McLeod County cast iron monument.**

**January 11, 1995. We found the monument in good condition down 6 inches below the surface of the road and took new reference ties.**

# Certificate of Location of Government Corner

North Quarter corner, Section 5, Township 115 North, Range 27 West

SKETCH OF REFERENCE TIES (NO SCALE)

SECTION 32, T. 116 N., R. 27 W.



Nail & bottle cap in south face of 24 inch elm.

Rock Pile

0.43

Nail & bottle cap in south face of 8 inch tree.

19.15

6±

Cast iron monument

Field line

SECTION 5, T. 115 N., R. 27 W.

Statement of evidence relative to this corner location on sheet 2

I hereby certify that this document was prepared by me or under my direct supervision.

Willard Pellinen

Willard Pellinen  
McLeod County Surveyor  
License No. 9626.

Date Nov. 6, 1995

OFFICE OF THE COUNTY RECORDER  
MCLEOD COUNTY, MINNESOTA **269325**

I hereby certify that this document was filed in this office at 9 o'clock A M. on the 14th day of November 19 95.

Carmen Estlie M. Jelder County Recorder

By \_\_\_\_\_, Deputy.

Document No. \_\_\_\_\_

## **Certificate of Location of Government Corner**

**North Quarter Corner, Section 5, Township 115 North, Range 27 West**

*July, 1855. John Ryan of the General Land Office established this corner. He set a post and marked a 10 inch aspen and a 7 inch aspen for bearing trees.*

*1969, Adjoining land owners have accepted the intersection of field lines as the quarter corner.*

*September 12, 1969. Dickman Knutson, county surveyor, found a pointed stone at the intersection of field lines north, east and west. The stone was 5 inches in diameter and 14 inches long, pointed at the top.*

*Knutson replaced the stone with a McLeod County cast iron monument and took available reference ties.*

*February, 1995. The monument set by Knutson is accepted as marking the location of the government corner. It fits long standing occupation lines (the field lines) and it perpetuates the location of an older monument (the stone).*

*July 5, 1995. We found the monument in good condition and took new available reference ties.*



**Certificate of Location of Government Corner**  
**Northeast Corner, Section 5, Township 115 North, Range 27 West**

*1855. John Ryan of the General Land Office established this corner. He set a post and marked 3 aspens and a cherry tree for bearing trees.*

*September 12, 1969. Dickman Knutson, county surveyor, set a temporary corner at location as per adjoining land owners.*


*October, 1969. Knutson dug for the corner and found a stone down 2 feet and he took reference ties.*

*February 3, 1995. We checked the reference ties to the monument.*

# Certificate of Location of Government Corner

EAST QUARTER corner, Section 33, Township 116 North, Range 27 West

## SKETCH OF REFERENCE TIES (NO SCALE)

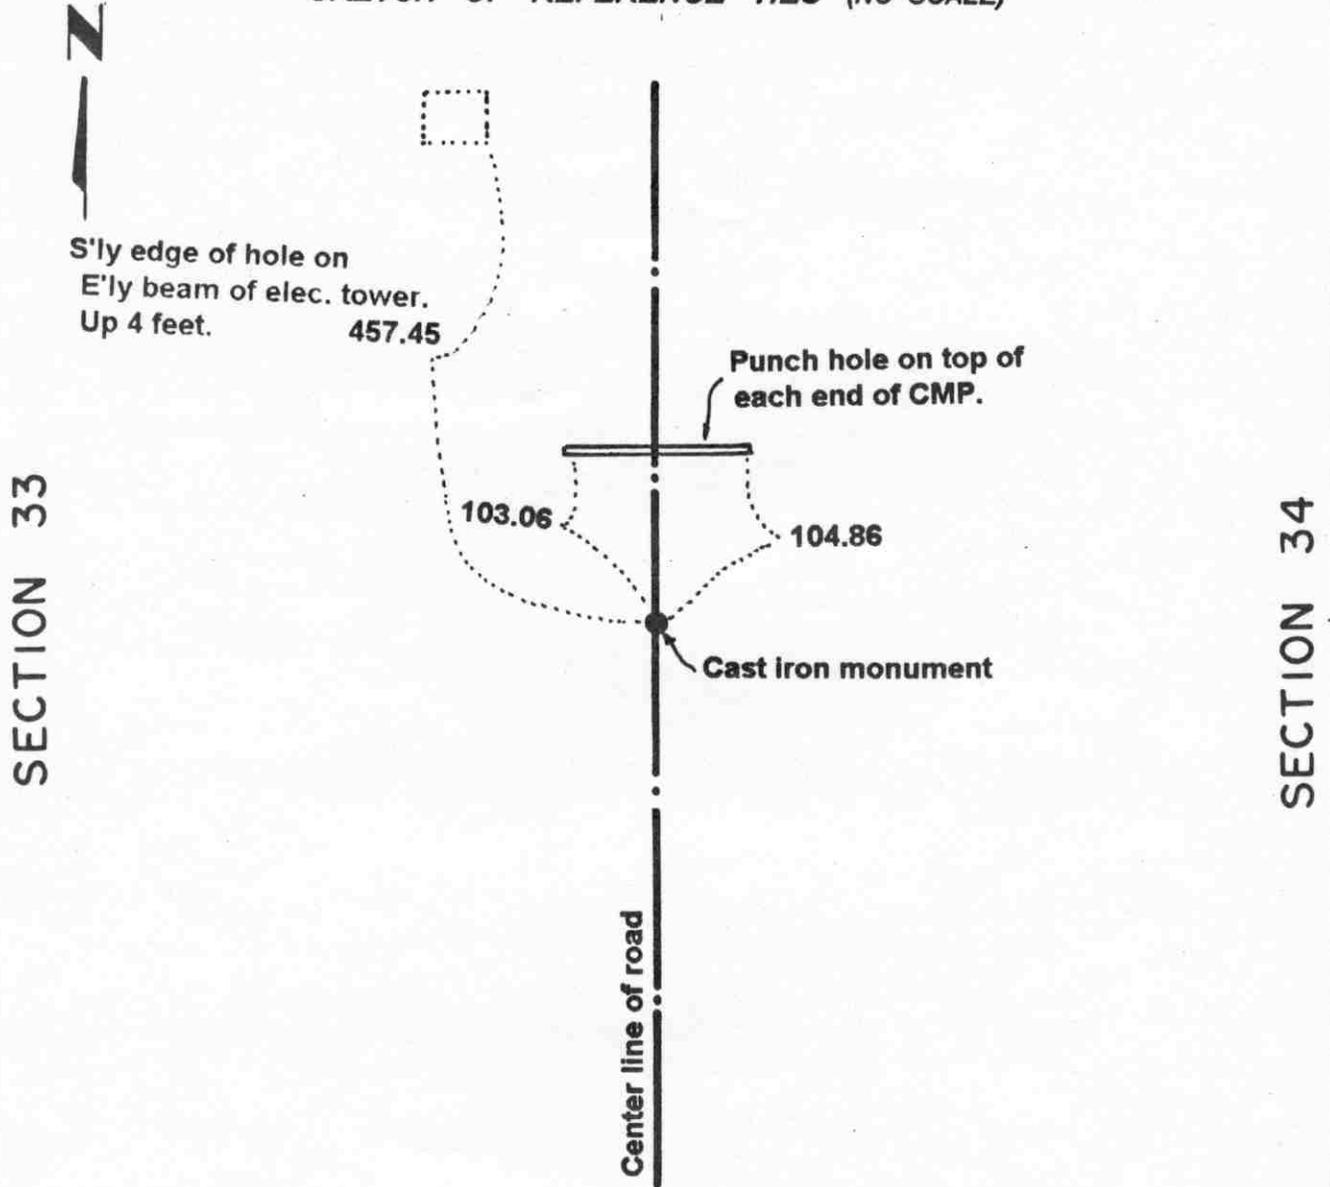

**Statement of evidence relative to this corner location on sheet 2**

I hereby certify that this document was prepared by me or under my direct supervision.

Willard Pellinen  
 Willard Pellinen  
 McLeod County Surveyor  
 License No. 9626.

Date Oct. 9, 1995

**OFFICE OF THE COUNTY RECORDER  
 MCLEOD COUNTY, MINNESOTA**

I hereby certify that this document was filed in this office at 9 o'clock A. M. on the 13th day of October 19 95.

Carmen Estlie Mulder, County Recorder

By \_\_\_\_\_, Deputy.

Document No. 268596

**Certificate of Location of Government Corner**  
**East Quarter Corner, Section 33, Township 116 North, Range 27 West**

*November, 1856. E. N. Darling of the General Land Office established this corner. He set a post and marked a 5 inch and a 6 inch aspen for bearing trees.*

*No property lines east or west at this corner. No testimony to help re-establish this corner. We set a temporary quarter corner half way between the section corners on the center line of the north-south road. We dug for the corner, John Tupa from Hutchinson with a backhoe. Down below the road surface, in the original ground, we found a rotted wood post, round, 4 inches in diameter. We took available reference ties and set a McLeod County cast iron monument. This is within a half foot of being half way between the section corners.*

*May 15, 1995. We checked the reference ties.*

NORTHEAST corner, Section 33, Township 116 North, Range 27 West


# Certificate of Location of Government Corner

SKETCH OF REFERENCE TIES  
(NO SCALE)



SECTION 28

SECTION 27

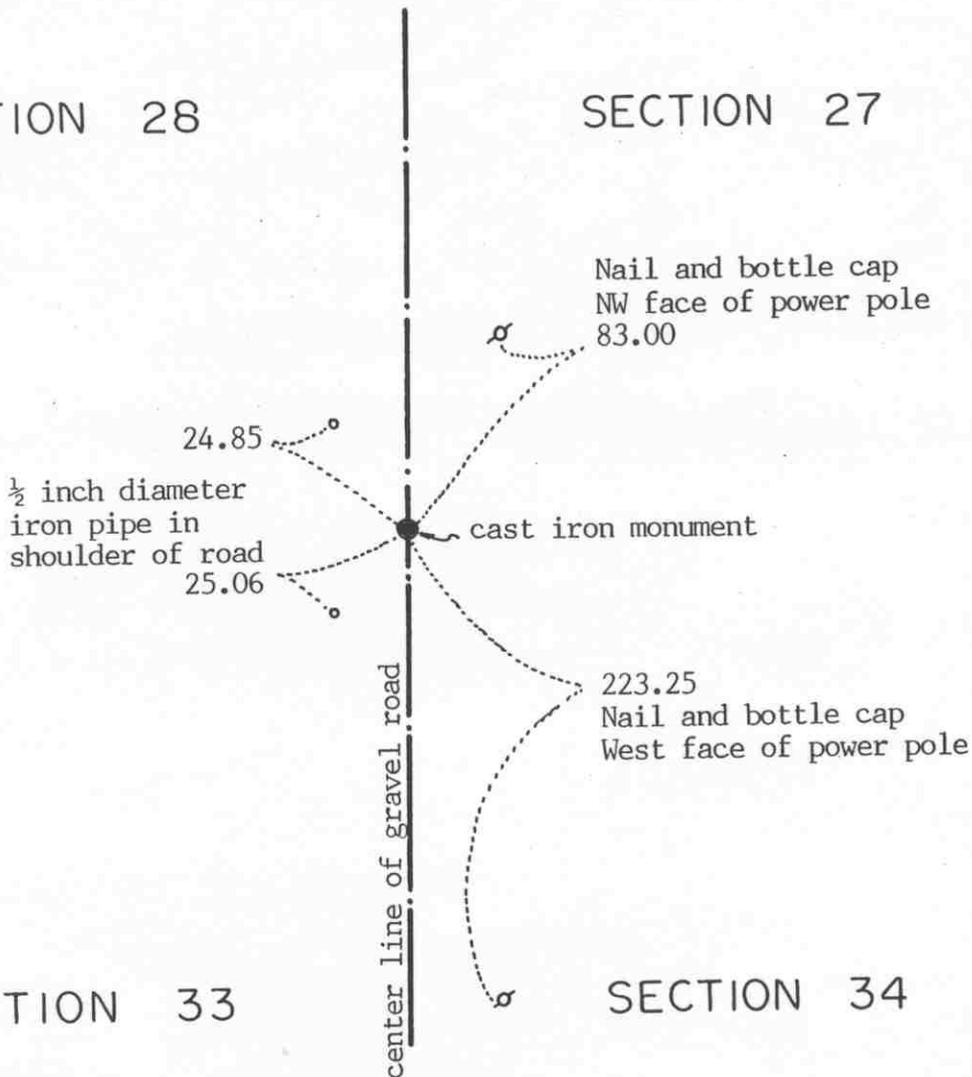

SECTION 33

SECTION 34

Statement of evidence relative to this corner location on sheet 2

I hereby certify that this document was prepared by me or under my direct supervision.

Willard Pellinen

Willard Pellinen  
McLeod County Surveyor  
License No. 9626

Date July 27, 1993

OFFICE OF THE COUNTY RECORDER  
MCLEOD COUNTY, MINNESOTA.

I hereby certify that this document was filed in this office at 4 o'clock P.M. on the 5th day of August, 19 93.

Carmen Belle Mulder, County Recorder

By \_\_\_\_\_, Deputy

Document No. 253991

NORTHEAST corner, Section 33, Township 116 North, Range 27 West

## Certificate of Location of Government Corner

November, 1856. E. N. Darling of the General Land Office established this corner. He set a post and marked 1 ash and 3 oaks for bearing trees.

August 20, 1975. McCombs Knutson Associates (Dickman Knutson, county surveyor) set a McLeod County cast iron monument over a found 6 inch by 4 inch stone. This stone was on the center line P.I. of the north-south road. No occupation lines east or west. This is within a foot of being half way between the east quarter corner of Section 28 and the east quarter corner of Section 33.


March 13, 1993. We found the monument in good condition down 6 inches below the surface of the road and took new reference ties.

# Certificate of Location of Government Corner

NORTH QUARTER corner, Section 33, Township 116 North, Range 27 West

SKETCH OF REFERENCE TIES (NO SCALE)

SECTION 28

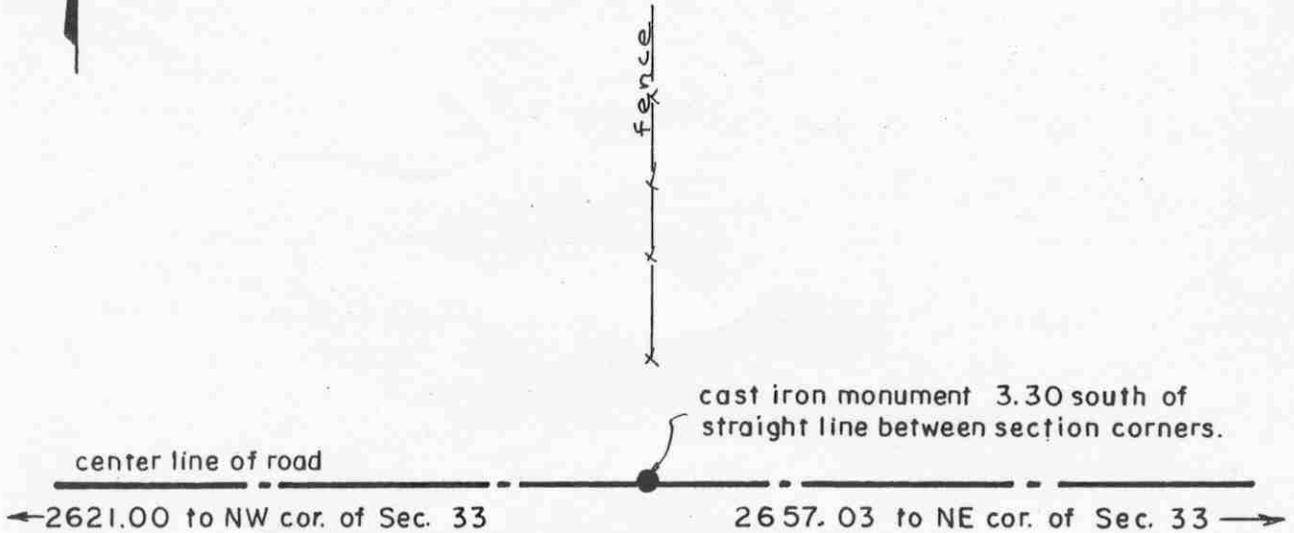

SECTION 33

Statement of evidence relative to this corner location on sheet 2

I hereby certify that this document was prepared by me or under my direct supervision.

Willard Pellinen  
Willard Pellinen  
McLeod County Surveyor  
License No. 9626.

Date Jan. 4, 1995

OFFICE OF THE COUNTY RECORDER  
MCLEOD COUNTY, MINNESOTA

I hereby certify that this document was filed in this office at 9 o'clock A. M. on the 10th day of January, 1995.

Carmen Helie Mulder County Recorder

By \_\_\_\_\_, Deputy.

Document No. 263641

**Certificate of Location of Government Corner**  
**North Quarter Corner, Section 33, Township 116 North, Range 27 West**

*November, 1856. E. N. Darling of the General Land Office established this corner. He set a post and marked 2 five inch aspens for bearing trees.*

*September 23, 1977. Dickman Knutson, county surveyor, excavated for the corner, John Tupa from Hutchinson with a backhoe. They found a stone down 1 1/2 feet below the surface of the road. Stone was 8 inches square on top, 12 inches high. Knutson left the stone in place and placed a half inch diameter iron pipe over the stone and took available reference ties.*

*June 14, 1979. We replaced the iron pipe with a McLeod County cast iron monument. We measured 2621.00 feet to the northwest corner and 2657.03 feet to the northeast corner of Section 33. We had an angle of 180 degrees 08 minutes 35 seconds at the corner, on the south side of the section line. We measured 5234.12 feet to the south quarter corner of Section 33.*


*January 3, 1995. We checked the reference ties to the monument.*

# Certificate of Location of Government Corner

NORTH QUARTER corner, Section 4, Township 115 North, Range 27 West

SKETCH OF REFERENCE TIES (NO SCALE)

SECTION 33, T. 116 N., R. 27 W.

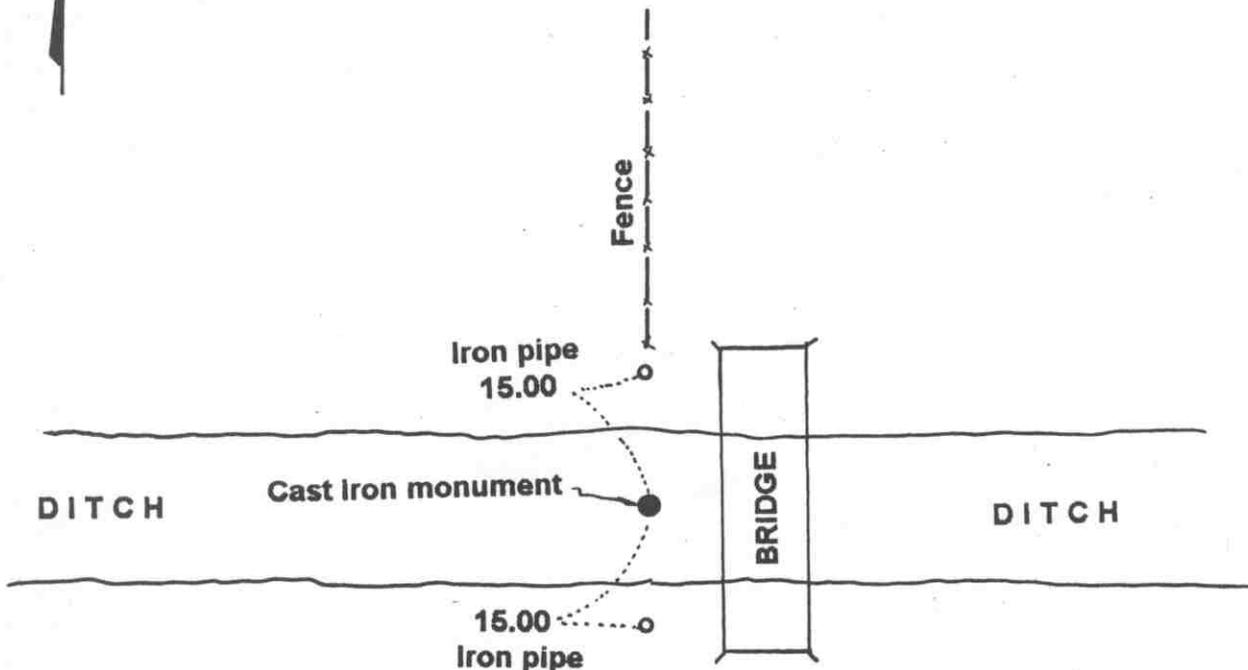

SECTION 4, T. 115 N., R. 27 W.

Statement of evidence relative to this corner location on sheet 2

I hereby certify that this document was prepared by me or under my direct supervision.

Willard Pellinen  
Willard Pellinen  
McLeod County Surveyor  
License No. 9626.

Date June 9, 1995

OFFICE OF THE COUNTY RECORDER  
MCLEOD COUNTY, MINNESOTA

I hereby certify that this document was filed in this office at 2 o'clock P. M. on the 13th day of June 19 95.

GARREN OSTLIE HILDFR, MCLEOD COUNTY RECORDER

County Recorder

By Phyllis Sopkowiak, Deputy.

Document No. 266252

**Certificate of Location of Government Corner**  
**North Quarter Corner, Section 4, Township 115 North, Range 27 West**

**1855. John Ryan of the General Land Office established this corner. He set a a post at the corner (at the west edge of a swamp) and marked an 8 inch and a 12 inch aspen for bearing trees.**

**September, 1969. Dickman Knutson, county surveyor, set a McLeod County cast iron monument in the center of a east-west ditch in line with a fence to the north. Mr. Elde, Mr. Kulmann and Mr. Engelman, area land owners, all stated this was the correct location of the government corner. Knutson took available reference ties.**

**March 29, 1995. We checked the reference ties.**

# Certificate of Location of Government Corner

NORTHEAST corner, Section 4, Township 115 North, Range 27 West

SKETCH OF REFERENCE TIES (NO SCALE)

T.116 N., R. 27 W.

SECTION 33

SECTION 34



Nail and bottle cap in  
north face of power pole  
26.91

Wood fence post  
1.3

Cast iron monument

Field line

Fence

Fence

SECTION 4

SECTION 3

T.115 N., R. 27 W.

Statement of evidence relative to this corner location on sheet 2

I hereby certify that this document was prepared by me or under my direct supervision.

Willard Pellinen  
Willard Pellinen  
McLeod County Surveyor  
License No. 9626.

Date June 9, 1995

OFFICE OF THE COUNTY RECORDER  
MCLEOD COUNTY, MINNESOTA

I hereby certify that this document was filed in this office at 2 o'clock P.M. on the 13th day of June 19 95.

CARMEN OSTLE MILDFR., MCLEOD COUNTY RECORDER

County Recorder

By Phyllis Sopotowiak, Deputy.

Document No. 266251

**Certificate of Location of Government Corner**  
**Northeast Corner, Section 4, Township 115 North, Range 27 West**

**1855. John Ryan of the General Land Office established this corner. He set a post and marked two 10 inch aspens, an 8 inch aspen and a 7 inch aspen for bearing trees.**

**September, 1969. Dickman Knutson, county surveyor, set a McLeod County cast iron monument at the intersection of fences. Fences north, south and east. This has been accepted as the corner by adjoining land owners. Knutson took available reference ties.**

**March 29, 1995. We checked the reference ties.**

# Certificate of Location of Government Corner

EAST QUARTER corner, Section 34, Township 116 North, Range 27 West

SKETCH OF REFERENCE TIES (NO SCALE)




2627.25 feet to southeast corner of Sec. 34  
 2634.47 feet to northeast corner of Sec. 34

SECTION 34

SECTION 35

Nail and bottle cap in north face of west tree of twin 16 inch tree.

Nail and bottle cap in west face of 10 inch tree.

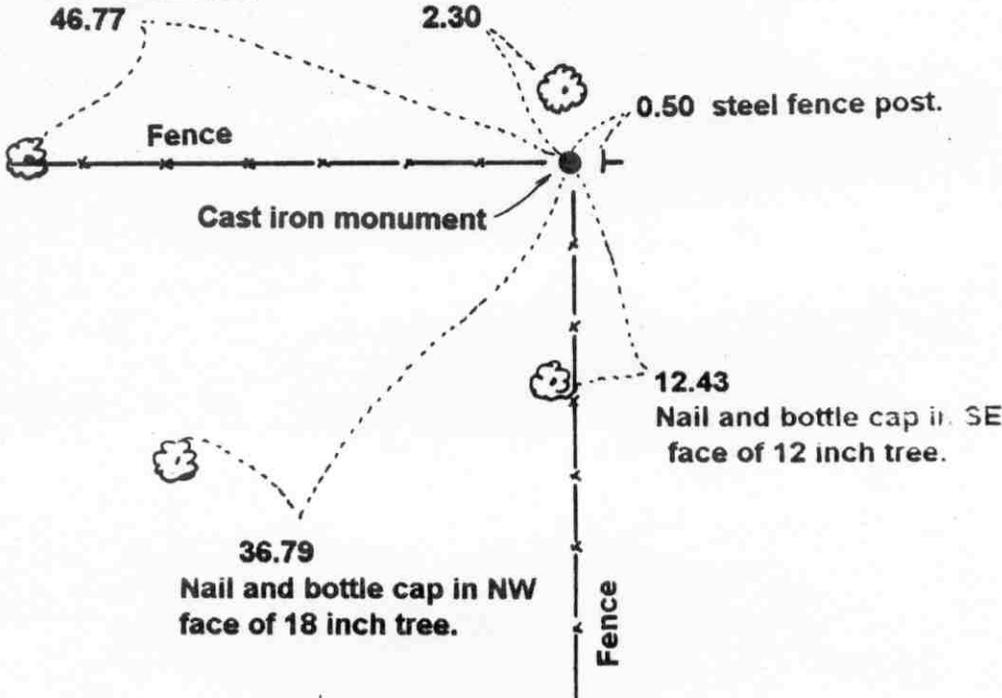

36.79  
 Nail and bottle cap in NW face of 18 inch tree.

Statement of evidence relative to this corner location on sheet 2

I hereby certify that this document was prepared by me or under my direct supervision.

Willard Pellinen  
 Willard Pellinen  
 McLeod County Surveyor  
 License No. 9626.

Date Dec 13, 1995

OFFICE OF THE COUNTY RECORDER  
 MCLEOD COUNTY, MINNESOTA

I hereby certify that this document was filed in this office at 9 o'clock A.M. on the 9th day of January 19 96.

Carmen Ostlie Mudder, County Recorder

By Charleen Engelman, Deputy.

Document No. 270208

**Certificate of Location of Government Corner**  
**East Quarter Corner, Section 34, Township 116 North, Range 27 West**

**November, 1856. E. N. Darling of the General Land Office established this corner. He set a post and marked 2 five inch oaks for bearing trees.**

**August 20, 1975. Mr. August Schuete, 63 years old and had lived in the Southeast Quarter of Section 34 all his life, stated the fence corner, fences south and west is the quarter corner. Other adjoining land owners agree.**


**August 20, 1975. Dickman Knutson, county surveyor, set a McLeod County cast iron monument at the fence intersection and took available reference ties. This corner is within 3 1/2 foot of being half way between the section corners.**

**January, 1995. The monument set by Knutson is accepted as marking the location of the government corner. It fits long standing occupation lines (the fences) which have been accepted by adjoining land owners as being along the section and quarter section lines.**

# Certificate of Location of Government Corner

NORTHEAST corner, Section 34, Township 116 North, Range 27 West

SKETCH OF REFERENCE TIES (NO SCALE)

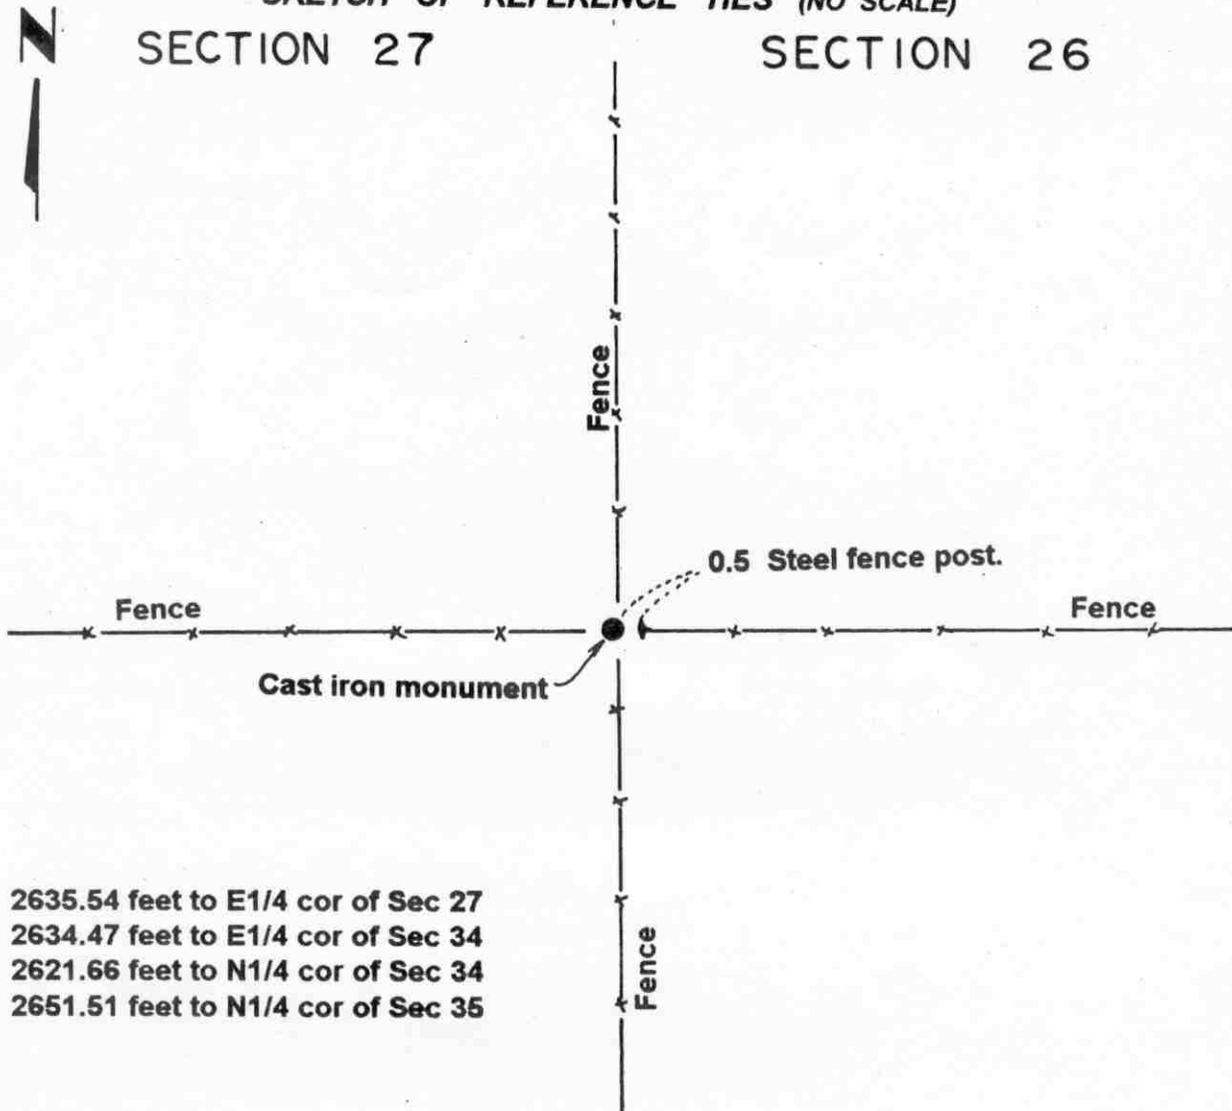

2635.54 feet to E1/4 cor of Sec 27  
 2634.47 feet to E1/4 cor of Sec 34  
 2621.66 feet to N1/4 cor of Sec 34  
 2651.51 feet to N1/4 cor of Sec 35

SECTION 34                      SECTION 35

Statement of evidence relative to this corner location on sheet 2

I hereby certify that this document was prepared by me or under my direct supervision.

Willard Pellinen  
 Willard Pellinen  
 McLeod County Surveyor  
 License No. 9626.

Date Dec. 13, 1995

OFFICE OF THE COUNTY RECORDER  
 MCLEOD COUNTY, MINNESOTA

I hereby certify that this document was filed in this office at 9 o'clock A. M. on the 9th day of January, 19 96.

Carmen Estlie Muller, County Recorder

By Charleen Engelman, Deputy.

Document No. 270207

**Certificate of Location of Government Corner**  
**Northeast Corner, Section 34, Township 116 North, Range 27 West**

**November, 1856. E. N. Darling of the General Land Office established this corner. He set a post and marked an aspen, an elm and 2 oaks for bearing trees.**

**1975. Adjoining land owners all agree the fence intersection, fences north, south, east and west, is the section corner.**

**August 20, 1975. Dickman Knutson, county surveyor, set a McLeod County cast iron monument at the fence intersection and took available reference ties.**

**We measured 2634.47 feet to the east quarter corner of Section 34. We measured 2651.51 feet to the north quarter corner of Section 35 and we measured 2635.54 feet to the east quarter corner of Section 27.**

**January, 1995. The monument set by Knutson is accepted as marking the location of the government corner. It fits long standing occupation lines (the fences) which have been accepted by adjoining land owners as being along the section and quarter section lines.**

NORTH QUARTER corner, Section 34, Township 116 North, Range 27 West

# Certificate of Location of Government Corner

SKETCH OF REFERENCE TIES  
(NO SCALE)



SECTION 27



2629.41 feet to NW corner of Section 34

2621.66 feet to NE corner of Section 34

2624.58 feet to center of Section 27

cast iron monument

Angle on north side of quarter corner, turned from northwest corner to northeast corner is 180° 23' 13"

SECTION 34

Statement of evidence relative to this corner location on sheet 2

I hereby certify that this document was prepared by me or under my direct supervision.

Willard Pellinen

Willard Pellinen  
McLeod County Surveyor  
License No. 9626

Date July 26, 1993

OFFICE OF THE COUNTY RECORDER  
MCLEOD COUNTY, MINNESOTA.

I hereby certify that this document was filed in this office at 4 o'clock P. M. on the 5th day of August, 1993.

Carmen Estelle Quader, County Recorder

By \_\_\_\_\_, Deputy

Document No. 253992

NORTH QUARTER corner, Section 34, Township 116 North, Range 27 West

## *Certificate of Location of Government Corner*

November, 1856. E.N.Darling of the General Land Office established this corner. He set a post and marked a 14 inch and a 10 inch elm for bearing trees.

August, 1975. Dickman Knutson, county surveyor, found a rusted iron pipe along the north-south fence line which has been accepted as the north-south quarter line of Sections 34 and 27. Knutson replaced the iron pipe with a McLeod County cast iron monument.

This falls 8.88 feet north and 3.87 feet east of a lost position for the corner.


March 9, 1993. We found the monument in good condition under the north-south fence. No available reference ties.

# Certificate of Location of Government Corner

NORTH QUARTER corner, Section 3, Township 115 North, Range 27 West

SKETCH OF REFERENCE TIES (NO SCALE)

SECTION 34, T.116 N., R.27 W.

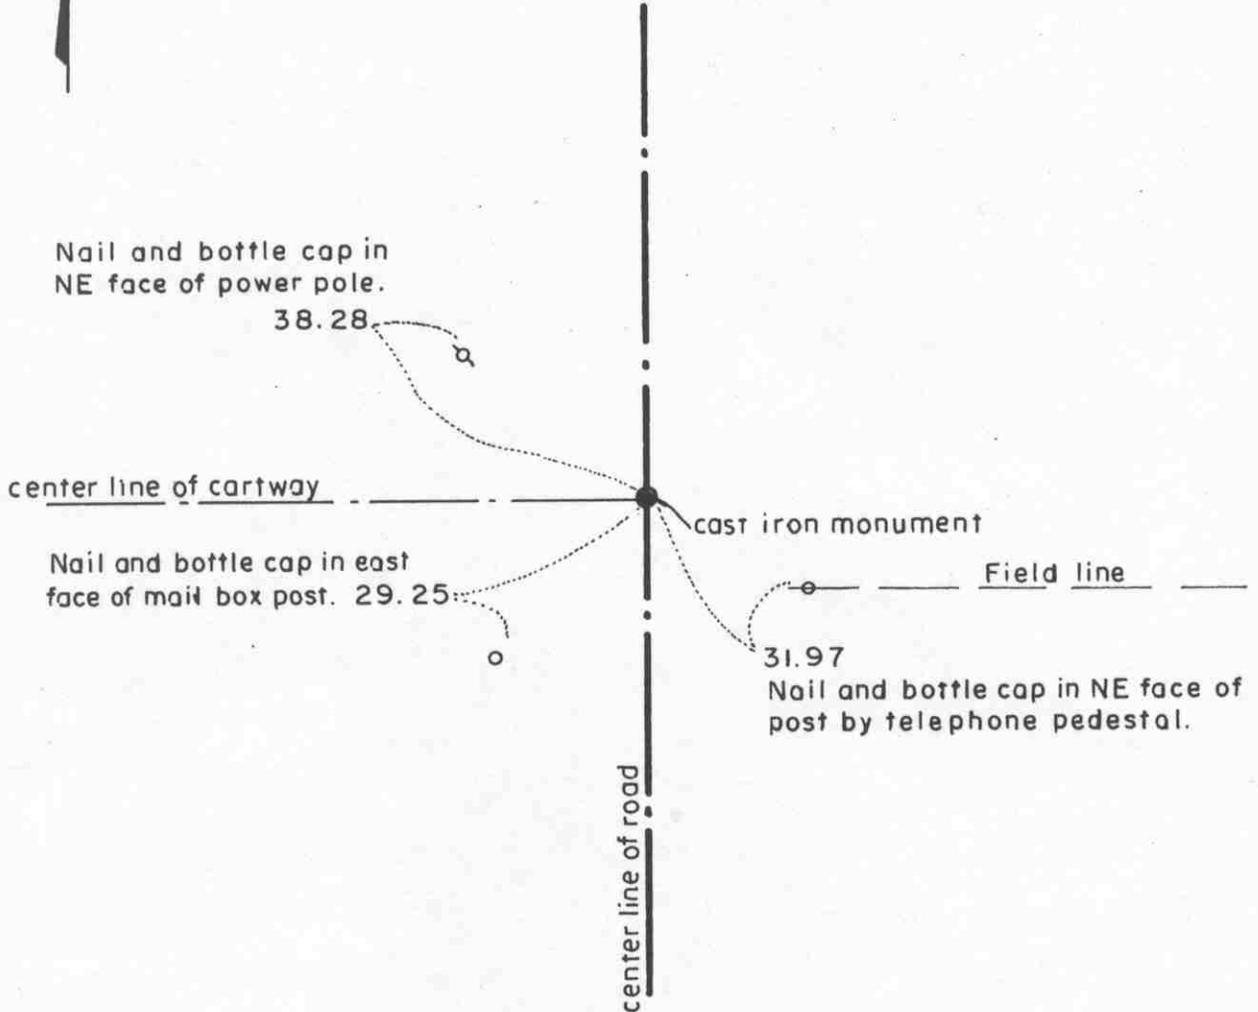

SECTION 3, T.115 N., R.27 W.

Statement of evidence relative to this corner location on sheet 2

I hereby certify that this document was prepared by me or under my direct supervision.

Willard Pellinen  
Willard Pellinen  
McLeod County Surveyor  
License No. 9626.

Date April 17, 1995

OFFICE OF THE COUNTY RECORDER  
MCLEOD COUNTY, MINNESOTA

I hereby certify that this document was filed in this office at 9 o'clock A.M. on the 24th day of Apr 19 95.

Carmen Ostlie Mulder County Recorder

By \_\_\_\_\_, Deputy.

Document No. 265297

**Certificate of Location of Government Corner**  
**North Quarter Corner, Section 3, Township 115 North, Range 27 West**

**1855. John Ryan of the General Land Office established this corner. He set a post and marked two 10 inch oaks for bearing trees.**

**September, 1969. Dickman Knutson, county surveyor, found an iron pipe at the center line intersection of a north-south road and a cartway to the west. This point has been accepted by adjoining land owners as the quarter corner. Knutson replaced the iron pipe with a McLeod County cast iron monument and took reference ties.**

**February 2, 1995. We found the monument in good condition down 8 inches below the surface of the gravel road and took new ties.**

# Certificate of Location of Government Corner


NORTHEAST corner, Section 3, Township 115 North, Range 27 West

SKETCH OF REFERENCE TIES (NO SCALE)

T. 116 N., R. 27 W.

SECTION 34

SECTION 35

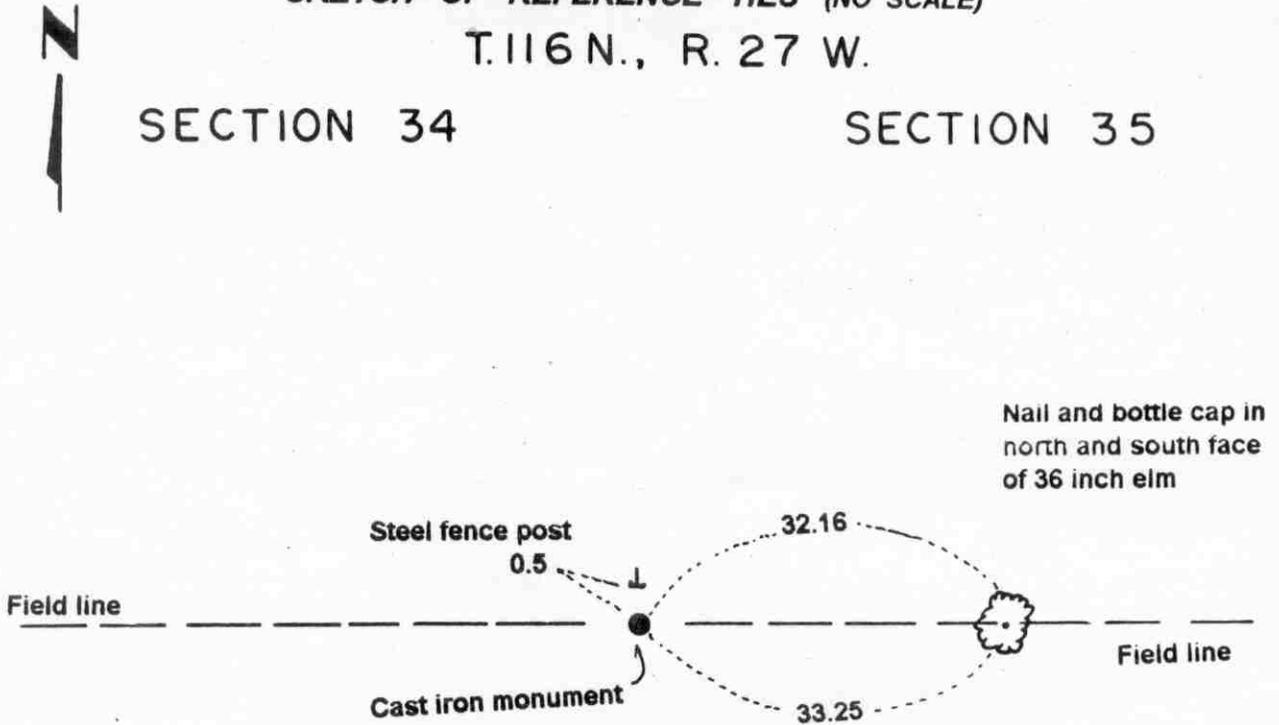

SECTION 3

SECTION 2

T. 115 N., R. 27 W.

Statement of evidence relative to this corner location on sheet 2

I hereby certify that this document was prepared by me or under my direct supervision.

Willard Pellinen  
Willard Pellinen  
McLeod County Surveyor  
License No. 9626.

Date Sept. 7, 1995

OFFICE OF THE COUNTY RECORDER  
MCLEOD COUNTY, MINNESOTA

I hereby certify that this document was filed in this office at 9 o'clock A. M. on the 14th day of Sept 19 95.

Carmen Ostlie Muder, County Recorder

By \_\_\_\_\_, Deputy.

Document No. 268046

**Certificate of Location of Government Corner**  
**Northeast Corner, Section 3, Township 115 North, Range 27 West**

**1855. John Ryan of the General Land Office established this corner. He set a a post and marked 2 six inch aspens, a 12 inch linden and a 10 inch oak for bearing trees.**


**1969. Dickman Knutson, county surveyor, found a 1 1/2 inch diameter iron pipe and took available reference ties. This was within 1/2 foot of 1940 distance to the north quarter corner of Section 2 and within 1/2 foot of 1940 distance to a found iron pipe a quarter mile east.**

**April 10, 1995. We found the monument in good condition down 3 inches below the surface and took new available ties.**

# Certificate of Location of Government Corner

EAST QUARTER corner, Section 35, Township 116 North, Range 27 West

SKETCH OF REFERENCE TIES (NO SCALE)

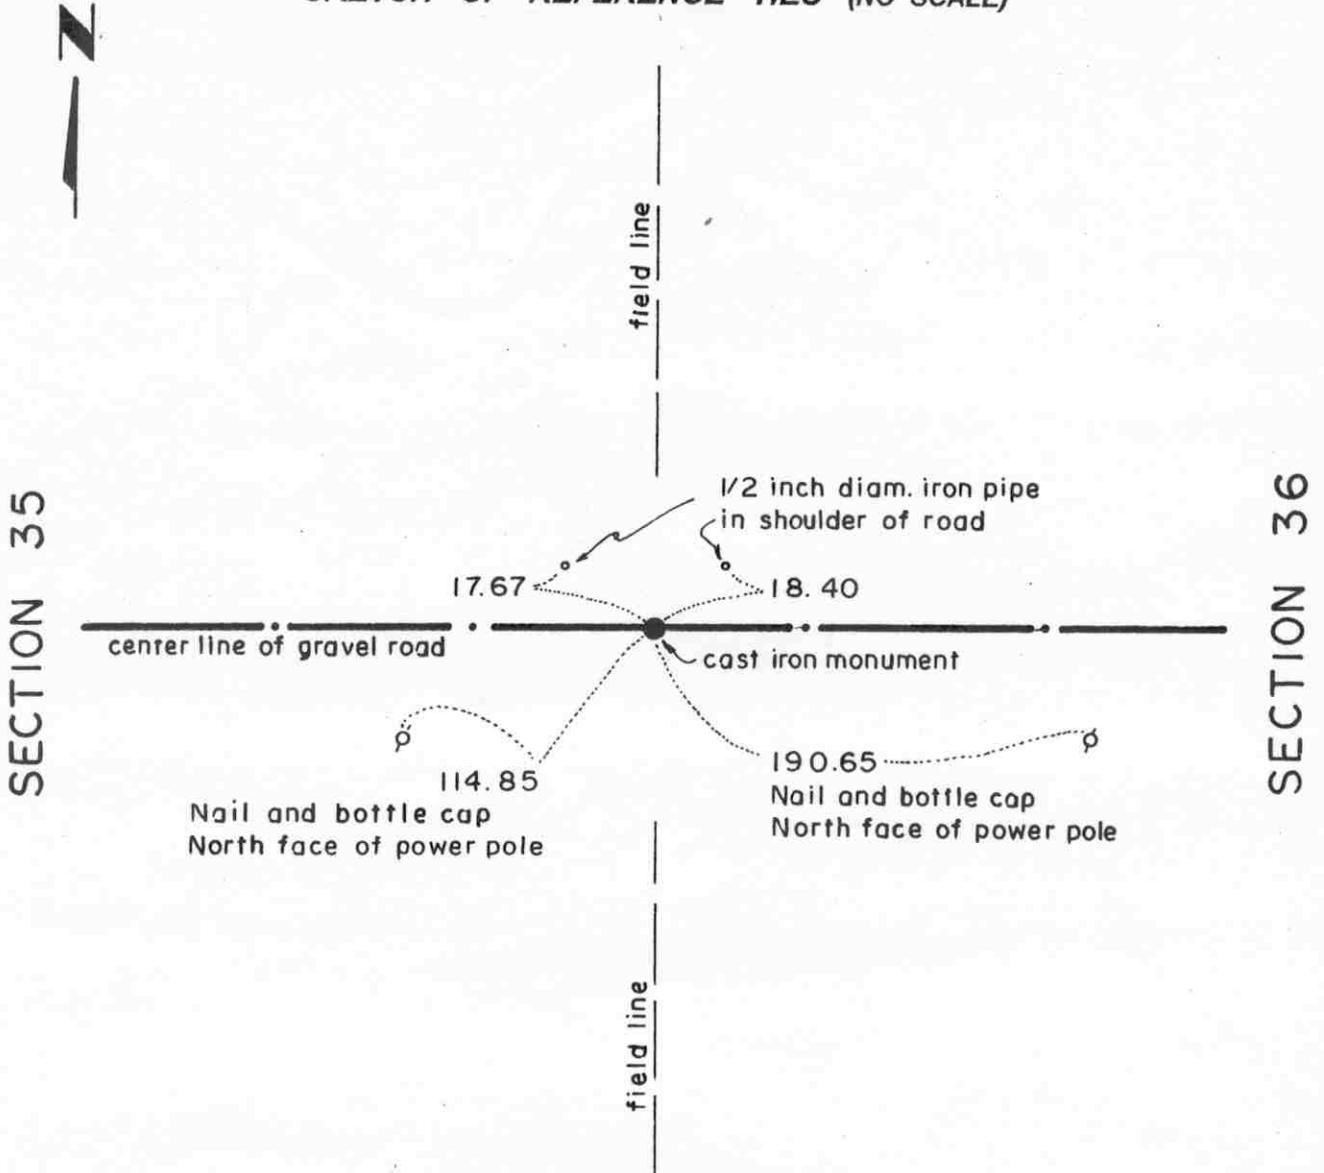

**Statement of evidence relative to this corner location on sheet 2**

I hereby certify that this document was prepared by me or under my direct supervision.

Willard Pellinen  
 Willard Pellinen  
 McLeod County Surveyor  
 License No. 9626.

Date Sept. 7, 1994

**OFFICE OF THE COUNTY RECORDER  
 MCLEOD COUNTY, MINNESOTA**

I hereby certify that this document was filed in this office at 9 o'clock A. M. on the 22nd day of September 19 94.

Carmen O'Brien Mulder, County Recorder

By \_\_\_\_\_, Deputy.

Document No. 261946

## **Certificate of Location of Government Corner**

**East Quarter Corner, Section 35, Township 116 North, Range 27 West**

**November, 1856. E. N. Darling of the General Land Office originally established this corner. He set a post and marked a 10 inch oak and a 30 inch linden for bearing trees.**

**July 27, 1982. We excavated for the corner, John Tupa from Hutchinson with a backhoe. Down 6 inches below the road surface we found a 6 inch spike and a bottle cap. Directly below the spike, down 2 1/2 feet below the road surface, we found an old rotted wood stake. We took available reference ties.**

**August 26, 1982. Mr. Orville Hoerneman, who was 60 years old and had lived on farm in East Half of Section 35 all his life, said the center line of the road and the field lines running north and south have always been accepted as being on the quarter lines and on the section lines of Section 35 and Section 36. The stake we found was on the center line of the east-west road, in line with the field lines running north and south.**

**August 26, 1982. We set a McLeod County cast iron monument at the corner.**

**This corner is 1.33 feet south of a split between the section corners and 7.61 feet west of a straight line between the section corners.**

**August 23, 1994. We found the monument in good condition down 8 inches below the surface of the gravel road and took new reference ties.**

# Certificate of Location of Government Corner

NORTHEAST corner, Section 35, Township 116 North, Range 27 West

## SKETCH OF REFERENCE TIES (NO SCALE)



SECTION 26

SECTION 25

2636.82 feet to E1/4 corner of Section 26

Field line



1/2 inch iron pipe at east base of 26 inch elm.

2634.16 feet to N1/4 corner of Section 35

2633.83 feet to E1/4 corner of Section 35

Field line

SECTION 35

SECTION 36

### Statement of evidence relative to this corner location on sheet 2

I hereby certify that this document was prepared by me or under my direct supervision.

Willard Pellinen  
Willard Pellinen  
McLeod County Surveyor  
License No. 9626.

Date April 20, 1995

### OFFICE OF THE COUNTY RECORDER MCLEOD COUNTY, MINNESOTA

I hereby certify that this document was filed in this office at 9 o'clock A M. on the 24th day of Apr 19 95.

Armen Asthian, County Recorder

By \_\_\_\_\_, Deputy.

Document No. 265325

**Certificate of Location of Government Corner**  
**Northeast Corner, Section 35, Township 116 North, Range 27 West**

*November, 1856. E. N. Darling of the General Land Office established this corner. He set a post and marked a 10 inch oak, 2 six inch aspens and a 10 inch ash for bearing trees.*

*October 8, 1985. Mr. Orville Hoernemann, who had lived in the East Half of Section 35 all his life, and his father before him, said the field lines are in the same location as they have been as long as he can remember. He didn't know of any "marker" at the corner but it should be very near to a large tree. Mr. Hoernemann was 63 years old. Other adjoining land owners agree. We set an iron pipe at the corner and measured 2634.16 feet to the north quarter corner and 2633.83 feet to the east quarter corner of Section 35. We measured 2636.82 feet to the east quarter corner of Section 26.*

*February 2, 1995. We found the iron pipe at the east base of a 26 inch elm.*


# Certificate of Location of Government Corner



SKETCH OF REFERENCE TIES

(NO SCALE)

SECTION 26

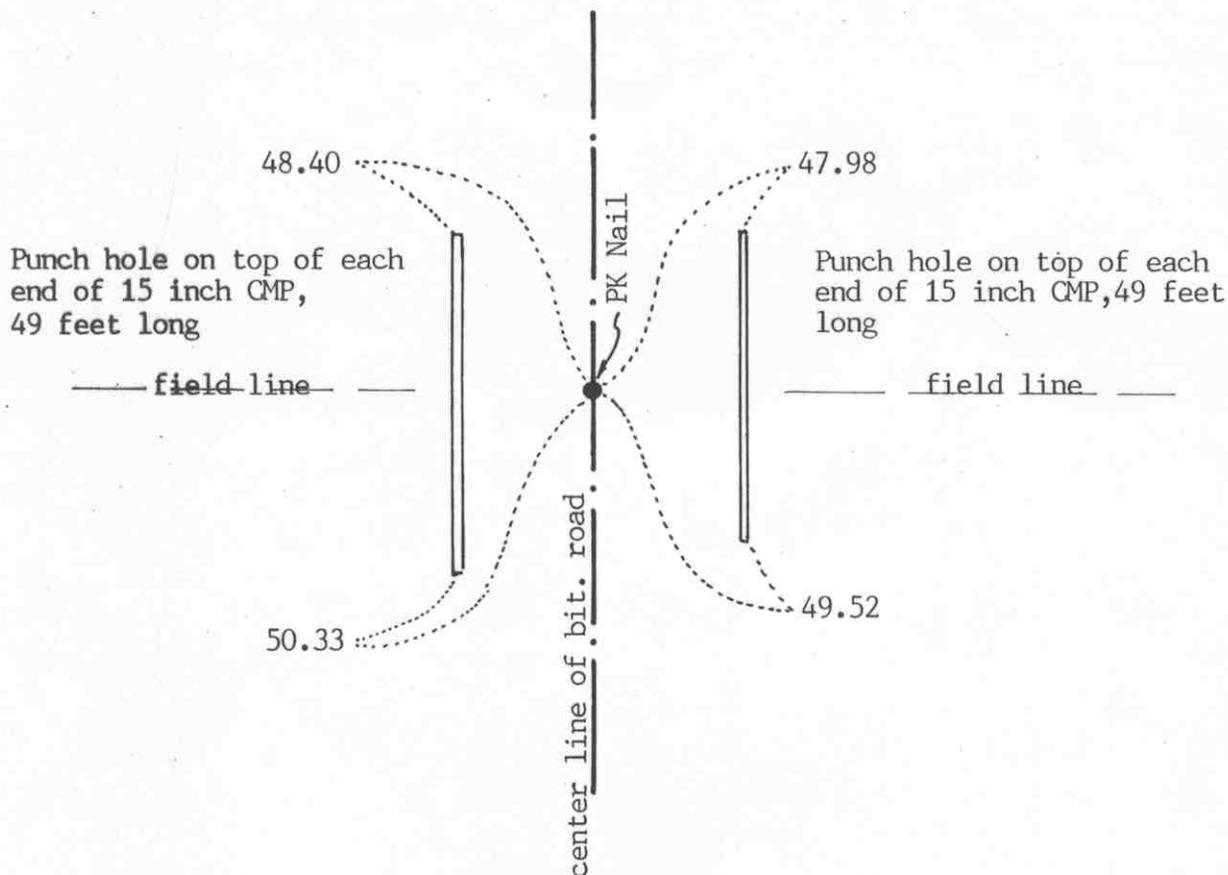

SECTION 35

Statement of evidence relative to this corner location on sheet 2

I hereby certify that this document was prepared by me or under my direct supervision.

Willard Pellinen

Willard Pellinen  
McLeod County Surveyor  
License No. 9626

Date August 10, 1992

OFFICE OF THE COUNTY RECORDER  
MCLEOD COUNTY, MINNESOTA.

I hereby certify that this document was filed in this office at 9 o'clock A.M. on the 20th day of Aug, 1992.

Carmen Oltie, County Recorder

By \_\_\_\_\_, Deputy

Document No. 247340

## Certificate of Location of Government Corner

November 1856. E. N. Darling set a post and marked an elm and a linden tree for bearing trees.

1924. The county highway department measured 5266 feet between the north and south quarter corners of section 35.

1975. We found a large spike down  $1\frac{1}{2}$  feet below the surface of the road. We tied it off and dug below but found nothing else.

January 7, 1981. We measured the north south quarter line and had 5265.82 feet compared with 5266 feet by the highway department in 1924. Mr. Wilbert Stuedemann, 69 years old, in the southeast quarter of Section 26 all his life said this is the correct corner. (the center line of the road, field lines east and west)

August 11, 1981. We set a  $\frac{1}{2}$  inch diameter iron pipe at the corner and took additional reference ties.

May 23, 1990. All the old ties and the quarter corner will be destroyed by road construction. We took new ties.

December 31, 1991. We reset the corner, a PK Nail and took new reference ties.

We accept the spike we found in 1975 as having perpetuated the correct location of the quarter corner. It fits occupation lines, the center line of the road and the field lines east and west.


# Certificate of Location of Government Corner



## SKETCH OF REFERENCE TIES

(NO SCALE)

SECTION 35 T 116 R 27

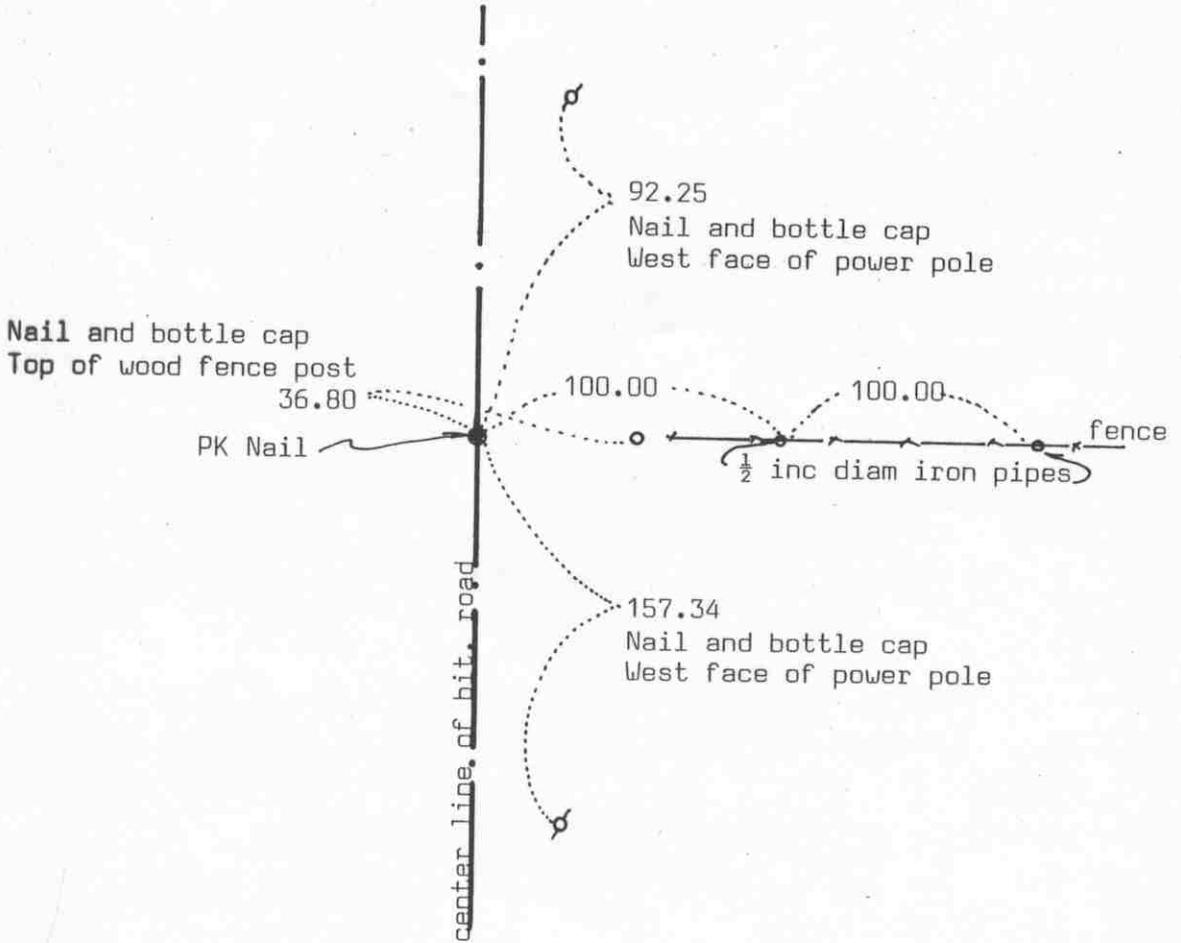

SECTION 2 T 115 R 27

Statement of evidence relative to this corner location on sheet 2

I hereby certify that this document was prepared by me or under my direct supervision.

Willard Pellinen  
Willard Pellinen  
McLeod County Surveyor  
License No. 9626

Date August 17, 1992

OFFICE OF THE COUNTY RECORDER  
MCLEOD COUNTY, MINNESOTA.

I hereby certify that this document was filed in this office at 9 o'clock A.M. on the 20th day of Aug, 1992.

Sarmin O'Brien, County Recorder

By \_\_\_\_\_, Deputy

Document No. 247332

## Certificate of Location of Government Corner

July, 1855. John Ryan of the General Land Office set a post and marked an oak and an aspen for bearing trees.

1940. E. L. Higgins, county surveyor, set a steel corner. He measured 2647.6 to the northwest corner of Section 2. He set the corner along the center line of the north-south road in line with fences east and west.

September 15, 1969. McCombs Knutson Associates (Dickman Knutson, county surveyor, set a McLeod County cast iron monument at the center line of the road in line with fences east and west. Adjoining property owners agree this is the correct location of the corner.

April 27, 1983. We reset the corner, old corner had been disturbed by road construction. We took new reference ties. We set a PK nail at the corner.

August 15, 1983. We reset a McLeod County cast iron monument at the corner.

May 24, 1990. We took extra reference ties, iron pipes 100.00 and 200.00 feet east of the corner along the north line of the Northeast Quarter of Section 2. Old ties to be destroyed by road construction.

December 31, 1991. We reset the corner, a PK nail, using the 1990 ties and took additional ties.

We accept the monument set by Knutson as marking the correct location of the quarter corner. The center line of the road and the fences had perpetuated the location of the corner.

This corner is within 2 feet of being on a split between the section corners and within  $1\frac{1}{2}$  feet of being on a straight line between the corners.

We measured 5265.82 feet to the north quarter corner of Section 35, compared with a distance of 5266 feet by the county highway department in 1924.

# Certificate of Location of Government Corner


NORTHEAST corner, Section 2, Township 115 North, Range 27 West

SKETCH OF REFERENCE TIES (NO SCALE)

T.116 N., R.27 W.

SECTION 35

SECTION 36

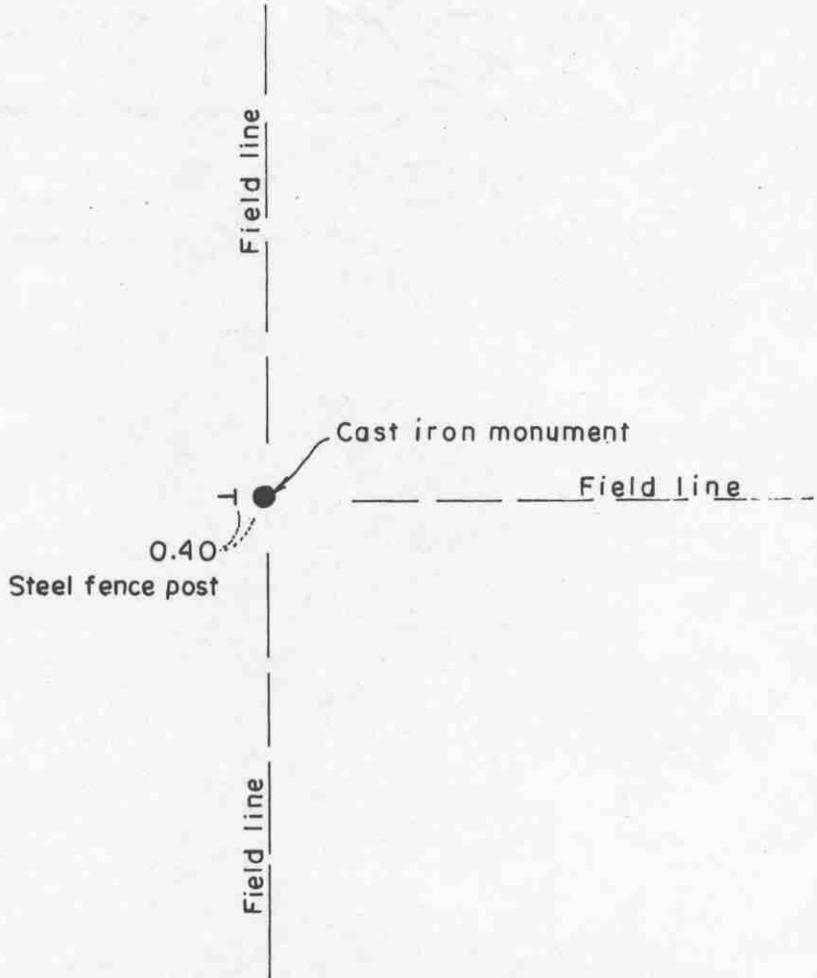

SECTION 2

SECTION 1

T.115 N., R.27 W.

Statement of evidence relative to this corner location on sheet 2

I hereby certify that this document was prepared by me or under my direct supervision.

Willard Pellinen  
Willard Pellinen  
McLeod County Surveyor  
License No. 9626.

Date April 17, 1995

OFFICE OF THE COUNTY RECORDER  
MCLEOD COUNTY, MINNESOTA

I hereby certify that this document was filed in this office at 9 o'clock A. M. on the 24th day of Apr 19 95.

Carmen Estlin Gulder County Recorder

By \_\_\_\_\_, Deputy.

Document No. 265295

**Certificate of Location of Government Corner**  
**Northeast Corner, Section 2, Township 115 North, Range 27 West**

**1855. John Ryan of the General Land Office established this corner. He set a post and marked a 10 inch oak, a 12 inch oak, a 20 inch elm and a 5 inch aspen for bearing trees.**


**1969. Dickman Knutson, county surveyor, set a McLeod County cast iron monument in the middle of a rock pile which adjoining land owners have accepted as being the section corner.**

**February 2, 1995. We found the monument in good condition in the middle of the rock pile, 0.4 feet east of a steel fence post.**

# Certificate of Location of Government Corner

East Quarter corner, Section 36, Township 116 North, Range 27 West

## SKETCH OF REFERENCE TIES (NO SCALE)

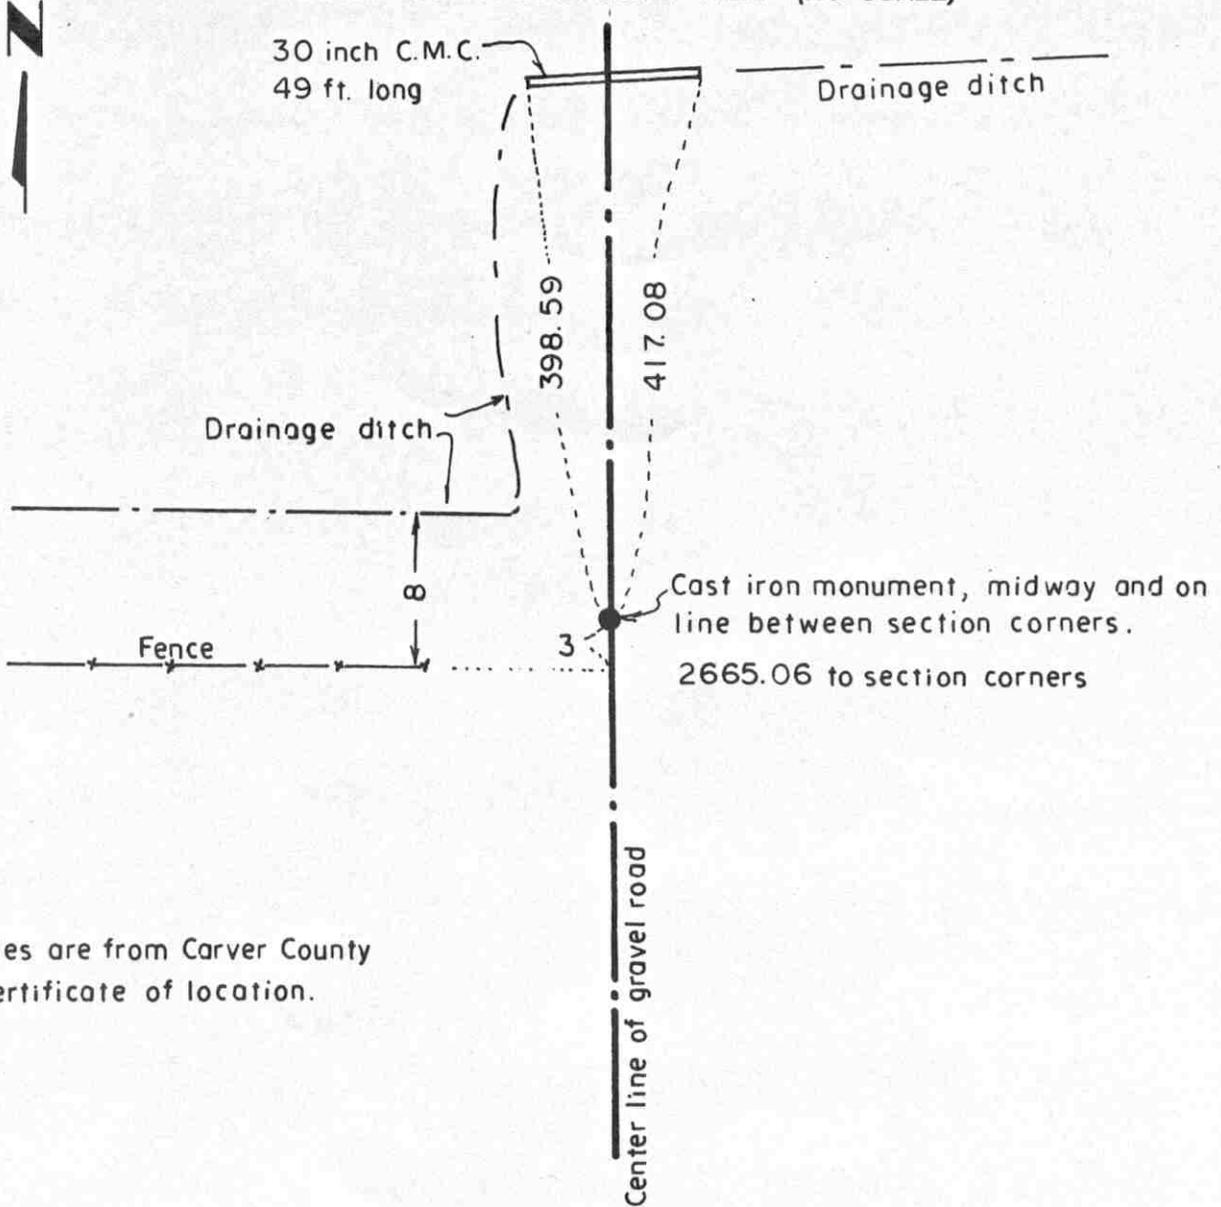

Ties are from Carver County certificate of location.

### Statement of evidence relative to this corner location on sheet 2

I hereby certify that this document was prepared by me or under my direct supervision.

Willard Pellinen  
 Willard Pellinen  
 McLeod County Surveyor  
 License No. 9626.

Date Dec. 13, 1995

### OFFICE OF THE COUNTY RECORDER MCLEOD COUNTY, MINNESOTA

I hereby certify that this document was filed in this office at 9 o'clock A. M. on the 9th day of January 19 96.

Carmen Estelle Mueller County Recorder

By Charleen Engelman, Deputy.

Document No. 270209

**Certificate of Location of Government Corner**  
**East quarter corner, Section 36, Township 116 North, Range 27 West**

**1855. John Ryan of the General Land Office originally established this corner.**

**1892. T.F. Kiernan either found or placed this corner midway between the section corners.**

**July, 1971. The Carver County Surveyor excavated for the corner at the center of the north-south road in line with a fence to the west. He found an egg-shaped field stone 28 inches by 18 inches by 24 inches.**


**December, 1972. The Carver County Surveyor measured the east line of Section 36 and found the stone to be midway and on line between the section corners. They set an iron pipe over the stone and took reference ties.**

**September, 1973. The Carver County Surveyor placed a cast iron monument over found stone.**

# Certificate of Location of Government Corner

Northeast corner, Section 36, Township 116 North, Range 27 West

SKETCH OF REFERENCE TIES (NO SCALE)

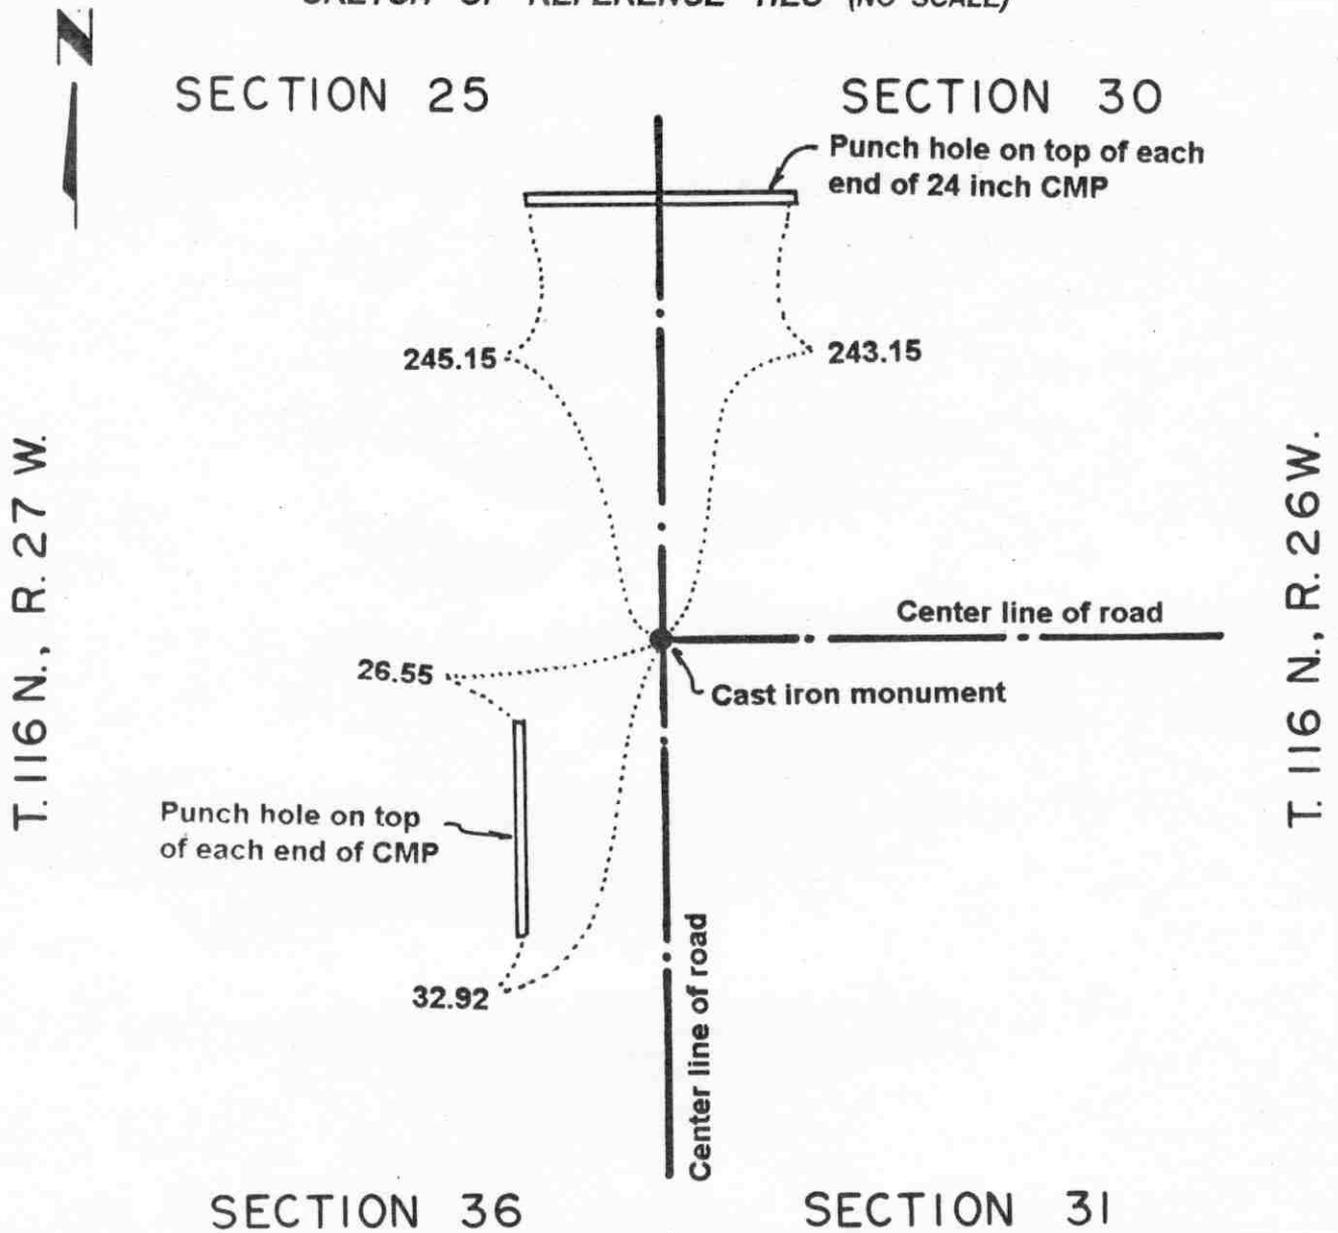

Statement of evidence relative to this corner location on sheet 2

I hereby certify that this document was prepared by me or under my direct supervision.

Willard Pellinen  
 Willard Pellinen  
 McLeod County Surveyor  
 License No. 9626.

Date Oct. 9, 1995

OFFICE OF THE COUNTY RECORDER  
 MCLEOD COUNTY, MINNESOTA

I hereby certify that this document was filed in this office at 9 o'clock A. M. on the 13th day of October 19 95.

Carmen Ostlie Mulder, County Recorder

By \_\_\_\_\_, Deputy.

Document No. 268597

## ***Certificate of Location of Government Corner***

***Northeast Corner, Section 36, Township 116 North, Range 27 West***

***1855. John Ryan of the General Land Office established this corner. He set a post in a marsh and marked 4 trees for bearing trees.***

***1968. Lindsey Engineering Company reported finding a sandstone monument.***

***July 27, 1971. Carver County Surveyor found a limestone monument down 1.2 feet below the surface of the road. They took ties and broke off the top portion of the stone and set a cast iron monument.***

***May 15, 1995. We checked the reference ties.***


# Certificate of Location of Government Corner

NORTH QUARTER corner, Section 36, Township 116 North, Range 27 West

SKETCH OF REFERENCE TIES (NO SCALE)



SECTION 25

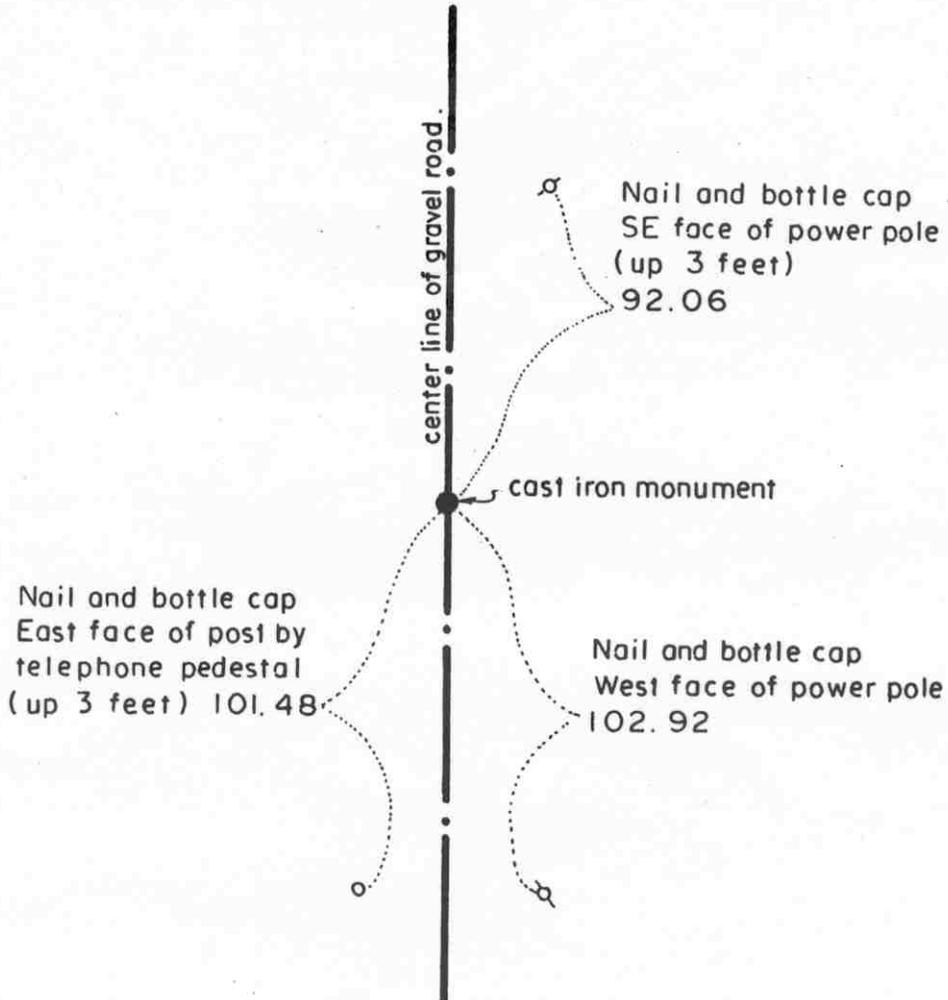

SECTION 36

Statement of evidence relative to this corner location on sheet 2

I hereby certify that this document was prepared by me or under my direct supervision.

Willard Pellinen  
Willard Pellinen  
McLeod County Surveyor  
License No. 9626.

Date August 25, 1994

OFFICE OF THE COUNTY RECORDER  
MCLEOD COUNTY, MINNESOTA

I hereby certify that this document was filed in this office at 9 o'clock A. M. on the 9th day of Sept 19 94.

Carman Oelie Mulder County Recorder

By \_\_\_\_\_, Deputy.

Document No. 261760

## ***Certificate of Location of Government Corner***

***North Quarter Corner, Section 36, Township 116 North, Range 27 West***

***November, 1856. E. N. Darling of the General Land Office set a post and marked a 12 inch elm and a 14 inch oak for bearing trees.***

***No occupation lines east or west to help locate north-south location of corner.***

***April 12, 1982. We set a temporary quarter corner on the center line of the north-south gravel road on a straight line between the northeast and northwest corners of Section 36.***

***July 27, 1982. We excavated for the corner at our temporary corner (John Tupa from Hutchinson with a backhoe). Down 3 feet below the surface of the road we found a very rotted wood stake. This was within 2-3 feet of being on a split between the section corners. We took available reference ties.***

***August 26, 1982. We set a Mcleod County cast iron monument at the corner and took additional reference ties.***


***August 23, 1994. We found the cast iron monument in good condition and checked the reference ties.***

# Certificate of Location of Government Corner

NORTH QUARTER corner, Section 1, Township 115 North, Range 27 West

SKETCH OF REFERENCE TIES (NO SCALE)

SECTION 36, T. 116 N., R. 27 W.

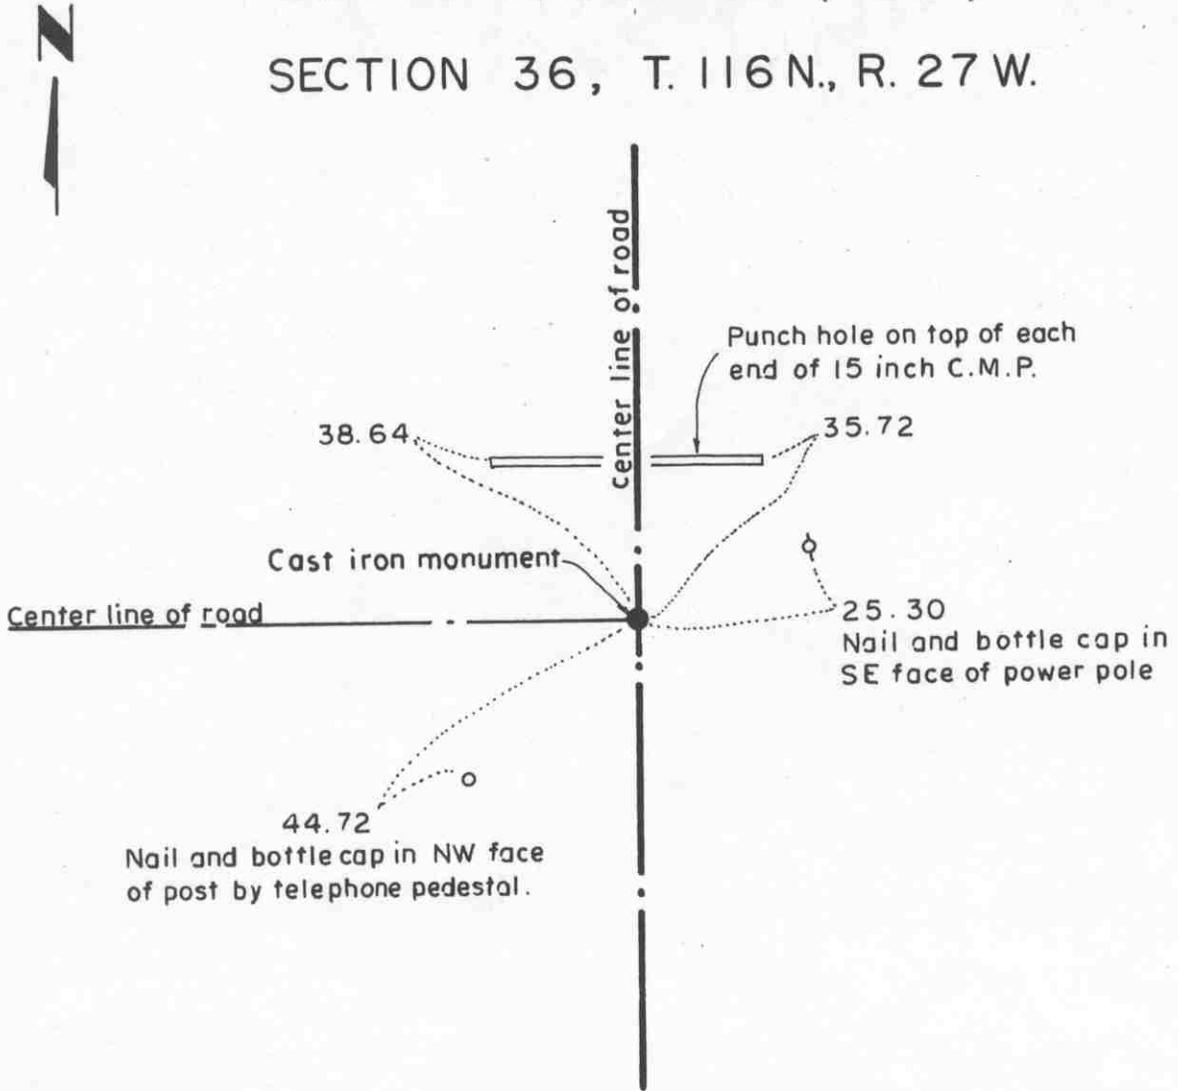

SECTION 1, T. 115 N., R. 27 W.

Statement of evidence relative to this corner location on sheet 2

I hereby certify that this document was prepared by me or under my direct supervision.

Willard Pellinen  
 Willard Pellinen  
 McLeod County Surveyor  
 License No. 9626.

Date April 17, 1995

OFFICE OF THE COUNTY RECORDER  
 MCLEOD COUNTY, MINNESOTA

I hereby certify that this document was filed in this office at 9 o'clock A. M. on the 24th day of April 19 95.

Carmen Potliw Gulder, County Recorder

By \_\_\_\_\_, Deputy.

Document No. 265294

**Certificate of Location of Government Corner**  
**North Quarter Corner, Section 1, Township 115 North, Range 27 West**

**1855. John Ryan of the General Land Office established this corner. He set a post and marked a 12 inch oak and a 10 inch oak for bearing trees.**

**September 15, 1969. Dickman Knutson, county surveyor found an iron pipe at the center line intersection of roads north, south and west. He took available ties.**

**1970. Knutson set a McLeod County cast iron monument at the corner.**

**February 2, 1995. We found the monument in good condition down 8 inches below the surface of the gravel road. We took new reference ties.**

# Certificate of Location of Government Corner


NORTHEAST corner, Section 1, Township 115 North, Range 27 West

## SKETCH OF REFERENCE TIES (NO SCALE)



SECTION 36  
T. 116, R. 27

SECTION 31  
T. 116, R. 26

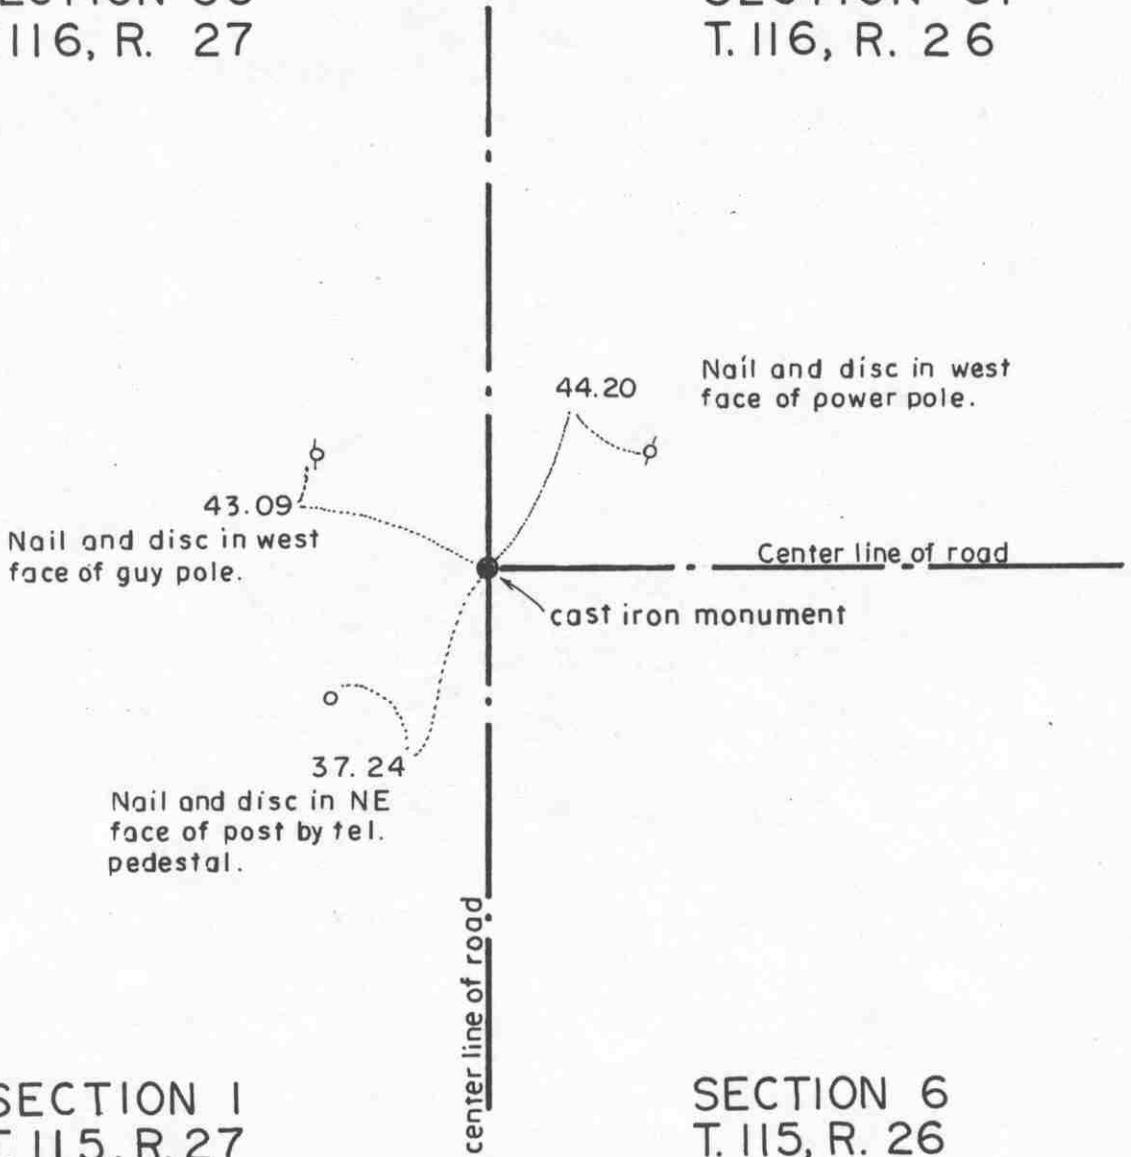

SECTION 1  
T. 115, R. 27

SECTION 6  
T. 115, R. 26

### Statement of evidence relative to this corner location on sheet 2

I hereby certify that this document was prepared by me or under my direct supervision.

Willard Pellinen  
Willard Pellinen  
McLeod County Surveyor  
License No. 9626.

Date April 17, 1995

### OFFICE OF THE COUNTY RECORDER MCLEOD COUNTY, MINNESOTA

I hereby certify that this document was filed in this office at 9 o'clock A. M. on the 24th day of Apr 19 95.

Carmen Dotlie Gulder, County Recorder

By \_\_\_\_\_, Deputy.

Document No. 265293

***Certificate of Location of Government Corner  
Northeast Corner, Section 1, Township 115 North, Range 27 West***

***July, 1855. John Ryan of the General Land Office established this corner. He set a post and marked a 30 inch ash, a 30 inch elm, a 20 inch oak and a 16 inch oak for bearing trees.***

***1971. Carlisle Madson, Carver County Surveyor, set a cast iron monument over a found limestone monument. This location was accepted by Dickman Knutson, McLeod County Surveyor.***

***February 2, 1995. We found the monument in good condition down 8 inches below the surface of the gravel road and took available reference ties.***